

**Drain:** SADDLE CREEK DRAIN **Drain #:** 295  
**Improvement/Arm:** SADDLE CREEK - SECTION 5  
**Operator:** SLM/JOH **Date:** 6-21-04  
**Drain Classification:** Urban/Rural **Year Installed:** 1999

### GIS Drain Input Checklist

- Pull Source Documents for Scanning SLM/JOH
- Digitize & Attribute Tile Drains N/A
- Digitize & Attribute Storm Drains SLM/JOH
- Digitize & Attribute SSD SLM/JOH
- Digitize & Attribute Open Ditch N/A
- Stamp Plans SLM/JOH
- Sum drain lengths & Validate JOH
- Enter Improvements into Posse JOH
- Enter Drain Age into Posse JOH
- Sum drain length for Watershed in Posse JOH
- Check Database entries for errors JOH





SURVEYOR'S OFFICE

# Hamilton County

*Kenton C. Ward, Surveyor*

*Phone (317) 776-8495*

*Fax (317) 776-9628*

*Suite 146*

*One Hamilton County Square*

*Noblesville, Indiana 46060-2230*

November 21, 1997

TO: HAMILTON COUNTY DRAINAGE BOARD

RE: Saddle Creek Drain-Section 5 Arm

Attached is a petition, non-enforcement request, plans, calculations, quantity summary and assessment roll for the Saddle Creek Drain-Section 5 Arm. I have reviewed the submittals and petition and have found each to be in proper form.

I have made a personal inspection of the land described in the petition. Upon doing so, I believe that the drain is practicable; will improve the public health; benefit a public highway and be of public utility; and that the costs, damages and expenses of the proposed drain will probably be less than the benefits accruing to the owners of land likely to be benefited. The drain will consist of the following:

6" SSD	5,000 ft	24" RCP	195 ft
12" RCP	409 ft	27" RCP	440 ft
15" RCP	197 ft	30" RCP	346 ft
18" RCP	700 ft	36" RCP	260 ft
21" RCP	867 ft		

The total length of the drain will be 8,414 feet.

The retention pond (lake) located to the South of Lot 160 within a common area is not to be considered part of the regulated drain. Only the inlet and outlet will be maintained as part of the regulated drain. The maintenance of the pond (lake) will be the responsibility of the Homeowners Association. The Board will however, retain jurisdiction for ensuring the storage volume for which the lake was designed will be retained. Thereby, allowing no fill or easement encroachments.

The subsurface drains (SSD) to be part of the regulated drain are those located under the curbs. Only the main SSD lines which are within R/W are to be maintained as regulated drain. Laterals for individual lots will not be considered part of the regulated drain. The portion of the SSD which will be regulated other than those under curbs are as follows: in the rear of Lots 131-133. The 12" CMP's under the sidewalks in various locations are not to be considered part of the drain nor is the open swale across the Common Area from 141st Street to the lake.

I have reviewed the plans and believe the drain will benefit each lot equally. Therefore, I recommend each lot be assessed equally. I also believe that no damage will result to landowners by the construction of this drain. I recommend a maintenance assessment of \$30.00 per lot, \$5.00 per acre for roadways, with a \$30.00 minimum. With this assessment the total annual assessment for this drain/this section will be \$ 1,237.55.

Parcels assessed for this drain may be assessed for the Collins-Osborn or Williams Creek Drain at sometime in the future.

I believe this proposed drain meets the requirements for Urban Drain Classification as set out in IC 36-9-27-67 to 69. Therefore, this drain shall be designated as an Urban Drain.

I recommend that upon approval of the above proposed drain that the Board also approve the attached non-enforcement request. This request is for the reduction of the regulated drain easement. to those easement widths as shown on the secondary plat for Saddle Creek Section 5 as recorded in the office of the Hamilton County Recorder.

I recommend the Board set a hearing for this proposed drain for January 1998.

---

Kenton C. Ward  
Hamilton County Surveyor  
KCW/no



# UNITED FIRE & CASUALTY COMPANY

CEDAR RAPIDS, IOWA

(A STOCK COMPANY)

## SUBDIVISION BOND

KNOW ALL MEN BY THESE PRESENTS, That we, SADDLE CREEK DEVELOPMENT  
COMPANY of 123 Village Drive, Carmel, IN 46032  
 \_\_\_\_\_ (hereinafter called Principal), and the UNITED  
 FIRE & CASUALTY COMPANY, an Iowa Corporation of Cedar Rapids, Iowa  
 (hereinafter called Surety), are held and firmly bound unto the  
THE BOARD OF HAMILTON COUNTY COMMISSIONERS

\_\_\_\_\_, as Oblige in the penal sum of \$ ONE HUNDRED SEVENTY  
FOUR THOUSAND, EIGHT HUNDRED AND THIRTY-THREE & 00/100 \$ 174,833.00-----  
 Dollars lawful money of the United States of America, for the pay-  
 ment of which whereof, wel and truly to be made, the said Prin-  
 cipal binds themselves, their heirs, executors and administrators,  
 successors and assigns, and the Surety binds itself, its successors  
 and assigns, jointly and severally, firmly by these presents.

WHEREAS, the above bounden, SADDLE CREEK DEVELOPMENT COMPANY  
 have asked for the approval of a certain subdivision known as \_\_\_\_\_  
SADDLE CREEK

NOW, THEREFORE, if the above bounden, SADDLE CREEK DEVELOPMENT  
COMPANY shall construct SECTION 5  
STORM SEWERS, and pay a reasonable inspection fee therefore,  
 all as a part of the platting ordinance of the BOARD OF HAMILTON  
COUNTY COMMISSIONERS all of which to be completed within two (2)  
 years from the date of acceptance of the final plat then this ob-  
 ligation to be null and void; otherwise to be and remain in full  
 force and effect.

It is understood and agreed, however, that the liability of the  
 Surety hereunder shall not exceed (1) the penal sum hereof, or  
 (2) the actual cost unto the BOARD OF HAMILTON COUNTY COMMISSIONERS,  
 for the completing such specified improvements, should such costs  
 be less than the penal sum thereof.

Dated at INDIANAPOLIS, this 21ST day of AUGUST,  
 1997.

SADDLE CREEK DEVELOPMENT COMPANY

BY \_\_\_\_\_

(PRINCIPAL)

JOHN J. KENNELLY, PRESIDENT

UNITED FIRE & CASUALTY COMPANY

BY \_\_\_\_\_

ATTORNEY-IN-FACT

JOSEPH L. LAWRENCE



**UNITED FIRE & CASUALTY COMPANY**  
**HOME OFFICE - CEDAR RAPIDS, IOWA**  
**CERTIFIED COPY OF POWER OF ATTORNEY**  
 (Original on file at Home Office of Company - See Certification)

KNOW ALL MEN BY THESE PRESENTS, That the UNITED FIRE & CASUALTY COMPANY, a corporation duly organized and existing under the laws of the State of Iowa, and having its principal office in Cedar Rapids, State of Iowa, does make, constitute and appoint **JOHN M. THIXTON, OR TERESA VINSON, OR JOSEPH L. LAWRENCE, ALL INDIVIDUALLY**

of **P.O. BOX 502984 INDIANAPOLIS IN 46250**  
 its true and lawful Attorney(s)-in-Fact with power and authority hereby conferred to sign, seal and execute in its behalf all lawful bonds, undertakings and other obligatory instruments of similar nature as follows: **ANY AND ALL BONDS**

and to bind UNITED FIRE & CASUALTY COMPANY thereby as fully and to the same extent as if such instruments were signed by the duly authorized officers of UNITED FIRE & CASUALTY COMPANY and all the acts of said Attorney, pursuant to the authority hereby given are hereby ratified and confirmed.

The Authority hereby granted shall expire **OCTOBER 22nd 2001** unless sooner revoked.

This power of Attorney is made and executed pursuant to and by authority of the following By-Law duly adopted by the Board of Directors of the Company on April 18, 1973.

"Article V - Surety Bonds and Undertakings."

Section 2, Appointment of Attorney-in-Fact. "The President or any Vice President, or any other officer of the Company, may, from time to time, appoint by written certificates attorneys-in-fact to act in behalf of the Company in the execution of policies of insurance, bonds, undertakings and other obligatory instruments of like nature. The signature of any officer authorized hereby, and the Corporate seal, may be affixed by facsimile to any power of attorney or special power of attorney or certification of either authorized hereby; such signature and seal, when so used, being adopted by the Company as the original signature of such officer and the original seal of the Company, to be valid and binding upon the Company with the same force and effect as though manually affixed. Such attorneys-in-fact, subject to the limitations set forth in their respective certificates of authority shall have full power to bind the Company by their signature and execution of any such instruments and to attach the seal of the Company thereto. The President or any Vice President, the Board of Directors or any other officer of the Company may at any time revoke all power and authority previously given to any attorney-in-fact.

IN WITNESS WHEREOF, the UNITED FIRE & CASUALTY COMPANY has caused these presents to be signed by its vice president and its corporate seal to be hereto affixed this **22nd** day of **OCTOBER** .A.D. **1996**



UNITED FIRE & CASUALTY COMPANY

By *Maynard L. Hansen*  
 Vice President

State of Iowa, County of Linn, ss:

On this **22nd** day of **OCTOBER**, **1996**, before me personally came **MAYNARD L. HANSEN** to me known, who being by me duly sworn, did depose and say: that he resides in Cedar Rapids, State of Iowa; that he is a Vice President of the UNITED FIRE & CASUALTY COMPANY, the corporation described in and which executed the above instrument; that he knows the seal of said corporation; that the seal affixed to the said instrument is such corporated seal; that it was so affixed pursuant to authority given by the Board of Directors of said corporation and that he signed his name thereto pursuant to like authority, and acknowledges same to be the act and deed of said corporation.



*Judith A. Davis*  
 Notary Public  
 My commission expires **FEBRUARY 4** .19 **99**

CERTIFICATION

I, the undersigned officer of the UNITED FIRE & CASUALTY COMPANY, do hereby certify that I have compared the foregoing copy of the Power of Attorney and affidavit, and the copy of the Section of the By-Laws of said Company as set forth in said Power of Attorney, with the ORIGINALS ON FILE IN THE HOME OFFICE OF SAID COMPANY, and that the same are correct transcripts thereof, and of the whole of the said originals, and that the said Power of Attorney has not been revoked and is now in full force and effect.

In testimony whereof I have hereunto subscribed my name and affixed the corporate seal of the said Company this **12TH** day of **AUGUST** **19 97**



*Lucretia L. Canning*  
 Asst. Secretary



# UNITED FIRE & CASUALTY COMPANY

CEDAR RAPIDS, IOWA

(A STOCK COMPANY)

## SUBDIVISION BOND

KNOW ALL MEN BY THESE PRESENTS, That we, SADDLE CREEK DEVELOPMENT

COMPANY of 123 Village Drive, Carmel, IN 46032

(hereinafter called Principal), and the UNITED FIRE & CASUALTY COMPANY, an Iowa Corporation of Cedar Rapids, Iowa (hereinafter called Surety), are held and firmly bound unto the

THE BOARD OF HAMILTON COUNTY COMMISSIONERS

, as Obligee in the penal sum of THIRTY THOUSAND

THREE HUNDRED AND THIRTEEN & 00/100 (\$ 30,313.00 )

Dollars lawful money of the United States of America, for the payment of which whereof, we and truly to be made, the said Principal binds themselves, their heirs, executors and administrators, successors and assigns, and the Surety binds itself, its successors and assigns, jointly and severally, firmly by these presents.


WHEREAS, the above bounden, SADDLE CREEK DEVELOPMENT COMPANY have asked for the approval of a certain subdivision known as SADDLE CREEK

NOW, THEREFORE, if the above bounden, SADDLE CREEK DEVELOPMENT COMPANY shall construct SECTION 5 Sub Surface Drains, and pay a reasonable inspection fee therefore, all as a part of the platting ordinance of the BOARD OF HAMILTON COUNTY COMMISSIONERS all of which to be completed within two (2) years from the date of acceptance of the final plat then this obligation to be null and void; otherwise to be and remain in full force and effect.

It is understood and agreed, however, that the liability of the Surety hereunder shall not exceed (1) the penal sum hereof, or (2) the actual cost unto the BOARD OF HAMILTON COUNTY COMMISSIONERS, for the completing such specified improvements, should such costs be less than the penal sum thereof.

Dated at INDIANAPOLIS, this 21ST day of AUGUST, 1997.

SADDLE CREEK DEVELOPMENT COMPANY

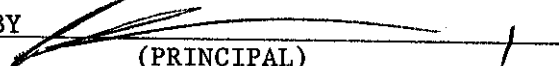BY   
(PRINCIPAL)  
JOHN J. KENNELLY, PRESIDENT

UNITED FIRE & CASUALTY COMPANY

BY   
ATTORNEY-IN-FACT  
JOSEPH L. LAWRENCE



**UNITED FIRE & CASUALTY COMPANY**  
**HOME OFFICE - CEDAR RAPIDS, IOWA**  
**CERTIFIED COPY OF POWER OF ATTORNEY**  
 (Original on file at Home Office of Company - See Certification)

KNOW ALL MEN BY THESE PRESENTS, That the UNITED FIRE & CASUALTY COMPANY, a corporation duly organized and existing under the laws of the State of Iowa, and having its principal office in Cedar Rapids, State of Iowa, does make, constitute and appoint **JOHN M. THIXTON, OR TERESA VINSON, OR JOSEPH L. LAWRENCE, ALL INDIVIDUALLY**

of **P.O. BOX 502984 INDIANAPOLIS IN 46250**  
 its true and lawful Attorney(s)-in-Fact with power and authority hereby conferred to sign, seal and execute in its behalf all lawful bonds, undertakings and other obligatory instruments of similar nature as follows: **ANY AND ALL BONDS**

and to bind UNITED FIRE & CASUALTY COMPANY thereby as fully and to the same extent as if such instruments were signed by the duly authorized officers of UNITED FIRE & CASUALTY COMPANY and all the acts of said Attorney, pursuant to the authority hereby given are hereby ratified and confirmed.

The Authority hereby granted shall expire **OCTOBER 22nd 2001** unless sooner revoked.

This power of Attorney is made and executed pursuant to and by authority of the following By-Law duly adopted by the Board of Directors of the Company on April 18, 1973.

**"Article V - Surety Bonds and Undertakings."**

Section 2, Appointment of Attorney-in-Fact. "The President or any Vice President, or any other officer of the Company, may, from time to time, appoint by written certificates attorneys-in-fact to act in behalf of the Company in the execution of policies of insurance, bonds, undertakings and other obligatory instruments of like nature. The signature of any officer authorized hereby, and the Corporate seal, may be affixed by facsimile to any power of attorney or special power of attorney or certification of either authorized hereby; such signature and seal, when so used, being adopted by the Company as the original signature of such officer and the original seal of the Company, to be valid and binding upon the Company with the same force and effect as though manually affixed. Such attorneys-in-fact, subject to the limitations set forth in their respective certificates of authority shall have full power to bind the Company by their signature and execution of any such instruments and to attach the seal of the Company thereto. The President or any Vice President, the Board of Directors or any other officer of the Company may at any time revoke all power and authority previously given to any attorney-in-fact.

IN WITNESS WHEREOF, the UNITED FIRE & CASUALTY COMPANY has caused these presents to be signed by its vice president and its corporate seal to be hereto affixed this **22nd** day of **OCTOBER**, A.D. **1996**




UNITED FIRE & CASUALTY COMPANY

By *Maynard L. Hansen*  
 Vice President

State of Iowa, County of Linn, ss:

On this **22nd** day of **OCTOBER**, **1996**, before me personally came **MAYNARD L. HANSEN** to me known, who being by me duly sworn, did depose and say: that he resides in Cedar Rapids, State of Iowa; that he is a Vice President of the UNITED FIRE & CASUALTY COMPANY, the corporation described in and which executed the above instrument; that he knows the seal of said corporation; that the seal affixed to the said instrument is such corporated seal; that it was so affixed pursuant to authority given by the Board of Directors of said corporation and that he signed his name thereto pursuant to like authority, and acknowledges same to be the act and deed of said corporation.

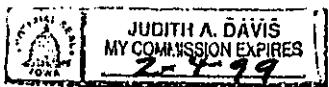

*Judith A. Davis*  
 Notary Public  
 My commission expires **FEBRUARY 4** .19 **99**

**CERTIFICATION**

I, the undersigned officer of the UNITED FIRE & CASUALTY COMPANY, do hereby certify that I have compared the foregoing copy of the Power of Attorney and affidavit, and the copy of the Section of the By-Laws of said Company as set forth in said Power of Attorney, with the ORIGINALS ON FILE IN THE HOME OFFICE OF SAID COMPANY, and that the same are correct transcripts thereof, and of the whole of the said originals, and that the said Power of Attorney has not been revoked and is now in full force and effect.

In testimony whereof I have hereunto subscribed my name and affixed the corporate seal of the said Company this **12TH** day of **AUGUST** **19-97**



*Lucretia L. Canning*  
 Asst. Secretary







UNITED FIRE & CASUALTY COMPANY

HOME OFFICE - CEDAR RAPIDS, IOWA

CERTIFIED COPY OF POWER OF ATTORNEY

(Original on file at Home Office of Company - See Certification)

KNOW ALL MEN BY THESE PRESENTS, That the UNITED FIRE & CASUALTY COMPANY, a corporation duly organized and existing under the laws of the State of Iowa, and having its principal office in Cedar Rapids, State of Iowa, does make, constitute and appoint JOHN M. THIXTON, OR TERESA VINSON, OR JOSEPH L. LAWRENCE, ALL INDIVIDUALLY

of P.O. BOX 502984 INDIANAPOLIS IN 46250 its true and lawful Attorney(s)-in-Fact with power and authority hereby conferred to sign, seal and execute in its behalf all lawful bonds, undertakings and other obligatory instruments of similar nature as follows: ANY AND ALL BONDS

and to bind UNITED FIRE & CASUALTY COMPANY thereby as fully and to the same extent as if such instruments were signed by the duly authorized officers of UNITED FIRE & CASUALTY COMPANY and all the acts of said Attorney, pursuant to the authority hereby given are hereby ratified and confirmed.

The Authority hereby granted shall expire OCTOBER 22nd 2001 unless sooner revoked.

This power of Attorney is made and executed pursuant to and by authority of the following By-Law duly adopted by the Board of Directors of the Company on April 18, 1973.

"Article V - Surety Bonds and Undertakings."

Section 2, Appointment of Attorney-in-Fact. "The President or any Vice President, or any other officer of the Company, may, from time to time, appoint by written certificates attorneys-in-fact to act in behalf of the Company in the execution of policies of insurance, bonds, undertakings and other obligatory instruments of like nature. The signature of any officer authorized hereby, and the Corporate seal, may be affixed by facsimile to any power of attorney or special power of attorney or certification of either authorized hereby; such signature and seal, when so used, being adopted by the Company as the original signature of such officer and the original seal of the Company, to be valid and binding upon the Company with the same force and effect as though manually affixed. Such attorneys-in-fact, subject to the limitations set forth in their respective certificates of authority shall have full power to bind the Company by their signature and execution of any such instruments and to attach the seal of the Company thereto. The President or any Vice President, the Board of Directors or any other officer of the Company may at any time revoke all power and authority previously given to any attorney-in-fact.

IN WITNESS WHEREOF, the UNITED FIRE & CASUALTY COMPANY has caused these presents to be signed by its vice president and its corporate seal to be hereto affixed this 22nd day of OCTOBER A.D. 1996



UNITED FIRE & CASUALTY COMPANY

By Maynard L. Hansen Vice President

State of Iowa, County of Linn, ss:

On this 22nd day of OCTOBER 1996, before me personally came MAYNARD L. HANSEN to me known, who being by me duly sworn, did depose and say: that he resides in Cedar Rapids, State of Iowa; that he is a Vice President of the UNITED FIRE & CASUALTY COMPANY, the corporation described in and which executed the above instrument; that he knows the seal of said corporation; that the seal affixed to the said instrument is such corporated seal; that it was so affixed pursuant to authority given by the Board of Directors of said corporation and that he signed his name thereto pursuant to like authority, and acknowledges same to be the act and deed of said corporation.



Judith A. Davis Notary Public My commission expires FEBRUARY 4 19 99

CERTIFICATION

I, the undersigned officer of the UNITED FIRE & CASUALTY COMPANY, do hereby certify that I have compared the foregoing copy of the Power of Attorney and affidavit, and the copy of the Section of the By-Laws of said Company as set forth in said Power of Attorney, with the ORIGINALS ON FILE IN THE HOME OFFICE OF SAID COMPANY, and that the same are correct transcripts thereof, and of the whole of the said originals, and that the said Power of Attorney has not been revoked and is now in full force and effect.

In testimony whereof I have hereunto subscribed my name and affixed the corporate seal of the said Company this 12TH day of AUGUST 19 97



Lucretia L. Canning Asst. Secretary

CERTIFICATE OF COMPLETION AND COMPLIANCE

TO: HAMILTON COUNTY SURVEYOR

RE: *Saddle Creek Sec 5*

I hereby certify that:

- 1.) I am a Registered Land Surveyor in the State of Indiana,
- 2.) I am familiar with the plans and specifications for the above referenced subdivision,
- 3.) I have personally observed and supervised the completion of the Drainage Facilities for the above referenced subdivision, and
- 4.) To the best of my knowledge, information and belief, the Drainage Facilities within the subdivision has been installed and completed in conformity with all plans and specifications.

Signature: *Bruce Hagen* Date: *8/20/99*  
Type or Printed Name: *Bruce Hagen*  
Business Address: *7172 Graham Rd*  
*Simplex Dr #6260*  
Telephone: *(317) 842-6777*




SEAL

INDIANA REGISTRATION NUMBER

*9300005*

**FILED**  
AUG 23 1999  
OFFICE OF HAMILTON COUNTY SURVEYOR

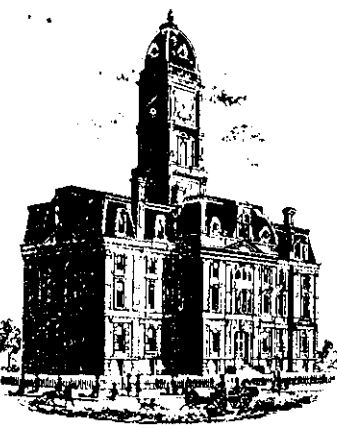

SURVEYOR'S OFFICE

# Hamilton County

*Kenton C. Ward, Surveyor*  
 Phone (317) 776-8495  
 Fax (317) 776-9628

*Suite 146*  
*One Hamilton County Square*  
*Noblesville, Indiana 46060-2230*

To: Hamilton County Drainage Board

June 6, 2000

Re: Saddle Creek Drain: Sec. 5 Arm

Attached are as-builts, certificate of completion & compliance, and other information for Saddle Creek Sec. 5. An inspection of the drainage facilities for this section has been made and the facilities were found to be complete and acceptable.

During construction, changes were made to the drain which will alter the plans submitted with my report for this drain dated November 21, 1997. The changes are as follows:

**Structure:            T.C.:    I.E.:    Pipe:    Length: Original Plans: Difference:**

707		894.93				
706	901	894.83	30	54	62	-12
706	901	894.82				
705	899.8	895.74	30	285	284	1
705	899.8	895.7				
704	901.69	896.24	30	349	350	-1
704	901.69	896.19				
703	901.44	897.14	27	76	75 - 21"	1
703	901.44	897.2				
702	900.27	897.49	21	179	177	2
702	900.27	897.49				
701		896.99	21	109	114	-5
704	901.69	896.22				
709	900.45	896.72	18	80		
709		896.78				
708	900.52	896.78	15	30	26	4
715		894.9				
714	900.89	895.43	21	190	191	-1
714	900.89	895.43				

713	900.89	895.43	18	30	26	4
713	900.89	895.47				
712	901.03	895.63	18	137	142	-5
712	901.03	895.85				
711	899.85	896.12	15	142	145	-3
711	899.85	896.26				
710	899.87	896.24	15	30	26	4
723		894.87				
722	903.19	895.14	27	43	49	-6
722	903.19	896.16				
721	901.92	896.7	24	196	195	1
721	901.92	895.68				
720	900.22	896.08	21	97		
720	900.22	896.26				
719	899.97	896.8	21	211	213	2
719	899.97	896.8				
718	899.9	897.05	18	30	26	4
718	899.9	897.04				
717		897.82	12	144	159	-15
717		897.82				
717a		897.89	12	14		14
722	903.19	895.07				
727	901.46	896.04	18	258	257	1
727	901.46	896.16				
726	900.13	896.68	18	168	169	-1
726	900.13	846.75				
725	900.02	846.76	15	30	26	4
725	900.02	896.87				
724	900.23	897.79	12	177	180	-3
727	901.46	896.21				
728	901.05	896.7	12	44		
729		894.83				
730	899.59	895.29	30	53	51	2
730	899.59	895.05				
731	899.02	894.66	36	133		
731	899.02	894.65				
732		894.21	36	125	2	

**6" SSD Streets:**

Espirit Dr.	1270
Nicholas Dr.	1116
x2	

**Total:** 4772

**6" SSD Lots:**

131-133	473

**Total:** 473

**RCP Pipe Totals:**

12	379
15	<del>202</del> 232'
18	<del>623</del> 703'
21	786
24	196
27	119
30	<del>688</del> 741'
36	258


The length of the drain due to the changes described above is now <sup>8659'</sup>~~8496~~ feet.

The non-enforcement was approved by the Board at its meeting on July 24, 2000 and recorded under instrument #20000003902.

The bond or letter of credit from Unite Fire & Casualty Co., number 54-092461 for storm sewers, 54-092462 for subsurface drains, 54-092463 for erosion control; in the amount of \$174,833.00, \$30,313.00, \$15,450.00; was released June 26, 2000.

I recommend the Board approve the drain's construction as complete and acceptable.


Sincerely,

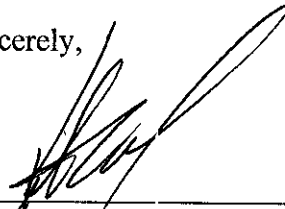



---

Kerton C. Ward,  
Hamilton County Surveyor

KCW/slm

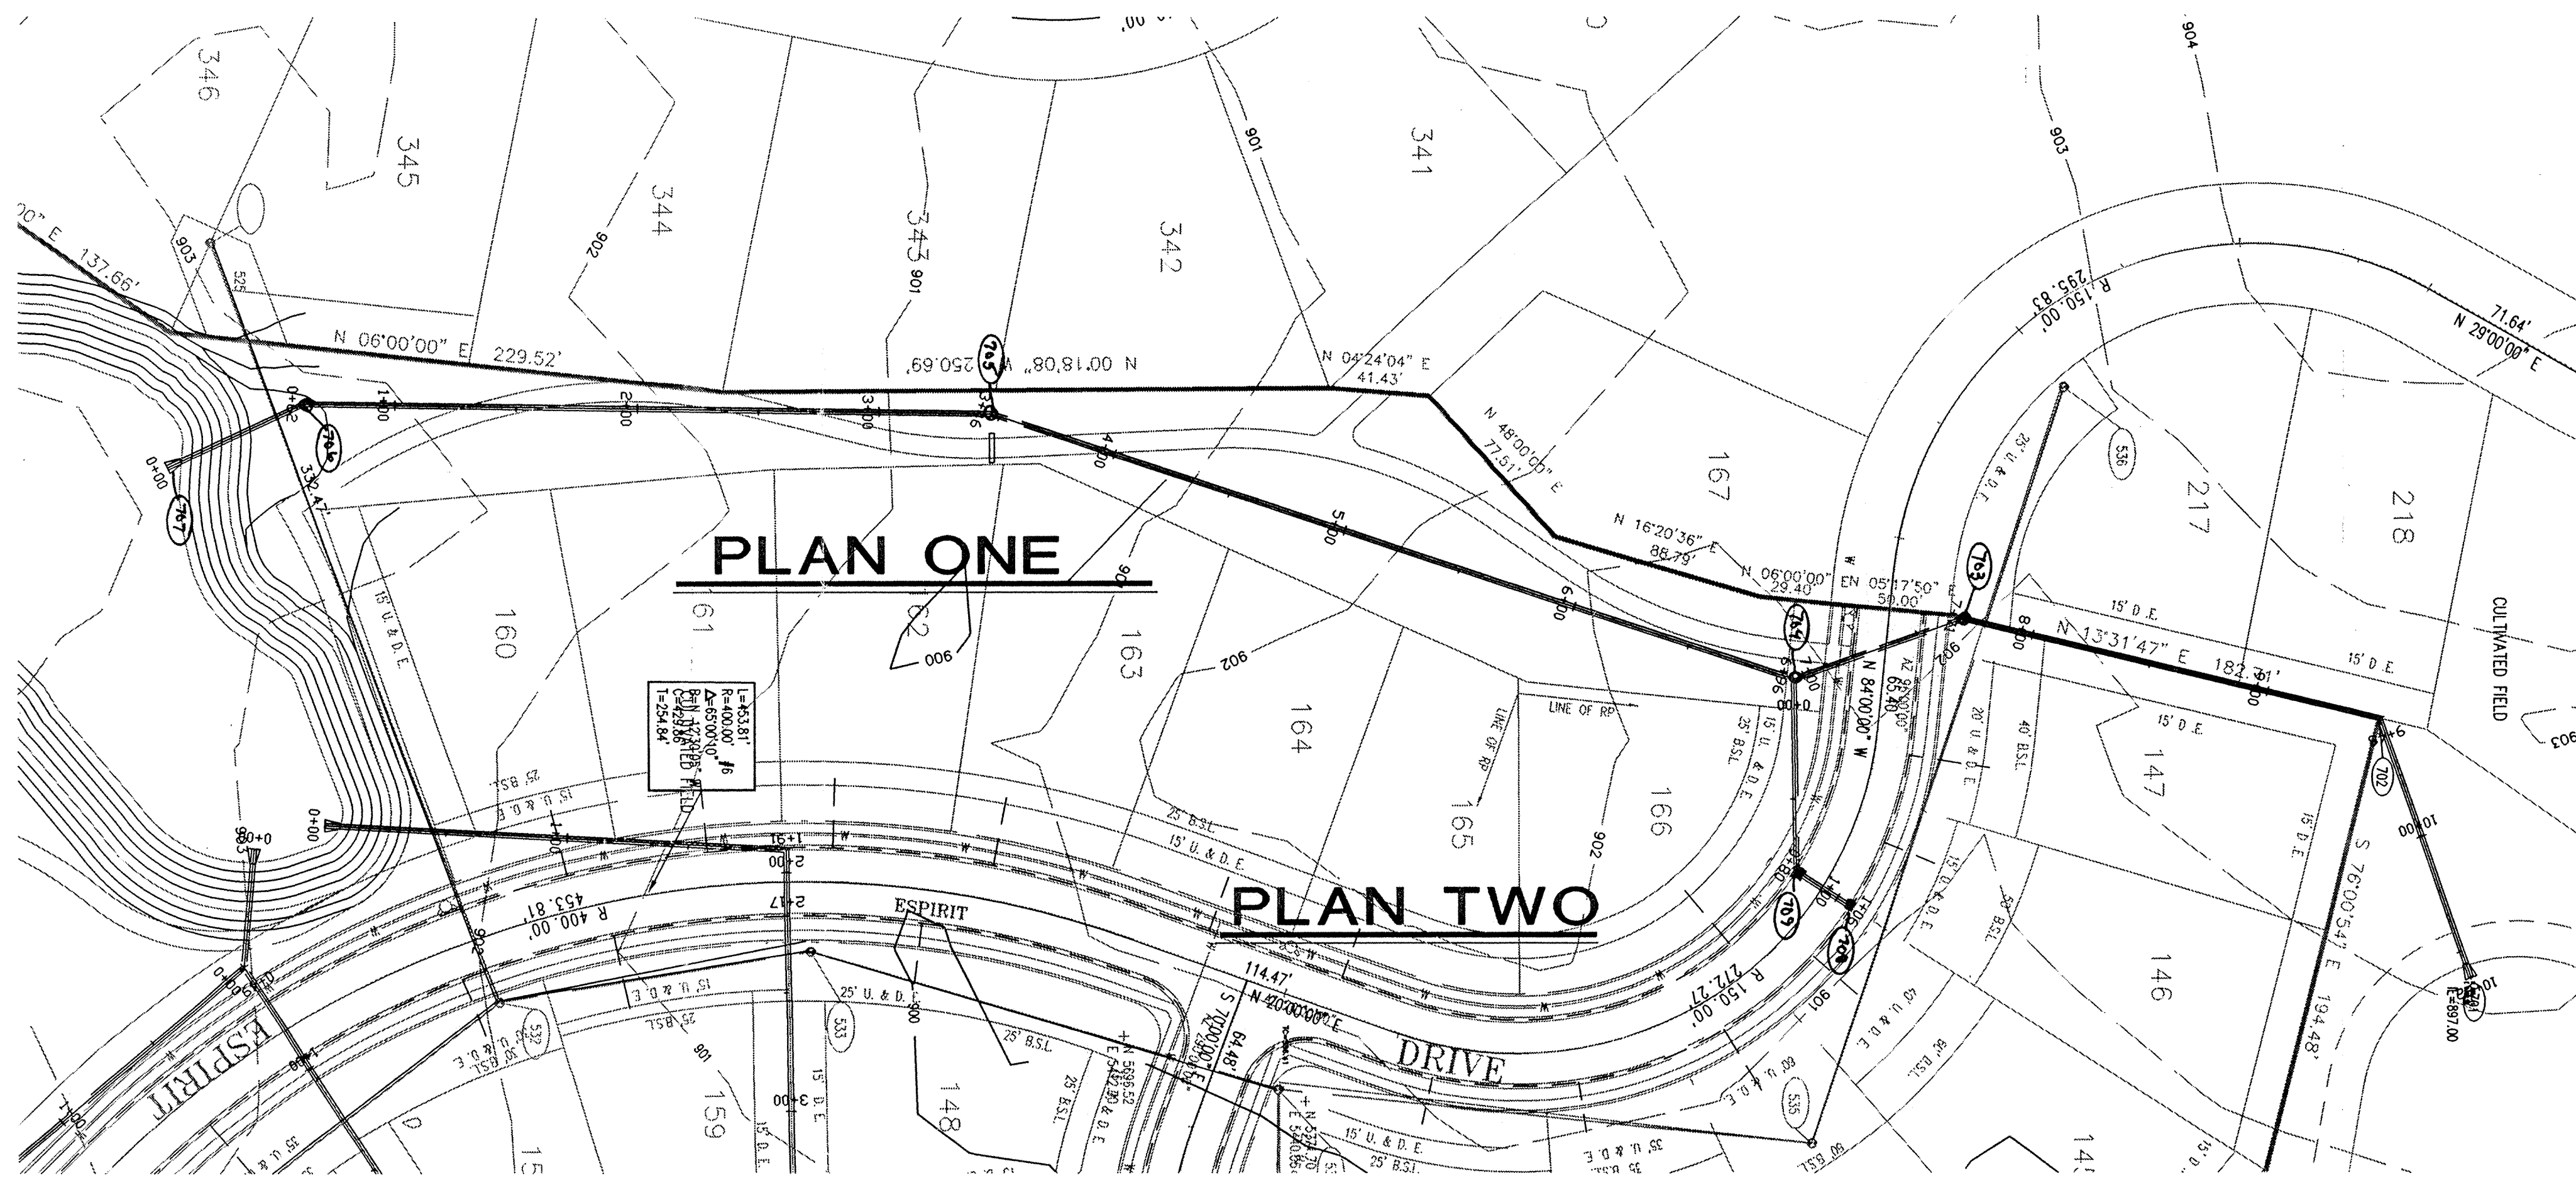

- NOTES: 1. CUTS OR FILLS SHOWN ARE APPROXIMATE. TAKEN FROM EXISTING GRADE @ & @ TO PROPOSED GRADE. @ TOP OF CURB.
2. OCCUPATIONAL SAFETY AND HEALTH ADMINISTRATION (OSHA) STANDARDS FOR EXCAVATIONS: FINAL RULE 29 CFR PART 1926, SUBPART "P" APPLIES TO ALL EXCAVATIONS EXCEEDING FIVE (5) FEET IN DEPTH.
3. PIPE LENGTHS INCLUDE END SECTIONS.
4. FOR CURB CASTINGS, THE TC ELEVATION IS AT THE TOP OF CURB.
5. DEBRIS / ANIMAL GUARD TO BE ADDED TO ALL END SECTIONS.
- IT SHALL BE THE RESPONSIBILITY OF THE CONTRACTOR TO COMPLY WITH THE ABOVE STATED REQUIREMENTS.

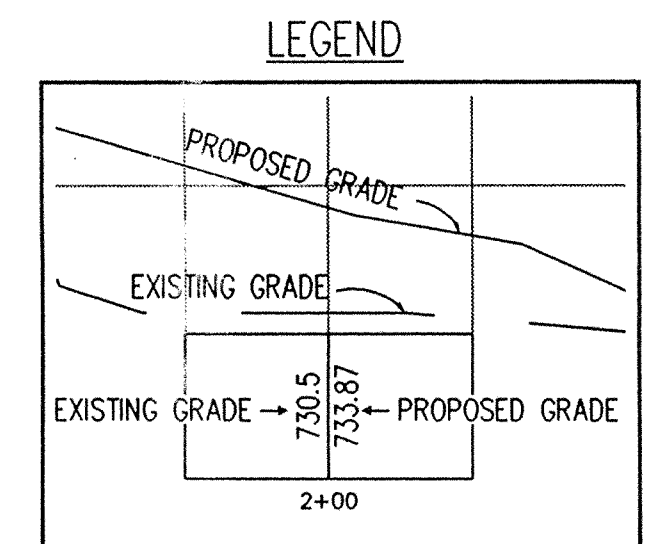




**DON'T DIG BLIND**

**CAUTION**  
LOCATIONS OF ALL EXISTING UNDERGROUND UTILITIES SHOWN ON THIS PLAN ARE BASED UPON ABOVE GROUND EVIDENCE (including, but not limited to, manholes, inlets, valves, and marks made upon the ground by others) AND ARE SPECULATIVE IN NATURE. THERE MAY ALSO BE OTHER EXISTING UNDERGROUND UTILITIES FOR WHICH THERE IS NO ABOVE GROUND EVIDENCE OR FOR WHICH NO ABOVE GROUND EVIDENCE WAS OBSERVED. THE EXACT LOCATIONS OF SAID EXISTING UNDERGROUND UTILITIES SHOULD BE VERIFIED BY THE CONTRACTOR PRIOR TO ANY AND ALL CONSTRUCTION.

1-800-382-5544  
1-800-428-5200  
FOR CALLS OUTSIDE OF INDIANA

This information was gathered for input into the Hamilton County Geographical Information System. This document is considered an official record of the GIS.

Entry Date: 9/14/00  
Entered by: SIM/JOH 6/2/01

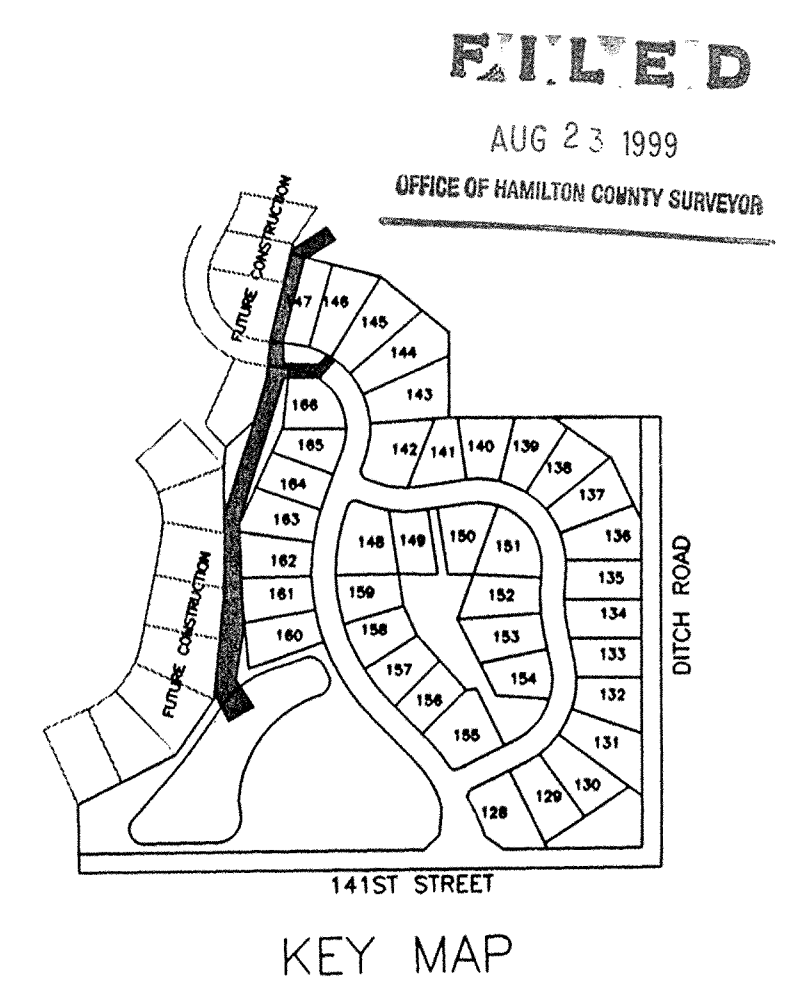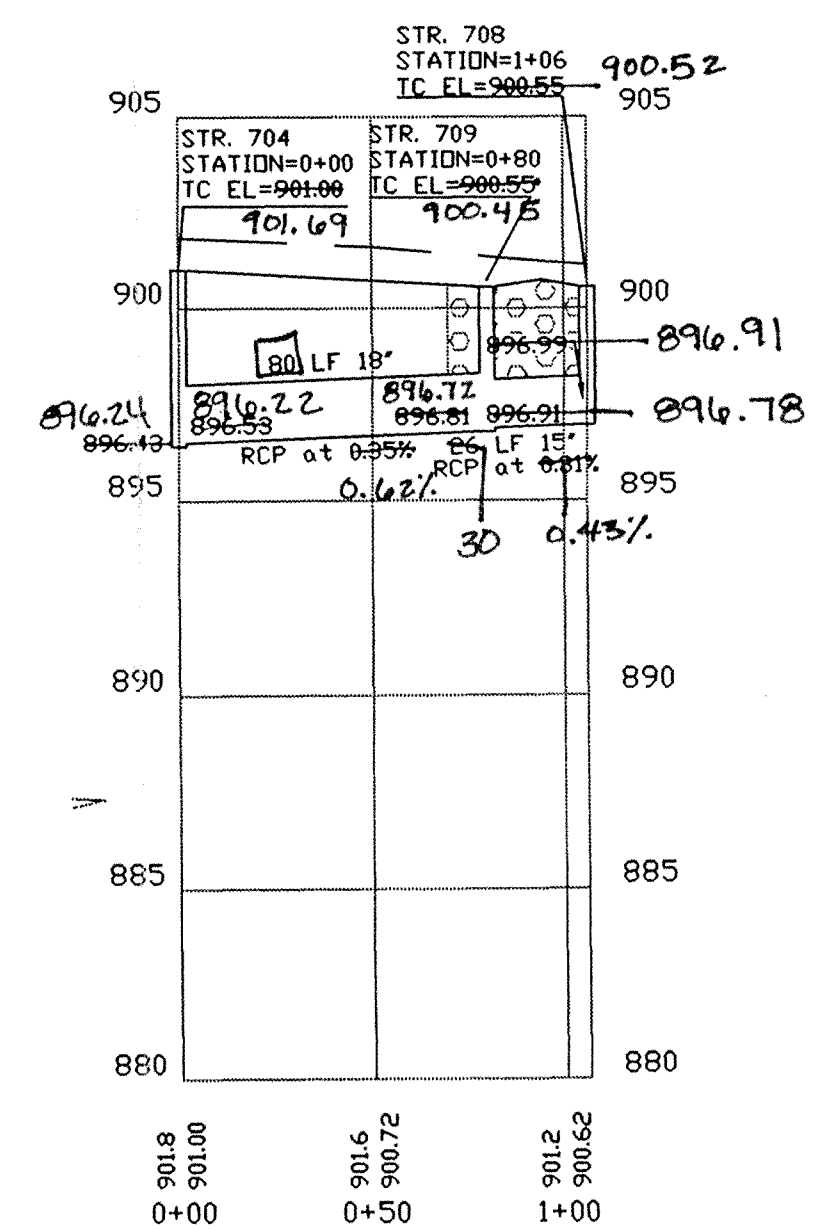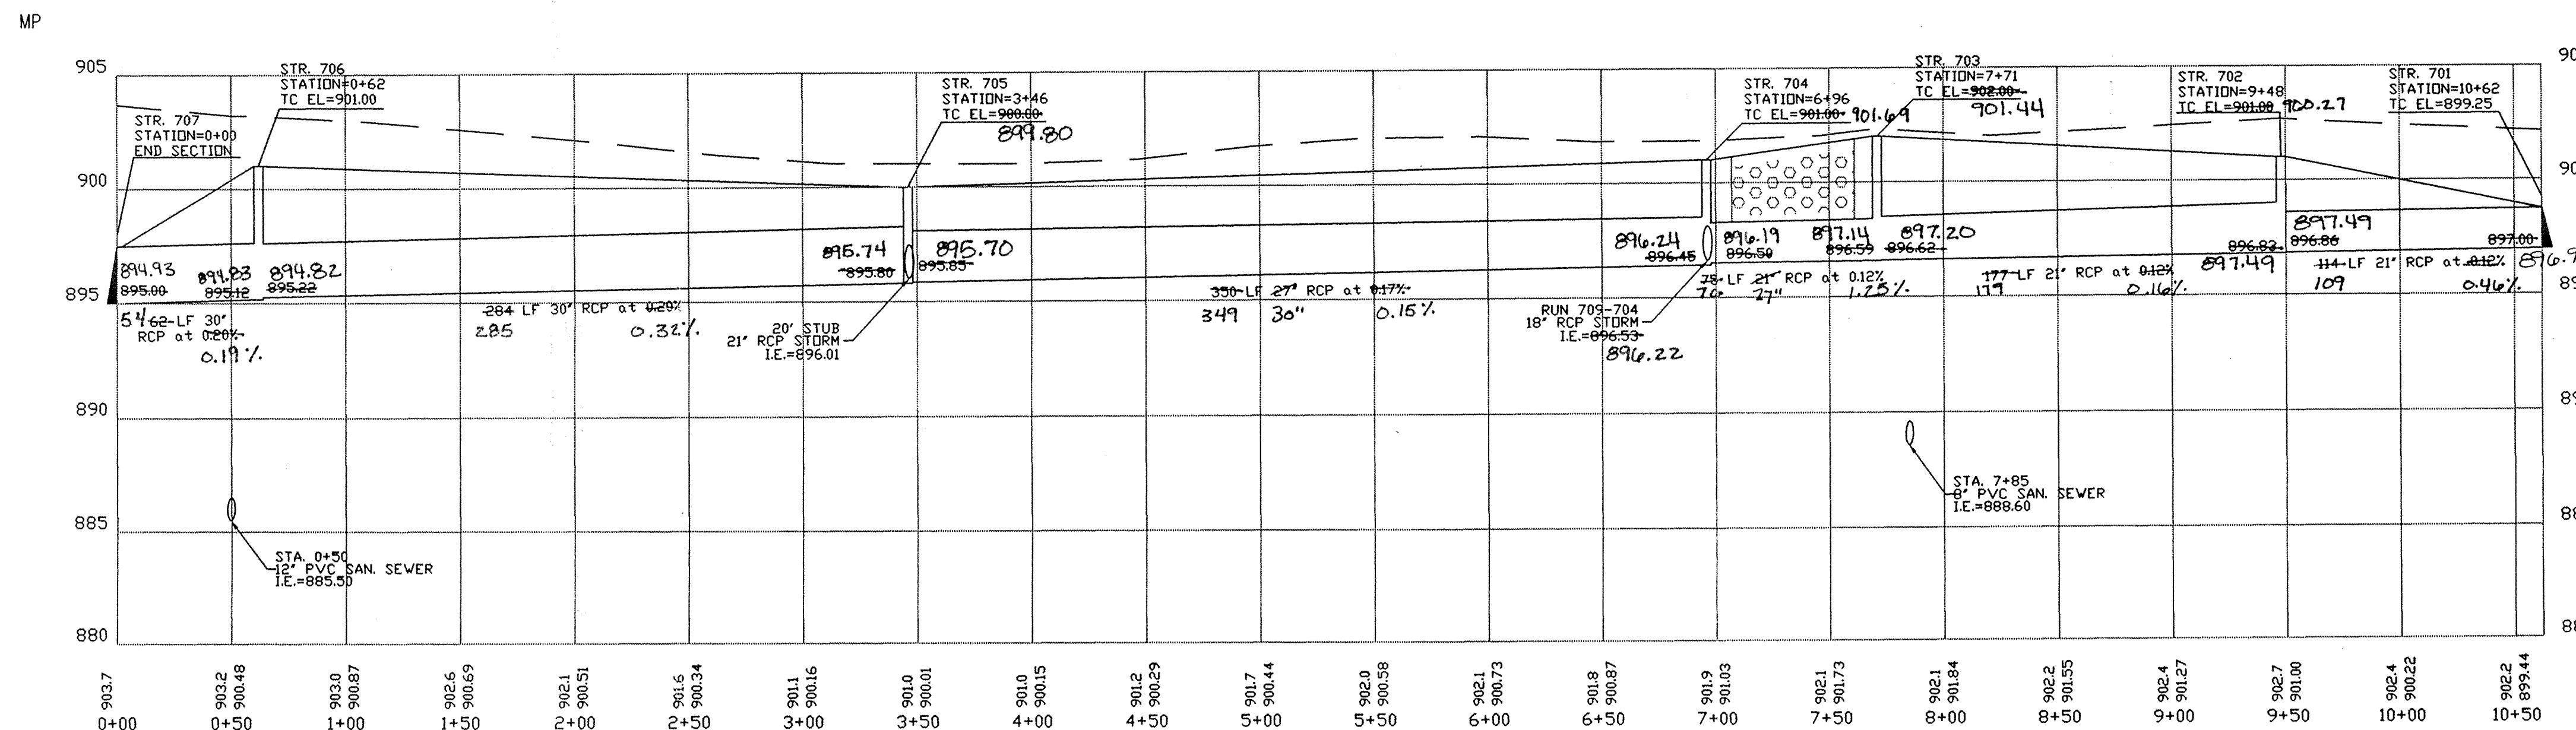

**PROFILE ONE**

**PROFILE TWO**

**AS BUILT**  
date 8/20/99



CERTIFIED BY:	REVISIONS	REVISIONS
DATE:	8/21/97 ADDED NOTE NO. 5	
	9/8/97 REV PIPE SIZES	

**PAUL I. CRIFE, INC.** • CIVIL ENGINEERING • LAND SURVEYING • ARCHITECTURE • LAND PLANNING

7172 GRAHAM ROAD INDIANAPOLIS, INDIANA 46250 Hamilton County Surveyor's Office, One Hamilton Co. Square, Ste. 188 Indianapolis, IN 46204



QUALITY ASSURANCE: DATE: 08-05-97 SCALE: HORZ. 1"=50' VERT. 1"=5'

DWG. TYPE	FILE NUMBER	SHEET:
		<b>C701</b>
JOB NUMBER		
960324-20000		

DRAWING TITLE: **STORM SEWER PLAN & PROFILE**

SADDLE CREEK SEC. 5

- NOTES:
1. CUTS OR FILLS SHOWN ARE APPROXIMATE, TAKEN FROM EXISTING GRADE @ & TO PROPOSED GRADE @ TOP OF CURB.
  2. OCCUPATIONAL SAFETY AND HEALTH ADMINISTRATION (OSHA) STANDARDS FOR EXCAVATIONS: FINAL RULE 29 CFR PART 1926, SUBPART "P" APPLIES TO ALL EXCAVATIONS EXCEEDING FIVE (5) FEET IN DEPTH.
  3. PIPE LENGTHS INCLUDE END SECTIONS.
  4. FOR CURB CASTINGS, THE TC ELEVATION IS AT THE TOP OF CURB.
  5. DEBRIS / ANIMAL GUARD TO BE ADDED TO ALL END SECTIONS.
- IT SHALL BE THE RESPONSIBILITY OF THE CONTRACTOR TO COMPLY WITH THE ABOVE STATED REQUIREMENTS.

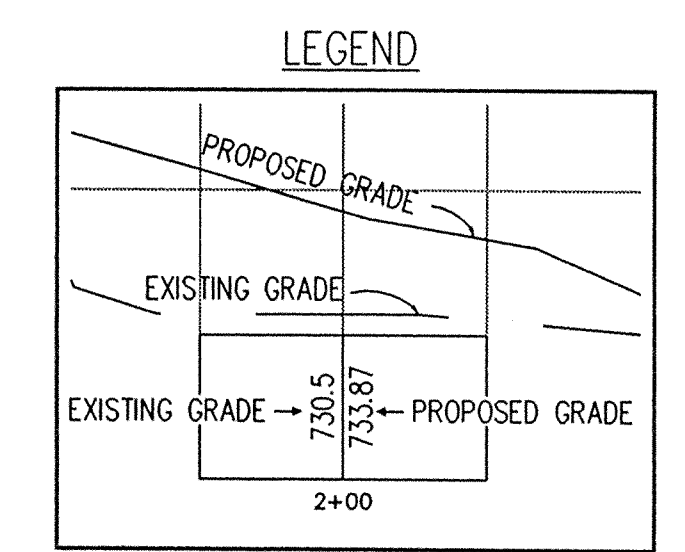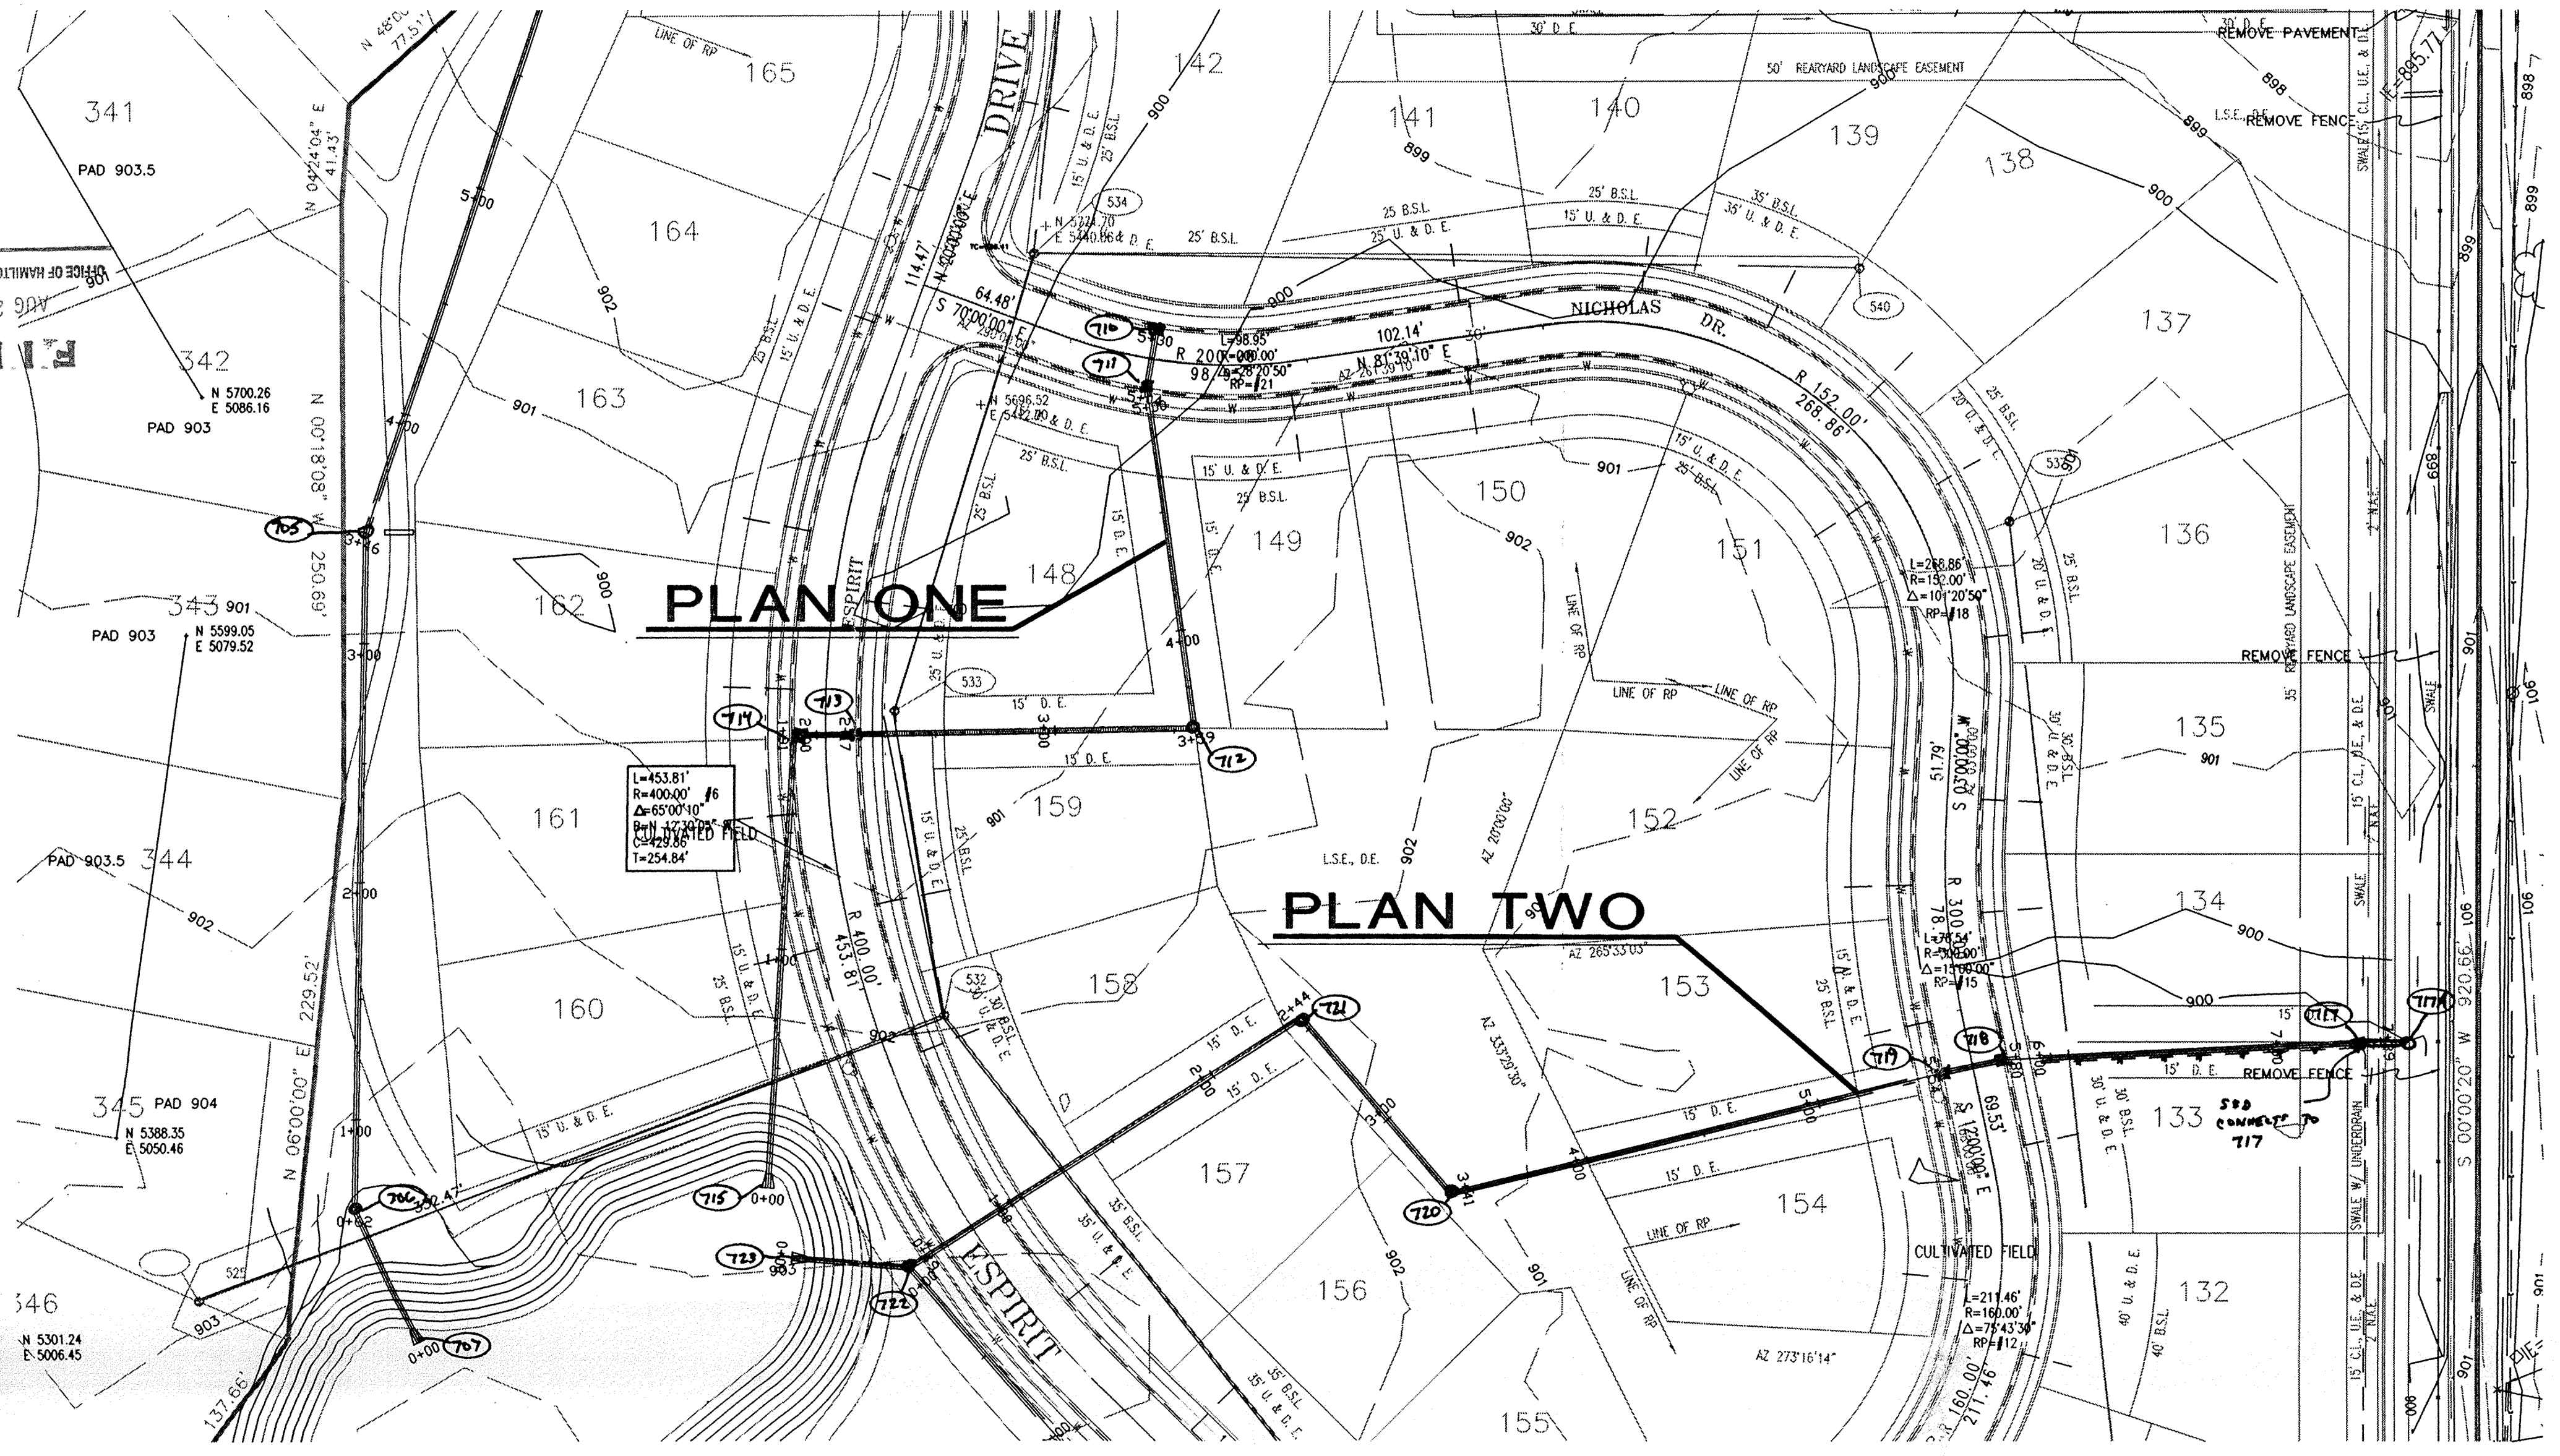





This information was gathered for input into the Hamilton County Geographical Information System. This document is considered an official record of the GIS.

Entry Date: 9/14/00

Entered by: SIM / JDH 6/21/04

1-800-382-5544  
1-800-428-5200  
FOR CALLS OUTSIDE OF INDIANA

**CAUTION**  
LOCATIONS OF ALL EXISTING UNDERGROUND UTILITIES SHOWN ON THIS PLAN ARE BASED UPON ABOVE GROUND EVIDENCE (including, but not limited to, manholes, vaults, valves, and marks made upon the ground by others) AND ARE SPECULATIVE IN NATURE. THERE MAY ALSO BE OTHER EXISTING UNDERGROUND UTILITIES FOR WHICH THERE IS NO ABOVE GROUND EVIDENCE OR FOR WHICH NO ABOVE GROUND EVIDENCE WAS OBSERVED. THE EXACT LOCATIONS OF SAID EXISTING UNDERGROUND UTILITIES SHOULD BE VERIFIED BY THE CONTRACTOR PRIOR TO ANY AND ALL CONSTRUCTION.

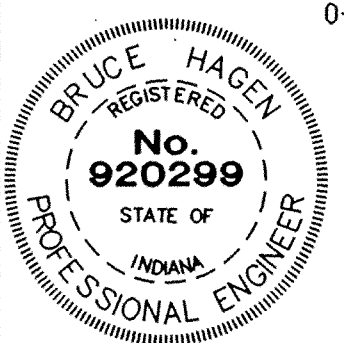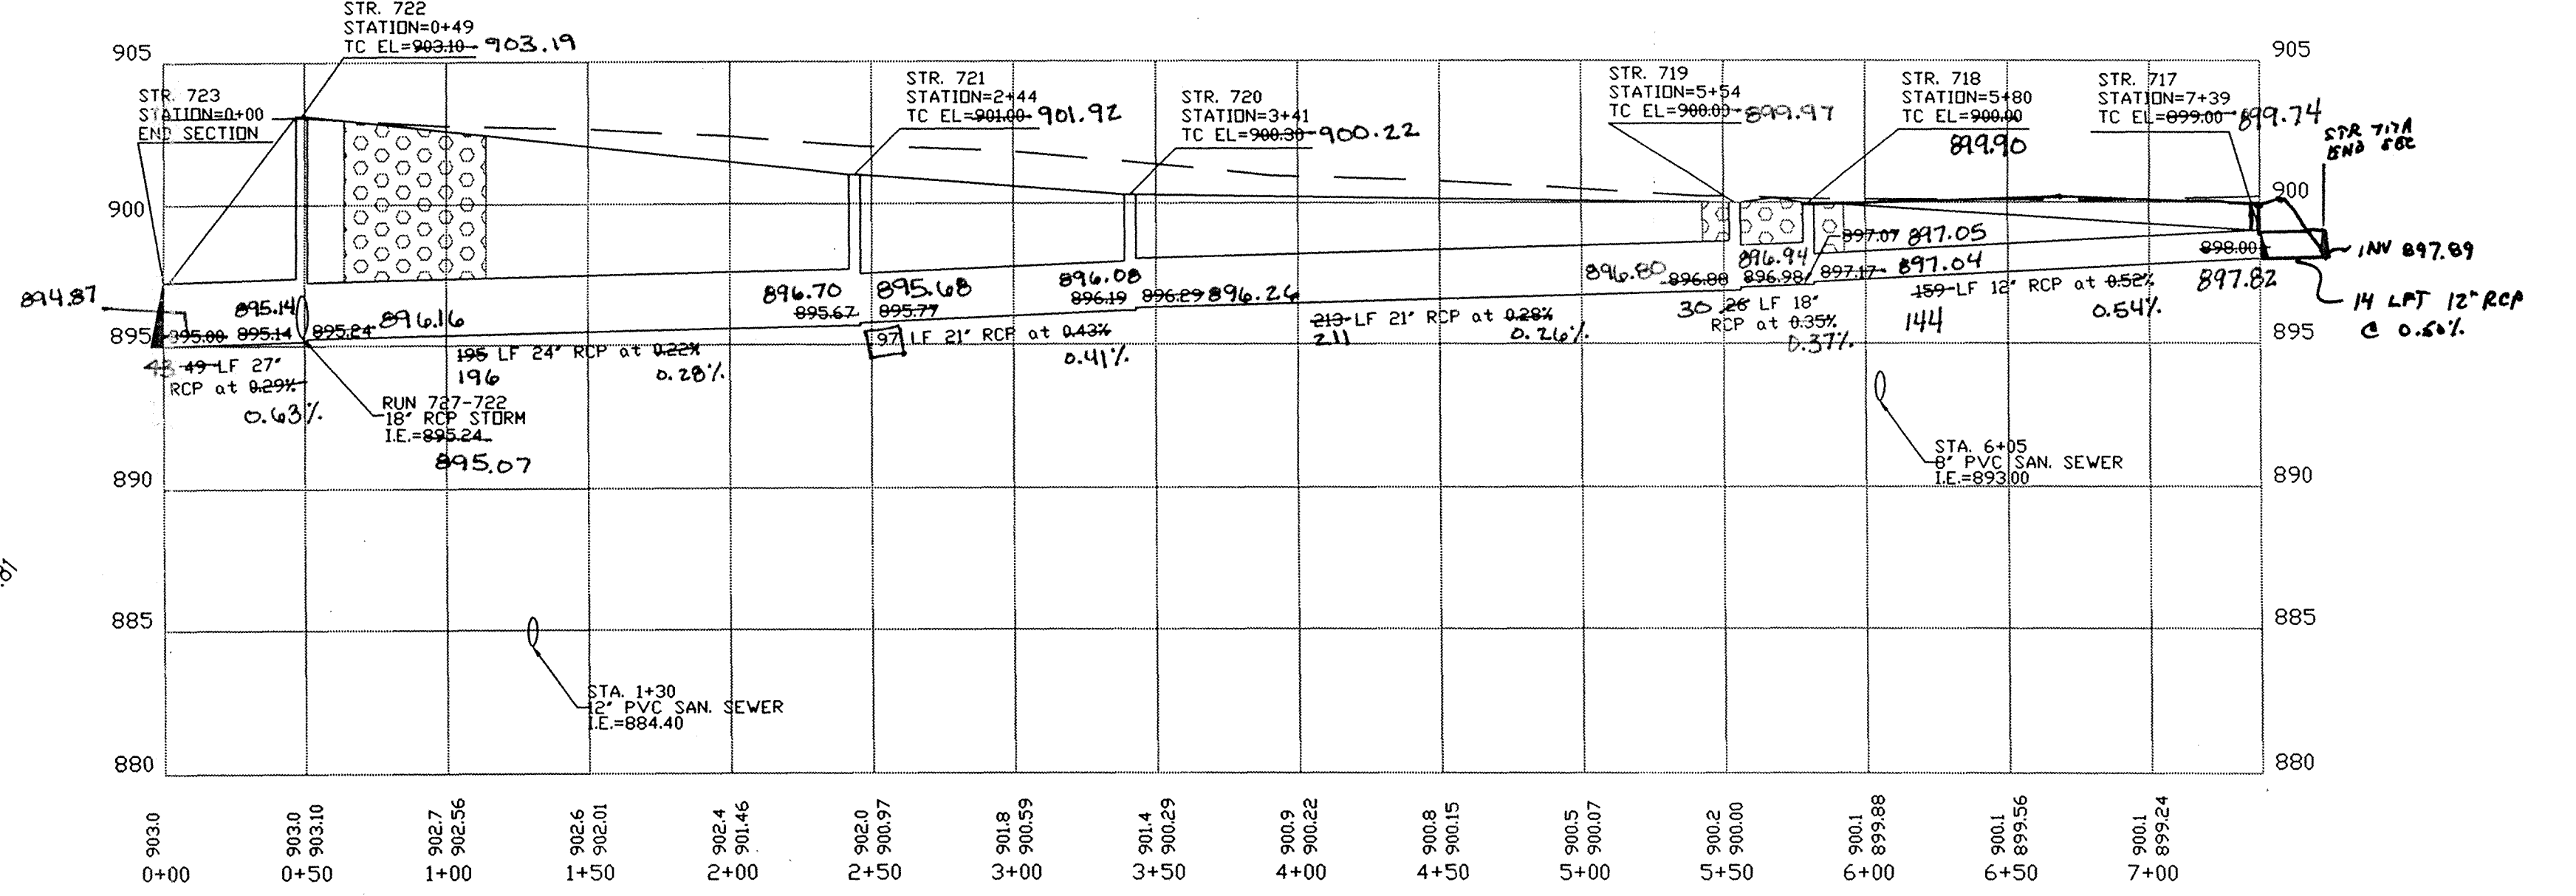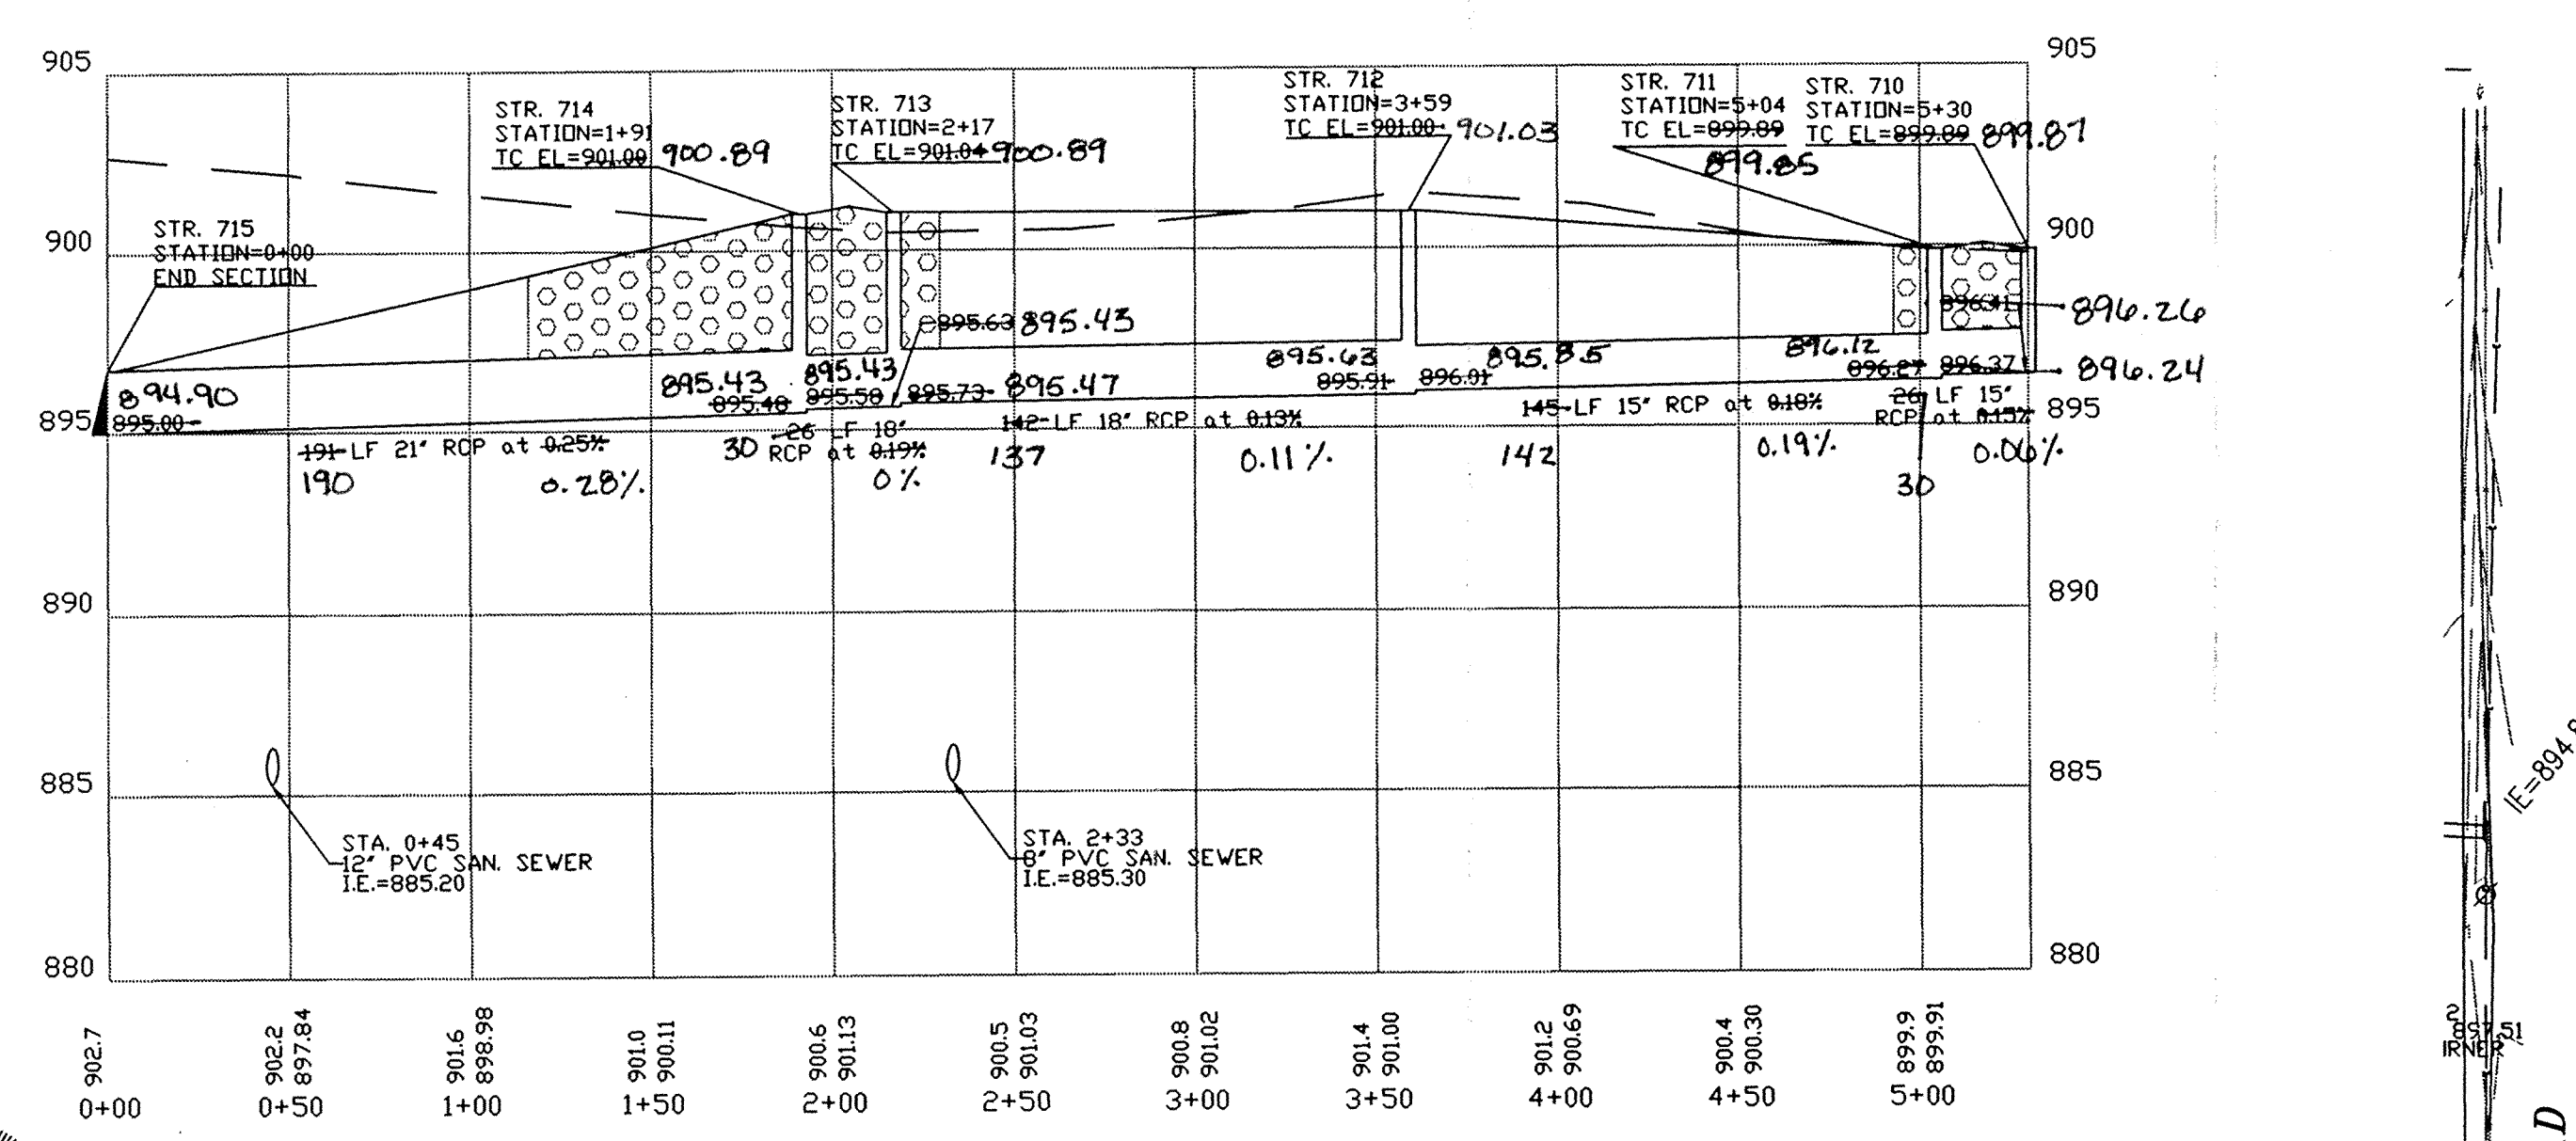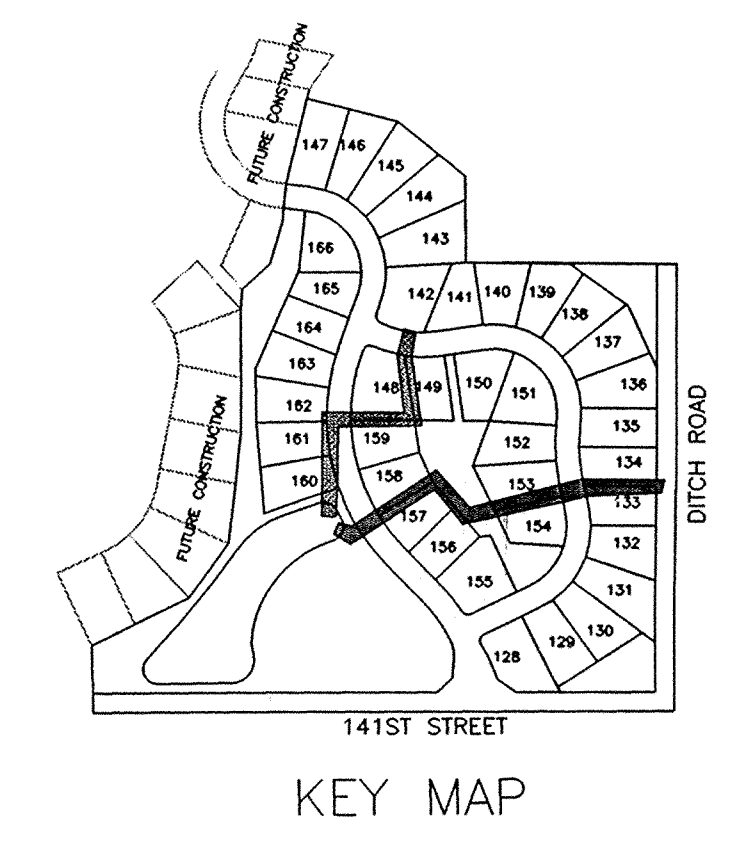

**PROFILE ONE**

**PROFILE TWO**

**AS BUILT**

CERTIFIED BY:	REVISIONS	REVISIONS
	8/21/97 ADDED NOTE NO. 5	
DATE:		



**PAUL I. CRIFE, INC.**  
7172 GRAHAM ROAD  
INDIANAPOLIS, INDIANA 46250  
(317) 842-6777

- CIVIL ENGINEERING
- LAND SURVEYING
- ARCHITECTURE
- LAND PLANNING

QUALITY ASSURANCE:  
DATE:


DATE: 08-05-97  
SCALE: HORZ. 1"=50'  
VERT. 1"=5'

DRAWING TITLE:  
**STORM SEWER PLAN & PROFILE**



SADDLE CREEK SEC. 5

DWG. TYPE	FILE NUMBER	SHEET:
		<b>C702</b>
JOB NUMBER		
960324-20000		



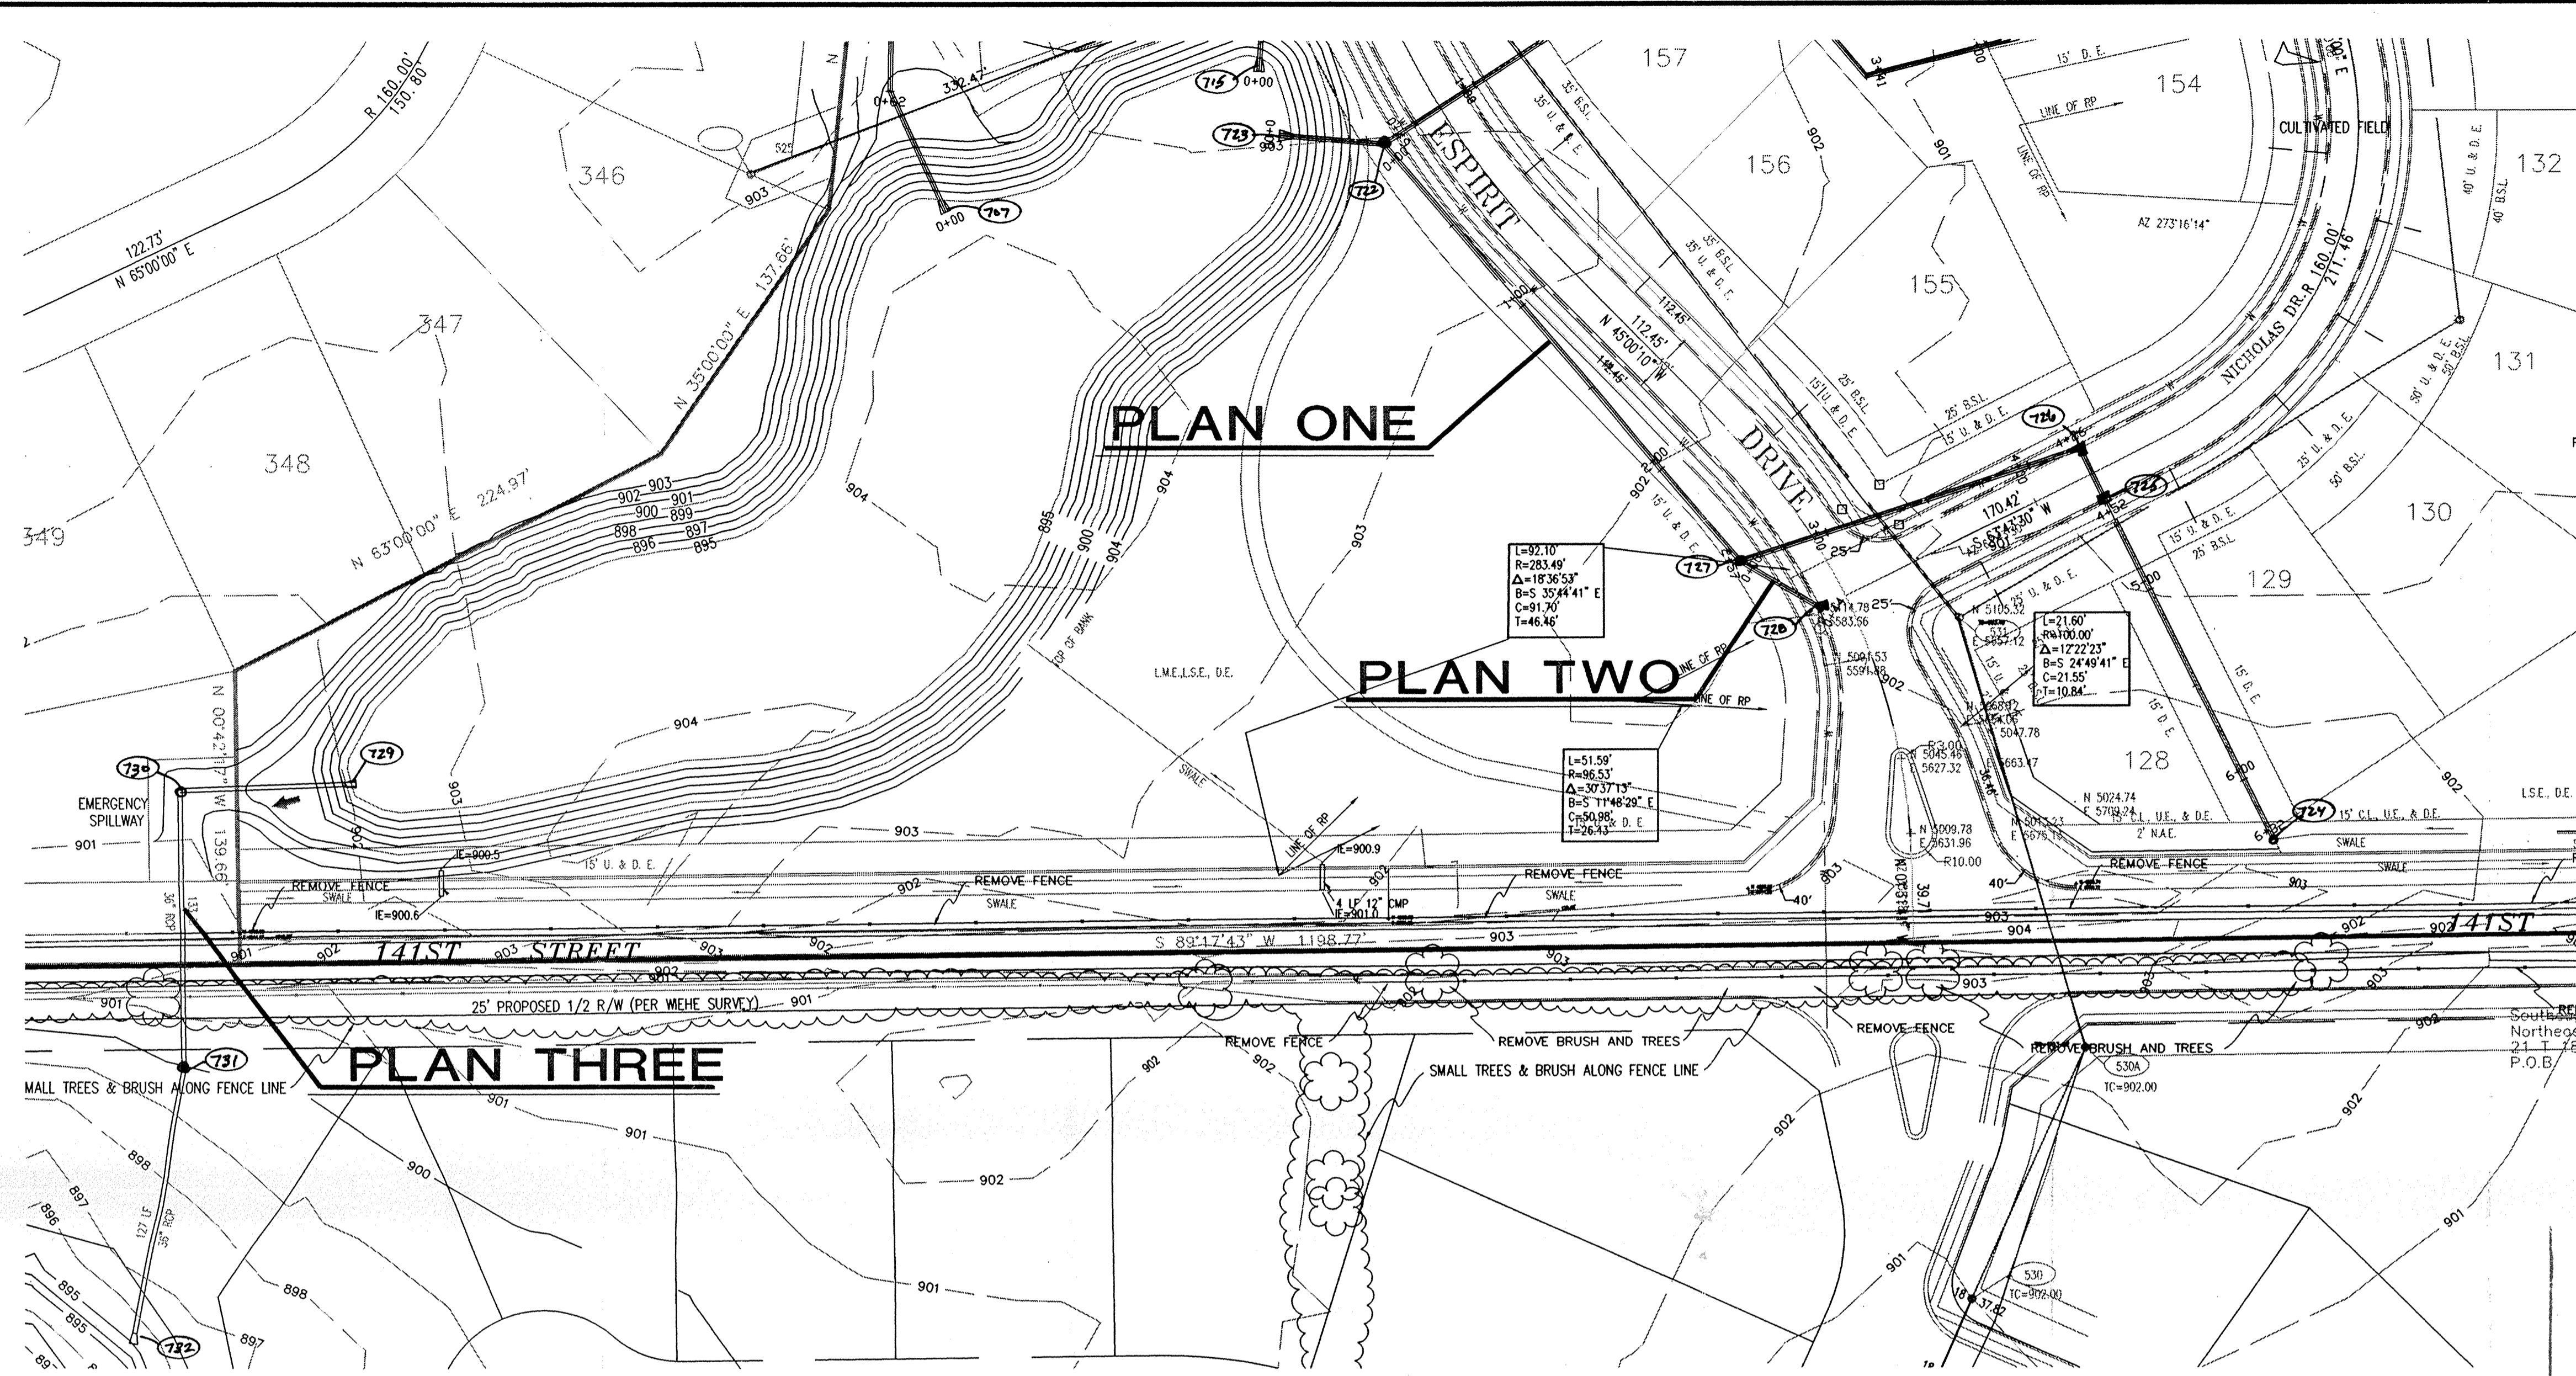

- NOTES:
1. CUTS OR FILLS SHOWN ARE APPROXIMATE, TAKEN FROM EXISTING GRADE TO PROPOSED GRADE TO TOP OF CURB.
  2. OCCUPATIONAL SAFETY AND HEALTH ADMINISTRATION (OSHA) STANDARDS FOR EXCAVATIONS; FINAL RULE 29 CFR PART 1926, SUBPART "P" APPLIES TO ALL EXCAVATIONS EXCEEDING FIVE (5) FEET IN DEPTH.
  3. PIPE LENGTHS INCLUDE END SECTIONS.
  4. FOR CURB CASTINGS, THE TC ELEVATION IS AT THE TOP OF CURB.
  5. DEBRIS / ANIMAL GUARD TO BE ADDED TO ALL END SECTIONS.
- IT SHALL BE THE RESPONSIBILITY OF THE CONTRACTOR TO COMPLY WITH THE ABOVE STATED REQUIREMENTS.



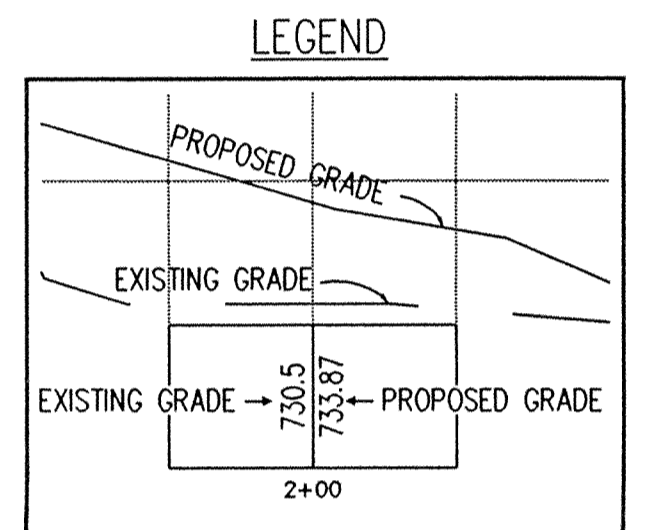
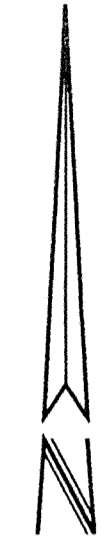


GRANULAR BACKFILL

This information was gathered for input into the Hamilton County Geographical Information System. This document is considered an official record of the GIS.

Entry Date: 9/14/00

Entered by: SLM/JPH 6/21/00

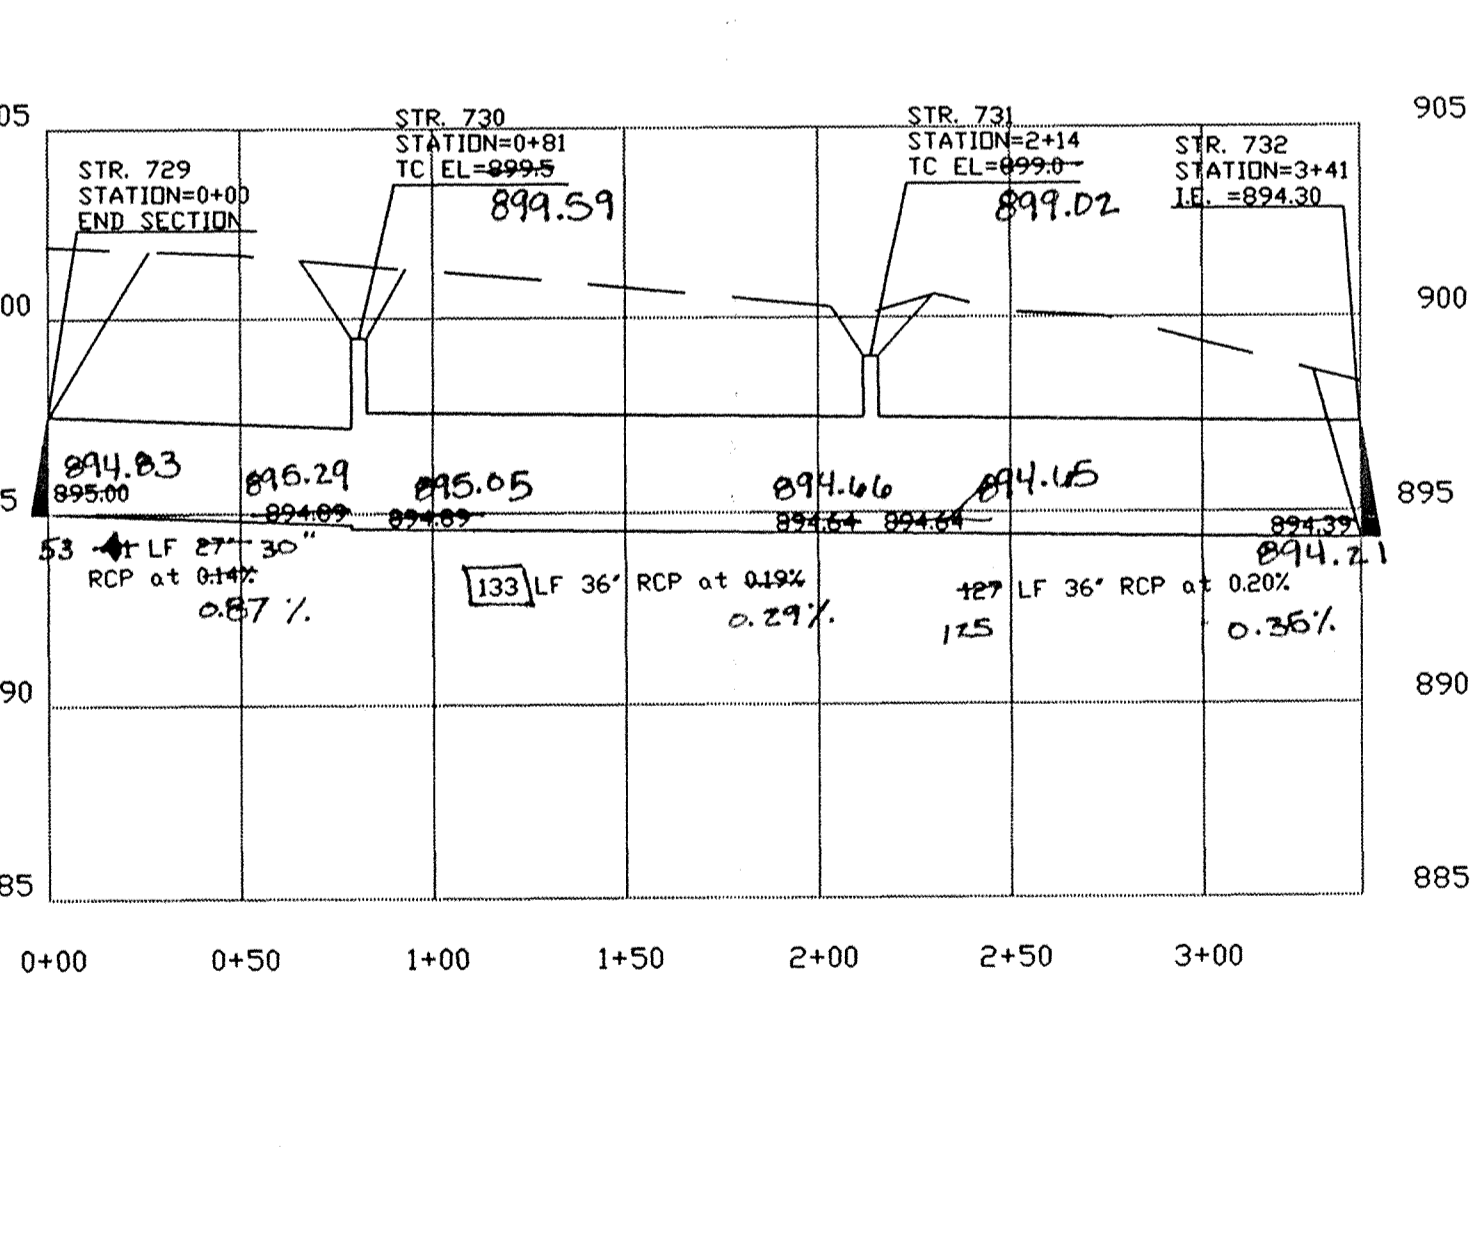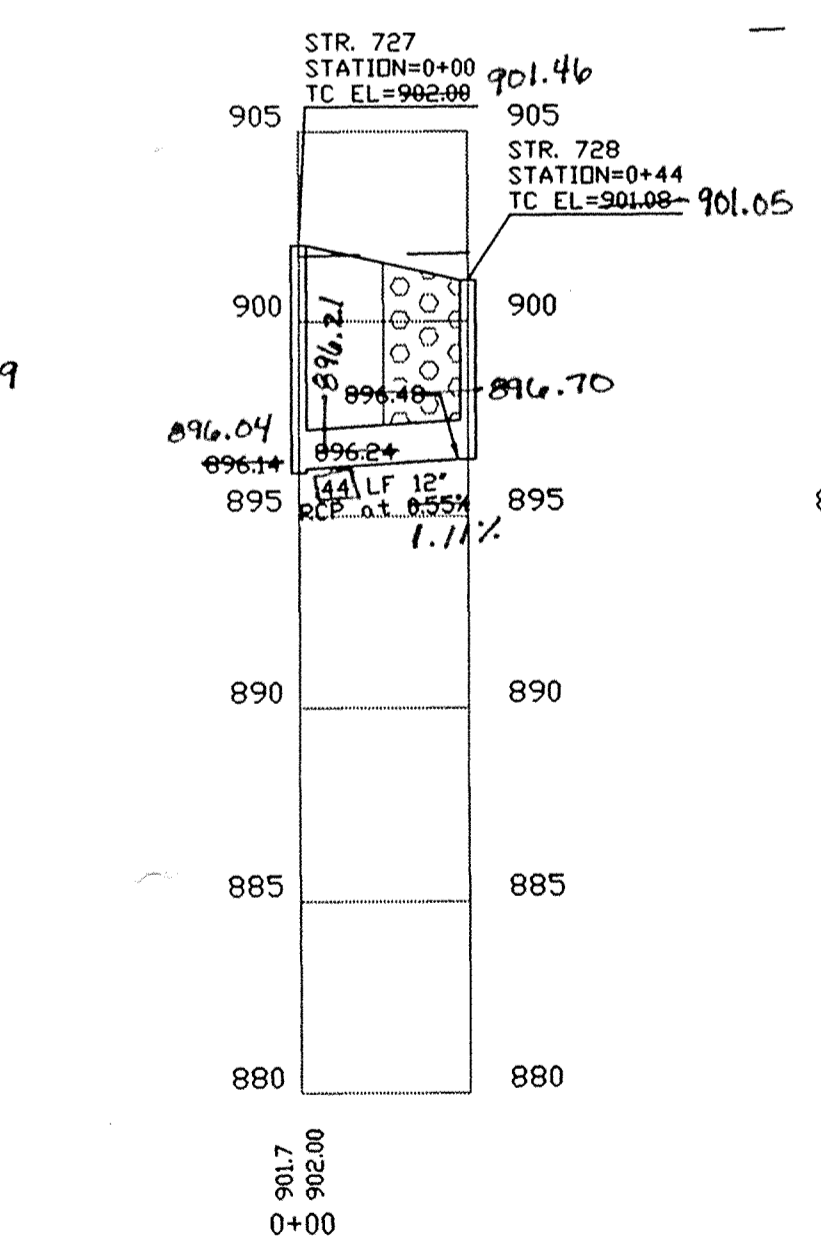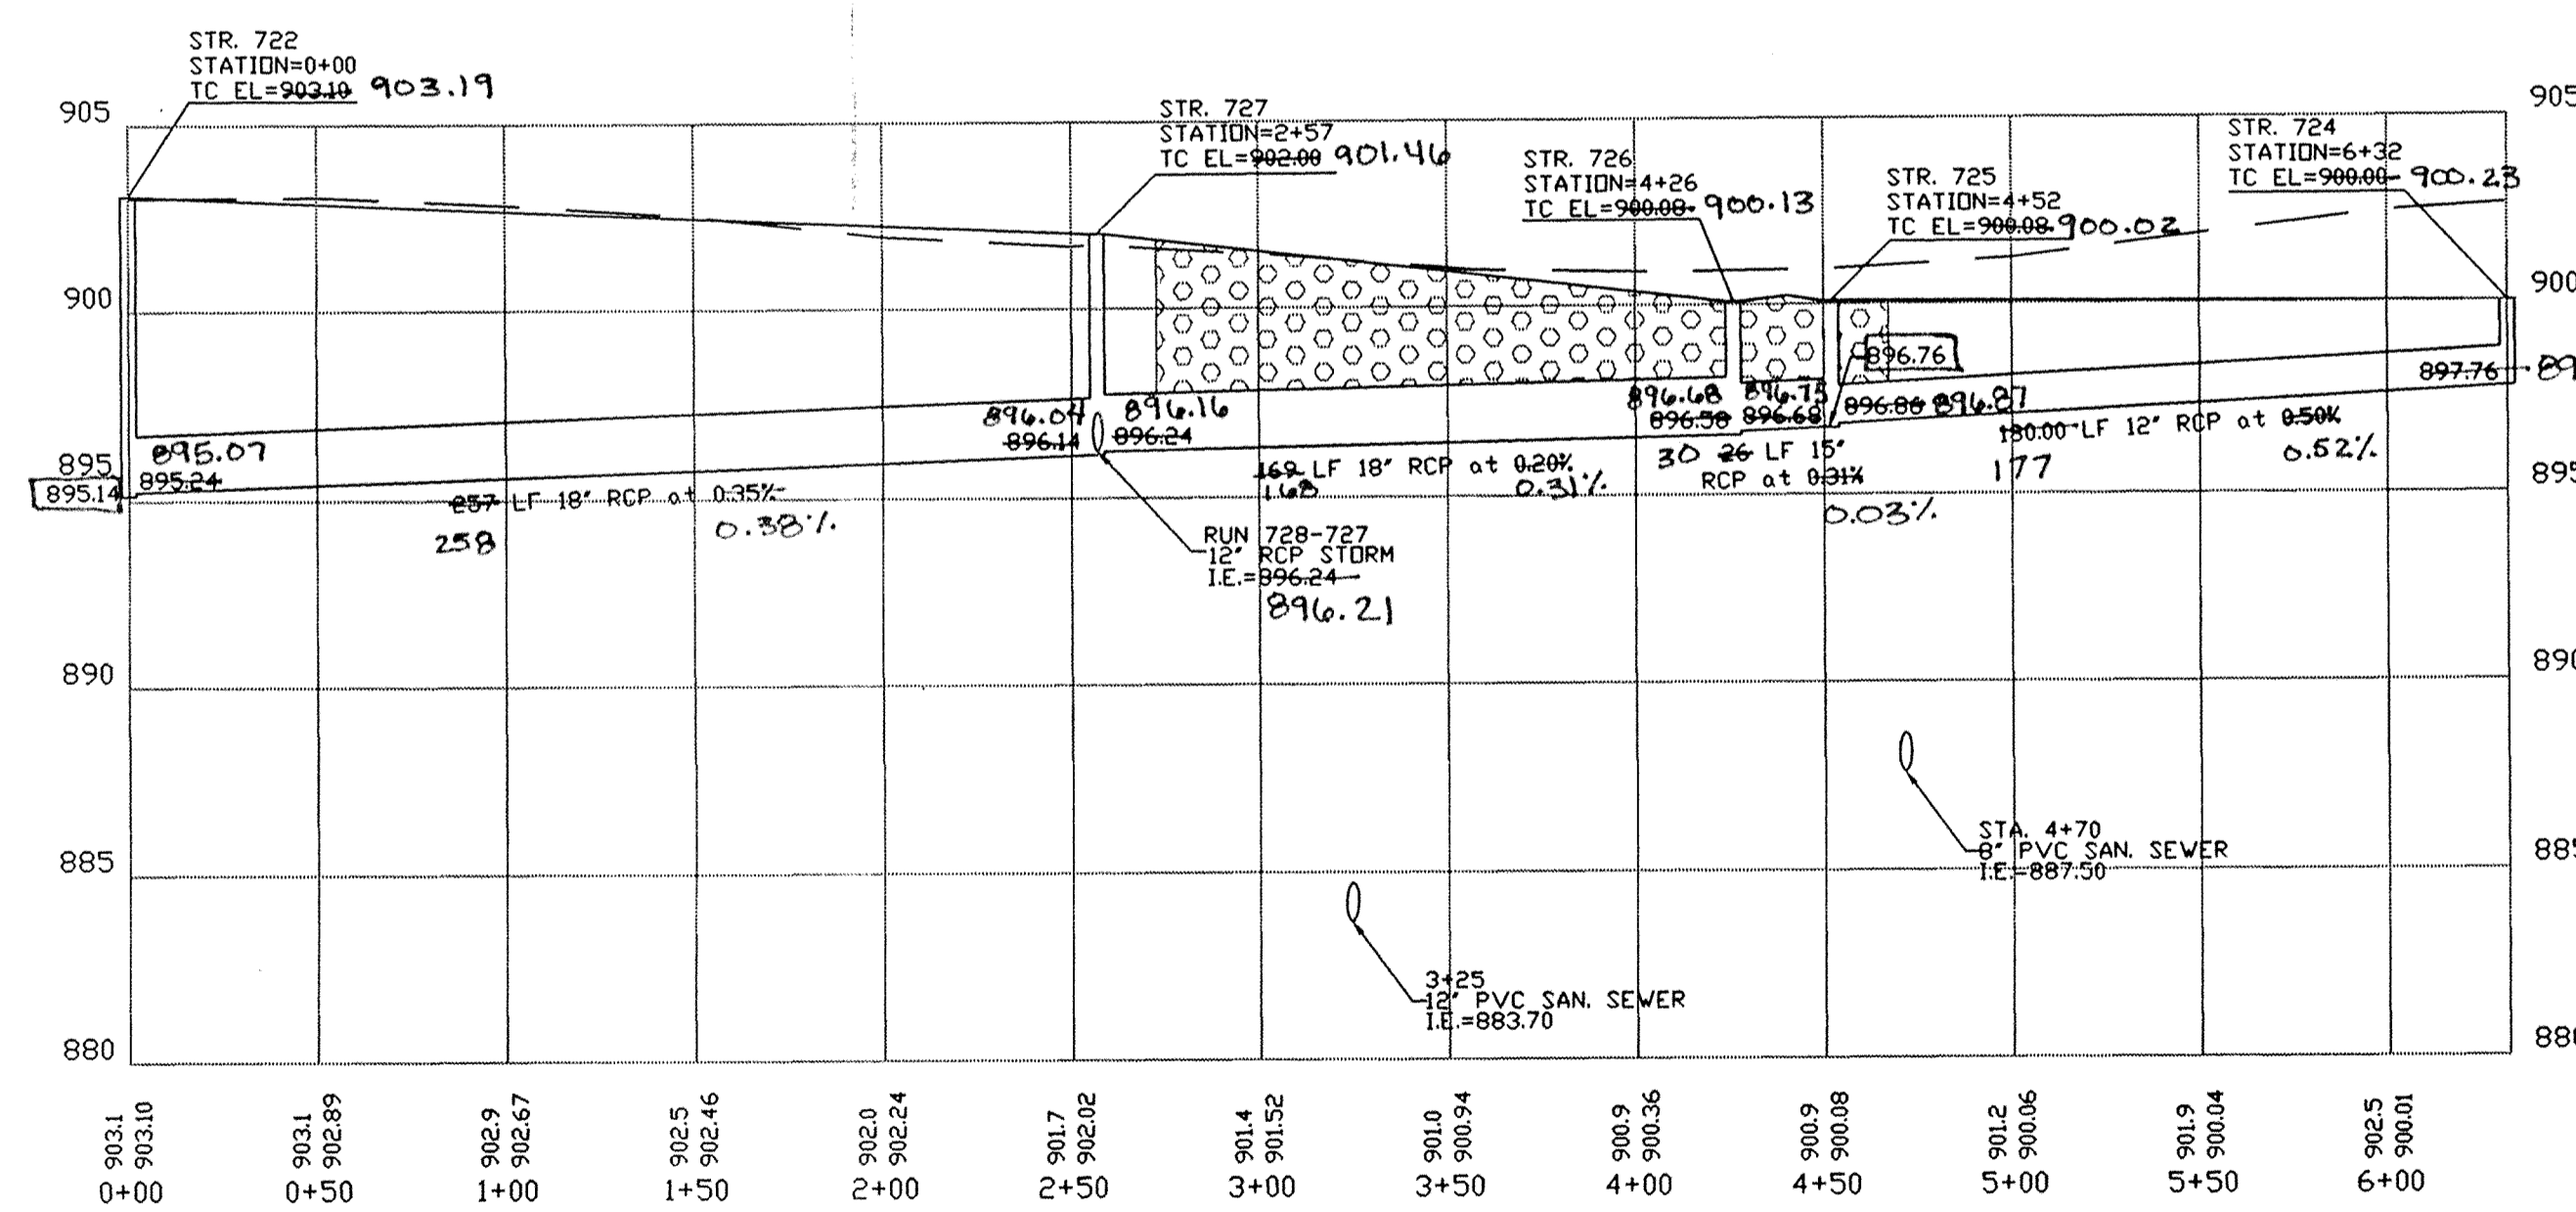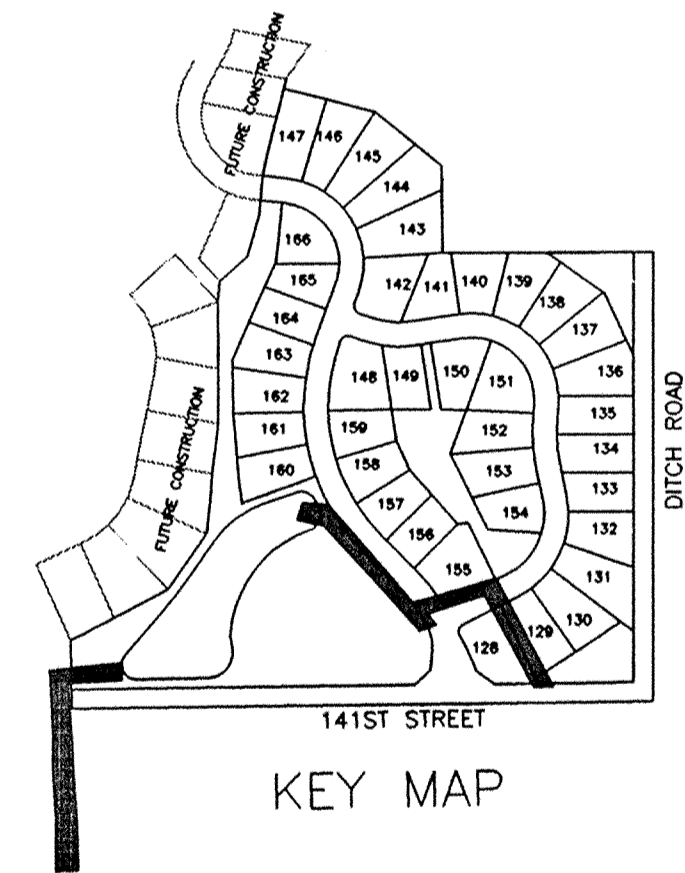

PROFILE ONE

PROFILE TWO

PLAN THREE

AS BUILT  
date 8/20/99

SADDLE CREEK SEC. 5



CERTIFIED BY:

REVISIONS	8/21/97 ADDED NOTE NO. 5
	8/27/97 REVISED RUN 729-732
	9/9/97 REVISE PIPE SIZE 729-730

DATE :

REVISIONS

REVISIONS	
-----------	--



**PAUL I. CRIFE, INC.**

7172 GRAHAM ROAD  
INDIANAPOLIS, INDIANA 46250  
(317) 842-6777

• CIVIL ENGINEERING  
• LAND SURVEYING  
• ARCHITECTURE  
• LAND PLANNING

QUALITY ASSURANCE:

DATE: 08-05-97

SCALE: HORZ. 1"=50'  
VERT. 1"=5'

DRAWING TITLE:  
**STORM SEWER  
PLAN & PROFILE**

DWG. TYPE	FILE NUMBER
JOB NUMBER	
960324-2000	

SHEET:  
**C703**