



**Drain:** THOMAS HUSSEY **Drain #:** 95  
**Improvement/Arm:** POLLACK RECONSTRUCTION  
**Operator:** J. LIVINGSTON **Date:** 1-27-04  
**Drain Classification:** Urban/Rural **Year Installed:** 1981

### GIS Drain Input Checklist




- Pull Source Documents for Scanning
- Digitize & Attribute Tile Drains
- Digitize & Attribute Storm Drains
- Digitize & Attribute SSD
- Digitize & Attribute Open Ditch
- Stamp Plans
- Sum drain lengths & Validate
- Enter Improvements into Posse
- Enter Drain Age into Posse
- Sum drain length for Watershed in Posse
- Check Database entries for errors

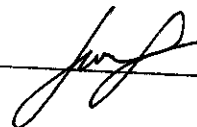

---

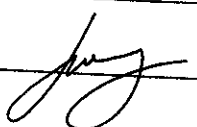
---


---

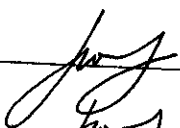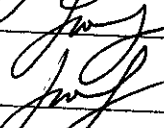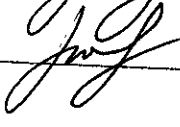

**Gasb 34 Footages for Historical Cost  
Drain Length Log**

Drain-Improvement: THOMAS HUSSEY - POLLACK RECONSTRUCTION

Drain Type:	Size:	Length ( )	Length (DB Query)	Length Reconcile	If Applicable	
					Price:	Cost:
CMPA	54" x 38"	128'	128'		27.13/lf	3477.76

Sum: 128' 128' \$3477.76

Final Report: AL/A

Comments:  
 \_\_\_\_\_  
 \_\_\_\_\_  
SURVEYOR'S OFFICE  
**Hamilton County**

*Kenton C. Ward, Surveyor*

773-6112 Ext. 19


*Noblesville, Ind. 46060* September 29, 1981

To: Hamilton County Drainage Board



Re: Thomas Hussey Drain

Attached are plans for a pipe extension on the Thomas Hussey Drain by Dr. Charles Pollack, owner of lot 108 in Crooked Stick Subdivision. I have examined the site and cannot foresee any problems with the extension. I do however, have the following suggestions:

1. The new pipe match the size of the existing structure,
2. The band used to join the pipe be treated with mastic in such a way that the joint will be water tight,
3. Care should be taken to be sure that the pipe is bedded correctly to prevent settlement and to be sure that the correct grade is maintained.,
4. A metal end section shall be placed at the end of the extended structure and further protected with 9" graded riprap. All disturbed areas shall be properly seeded and fertilized,
5. Pipe shall end at least 20 feet west of the east lot line of lot 108.
6. I shall make an inspection before backfilling and after completion of the work.

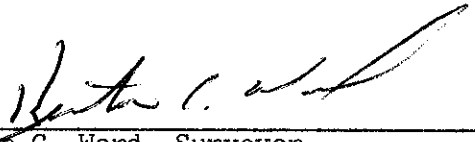  
Kenton C. Ward, Surveyor


KCW/jg

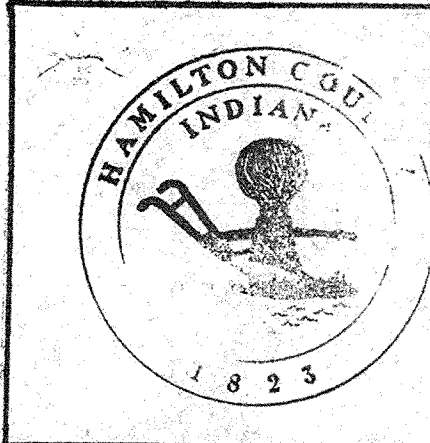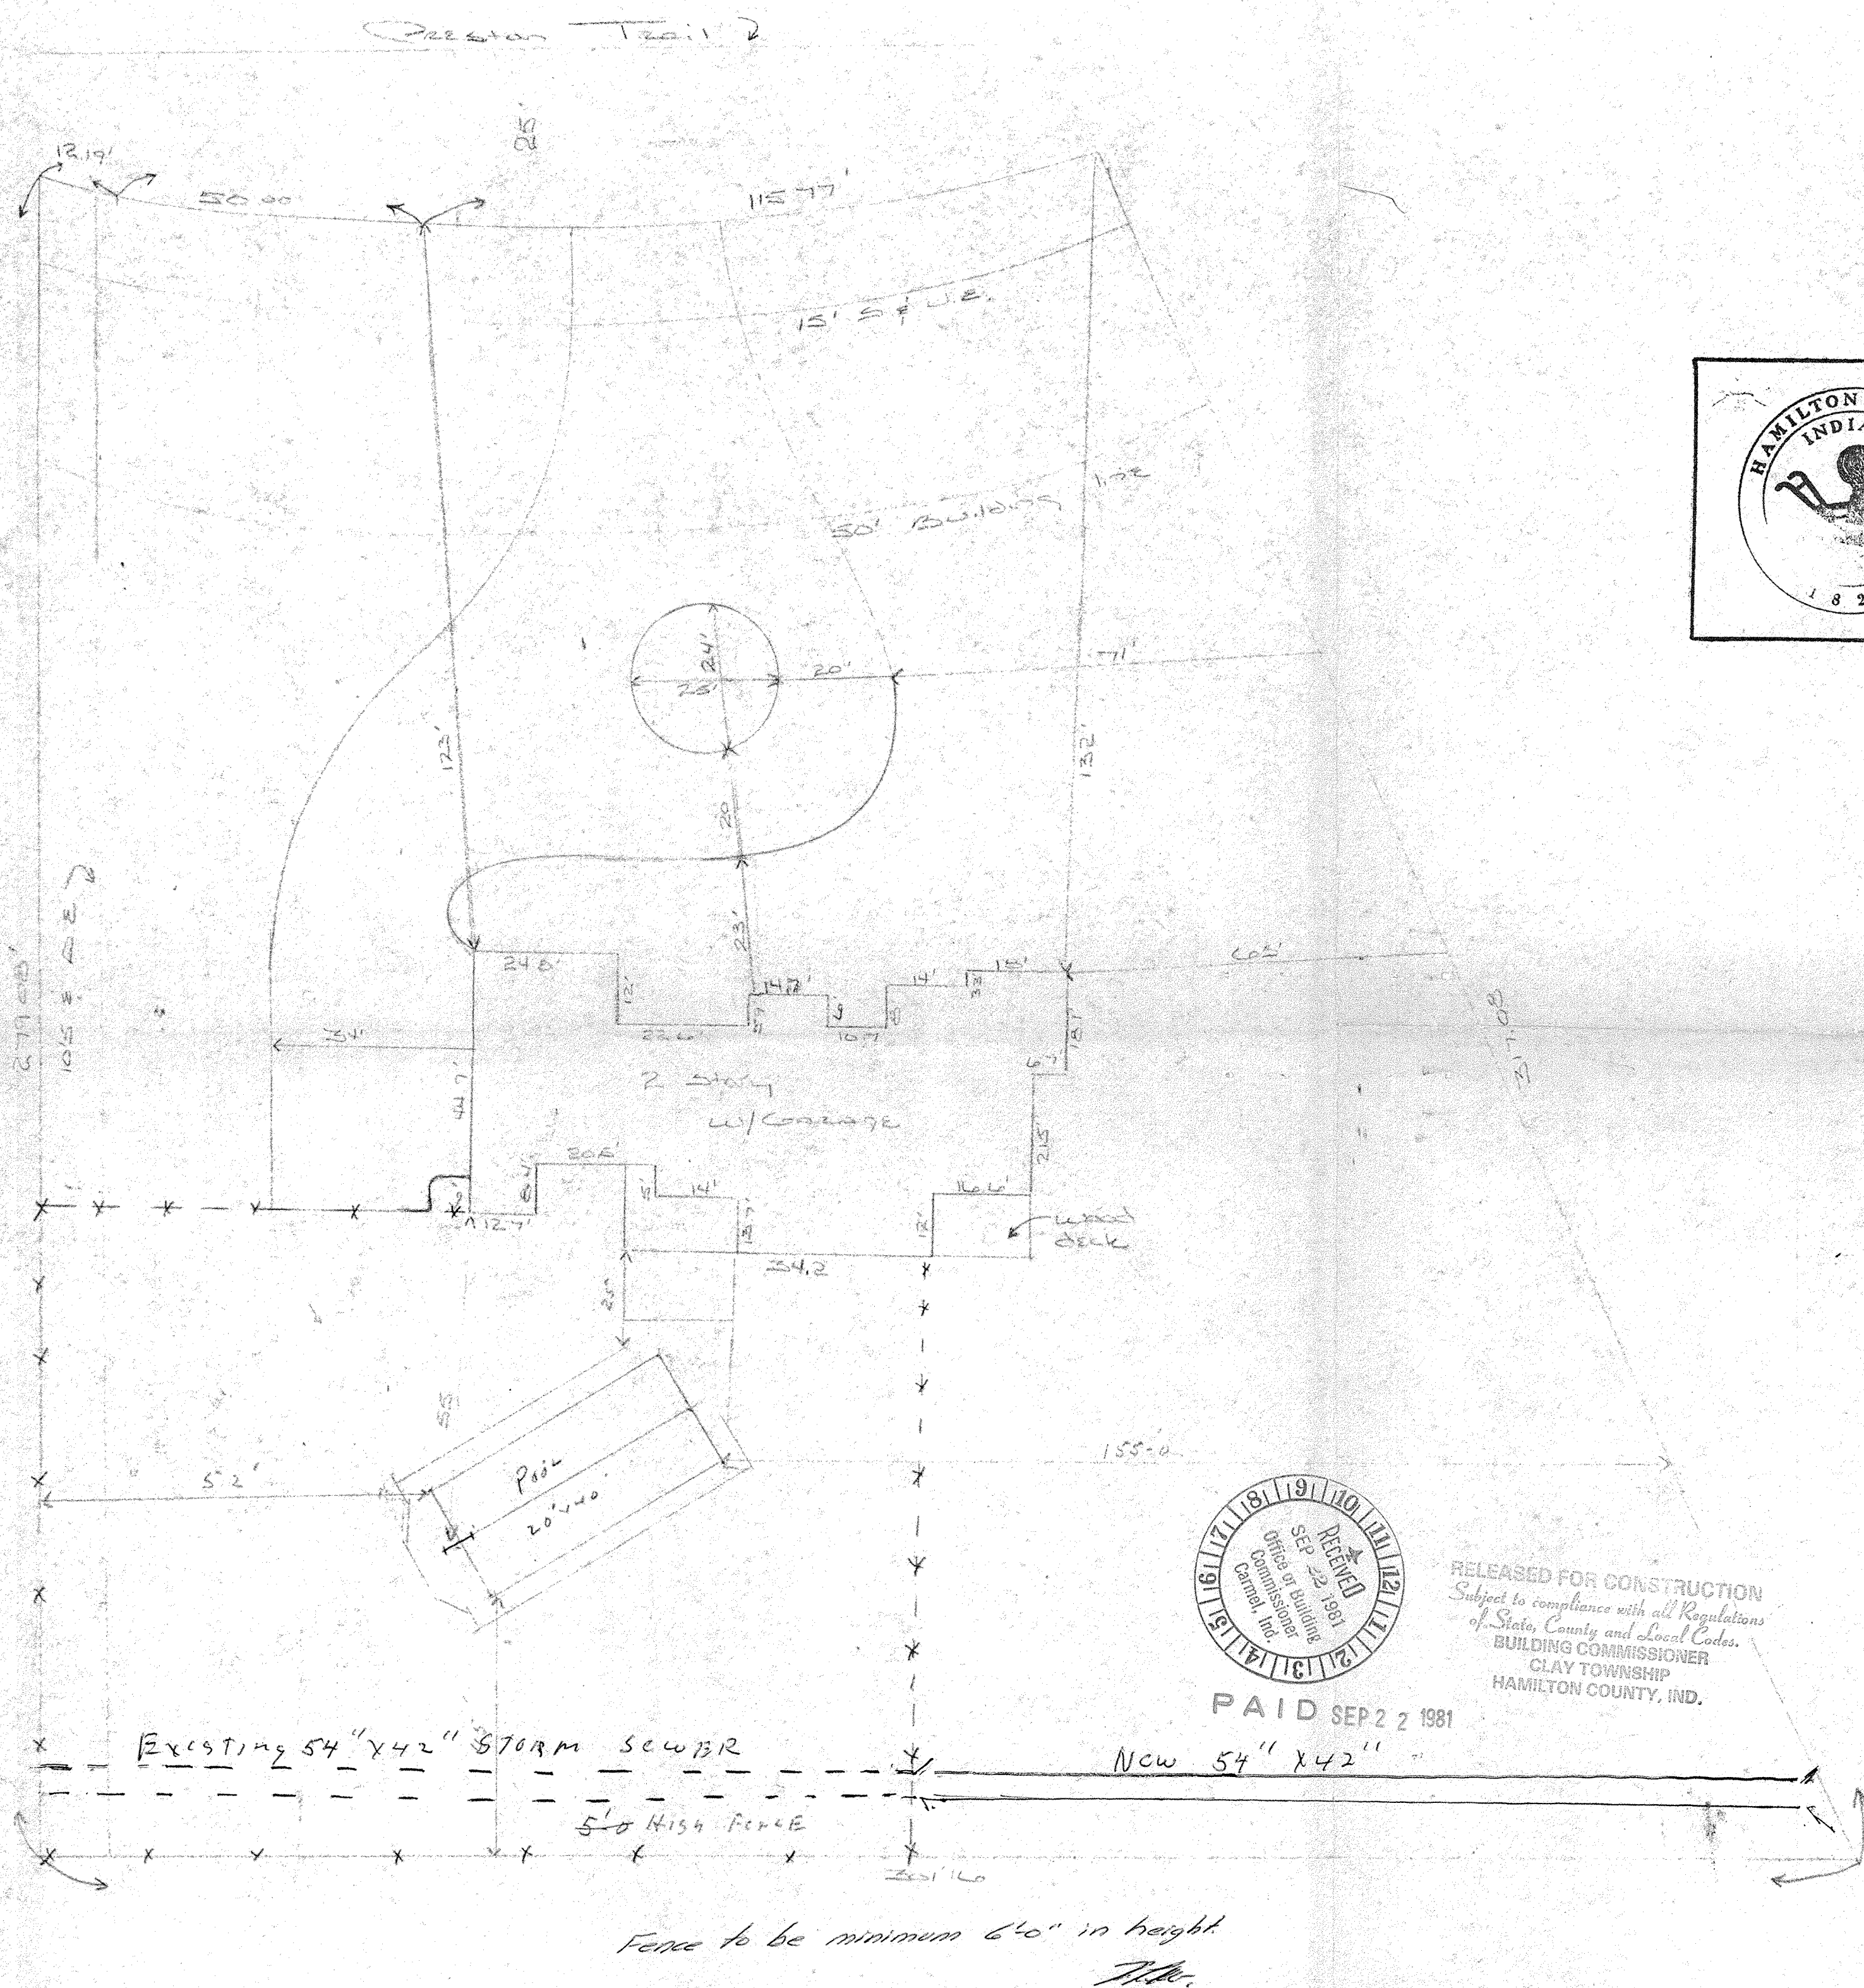

This information was gathered for input into the Hamilton County Geographical Information System. This document is considered an official record of the GIS.


Entry Date: 1-27-04

Entered by: [Signature]

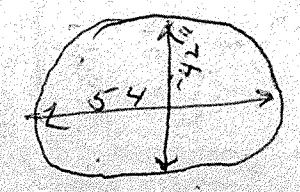

Cross section Pipe

Lot # 108 in  
 Clocked Sixth Estates  
 Section Six  
 Pool - 20' x 40'  
 Decking - 1000 sqft exposed  
 Aggregate

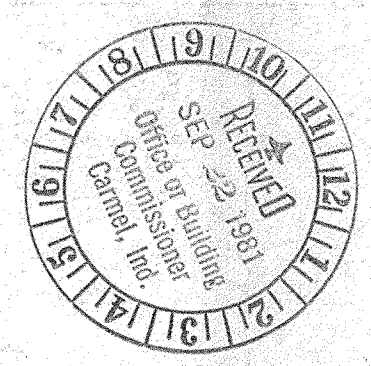

RELEASED FOR CONSTRUCTION  
 Subject to compliance with all Regulations  
 of State, County and Local Codes.  
 BUILDING COMMISSIONER  
 CLAY TOWNSHIP  
 HAMILTON COUNTY, IND.

PAID SEP 22 1981

Existing 54" x 42" STORM SEWER      New 54" x 42"

Fence to be minimum 6'0" in height  
 M.H.

D/E Mrs. C. Pollack		SCALE	DRAWN BY
1471 Preston Tr		1" = 30'	[Signature]
Contractor:		REVISED	
Trem Pool Co Inc.		DATE	DRAWING NUMBER
9/10/01		APPROVED BY	