

Kenton C. Ward, CFM
Surveyor of Hamilton County
Phone (317) 776-8495
Fax (317) 776-9628

Suite 188
One Hamilton County Square
Noblesville, Indiana 46060-2230

December 28, 2012

To: Hamilton County Drainage Board

Re: Williams Creek Drain, Towne Road 131st to 146th Reconstruction

Attached are petition, plans, and other information for the proposed reconstruction of the Williams Creek Drain, for the Towne Road from 131st to 146th Reconstruction. The reconstruction was petitioned by the City of Carmel. During the road reconstruction, the Williams Creek Drain – Saddle Creek – Section 10 & 11 Arm was affected. Those changes are as follows:

Williams Creek Drain

Williams Creek Drain – Saddle Creek Section 10 & 11 Arm: The project will replace the existing 23 feet of twin 24" RCP pipes, Structures 847 to 848 per the plans for Saddle Creek Section 10 & 11 prepared by Stooppelwerth & Associates, having Job Number 42611, and date of 3-29-02. This will be replaced with 146 feet of twin 18" RCP, shown as Structures 403 and 404 on the road project plans. The project also removed 76 feet of 12" pipe from Str. 852A to Str. 853 and replaced it with 80 feet of 18" RCP from Str. 414 to 310 on the road plans. This will add 123 feet of twin pipe and 4 feet of single pipe to the length of this arm. This is shown on Sheets 26 and 27 of the plans prepared by American Structurepoint, Inc., having City of Carmel Project Number 11-02, and dated February 10, 2011.


Williams Creek Drain – Saddle Creek Towne Road Extension: The project added a pipe under Towne Road for future drainage of the watershed West of Towne Road, north of Lincolnshire Subdivision to the watershed break near 151st Street. This pipe is only 2 manhole and 104 feet of 36" pipe under the roadway at this time, but will be extended as development on the southeast, southwest, and northwest corners of 146th Street and Towne Road happens. This will add 104 feet to the Williams Creek Drain. This is shown on Sheet 28 of the plans prepared by American Structurepoint, Inc., having City of Carmel Project Number 11-02, and dated February 10, 2011.

The road project will add 231 feet to the total length of the Williams Creek Drain.

The cost of the reconstruction is to be paid by the City of Carmel. Because the project is to be paid by the petitioner and is being completed within the right of way owned by the City of Carmel, the project falls under the requirements as set out in IC 36-9-27-52.5. Therefore, a hearing with 30 day notice is not required for the petition.

I recommend the Board approve the project at this time.

Sincerely,

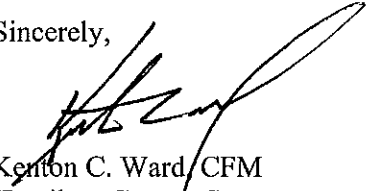

Kenton C. Ward, CFM
Hamilton County Surveyor

KCW/pll

**Gasb 34 Asset Price &
Drain Length Log**

Drain-Improvement: 131st St to 146th St : Town Rd Reconst.

Drain Type:	Size:	Length	Length (DB Query)	Length Reconcile	If Applicable	
					Price:	Cost:
RCP	18"	292*	292	∅	\$10.50 LF	\$3066 ⁰⁰
RCP	18"	80'	80'	∅	\$10.50 LF	\$840 ⁰⁰
RCP	36"	104'	104'	∅	\$32.25 LF	\$3354 ⁰⁰
Sum:		<u>330'</u>	<u>330'</u>	<u>∅</u>		<u>\$7,260⁰⁰</u>

Final Report: N/A

Comments:
* 146' of twin pipe

HAMILTON COUNTY DRAINAGE BOARD
NOBLESVILLE, INDIANA

IN RE: _____)
Hamilton County, Indiana)

PETITION FOR RELOCATION AND RECONSTRUCTION


_____ The City of Carmel _____ (hereinafter "Petitioner").

hereby petitions the Hamilton County Drainage Board for authority to relocate and improve a section of the _____ Elliott Creek-Lakeside Park Arm _____ Drain, and in support of said petition advises the Board that:

1. Petitioner owns real estate through which a portion of the _____ Elliott Creek-Lakeside Pk Arm _____ Drain runs.
2. Petitioner plans to develop its real estate with roads, buildings, utilities, storm drains, sanitary sewers and other structures.
3. Petitioner's proposed development of its real estate will require relocation and reconstruction of a portion of the _____ Elliott Creek-Lakeside Park Arm _____ Drain, as specifically shown on engineering plans and specifications filed with the Hamilton County Surveyor.
4. The work necessary for the proposed relocation and reconstruction will be undertaken at the sole expense of the Petitioner and such work will result in substantial improvement to the _____ Elliott Creek-Lakeside Park Arm _____ Drain, without cost to other property owners on the watershed of the _____ Elliott Creek-Lakeside Park Arm _____ Drain.
5. Proposed relocation and reconstruction will not adversely affect other land owners within the drainage shed.
6. Petitioner requests approval of the proposed relocation and reconstruction under IC 36-9-27-52.5.

WHEREFORE, Petitioner requests that an Order issued from the Hamilton County Drainage Board authorizing relocation and reconstruction of the _____ Elliott Creek-Lakeside Park Arm _____ Drain, in conformance with applicable law and plans and specifications on file with the Hamilton County Surveyor.

Mike McBride
Signed
Mike McBride
Printed

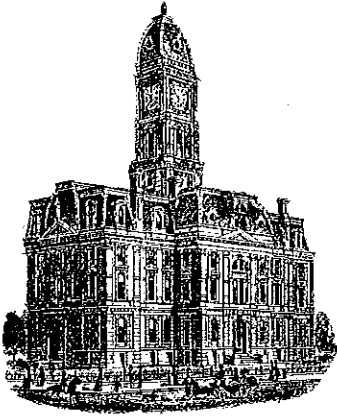

Kenton C. Ward, CFM
Surveyor of Hamilton County
Phone (317) 776-8495
Fax (317) 776-9628

Suite 188
One Hamilton County Square
Noblesville, Indiana 46060-2230

To: Hamilton County Drainage Board

August 27, 2013

Re: Williams Creek Drain – Towne Rd 131st to 146th St Reconstruction

Attached are as-builts, certificate of completion & compliance, and other information for Towne Rd 131st to 146th Street Reconstruction. An inspection of the drainage facilities for this section has been made and the facilities were found to be complete and acceptable.

During construction, changes there were no significant changes made to the drainage plans submitted with my report for this drain dated December 28, 2012. The report was approved by the Board at the hearing held July 8, 2013. Therefore, the length of the drain remains at **330 feet**. It should be noted that the project removed 99 feet of existing drain. Therefore, there was 231 feet of drain added to the overall length of the watershed.

All the work was done within right of way or existing drainage easement. Therefore, no additional drainage easements were required. The project was paid for by the City of Carmel. Subsequently, no sureties were required.

I recommend the Board approve the drain's construction as complete and acceptable.


Sincerely,

Kenton C. Ward, CFM
Hamilton County Surveyor

KCW/slm

CITY OF CARMEL PROJECT NO. 11-02

TOWNE ROAD 131st Street to 146th Street

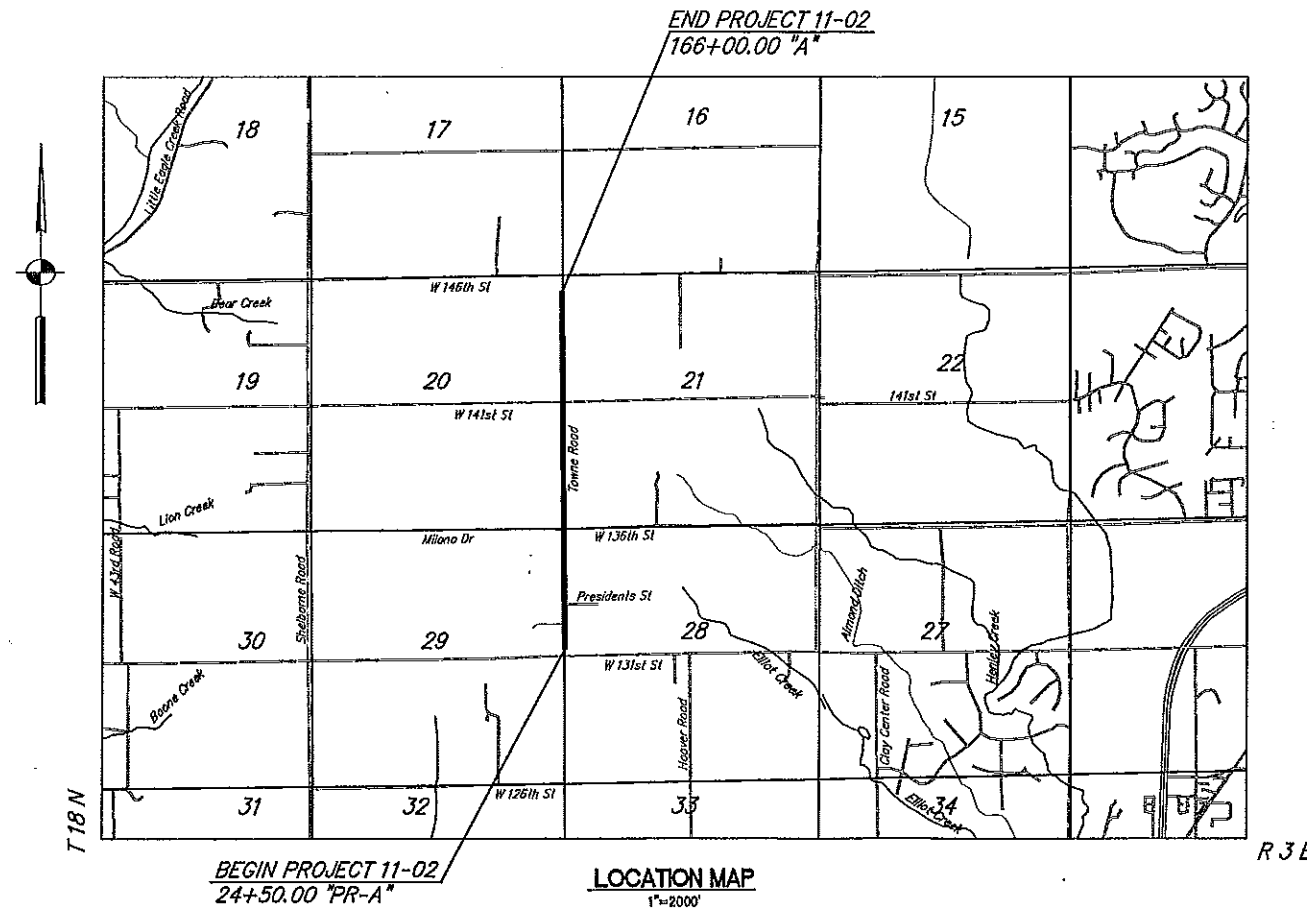

INDIANA DEPARTMENT OF TRANSPORTATION
STANDARD SPECIFICATIONS DATED 2010
TO BE USED WITH THESE PLANS

PROJECT LETTING DATE: 03-02-2011

APPROVED BY:
BOARD OF PUBLIC WORKS AND SAFETY

JAMES BRAINARD, MAYOR - CHAIRMAN
MARY ANNE BURKE - MEMBER
LORI WATSON - MEMBER

This information was gathered for input into the Hamilton County Geographic Information System (GIS). This document is considered an official record of the GIS.

Entry Date: August 2013

Entered By: SLM



OWNER
CITY OF CARMEL
ONE CIVIC SQUARE
CARMEL, INDIANA 46032
(317) 571-2400

TOPOGRAPHIC SURVEY BY:
FIRM NAME: AMERICAN STRUCTUREPOINT
ADDRESS: 7260 SHADELAND STATION
CITY/STATE: INDIANAPOLIS, IN
PHONE: 317-547-5580
CONTACT: SAM BALOG


HOLEY MOLEY SAYS
"DON'T DIG BLIND"



"IT'S THE LAW"
CALL 2 WORKING DAYS BEFORE YOU DIG
1-800-382-5544
CALL TOLL FREE
PER INDIANA STATE LAW IS-89-199L
IT IS AGAINST THE LAW TO EXCAVATE
WITHOUT NOTIFYING THE UNDERGROUND
LOCATION SERVICE TWO (2) WORKING
DAYS BEFORE COMMENCING WORK.

PLANS PREPARED BY:

AMERICAN
STRUCTUREPOINT
INC.
7260 SHADELAND STATION
INDIANAPOLIS, IN 46256-3957
TEL 317.547.5580 FAX 317.543.0270
www.structurepoint.com



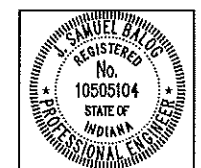


S. Samuel Balog 02-10-2011
CERTIFIED BY: DATE


DESIGNED: JSB	CHECKED: MJM
DRAWN: MJM	CHECKED: JSB

FINAL
CONSTRUCTION
DOCUMENTS

PROJECT NO. 11-02 - TOWNE ROAD

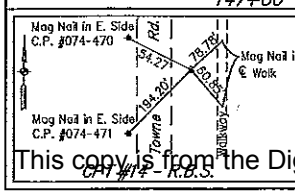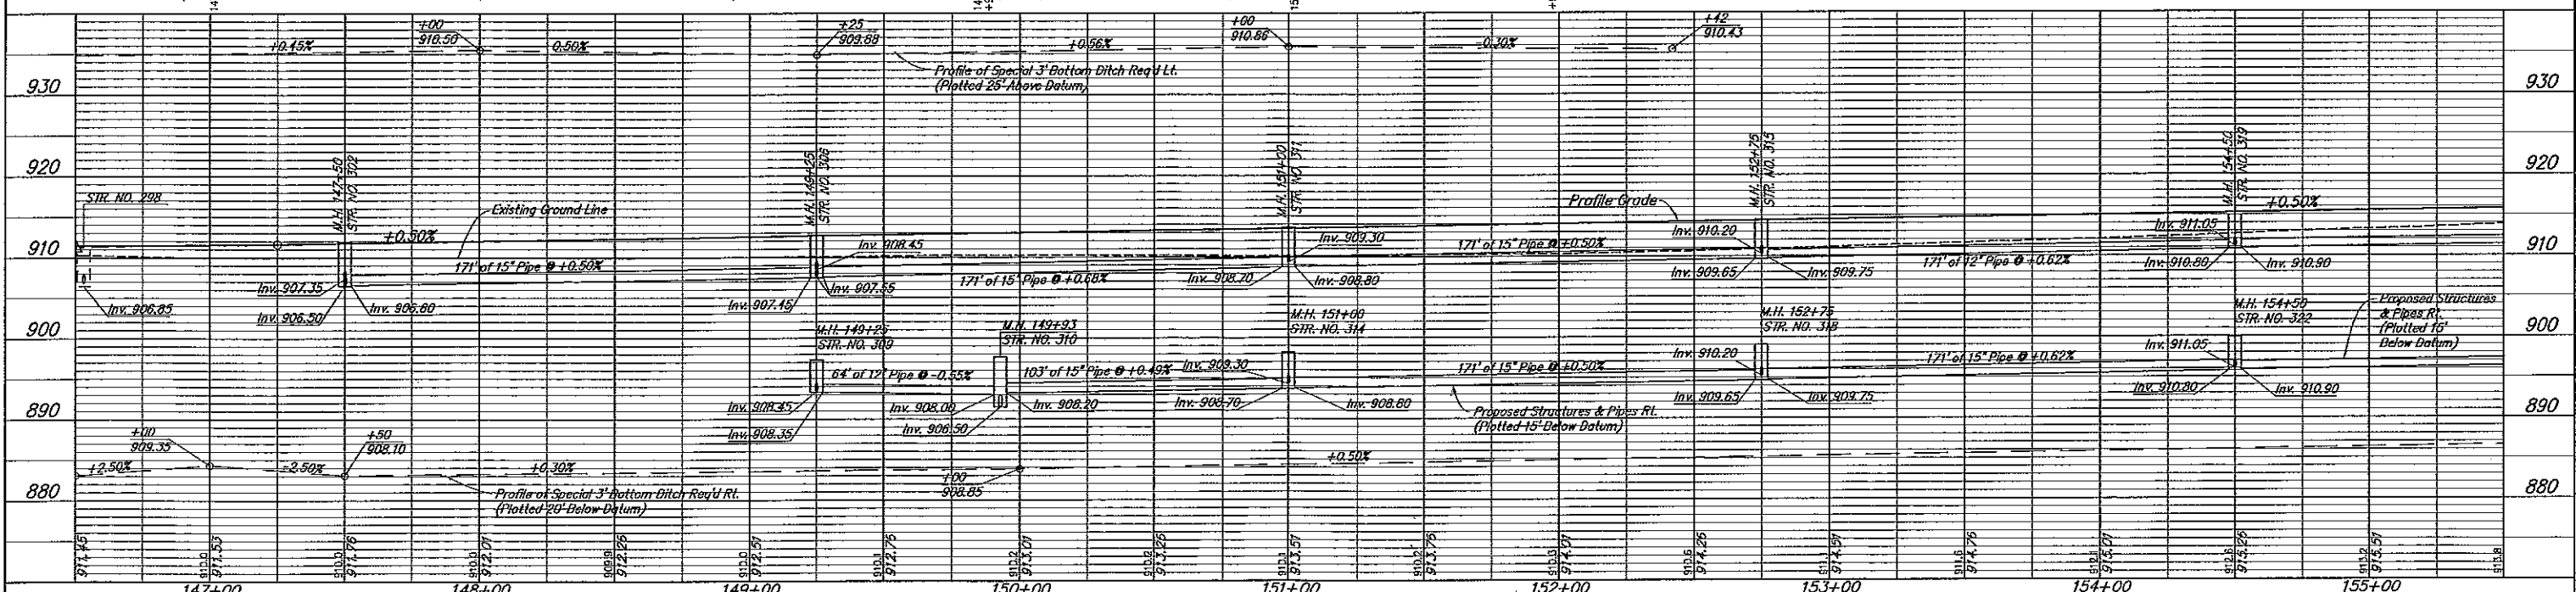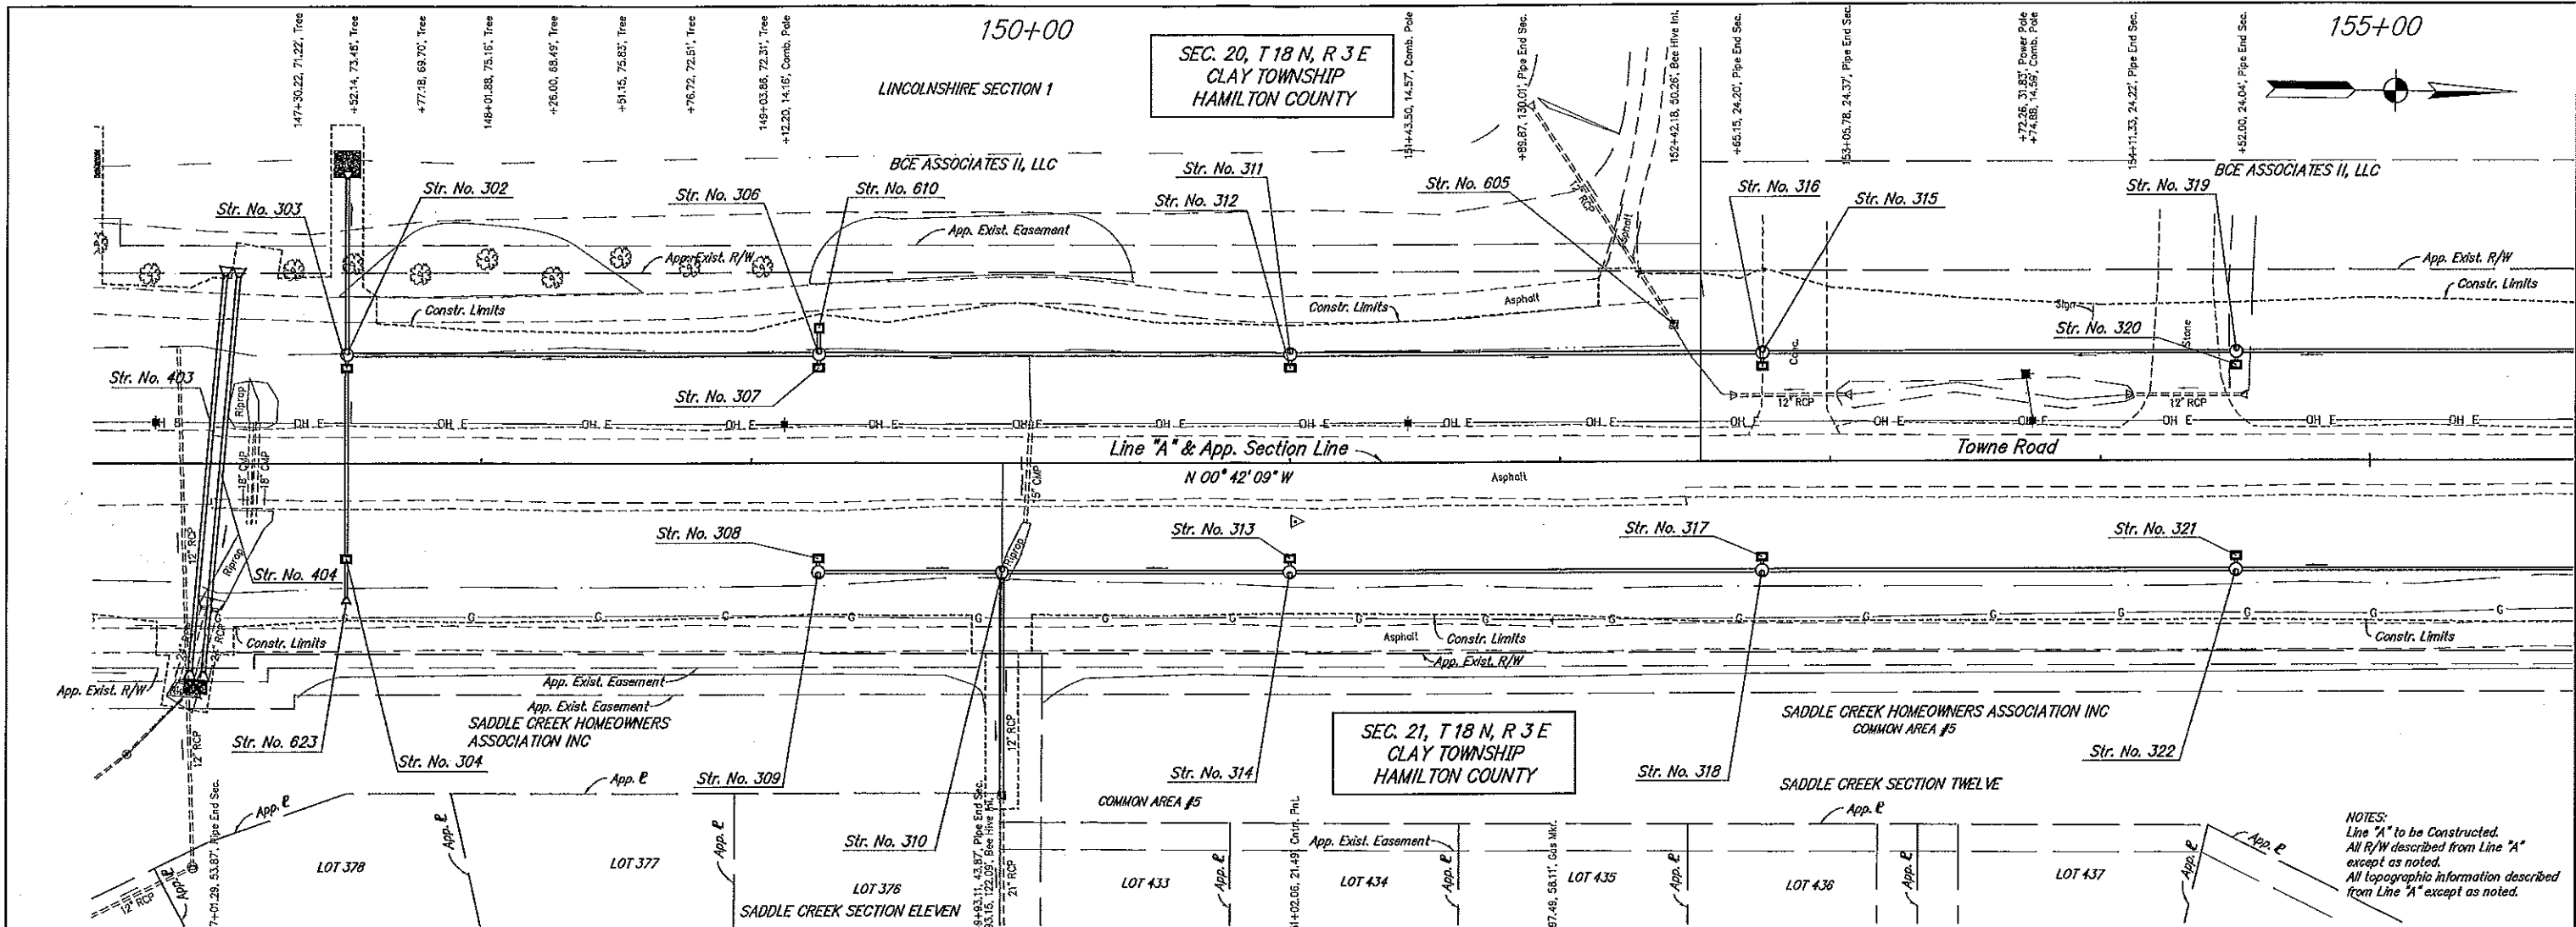

This copy is from the Digital Archive of the Hamilton County Surveyor's Office; Noblesville, In 46060
 2/11/2011 8:42:58 AM P:\N2004\0222\0. Drawings\N2004.0222.RD.PH2.PP08.dgn

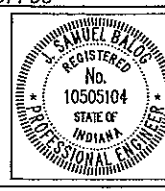

RECOMMENDED FOR APPROVAL: J. Samuel Balog, DESIGN ENGINEER, 02-10-2011 DATE
 DESIGNED: M.J.M. DRAWN: M.J.M.
 CHECKED: JSB CHECKED: JSB


CITY OF CARMEL
 PLAN AND PROFILE
 LINE "A"

HORIZONTAL SCALE 1" = 30'	BRIDGE FILE
VERTICAL SCALE 1" = 10'	DESIGNATION NO.
SURVEY BOOK	SHEETS
CONTRACT	16 of 116
	PROJECT NO. 11-02

156+00

160+00


SEC. 20, T 18 N, R 3 E
CLAY TOWNSHIP
HAMILTON COUNTY

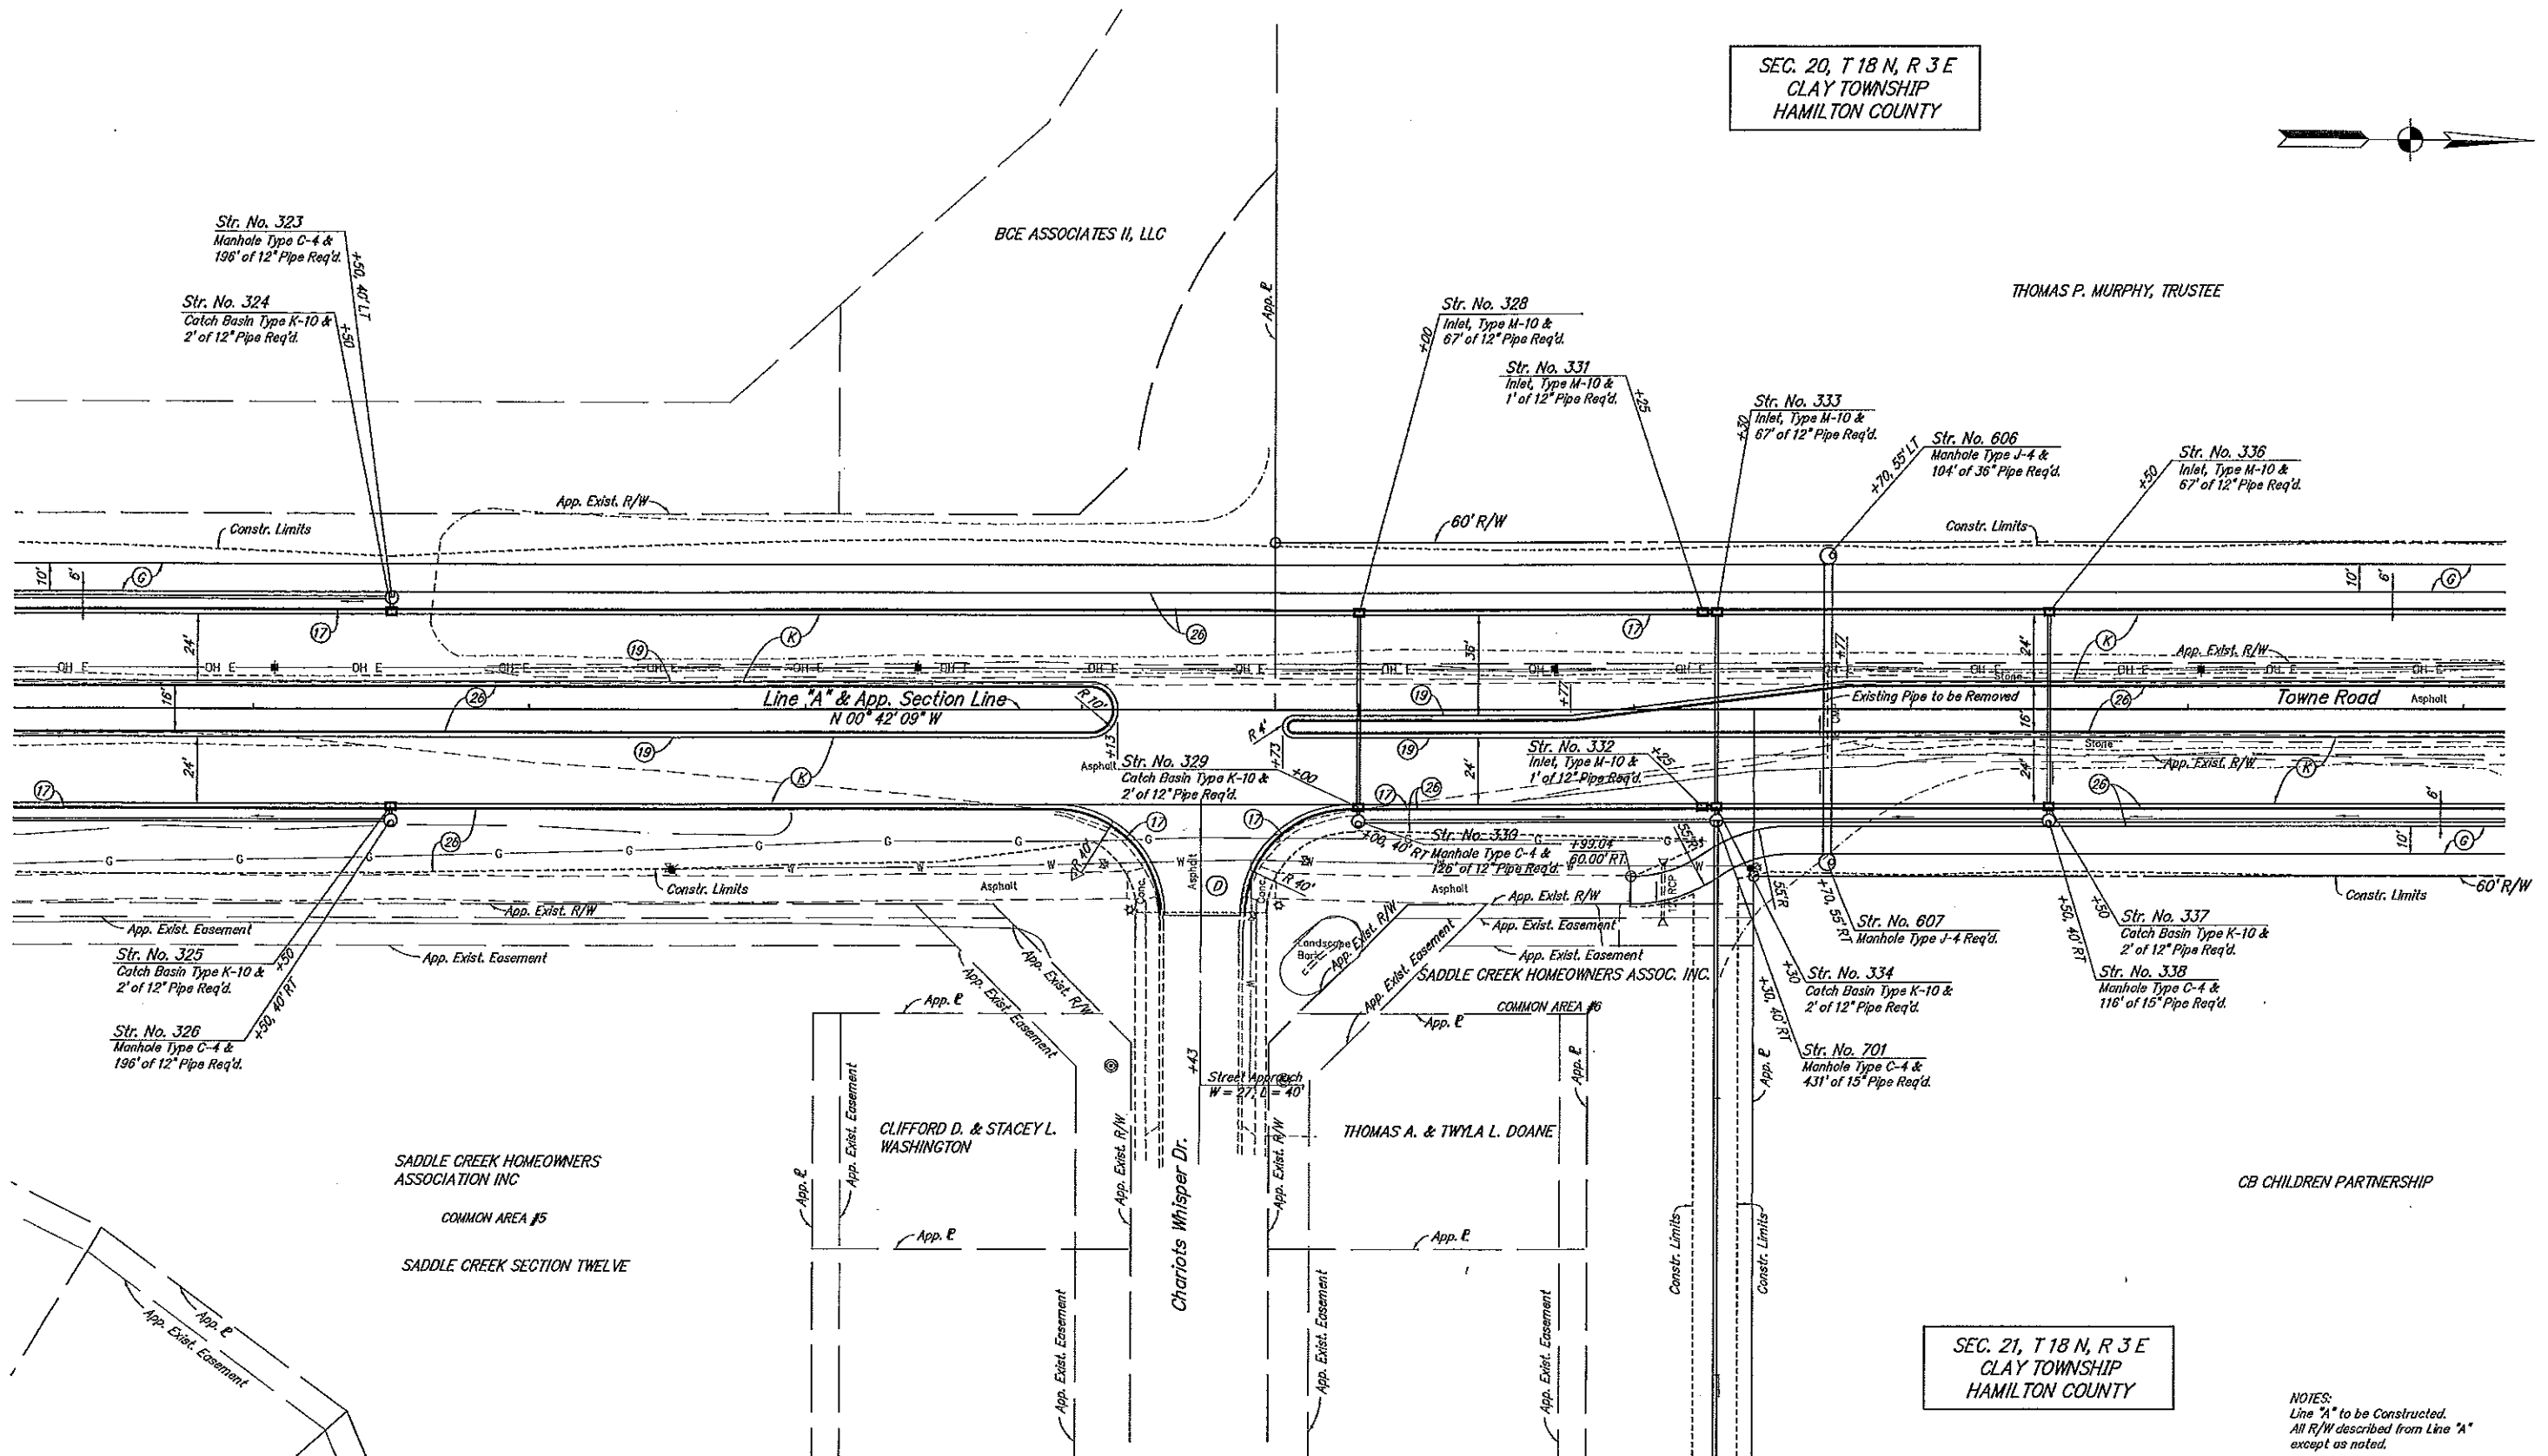

SEC. 21, T 18 N, R 3 E
CLAY TOWNSHIP
HAMILTON COUNTY

NOTES:
Line "A" to be Constructed.
All R/W described from Line "A"
except as noted.

(C) 6" PCOP for Approaches on 6" Compacted Aggregate, No. 53	(K) Full Depth HMA Pavement (See Typical Sections)	(17) Curb and Gutter Type II	(M) Mailbox Assembly
(D) 165#/Syd. HMA Surface, Type "A" on 275#/Syd. HMA Intermediate, Type "A" on 8" Compacted Aggregate Base, No. 53	(O) Compacted Aggregate Base, No. 53	(19) Curb and Gutter Type III	(R) 165#/Syd HMA Surface Type "C" on Variable Depth, HMA Intermediate Type "C"
(E) Concrete Sidewalk	(P) 165#/Syd HMA Surface Type "C" on 1.5" Asphalt Milling	(20) Sodding	(22) 12" Compacted Aggregate Base, No. 73
(F) Multi-Use Path (See Typical Sections)			

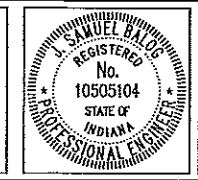

RECOMMENDED FOR APPROVAL	<i>J. Samuel B. Jones</i>	DESIGN ENGINEER	DATE
DESIGNED:	MJM	DRAWN:	MJM
CHECKED:	JSB	CHECKED:	JSB

CITY OF CARMEL

CONSTRUCTION DETAILS
LINE "A"


HORIZONTAL SCALE	BRIDGE FILE
1" = 30'	
VERTICAL SCALE	DESIGNATION NO.
SURVEY BOOK	SHEETS
	28 of 116
CONTRACT	PROJECT NO.
	11-02

This copy is from the Digital Archive of the Hamilton County Surveyors Office, Noblesville, In 46060

STRUCTURE DATA

STRUCTURE NUMBER	LOCATION				PIPE TYPE	DESCRIPTION MANHOLE, INLET, CATCH BASIN, OR SPECIALTY STRUCTURE	LENGTH ft.	SKEW	COVER ft.	FLOW LINE		SERVICE LIFE YR.	SITE DESIGNATION	PH	BACKFILL METHOD	STRUCTURE BACKFILL CYS.	TYPE	FLOWABLE BACKFILL CYS.	TYPE	GEOTEXTILES SYS.	RIPRAP TON	TYPE	CONCRETE CLASS A FOR STRUCTURES CYS.	VIDEO INSPECTION LFT.	PIPE END SECTION EACH	GRATED BOX END SECTION			SAFETY METAL END SECTION			CONNECT TO STR. NO.	REMARKS					
	STATION	LEFT	RIGHT	CROSS						OFFSET FT.	SIZE in.															ELEV.	ELEV.	TYPE	SLOPE	EACH	TYPE			SLOPE	EACH	TYPE	SLOPE	EACH
Line "PR-A"																																						
260	57+50	x			40	12	RCP	Manhole C-4	146		4.0	906.15	905.40	75	N	7.0	1	79	1													257						
261	57+50	x				12	RCP	Catch Basin K-10	2		3.3	906.30	906.25	75	N	7.0	1	1	1													260						
262	57+50		x			12	RCP	Inlet J-10	67		3.1	906.55	906.35	75	N	7.0	1	29	1													261						
263	61+78	x				12	RCP	Inlet M-10	1		2.1	907.15	907.10	75	N	7.0	1	1	1													266						
264	61+78		x			12	RCP	Inlet M-10	1		2.1	907.15	907.10	75	N	7.0	1	1	1													267						
602	61+83	x			57			Relocate Existing Inlet																														
265	61+83	x			40	18	RCP	Manhole C-4	63		2.1	906.85	906.77	75	N	7.0	1	27	1													268						
266	61+83	x				15	RCP	Catch Basin K-10	2		2.1	906.90	906.85	75	N	7.0	1	1	1													265						
267	61+83		x			15	RCP	Inlet M-10	67		1.9	907.10	906.90	75	N	7.0	1	23	1													266						
268	62+50	x			40	24	RCP	Manhole C-4	171		2.0	906.76	906.42	75	N	7.0	1	103	1													271						
269	62+50	x				12	RCP	Catch Basin K-10	2		2.4	907.10	907.05	75	N	7.0	1	1	1													268						
270	62+50		x			12	RCP	Inlet M-10	67		2.1	907.35	907.15	75	N	7.0	1	21	1													269						
271	64+25	x			40	24	RCP	Manhole C-4	371		3.7	906.42	905.86	75	N	7.0	1	309	1													274						
272	64+25	x				12	RCP	Catch Basin K-10	2		2.9	908.05	908.00	75	N	7.0	1	1	1													271						
273	64+25		x			12	RCP	Inlet J-10	67		2.6	908.30	908.10	75	N	7.0	1	25	1													272						
274	68+00	x			40	24	RCP	Manhole C-4	96		4.7	905.86	905.71	75	N	7.0	1	89	1													277						
275	68+00	x				12	RCP	Catch Basin K-10	2		2.9	908.45	908.40	75	N	7.0	1	1	1													274						
276	68+00		x			12	RCP	Inlet J-10	67		2.6	908.75	908.55	75	N	7.0	1	25	1													275						
413	68+33	x			61			Relocate Existing Inlet																														
277	69+00	x			40			Existing Manhole																								Core Drill Existing Structure						
Line "A"																																						
292	145+50	x			40			Existing Manhole																								Core Drill Existing Structure						
293	145+50	x				12	RCP	Catch Basin K-10	2		2.9	907.30	907.25	75	N	7.0	1	1	1													292						
294	145+50		x			12	RCP	Inlet J-10	67		2.6	907.60	907.40	75	N	7.0	1	25	1													293						
296	146+48	x				12	RCP	Inlet M-10	1		2.7	907.20	907.15	75	N	7.0	1	1	1													299						
297	146+48		x			12	RCP	Inlet M-10	1		2.6	907.30	907.25	75	N	7.0	1	1	1													300						
298	146+53	x			40	18	RCP	Existing Manhole	63		3.4	906.50	906.14	75	N	7.0	1	37	1													Core Drill Existing Structure						
299	146+53	x				12	RCP	Catch Basin K-10	2		3.0	906.90	906.85	75	N	7.0	1	1	1													298						
300	146+53		x			12	RCP	Inlet M-10	67		2.7	907.20	907.00	75	N	7.0	1	26	1													299						
622	146+53		x			12	RCP	Pipe End Section	13		2.1	908.10	907.80	75	N	7.0	1	4	1													300						
403	147+04			x		18	RCP	Pipe Culvert	146		1.0	907.58	906.97	75	N	7.0	1	37	1																			

This copy is from the Digital Archive of the Hamilton County Surveyor's Office; Noblesville, In 46060

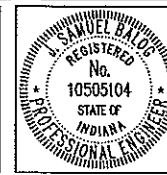

RECOMMENDED FOR APPROVAL *J. Samuel Balog* 02-10-2011
DESIGN ENGINEER DATE

DESIGNED: MJM DRAWN: MJM
CHECKED: JSB CHECKED: JSB


CITY OF CARMEL

STRUCTURE DATA TABLE

HORIZONTAL SCALE	BRIDGE FILE
VERTICAL SCALE	DESIGNATION NO.
SURVEY BOOK	SHEETS
CONTRACT	53 of 116 PROJECT NO. 11-02

STRUCTURE DATA

STRUCTURE NUMBER	LOCATION				PIPE TYPE	DESCRIPTION MANHOLE, INLET, CATCH BASIN, OR SPECIALTY STRUCTURE	LENGTH ft.	SKEW	COVER ft.	FLOW LINE		SERVICE LIFE YR.	SITE DESIGNATION	PH	BACKFILL METHOD	STRUCTURE BACKFILL CYC.	TYPE	FLOWABLE BACKFILL CYC.	TYPE	GEOTEXTILES SYS.	RIPRAP TON	TYPE	CONCRETE, CLASS A, FOR STRUCTURES			VIDEO INSPECTION			PIPE END SECTION			GRATED BOX END SECTION			SAFETY METAL END SECTION			CONNECT TO STR. NO.	REMARKS
	STATION	LEFT	RIGHT	CROSS						OFFSET FT.	SIZE in.												UP STREAM ELEV.	DOWN STREAM ELEV.	CYS.	CYS.	CYS.	LFT.	EACH	TYPE	SLOPE	EACH	TYPE	SLOPE	EACH				
404	147+08			x		18	RCP	Pipe Culvert	146	1.0	907.58	906.97	75	N	7.0	1	37	1								146	2												
302	147+50	x			40	15	RCP	Manhole C-4	63	4.1	906.50	906.30	75	N	7.0	1	39	1								63	1												
303	147+50	x				12	RCP	Catch Basin K-10	2	2.8	907.40	907.35	75	N	7.0	1	1	1								2												302	
304	147+50		x			12	RCP	Inlet M-10	67	2.6	907.60	907.40	75	N	7.0	1	25	1								67													303
623	147+50		x			12	RCP	Pipe End Section	13	2.5	908.10	907.70	75	N	7.0	1	5	1								13	1												304
610	149+25	x			50	12	RCP	Catch Basin E-7	6	1.2	907.65	907.55	75	N	7.0	1	3	1								6													306
306	149+25	x			40	15	RCP	Manhole C-4	171	4.0	907.45	906.60	75	N	7.0	1	102	1								171													302
307	149+25	x				12	RCP	Catch Basin K-10	2	2.6	908.50	908.45	75	N	7.0	1	1	1								2													306
308	149+25		x			12	RCP	Catch Basin K-10	2	2.6	908.50	908.45	75	N	7.0	1	1	1								2													309
309	149+25		x		40	12	RCP	Manhole C-4	64	3.0	908.35	908.00	75	N	7.0	1	29	1								64													310
310	149+93		x		40	18	RCP	Manhole C-4	80	4.7	906.50	905.77	75	N	7.0	1	65	1								80													414
414	149+93		x					Existing Inlet																														Core Drill Existing Structure	
311	151+00	x			40	15	RCP	Manhole C-4	171	3.7	908.70	907.55	75	N	7.0	1	97	1								171													306
312	151+00	x				12	RCP	Catch Basin K-10	2	2.6	909.35	909.30	75	N	7.0	1	1	1								2													311
313	151+00		x			12	RCP	Catch Basin K-10	2	2.6	909.35	909.30	75	N	7.0	1	1	1								2													314
314	151+00		x		40	15	RCP	Manhole C-4	103	3.2	908.70	908.20	75	N	7.0	1	51	1								103													310
605	152+36	x						Existing Inlet																														Adjust Casting to Grade	
315	152+75	x			40	15	RCP	Manhole C-4	171	3.6	909.65	908.80	75	N	7.0	1	92	1								171													311
316	152+75	x				12	RCP	Catch Basin K-10	2	2.6	910.25	910.20	75	N	7.0	1	1	1								2													315
317	152+75		x			12	RCP	Catch Basin K-10	2	2.6	910.25	910.20	75	N	7.0	1	1	1								2													318
318	152+75		x		40	15	RCP	Manhole C-4	171	3.2	909.65	908.80	75	N	7.0	1	86	1								171													314
319	154+50	x			40	12	RCP	Manhole C-4	171	3.2	910.80	909.75	75	N	7.0	1	79	1								171													315
320	154+50	x				12	RCP	Catch Basin K-10	2	2.6	911.10	911.05	75	N	7.0	1	1	1								2													319
321	154+50		x			12	RCP	Catch Basin K-10	2	2.6	911.10	911.05	75	N	7.0	1	1	1								2													322
322	154+50		x		40	15	RCP	Manhole C-4	171	2.9	910.80	909.75	75	N	7.0	1	82	1								171													318
323	156+50	x			40	12	RCP	Manhole C-4	196	3.1	911.90	910.90	75	N	7.0	1	81	1								196													319
324	156+50	x				12	RCP	Catch Basin K-10	2	2.6	912.10	912.05	75	N	7.0	1	1	1								2													323
325	156+50		x			12	RCP	Catch Basin K-10	2	2.6	912.10	912.05	75	N	7.0	1	1	1								2													326
326	156+50		x		40	12	RCP	Manhole C-4	196	3.1	911.90	910.90	75	N	7.0	1	81	1								196													322
328	160+00	x				12	RCP	Inlet M-10	67	2.0	912.70	912.50	75	N	7.0	1	21	1								67													329
329	160+00		x			12	RCP	Catch Basin K-10	2	2.3	912.50	912.45	75	N	7.0	1	1	1								2													330

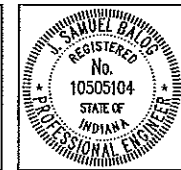

RECOMMENDED FOR APPROVAL: *S. Samuel D. ...* 02-10-2011
 DESIGN ENGINEER DATE
 DESIGNED: MJM DRAWN: MJM
 CHECKED: JSB CHECKED: JSB


CITY OF CARMEL

STRUCTURE DATA TABLE

HORIZONTAL SCALE	BRIDGE FILE
VERTICAL SCALE	DESIGNATION NO.
SURVEY BOOK	SHEETS
CONTRACT	54 of 116
	PROJECT NO. 11-02

STRUCTURE DATA

STRUCTURE NUMBER	LOCATION					DESCRIPTION MANHOLE, INLET, CATCH BASIN, OR SPECIALTY STRUCTURE	LENGTH ft.	SKEW	COVER ft.	FLOW LINE		SERVICE LIFE YR.	SITE DESIGNATION	PH	BACKFILL METHOD	STRUCTURE BACKFILL CYS.	TYPE	FLOWABLE BACKFILL CYS.	TYPE	GEOTEXTILES SYS.	RIPRAP TON	TYPE	CONCRETE, CLASS A, FOR STRUCTURES			VIDEO INSPECTION	PIPE END SECTION EACH	GRATED BOX END SECTION			SAFETY METAL END SECTION			CONNECT TO STR. NO.	REMARKS			
	STATION	LEFT	RIGHT	CROSS	OFFSET FT.					SIZE in.	PIPE TYPE												UP STREAM ELEV.	DOWN STREAM ELEV.	CONCRETE CYS.			LFT.	EACH	TYPE	SLOPE	EACH	TYPE			SLOPE	EACH	
Line 'A'																																						
330	160+00		x		40	12	RCB	Manhole C-4	126		2.9	912.45	911.80	75	N	7.0	1	49	1						126									701				
331	161+25	x				12	RCP	Inlet M-10	1		2.0	912.35	912.30	75	N	7.0	1	1	1					1											333			
332	161+25		x			12	RCP	Inlet M-10	1		2.0	912.35	912.30	75	N	7.0	1	1	1					1											334			
333	161+30	x				12	RCP	Inlet M-10	67		2.1	912.30	912.10	75	N	7.0	1	21	1					67											334			
334	161+30		x			12	RCP	Catch Basin K-10	2		2.4	912.05	912.00	75	N	7.0	1	1	1					2												701		
701	161+30		x		40	15	RCP	Manhole C-4	431		4.8	909.65	907.50	75	N	7.0	2	431	1					431												702		
702	161+30		x		475	15	RCP	Manhole C-4	44		7.2	907.40	907.00	75	N	7.0	1	53	1					44	1													
606	161+70	x			55	36	RCB	Manhole J-4	104		4.1	908.64	908.33	75	N	7.0	1	128	1					104												607		
607	161+70		x		55			Manhole J-4																														
336	162+50	x				12	RCP	Inlet M-10	67		2.1	912.70	912.50	75	N	7.0	1	21	1					67													337	
337	162+50		x			12	RCP	Catch Basin K-10	2		2.4	912.50	912.45	75	N	7.0	1	1	1					2														338
338	162+50		x		40	15	RCP	Manhole C-4	116		2.3	912.45	912.10	75	N	7.0	1	46	1					116														701
339	164+20	x				12	RCP	Inlet M-10	67		2.4	913.45	913.25	75	N	7.0	1	24	1					67														340
340	164+20		x			12	RCP	Catch Basin K-10	2		2.6	913.25	913.20	75	N	7.0	1	1	1					2														341
341	164+20		x		40	12	RCP	Manhole C-4	166		2.7	913.20	912.70	75	N	7.0	1	64	1					166														338
405	164+30			x		5'x2'	RCB	Box Culvert	117		1.0	913.37	912.39	75	N	7.0	1	71	2					117														
621	141+95		x			12	RCP	Pipa Culvert	20		1.0	909.90	909.80	75	N	7.0	1									2												

	RECOMMENDED FOR APPROVAL: <i>S. Samuel B. Jones</i> 02-10-2011 DESIGN ENGINEER DATE	CITY OF CARMEL		HORIZONTAL SCALE	BRIDGE FILE
	DESIGNED: MJM DRAWN: MJM CHECKED: JSB CHECKED: JSB			VERTICAL SCALE	DESIGNATION NO.
	STRUCTURE DATA TABLE		SURVEY BOOK	SHEETS	
			CONTRACT	55 of 116 PROJECT NO. 11-02	