



Kenton C. Ward, CFM
Surveyor of Hamilton County
Phone (317) 776-8495
Fax (317) 776-9628

Suite 188
One Hamilton County Square
Noblesville, Indiana 46060-2230

Map Correction-Field Verification

Drain Number: #258

Drain Length: 9402.1

Drain Name: Waterwood: Section 1 Arm

Change + / - : 45

Date: 12-9-2011

New Length: 9447.01


Verified By: ADC, SLM

Notes & Sketch:

See attached map. The 6" SSD was never mapped across the rear of lot 6 in Waterwood Section 1. It was field verified to be installed.

Suzanne L. Mills
GIS Specialist

106th & College Ave
NW corner

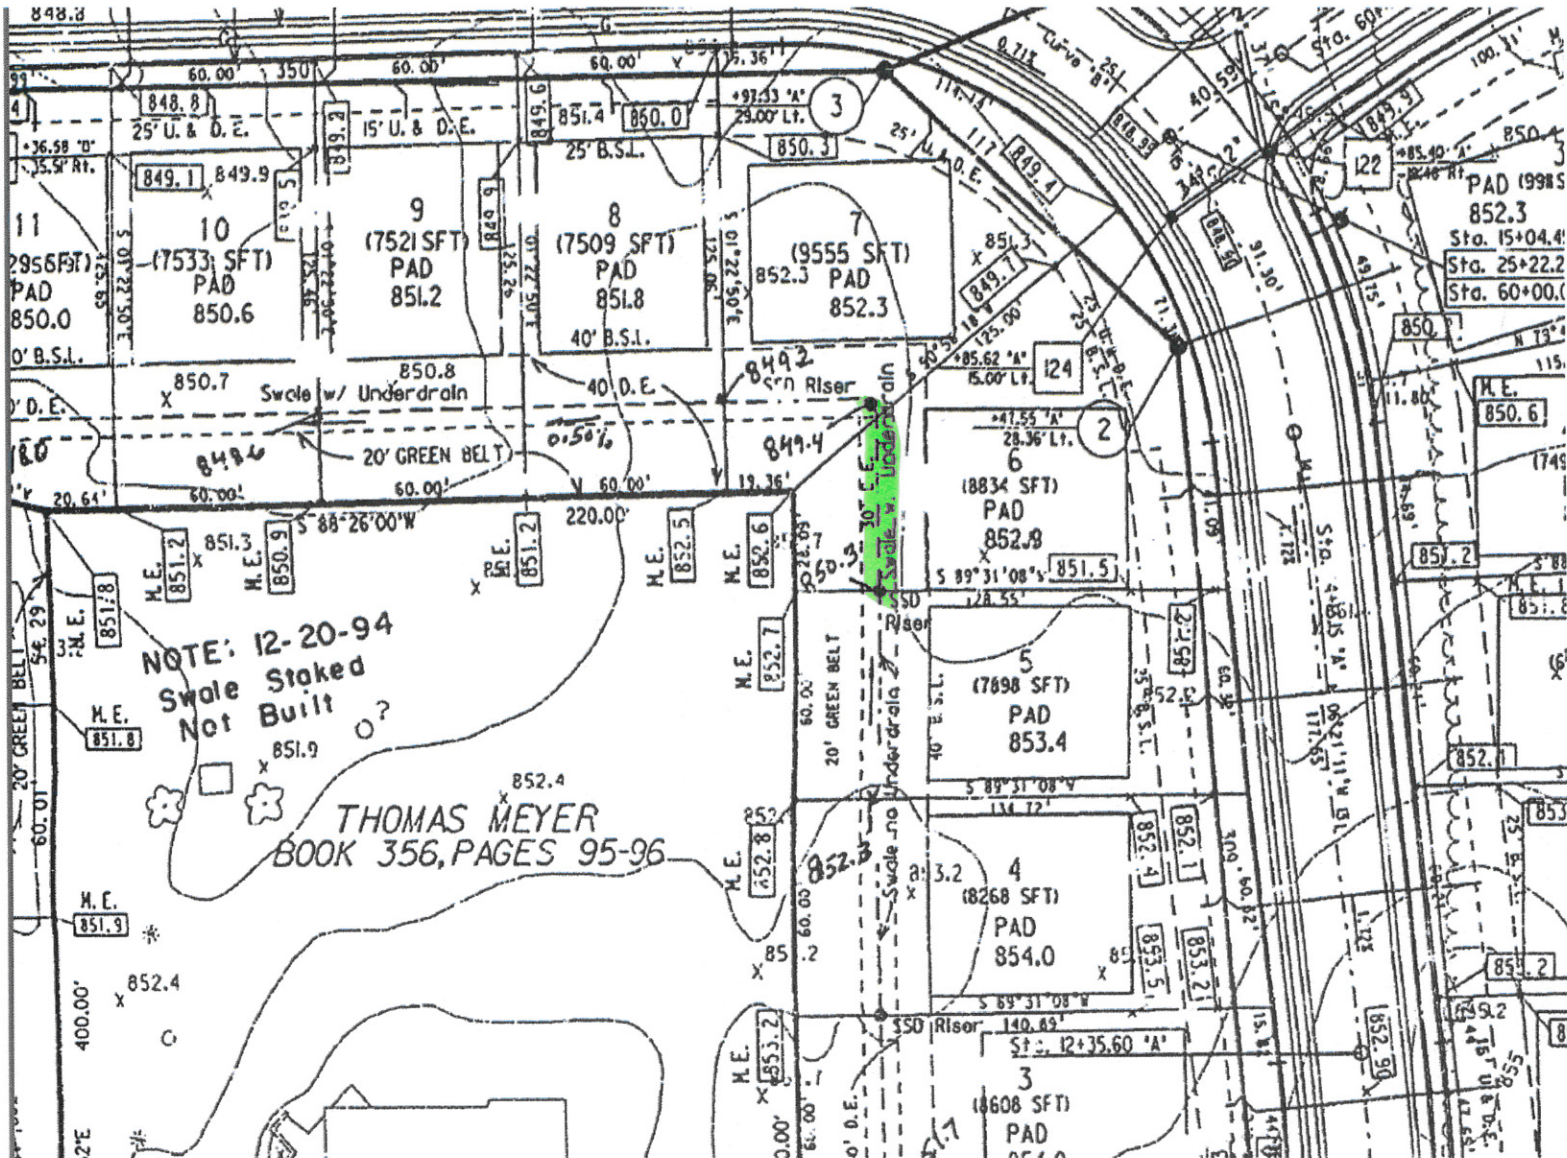

Waterwood Sec. 1