

KWJ

SURVEYOR'S OFFICE

# Hamilton County

*Kenton C. Ward, CFM*  
*Surveyor of Hamilton County*  
*Phone (317) 776-8495*  
*Fax (317) 776-9628*

*Suite 188*  
*One Hamilton County Square*  
*Noblesville, Indiana 46060-2230*

August 4, 2017

To: Hamilton County Drainage Board

Re: Williams Creek Drain, Woodside at West Clay Arm

Attached is a petition filed by SNAP II Properties, LLC., along with a non-enforcement request, plans, calculations, quantity summary and assessment roll for Woodside at West Clay Arm, Williams Creek Drain to be located in Clay Township. I have reviewed the submittals and petition and have found each to be in proper form.

I have made a personal inspection of the land described in the petition. Upon doing so, I believe that the drain is practicable, will improve the public health, benefit a public highway, and be of public utility and that the costs, damages and expenses of the proposed drain will probably be less than the benefits accruing to the owners of land likely to be benefited. The drain will consist of the following:

12" RCP	678 ft.	30" RCP	213 ft.
15" RCP	924 ft.	36" RCP	182 ft.
18" RCP	599 ft.	6" SSD	7,263 ft.
24" RCP	395 ft.	Open Ditch	750 ft.

The total length of the drain will be 11,904 feet.

The length of open ditch shown above is the straight line distance between inlets into Lake #1 (Str. 401, 406 and 425) and the outlet of Lake #1 (Str. 400).

The detention basin (Lake 1) located in Common Area #2 is not to be considered part of the regulated drain. Basin maintenance assumed by the Drainage Board shall only include the inlets and outlet as part of the regulated drain. The maintenance of the detention basin (Lake 1) such as sediment removal and erosion control along the banks, mowing, aquatic vegetation maintenance and control, and anything required per the Storm Water Quality Maintenance and Operations Manual will be the responsibility of the Homeowners Association. The Board will also retain jurisdiction for ensuring the storage volume for which the pond was designed will be retained. Thereby, allowing no fill or easement encroachments.

The subsurface drains (SSD) to be part of the regulated drain are those located under the curbs, those main lines in front/rear yards, and those in common areas. Only the main SSD lines as described below, which are located within the easement or right of way are to be maintained as regulated drain. Laterals for individual lots will not be considered part of the regulated drain. The portions of the SSD which will be regulated and maintained are as follows:

Curbline SSD in Streets:

Azteca Lane  
Soundview Place  
Woodside Drive  
Woodside Avenue

Front/Rear Yard SSDs:

Rear yard lots 1 to 3 from Str. 405 to Str. 405A  
Rear yard lots 4 to 8 from Str. 405A to Str. 414  
Rear yard lots 9 to 11 from Str. 414 to Str. 415  
Rear yard lots 12 to 14 from Str. 415 north to riser  
Rear yard lots 15 to 17 from Str. 416 north to riser  
Rear yard lots 18 to 22 from Str. 428 west to riser  
Rear yard lots 23 & 24 from Str. 428 to Str. 427  
Rear yard lots 25 to 27 from Str. 427 to Str. 426  
Rear yard lots 27 & 28 from Str. 426 south to riser  
Rear yard lots 29 & 30 from Str. 407 east to riser  
Rear yard lots 31 & 32 from Str. 407 west to riser  
Rear yard lots 37 & 38 from Str. 411 north to riser  
Rear yard lots 39 & 40 from Str. 411 south to riser


I have reviewed the plans and believe the drain will benefit each lot equally. Therefore, I recommend each lot be assessed equally. I also believe that no damages will result to landowners by the construction of this drain. I recommend a maintenance assessment of \$65.00 per lot, \$10.00 per acre for common areas, with \$65.00 minimum, and \$10.00 per acre for roadways. With this assessment the total annual assessment for this drain will be \$2,892.80.

In accordance with IC 36-7-4-709, the petitioner did not submit surety for the proposed drain prior to construction commencing. If the petitioner/developer wants to submit final secondary plat for recording prior to the final inspection and approved as-built drawings, a bond will be required at that time.

I believe this proposed drain meets the requirements for Urban Drain Classification as set out in IC 36-9-27-67 to 69. Therefore, this drain shall be designated as an Urban Drain.

I recommend that upon approval of the above proposed drain that the Board also approve the attached non-enforcement request. The request will be for the reduction of the regulated drain easement to those easement widths as shown on the secondary plat for Woodside at West Clay as recorded in the office of the Hamilton County Recorder.

I recommend the Board set a hearing for this proposed drain for October 23, 2017.

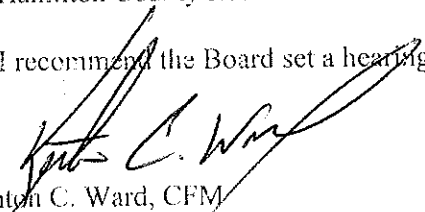  
Kenton C. Ward, CFM  
Hamilton County Surveyor

KCW/pll

STATE OF INDIANA )  
 )  
COUNTY OF HAMILTON )

**FILED**

**MAY 31 2017**

TO: HAMILTON COUNTY DRAINAGE BOARD  
% Hamilton County Surveyor  
One Hamilton County Square, Suite 188  
Noblesville, IN. 46060-2230

OFFICE OF HAMILTON COUNTY SURVEYOR

In the matter of Woodside at West Clay Subdivision, Section  
Drain Petition.

Petitioner is the owner of all lots in the land affected by the proposed new regulated drain. The drainage will affect various lots in Woodside at West Clay, a subdivision in Hamilton County, Indiana. The general route of such drainage shall be in existing easements and along public roads as shown in the plans on file in the Surveyor's Office.

Petitioner believes that the cost, damages and expenses of the proposed improvement will be less than the benefits which will result to the owners of the land likely to be benefited thereby. Petitioner believes the proposed improvements will:

- (a) improve public health
- (b) benefit a public street
- (c) be of public utility

Petitioner agrees to pay the cost of construction of the drainage system and requests periodic maintenance assessments by the Board thereafter.


The Petitioner also agrees to the following:

1. To provide the Drainage Board a Performance Bond or Non-Revocable Letter of Credit for the portion of the drainage system which will be made a regulated drain. The bond will be in the amount of 120% of the Engineer's estimate. The bond will be in effect until construction of 100% of the system is completed and so certified by the Engineer.
2. The Petitioner shall retain an Engineer throughout the construction phase. At completion of the project the Petitioner's Engineer shall certify that the drainage system which is to be maintained as a regulated drain has been constructed as per construction plans.
3. The Petitioner agrees to request in writing to the County Surveyor any changes from the approved plan and must receive written authorization from the County Surveyor prior to implementation of the change. All changes shall be documented and given to the Surveyor to be placed in the Drain file.
4. The Petitioner shall instruct his Engineer to provide a reproducible print on a 24" x 36" Mylar of the final design of the Drainage System. This shall be submitted to the County Surveyor prior to the release of the Performance Bond.
5. The Petitioner shall comply with the Erosion Control Plan as specified on the construction plans. Failure to comply with the Erosion Control Plan shall be determined by the Board as being an obstruction to the drainage system. The County Surveyor shall immediately install or repair the needed measures at Petitioners cost as per IC 36-9-27-46.

Adobe PDF Fillable Form

The Petitioner further requests that the Drain be classified as an Urban Drain as per IC 36-9-27-69(d).

**RECORDED OWNER(S) OF LAND INVOLVED**

  
\_\_\_\_\_  
Signed

SNAP II Properties, LLC by Nick Churchill

\_\_\_\_\_  
Printed Name

May 17, 2017

\_\_\_\_\_  
Date

\_\_\_\_\_  
Signed

\_\_\_\_\_  
Printed Name

\_\_\_\_\_  
Date

\_\_\_\_\_  
Signed

\_\_\_\_\_  
Printed Name

\_\_\_\_\_  
Date

\_\_\_\_\_  
Signed

\_\_\_\_\_  
Printed Name

\_\_\_\_\_  
Date

FINDINGS AND ORDER

CONCERNING THE MAINTENANCE OF THE

Williams Creek Drain, Woodside at West Clay Arm


On this 23<sup>rd</sup> day of October, 2017, the Hamilton County Drainage Board has held a hearing on the Maintenance Report and Schedule of Assessments of the *Williams Creek Drain, Woodside at West Clay Arm*.

Evidence has been heard. Objections were presented and considered. The Board then adopted the original/amended Schedule of Assessments. The Board now finds that the annual maintenance assessment will be less than the benefits to the landowners and issues this order declaring that this Maintenance Fund be established.

HAMILTON COUNTY DRAINAGE BOARD



\_\_\_\_\_  
President



\_\_\_\_\_  
Member



\_\_\_\_\_  
Member

Attest:

  
Executive Secretary



**STOEPPELWERTH**

ALWAYS ON

ofc: 317.849.5935  
fax: 317.849.5942

7965 East 106th Street  
Fishers, IN 46038-2505  
www.stoepelwerth.com

August 1, 2017

Hamilton County Surveyor's Office  
One Hamilton County Square  
Suite 188  
Noblesville, Indiana 46060

Attention: Greg Hoyes

Re: Woodside at West Clay

Dear Mr. Hoyes:

On behalf of the developer SNAP II Properties, LLC, please accept this Engineer's Estimate for Woodside at West Clay. The estimate is as follows:

ITEM NAME:	UNIT	QUANTITY	UNIT COST	AMOUNT
<b>STORM SEWER</b>				
12" RCP	LF	678	\$ 23.85	\$ 16,170.30
15" RCP	LF	924	\$ 29.50	\$ 27,258.00
18" RCP	LF	599	\$ 33.50	\$ 20,066.50
24" RCP	LF	395	\$ 45.80	\$ 18,091.00
30" RCP	LF	213	\$ 59.00	\$ 12,567.00
36" RCP	LF	182	\$ 74.00	\$ 13,468.00
12" END SECTION	EA	1	\$ 1,242.00	\$ 1,242.00
15" END SECTION	EA	1	\$ 1,258.00	\$ 1,258.00
18" END SECTION	EA	1	\$ 1,316.00	\$ 1,316.00
36" END SECTION	EA	1	\$ 2,146.00	\$ 2,146.00
12" TRASH GUARD	EA	1	\$ 449.00	\$ 449.00
15" TRASH GUARD	EA	1	\$ 465.00	\$ 465.00
18" TRASH GUARD	EA	1	\$ 511.00	\$ 511.00
36" TRASH GUARD	EA	1	\$ 975.00	\$ 975.00
MANHOLE, STANDARD	EA	11	\$ 2,125.00	\$ 23,375.00
MANHOLE, LARGE	EA	6	\$ 2,740.00	\$ 16,440.00
STANDARD INLET	EA	5	\$ 1,475.00	\$ 7,375.00
DOUBLE INLET	EA	4	\$ 2,856.00	\$ 11,424.00
CURB SSD	LF	5340	\$ 9.20	\$ 49,128.00
SWALE SSD	LF	2470	\$ 9.20	\$ 22,724.00
SSD LATERALS	EA	40	\$ 93.00	\$ 3,720.00
GRANULAR BACKFILL	TON	1058	\$ 12.00	\$ 12,696.00
			<b>STORM SEWER SUBTOTAL:</b>	<b>\$ 262,864.80</b>
			<b>STORM SEWER PERFORMANCE BOND (120%):</b>	<b>\$ 315,437.76</b>

**LAND DEVELOPMENT SUPPORT SOLUTIONS**

ENGINEERING | SURVEYING



MONUMENTATION				
LOT CORNERS	EA	1	\$ 3,900.00	\$ 3,900.00
CENTERLINE	EA	1	\$ 2,040.00	\$ 2,040.00
CONCRETE 4X4 PROPERTY CORNERS AT ROW	EA	1	\$ 1,350.00	\$ 1,350.00
MONUMENTATION SUBTOTAL:				\$ 7,290.00
MONUMENTATION PERFORMANCE BOND (120%):				\$ 8,748.00

If you have any questions regarding these estimates, please contact Brian Robinson at (317) 570-4763.

Very truly yours,

STOEPPELWERTH & ASSOCIATES, INC.



David J. Stoepfelwerth, P.E.  
Professional Engineer  
No. 19358



Cc: Nick Churchill

BKR/meb

S:\56325PIT-S1\Blue\_Book\Agency\_Correspondence\HamiltonCountySurveyorHoyesEE08-01-17.doc



BEFORE THE HAMILTON COUNTY DRAINAGE BOARD  
IN THE MATTER OF

Williams Creek Drain, Woodside at West Clay Arm

NOTICE

To Whom It May Concern and: \_\_\_\_\_  
\_\_\_\_\_  
\_\_\_\_\_

Notice is hereby given of the hearing of the Hamilton County Drainage Board on the Williams Creek Drain, Woodside at West Clay Arm on October 23, 2017 at 9:05 A.M. in Commissioners Court, Hamilton County Judicial Center, One Hamilton County Square, Noblesville, Indiana, and which construction and maintenance reports of the Surveyor and the Schedule of Assessments made by the Drainage Board have been filed and are available for public inspection in the office of the Hamilton County Surveyor.

Hamilton County Drainage Board

Attest: Lynette Mosbaugh

ONE TIME ONLY



BEFORE THE HAMILTON COUNTY DRAINAGE BOARD  
IN THE MATTER OF THE  
Williams Creek Drain, Woodside at West Clay Arm


NOTICE

Notice is hereby given pursuant to Section 405 of the 1965 Indiana Drainage Code that this Board, prior to final adjournment on October 23, 2017 has issued an order adopting the Schedule of Assessments, filed the same and made public announcement thereof at the hearing and ordered publication. If judicial review of the findings and order of the Board is not requested pursuant to Article Eight of this code within twenty (20) days from the date of this publication, the order shall be conclusive.

Hamilton County Drainage Board

Attest: Lynette Mosbaugh

ONE TIME ONLY

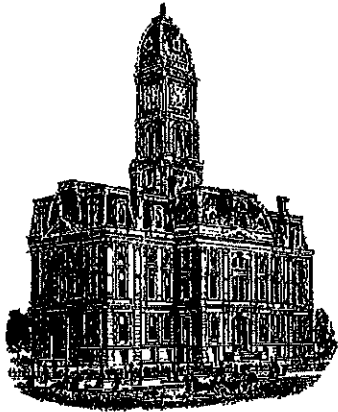

Kenton C. Ward, CFM  
Surveyor of Hamilton County  
Phone (317) 776-8495  
Fax (317) 776-9628

Suite 188  
One Hamilton County Square  
Noblesville, Indiana 46060-2230

To: Hamilton County Drainage Board

February 5, 2018

Re: Williams Creek Drain – Woodside at West Clay

Attached are as-built, certificate of completion & compliance, and other information for Woodside at West Clay. An inspection of the drainage facilities for this section has been made and the facilities were found to be complete and acceptable.

During construction, changes were made to the drain, which will alter the plans submitted with my report for this drain-dated August 4, 2017. The report was approved by the Board at the hearing held October 23, 2017. (See Drainage Board Minutes Book 17, Pages 511-512) The changes are as follows: the 12" RCP was lengthened from 678 feet to 679 feet. The 15" RCP was shortened from 924 feet to 920 feet. The 18" RCP was lengthened from 599 feet to 603 feet. The 24" RCP was lengthened from 395 feet to 396 feet. The 30" RCP was lengthened from 213 feet to 216 feet. The 36" RCP was shortened from 182 feet to 179 feet. The 6" SSD was lengthened from 7,263 feet to 7,288 feet. The open ditch was lengthened from 750 feet to 755 feet. The length of the drain due to the changes described above is now **11,036 feet**.

The non-enforcement was approved by the Board at its meeting on October 23, 2017 and recorded under instrument #2017057047. Sureties were not posted for this project in accordance with IC 36-7-4-709.

I recommend the Board approve the drain's construction as complete and acceptable.

Sincerely,

Kenton C. Ward, CFM  
Hamilton County Surveyor

CERTIFICATE OF COMPLETION AND COMPLIANCE

To: Hamilton County Surveyor

Re: Woodside at West Clay

I hereby certify that:

1. I am a Registered Land Surveyor or Engineer in the State of Indiana.
2. I am familiar with the plans and specifications for the above referenced subdivision.
3. I have personally observed and supervised the completion of the drainage facilities for the above referenced subdivision.
4. The drainage facilities within the above referenced subdivision to the best of my knowledge, information and belief have been installed and completed in conformity with all plans and specifications.
5. The drainage facilities within the above referenced subdivision to the best of my knowledge, information and belief have been correctly represented on the Record Drawings, Digital Record Drawings and the Structure Data Spreadsheet.

Signature: *David J. Stoepfelwerth* Date: February 1, 2018

Type or Print Name: David J. Stoepfelwerth

Business Address: Stoepfelwerth & Associates, Inc.

7965 East 106th Street, Fishers, Indiana 46038

Telephone Number: (317) 849-5935

INDIANA REGISTRATION NUMBER

19358



# WOODSIDE at WEST CLAY

Developed by: Snap II Properties, LLC


P.O. BOX 554

Carmel, IN 46082


Phone: (317) 580-9693

Contact Person: Nick Churchill

Email: Nick@Pittmanpartners.com

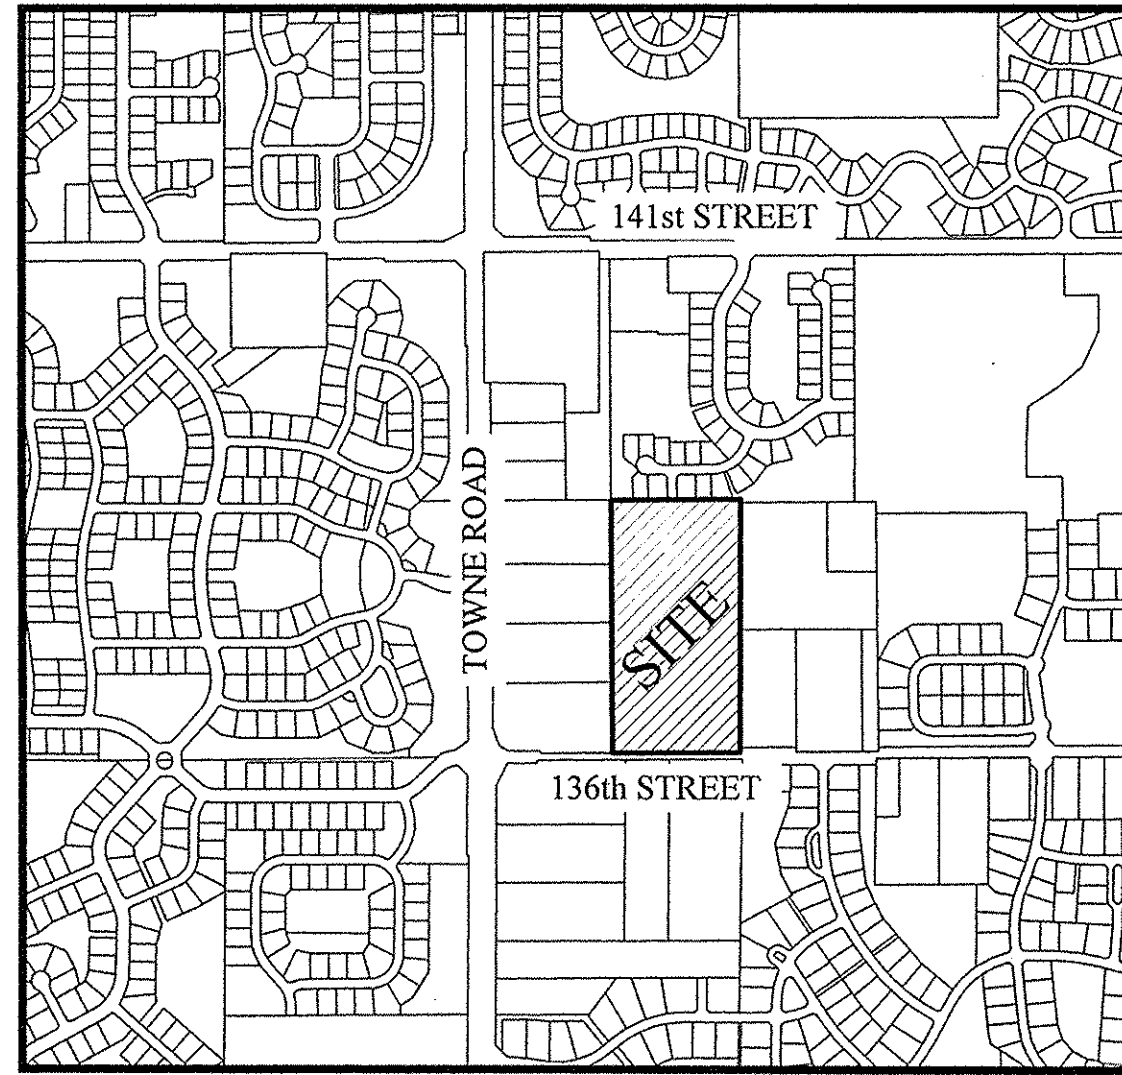

LOCATION MAP  
SCALE: 1"=1000'

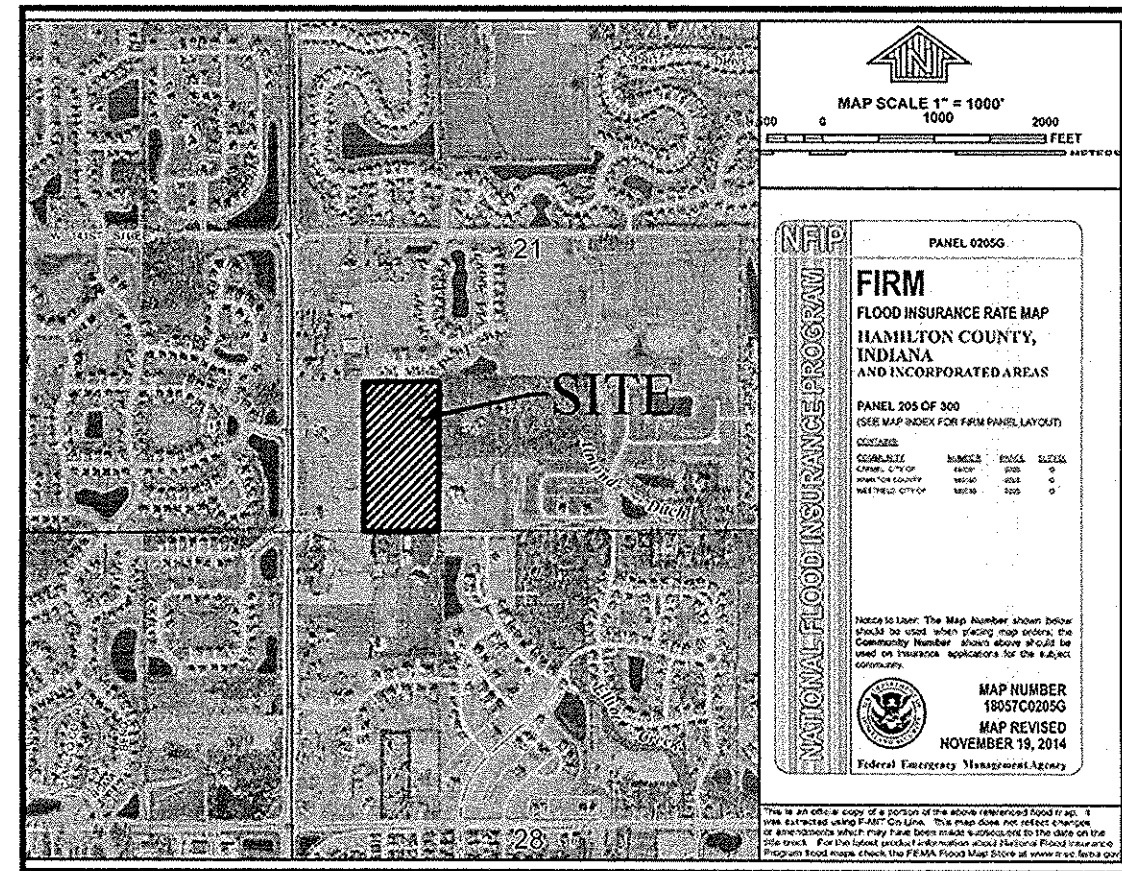

FLOOD MAP  
SCALE: N.T.S.  
FIRM #18057C0205G

SITE DATA	
LARGEST LOT	18,972 sq.ft.
SMALLEST LOT	8,450 sq.ft.
AVERAGE LOT SIZE	10,763 sq.ft.
TOTAL LOTS	40
TOTAL ACRES	20.337 Ac.±
GROSS DENSITY	1.97 Lots/Ac.
TOTAL COMMON AREA	6,944 Ac.±
PRESENT ZONING	Woodside at West Clay PUD Z-618-16
SUBMITTAL DATE	10/21/16
EST. START CONSTRUCTION	06/01/17

PRIMARY BUILDING SETBACKS	
MIN. FRONT BUILDING LINE	15'
SIDE YARD/AGGREGATE	0' MIN/10' AGGREGATE/6' BTWN. STRUCTURES
REAR YARD	20'
MAXIMUM LOT COVERAGE	60%

ACCESSORY BUILDING SETBACKS (beyond 10' from primary building)	
MIN. FRONT BUILDING LINE	25' FROM FRONT OF BUILDING OR SETBACK LINE - WHICH EVER IS GREATER
SIDE / REAR YARD	5' FROM LOT LINE OR 3' FROM EASEMENT

ACCESSORY BUILDING SETBACKS (within 10' of primary building)	
MIN. FRONT BUILDING LINE	25' FROM FRONT OF BUILDING OR SETBACK LINE - WHICH EVER IS GREATER
SIDE / REAR YARD	see PRIMARY BUILDING SETBACKS

\*REFER TO PUD FOR ARCHITECTURAL STANDARDS

DESIGN DATA	
40 LOTS	= 1.97 LOTS/ACRE
WOODSIDE HOLLOW DRIVE	1,389.39 L.F.
SOUNDVIEW PLACE	803.08 L.F.
SUNBLAZE DRIVE	313.01 L.F.
TOTAL	2,505.48 L.F.
DESIGN SPEED LIMIT:	25 M.P.H

**OPERATOR ON N.O.I. LETTER:**  
SNAP II PROPERTIES, LLC  
P.O. BOX 554  
Carmel, Indiana 46082  
Contact: Nick Churchill  
Phone: (317) 580-9693

**OPERATING AUTHORITY**  
CITY OF CARMEL (317) 571-2441  
ONE CIVIC SQUARE  
CARMEL, INDIANA 46032

**UTILITY CONTACTS:**

Clay Township Regional Waste District  
10701 College Avenue  
Indianapolis, Indiana 46280




Carmel Water Utilities  
3450 West 131st Street  
Westfield, IN 46074

AT & T - Engineering  
240 North Meridian Street  
2nd Floor, Room 280  
Indianapolis, Indiana 46204

Brighthouse Networks  
3030 Roosevelt Avenue  
Indianapolis, Indiana 46218

Duke Energy  
100 South Mill Creek Road  
Noblesville, Indiana 46060

Vectren Energy  
16000 Allisonville Road  
Noblesville, Indiana 46060

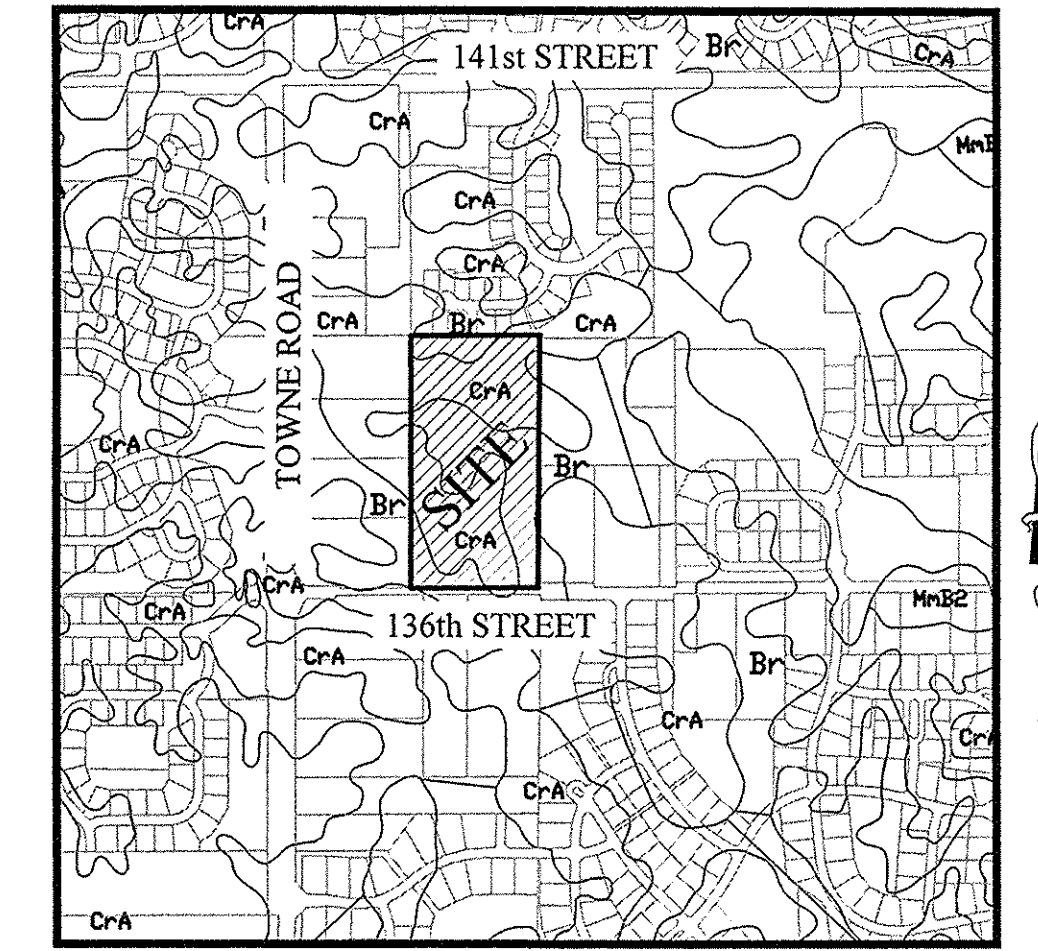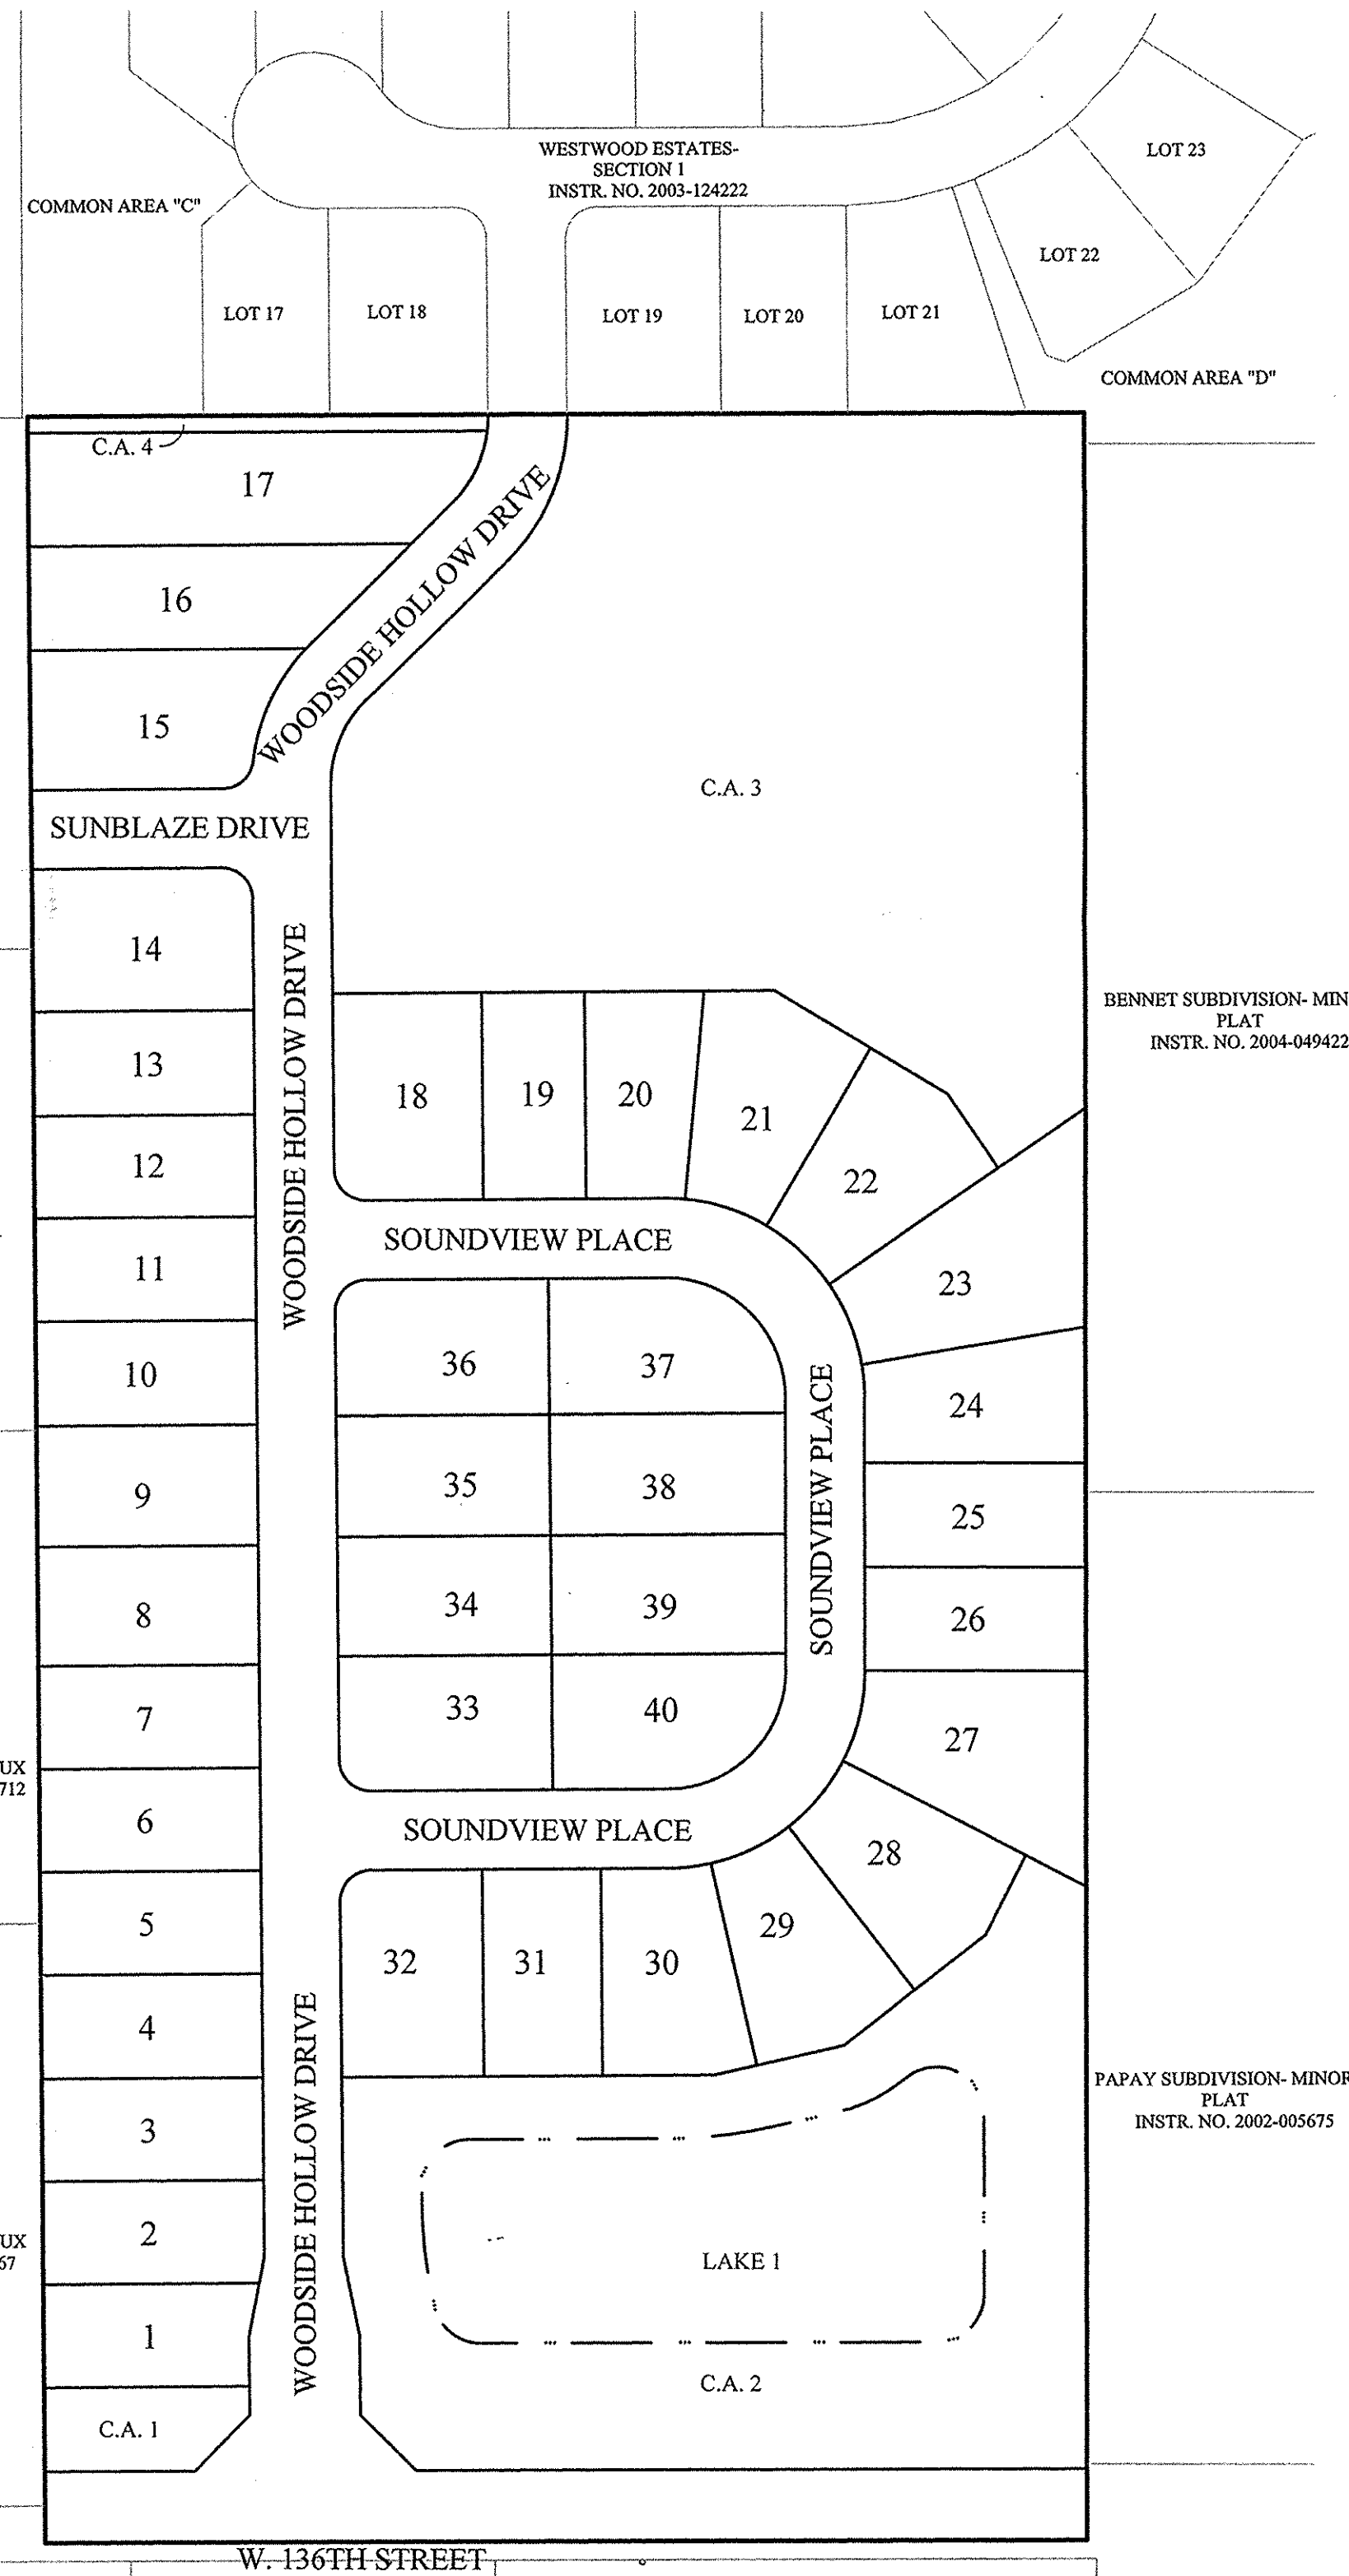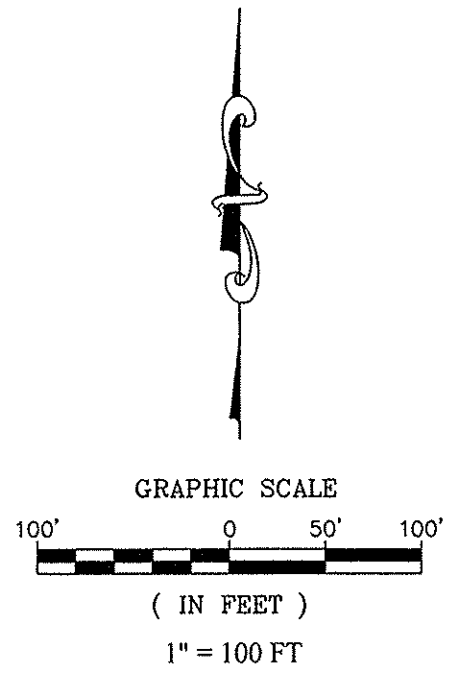

SOILS MAP  
SCALE: 1"=1000'

Map Unit: Br - Brookston silty clay loam  
This poorly drained soil has a seasonal high water table above the surface or within 1.0 ft. and is in depressions. Slopes are 0 to 2 percent. The native vegetation is water tolerant grasses and hardwoods. The surface layer is silty clay loam and has moderate to high organic matter content (2.0 to 5.0 percent). Permeability is moderately slow (0.2 to 0.6 in/hr) in the most restrictive layer above 60 inches. Available water capacity is high (10.0 inches in the upper 60 inches). The pH of the surface layer in non-limed areas is 6.1 to 7.3. This soil is hydric. Wetness is a management concern for crop production. This soil responds well to tile drainage.

Map Unit: CrA - Crosby silt loam, 0 to 2 percent slopes

CrA - Crosby silt loam, 0 to 2 percent slopes  
This is a somewhat poorly drained soil and has a seasonal high water table at 0.5 to 2.0 ft. and is on rises on uplands. Slopes are 0 to 2 percent. The native vegetation is hardwoods. The surface layer is silt loam and has moderately low to moderate organic matter content (1.0 to 3.0 percent). Permeability is very slow (< 0.06 in/hr) in the most restrictive layer above 60 inches. Available water capacity is moderate (6.2 inches in the upper 60 inches). The pH of the surface layer in non-limed areas is 5.1 to 6.0. Droughtiness and wetness are management concerns for crop production. This soil responds well to tile drainage.


**WOODSIDE AT WEST CLAY**  
A part of the Southwest Quarter of Section 21, Township 18 North, Range 3 East in Clay Township, Hamilton County, Indiana, being more particularly described as follows:

Commencing at the Northwest corner of said Southwest Quarter; thence South 00 degrees 15 minutes 08 seconds East along the west line thereof 1297.22 feet; thence South 89 degrees 58 minutes 53 seconds East 672.44 feet to the POINT OF BEGINNING of this description; thence North 89 degrees 40 minutes 06 seconds East 668.70 to a point on the east line of the West Half of said Quarter Section; thence South 00 degrees 05 minutes 47 seconds East along the East line thereof 1334.64 feet to the South line of said Quarter Section; thence South 89 degrees 39 minutes 12 seconds West along the South line thereof 658.73 feet; thence North 00 degrees 31 minutes 28 seconds West 1334.81 feet to the place of beginning, containing 20.337 acres, more or less, subject to all legal highways, rights-of-ways and easements on record.

**FLOOD STATEMENT**  
This is to certify that NO portion of the property is located within a Special Flood Hazard Area (Zone AE) as said property plots by scale on Community Panel No. 18057C 0205G of the Flood Insurance Rate Maps dated November 19, 2014.

INDEX	
SHT.	DESCRIPTION
C001	COVER SHEET
C100-C101	TOPOGRAPHICAL SURVEY
C200-C203	SITE DEVELOPMENT PLAN EMERGENCY FLOOD ROUTE OVERALL UTILITY PLAN
C300-C305	INITIAL STORM WATER POLLUTION & PREVENTION PLAN TEMPORARY STORM WATER POLLUTION & PREVENTION PLAN PERMANENT SEDIMENT & EROSION CONTROL PLAN STORM WATER POLLUTION & PREVENTION SPECIFICATIONS STORM WATER POLLUTION & PREVENTION DETAILS
C400-C408	STREET PLAN & PROFILES INTERSECTION DETAILS TRAFFIC CONTROL PLAN
C500-C502	SANITARY SEWER PLAN & PROFILE UNSEWERED WATERSHED MAP
C600-C602	STORM SEWER PLAN & PROFILES
C700-C701	WATER PLAN
C800-C805	CONSTRUCTION DETAILS SANITARY STORM STREET

REVISIONS	
SHT.	DESCRIPTION
ALL	REVISED PER TAC COMMENTS 05/01/17 DCM
ALL	REVISED PER CTRWD COMMENTS 06/20/17 DCM
ALL	REVISED PER COMMENTS 06/30/17 KRG
C500-C502	REVISED PER COMMENTS 07/13/17 KRG
C500 & C600	ADDED EX. WATER CROSSING 07/17/17 KRG
ALL	REVISED STREET NAMES 10/06/17 CCE
ALL	AS BUILTS 12/06/17 CCE

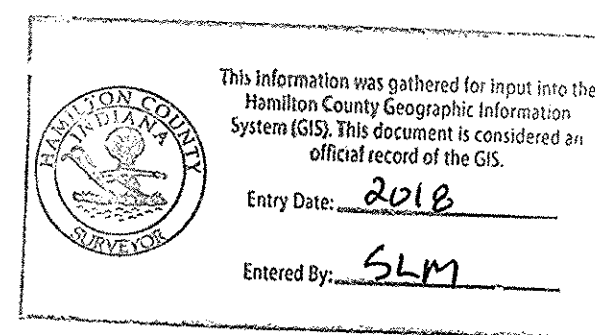


## RECORD DRAWING

Dennis D. Olmstead  
Registered Land Surveyor  
No. 900012  
STATE OF INDIANA  
LAND SURVEYOR

PLANS PREPARED BY:  
STOEPPEL WERTH & ASSOCIATES, INC.  
CONSULTING ENGINEERS & LAND SURVEYORS  
7965 E. 106TH STREET, FISHERS, INDIANA 46038  
PHONE: (317)-849-5935  
FAX: (317)-849-5942  
CONTACT PERSON: BRIAN K. ROBINSON  
EMAIL: BROBINSON@STOEPPEL WERTH.COM


PLANS CERTIFIED BY:

David J. Stoepfelwerth  
DAVID J. STOEPPEL WERTH  
PROFESSIONAL LAND SURVEYOR  
NO. 19358

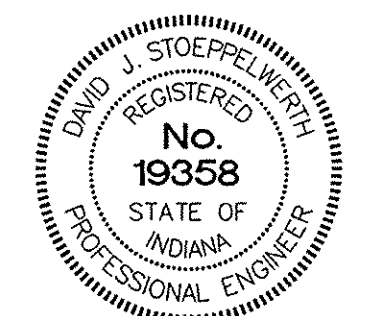




WESTWOOD ESTATES- SECTION 1  
INSTR. NO. 2003-124222

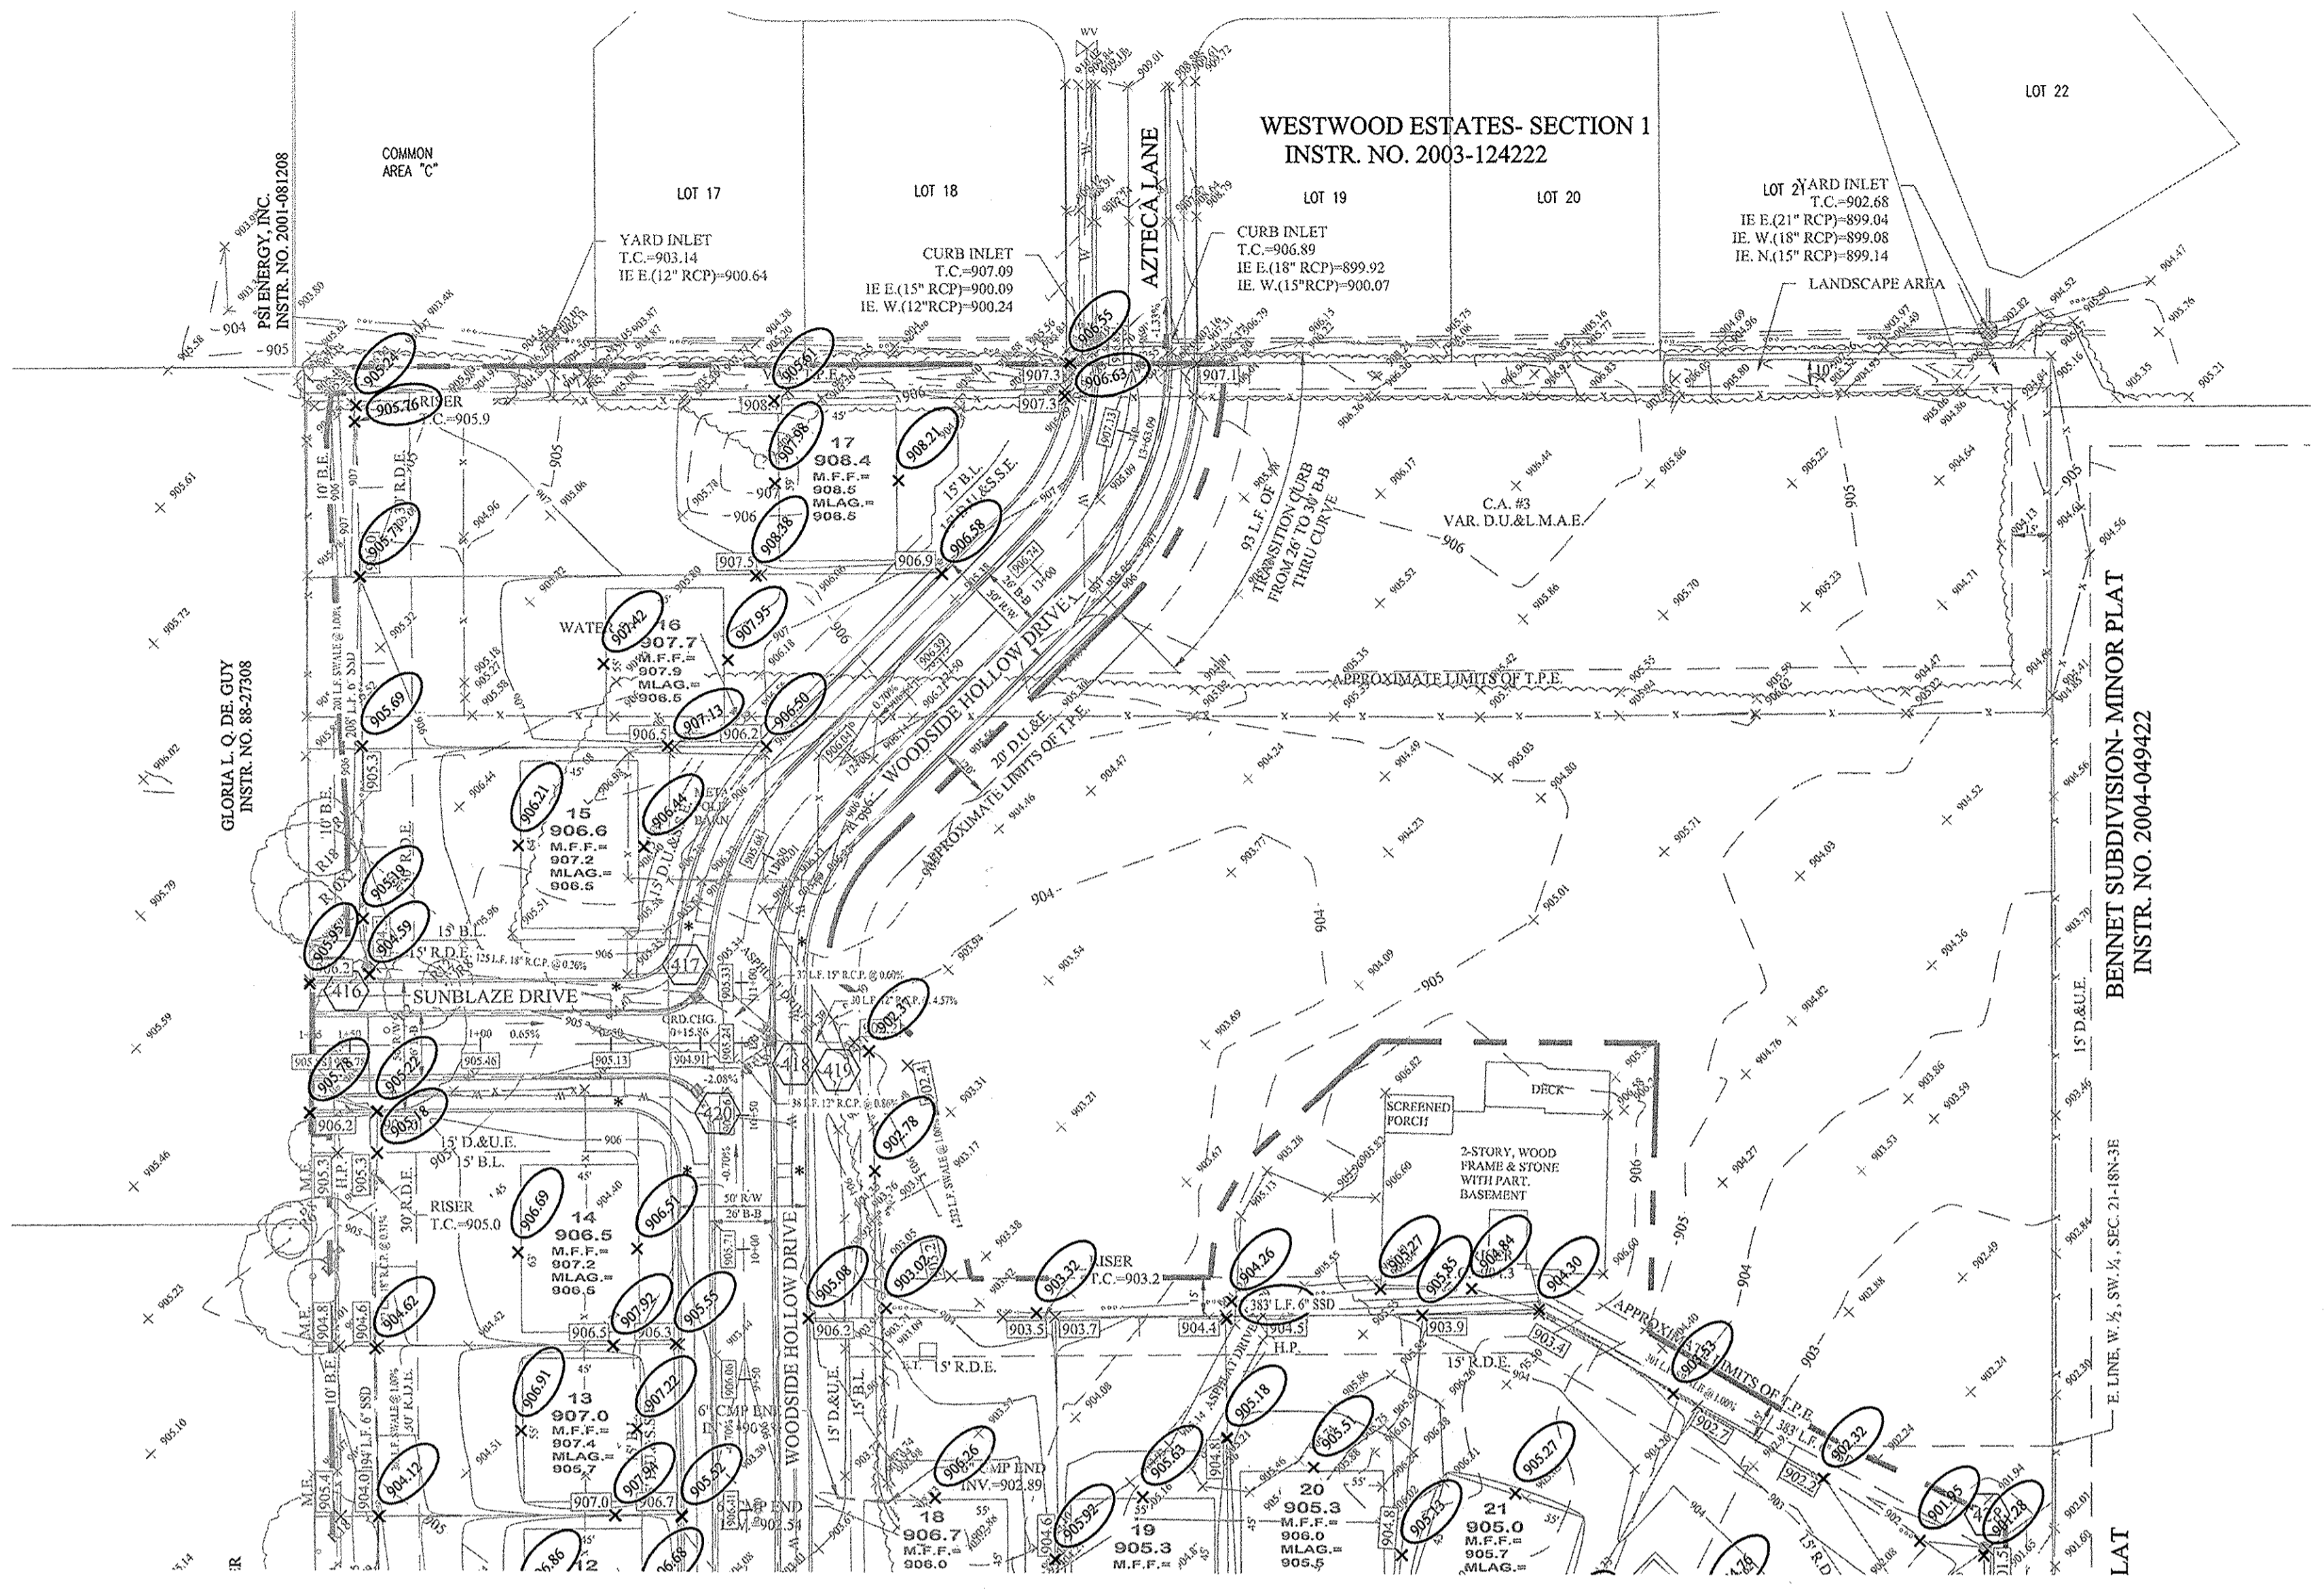

**NOTES TO CONTRACTOR:**  
ALL PADS SHOULD BE TESTED TO ASSURE A COMPACTION OF AT LEAST 95 PERCENT OF THE MAXIMUM DRY DENSITY USING THE STANDARD PROCTOR TEST METHOD.  
ANY PRIVATE TILES LOCATED ON THIS SITE WILL NEED TO BE LOCATED; BREATHERS SET AT THE DOWNSTREAM PROPERTY LINE AND CRUSHED OR REMOVED ACROSS THIS SITE, IF ANY OF THESE TILES EXTEND BEYOND THE LIMITS OF THIS PROJECT, THEY WILL NEED TO BE PROVIDED A POSITIVE OUTLET AND ALLOWED TO CONTINUE TO FUNCTION, AS IT IS ILLEGAL TO BLOCK OFF A PRIVATE "MUTUAL" TILE.  
CONTRACTOR SHALL VERIFY DEPTHS OF ALL EXISTING ONSITE UTILITIES PRIOR TO CONSTRUCTION TO CONFIRM THERE IS NOT ANY CONFLICTS WITH OTHER UTILITIES, STORM SEWERS OR STREETS. CONFLICTS AFTER CONSTRUCTION BEGINS ARE SOLELY THE CONTRACTOR'S RESPONSIBILITY.  
ALL PAVING WITHIN THE EXISTING AND PROPOSED CITY RIGHT-OF-WAY SHALL CONFORM TO THE REQUIREMENTS OF THE DEPARTMENT OF ENGINEERING. THE CONTRACTOR SHALL CONTACT THE DEPARTMENT OF ENGINEERING TO SCHEDULE A PRE-CONSTRUCTION MEETING TO REVIEW THE DEPARTMENT'S CONSTRUCTION REQUIREMENTS, STAFF NOTIFICATION REQUIREMENTS, REQUIRED INSPECTIONS FOR CERTAIN STAGES OF THE WORK AND TO REVIEW THE AUTHORITY OF THE DEPARTMENT AS IT RELATES TO WORK WITHIN THE EXISTING AND PROPOSED RIGHT-OF-WAY.  
EXISTING PAVEMENT TO BE SAW CUT TO A CLEAN EDGE ADJACENT TO ANY WIDENING, AUXILIARY LANES, ETC.  
NO EARTH DISTURBING ACTIVITY MAY TAKE PLACE WITHOUT AN APPROVED STORM WATER MANAGEMENT PERMIT.  
THERE IS TO BE NO DRIVEWAY ENCRoACHMENTS INTO EASEMENTS BETWEEN LOTS.  
UTILITY RELOCATIONS REQUIRED BY THE PROJECT SHALL BE THE RESPONSIBILITY OF THE DEVELOPER. UTILITY LINE RELOCATIONS REQUIRED FOR ROAD PROJECTS THAT RESULT IN A CONFLICT WITH PROPOSED DEVELOPMENT SHALL BE THE RESPONSIBILITY OF THE DEVELOPER TO RESOLVE WITH THE UTILITY. EXISTING TIE LINES REQUIRED TO BE RELOCATED TO WITHIN ONE FOOT OF PROPOSED RIGHT-OF-WAY LINE.  
DAMAGE TO THE EXISTING RIGHT-OF-WAY SHALL BE RESTORED/REPAIRED TO THE SATISFACTION OF THE CITY AT THE COMPLETION OF THE PROJECT. THE CONTRACTOR IS ENCOURAGED TO INSPECT THE RIGHT-OF-WAY WITH THE CITY PRIOR TO THE START OF CONSTRUCTION TO DOCUMENT THE EXISTING CONDITION OF THE RIGHT-OF-WAY.

CONTRACTOR SHALL VERIFY DEPTHS OF ALL EXISTING ONSITE UTILITIES PRIOR TO CONSTRUCTION TO CONFIRM THERE IS NOT ANY CONFLICTS WITH OTHER UTILITIES, STORM SEWERS OR STREETS. CONFLICTS AFTER CONSTRUCTION BEGINS ARE SOLELY THE CONTRACTOR'S RESPONSIBILITY.  
STORM SEWER FOR THIS PROJECT WILL BE PUBLIC, EXCEPT SUB-SURFACE DRAINS.  
ALL STORM SEWERS WITHIN PUBLIC RIGHT-OF-WAY SHALL BE RCP CLASS III.

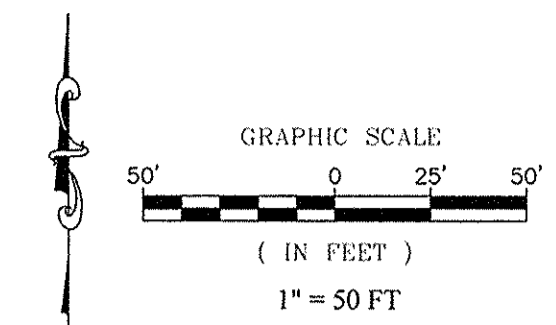

**LEGEND**

- EXISTING CONTOUR
- EXISTING SANITARY SEWER
- EXISTING STORM SEWER
- PROPOSED GRADE
- PROPOSED CONTOUR
- PROPOSED SANITARY SEWER
- PROPOSED SANITARY FORCE MAIN
- PROPOSED STORM SEWER
- PROPOSED WATER LINE
- PROPOSED SWALE
- ADA RAMP TO BE INSTALLED

REAR RW  
MFGP=XXX.X DENOTES REAR PROTECTION GRADE  
XX XXX.X LOT NUMBER PAD ELEVATION  
MFGP=XXX.X DENOTES FRONT PROTECTION GRADE  
PROPOSED 5' SIDEWALK (BY HOME BUILDER) (DEVELOPER SHALL INSTALL SIDEWALKS ALONG ALL COMMON AREAS)  
PROPOSED 6" UNDERDRAINS  
MFF XXX.X MINIMUM FINISH FLOOR ELEVATION IS BASED OFF OF THE BELOW  
MLAG XXX.X MINIMUM LOWEST ADJACENT GRADE (FLOOD PROTECTION)

4" SSD TO LOT RISER TC  
DUAL WALL, HANCOR HI-Q TYPE 4 SSD (SIZE NOTED ON PLANS) SEE SUMP PLAN SHEETS C603 FOR CLARITY & LABELS

**FLOOD STATEMENT**  
THIS SITE DOES NOT LIE WITHIN A FLOODWAY OR FLOOD PLAIN PER COMMUNITY PANEL No. 18057C0205G OF THE FLOOD INSURANCE RATE MAPS DATED NOVEMBER 19, 2014

**VEGETATIVE COVER**  
EXISTING SITE CONSIST MOSTLY OF GRASS AND WEEDS WITH WOODS ON THE SITE.

**ADJACENT PROPERTIES**  
NORTH: RESIDENTIAL  
EAST: RESIDENTIAL  
SOUTH: RESIDENTIAL  
WEST: RESIDENTIAL

RECORD DRAWING

Dennis D. Olmstead Registered Land Surveyor No. 900012  
12/6/2017  
DENNIS D. OLMSTEAD REGISTERED No. 900012 STATE OF INDIANA LAND SURVEYOR

**DRAINAGE SUMMARY OVERALL**  
Site Acreage=17-20.33 ac.  
Allowable Release Rate:  
10yr = 2.102 c.f.s. 100yr = 6.305 c.f.s.  
Post Developed Release Rate:  
10 yr = 1.622 c.f.s. 100 yr = 5.724 c.f.s.  
Detention Required: 263,864 cubic feet  
Detention Provided: 349,947 cubic feet


**CONTACT:**  
CARMEL UTILITIES (317) 571-2648 FOR WATER LOCATES  
**FOR SANITARY SEWER LOCATES**  
CONTACT: CLAY TOWNSHIP REGIONAL WASTE DISTRICT (317) 844-9200  
**NOTE:**  
FOR STORM AND PIPE CHARTS SEE THIS SHEET

**BENCHMARK:**  
HCBR-5 HAMILTON COUNTY CONTROL DISK AT THE NORTH END OF THE EAST HEADWALL OF DITCH ROAD OVER HENLEY CREEK.

NAVD. 88 ELEV.=888.34  
NAD83 INDIANA STATE PLANE COORDINATES  
BEARING BASED UPON GRID NORTH, INDIANA STATE PLANE, EAST ZONE (NAD 1983). THIS BEARING BASE DIFFERS FROM THE RECORD DEED BEARING BASE BY A ROTATION OF 0°21'01" COUNTER-CLOCKWISE.

- EARTHWORK:**
- EXCAVATION
    - A. Excavated material that is suitable may be used for fills. All unsuitable material and all surplus excavated material not required shall be removed from the site.
    - B. Provide and place any additional fill material from offsite as may be necessary to produce the grades required on plan. Fill obtained from offsite shall be of quality as specified for fills herein and the source approved by the Developer. It will be the responsibility of the Contractor for any costs for fill needed.
  - REMOVAL OF TREES
    - A. All trees and stumps shall be removed from areas to be occupied by a road surface or structure area. Trees and stumps shall not be buried on site.
  - PROTECTION OF TREES
    - A. The Contractor shall, at the direction of the Developer, endeavor to save and protect trees of value and worth which do not impair construction of improvements as designed.
    - B. In the event cut or fill exceeds 0.5 foot over the root area, the Developer shall be consulted with respect to protective measure to be taken, if any, to preserve such trees.
  - REMOVAL OF TOPSOIL
    - A. All topsoil shall be removed from all areas beneath future pavements or building. Topsoil removal shall be to a minimum depth of 6 inches or to the depth indicated in the geotechnical report provided by the Developer to be excavated or filled. Topsoil should be stored at a location where it will not interfere with construction operations. The topsoil shall be free of debris and stones.
  - UTILITIES
    - A. Rules and regulation governing the respective utility shall be observed in executing all work under this section.
    - B. It shall be the responsibility of the Contractor to determine the location of existing underground utilities 2 working days prior to commencing work. For utility locations to be marked call Toll Free 1-800-382-5544 within Indiana or 1-800-428-5200 outside Indiana.
  - SITE GRADING
    - A. Do all cutting, filling, compacting of fills and rough grading required to bring entire project area to subgrade as shown on the drawing.
    - B. The tolerance for paved areas shall not exceed 0.05 feet above established subgrade. All other areas shall not exceed 0.05 feet plus or minus the established grade. Provide roundings at top and bottom of banks and other breaks in grade.
    - C. The Engineer shall be notified when the Contractor has reached the tolerance as stated above, so that field measurements and spot elevations can be verified by the Engineer. The Contractor shall not remove his equipment from the site until the Engineer has verified that the job meets the above tolerance.

**Minimum Flood Protection Grades**  
From Sections 104.02, 302.06 and 303.07 of the City of Carmel Storm Water Technical Standards Manual  
1. Definitions  
a. Minimum Flood Protection Grade of all structures fronting a pond or open ditch shall be no less than 2 feet above any adjacent 100-year local or regional flood elevations, whichever is greater, for all windows, doors, pipe entrances, window wells, and any other structure member where floodwaters can enter a building.  
b. Lowest Adjacent Grade is the elevation of the lowest grade adjacent to a structure, where the soil meets the foundation around the outside of the structure (including structural members such as basement wallfoot, patios, decks, porches, support posts or piers, and rim of window well).  
2. Standard: Lowest Adjacent Grade  
a. General  
i. The Lowest Adjacent Grade for residential, commercial, or industrial buildings shall have two feet of freeboard above the flooding source's 100-year flood elevation under proposed conditions.  
b. For areas outside a Special Flood Hazards Area (SFHA) or FEMA or IDNR designated floodplain  
i. The Lowest Adjacent Grade for all residential, commercial, or industrial buildings adjacent to ponds shall be set a minimum of 2 feet above the 100-year pond elevation or 2 feet above the emergency overflow weir elevation, whichever is higher.  
ii. The Lowest Adjacent Grade for all residential, commercial, or industrial buildings shall be set a minimum of 2 feet above the highest noted overflow path/pooling elevation across the property frontage.  
iii. In addition to the Lowest Adjacent Grade requirements, any basement floor must be at least a foot above the normal water level of any wet-bottom pond.  
3. Design Notes:  
a. Each lot that is adjacent to a pond, open ditch or flooding source has a flood protection grade. There are instances where there are multiple different flooding sources for 1 structure. In this case, there should be a flood protection grade listed for each side of the structure in the event that piping from the structure discharge to either flood source.  
b. Finished floor elevation or the lowest building entry elevation shall be no less than 6 inches above finished grade around the building. Also, the building's lowest entry elevation that is adjacent to and facing a road shall be a minimum of 15 inches above the road elevation.

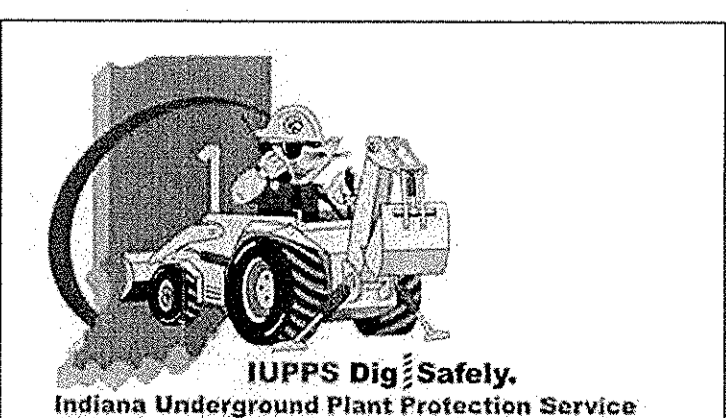

**811**  
Know what's below.  
Call before you dig.

**STRUCTURE TABLE**

STR.#	STR. CALLOUT	STR. TYPE	T.C.	CASTING TYPE	DIAMETER IN	DIRECTION IN	INV. IN	DIAMETER OUT	DIRECTION OUT	INV. OUT	SLOPE
400	OUTLET CONTROL	SEE DETAIL	899.75	SEE DETAIL				15" R.C.P.	SB	899.55	0.26%
401	END SECTION				24" R.C.P.	SW	896.30				
402	DOUBLE CURB INLET	DOUBLE CURB INLET W/ 2' SUMP	901.43	R-3501-TR-TL	15" R.C.P.	W	896.88	24" R.C.P.	NE	896.78	0.51%
403	DOUBLE CURB INLET	DOUBLE CURB INLET	901.55	R-3501-TR-TL	12" R.C.P.	W	897.10	15" R.C.P.	NE	897.00	0.24%
404	YARD INLET	STD. MH.	902.32	R-4342	12" R.C.P.	N	897.54	15" R.C.P.	E	897.44	0.30%
405	YARD INLET	STD. MH.	901.67	R-4342	12" R.C.P.	N	897.78	15" R.C.P.	S	897.79	0.56%
405A	YARD INLET	STD. MH.	902.73	R-4342	12" R.C.P.	N	897.88	15" R.C.P.	S	898.81	0.47%
406	END SECTION				36" R.C.P.	N	896.89				
407	MANHOLE	STD. MH. 60"	903.51	R-1772	36" R.C.P.	N	896.48	36" R.C.P.	S	896.40	0.30%
408	CURB INLET	STD. MH. 60" W/ SUMP	903.64	R-3501-L2	30" R.C.P.	N	896.74	36" R.C.P.	S	896.64	0.22%
408A	CONTECH BMP	CDS3035-6-C-558857-10	903.80	R-1772	36" R.C.P.	S	896.58	36" R.C.P.	S	896.56	0.07%
409	CURB INLET	STD. MH. 60"	903.52	R-3501-L2	30" R.C.P.	NW	896.89	30" R.C.P.	S	896.83	0.35%
410	MANHOLE	STD. MH. 60"	904.46	R-1772	30" R.C.P.	NW	896.95	30" R.C.P.	SE	896.93	0.11%
411	YARD INLET	STD. MH. 60"	902.98	R-4342	24" R.C.P.	N	897.35	30" R.C.P.	S	897.24	0.19%
412	DOUBLE CURB INLET	DOUBLE CURB INLET	904.85	R-3501-TR-TL	24" R.C.P.	W	897.90	24" R.C.P.	E	897.85	0.34%
413	DOUBLE CURB INLET	DOUBLE CURB INLET	904.72	R-3501-TR-TL	24" R.C.P.	W	897.98	24" R.C.P.	E	897.94	0.15%
414	YARD INLET	STD. MH.	902.18	R-4342	18" R.C.P.	N	898.14	24" R.C.P.	E	898.14	0.12%
415	YARD INLET	STD. MH.	902.38	R-4342	18" R.C.P.	N	899.10	18" R.C.P.	S	899.00	0.42%
416	YARD INLET	STD. MH.	901.60	R-4342	18" R.C.P.	E	900.04	18" R.C.P.	S	899.94	0.31%
417	CURB INLET	STD. MH.	900.97	R-3501-L2	15" R.C.P.	SE	900.48	18" R.C.P.	NW	900.37	0.26%
418	CURB INLET	STD. MH.	905.15	R-3501-L2	12" R.C.P.	E	901.00	15" R.C.P.	W	900.70	0.60%
419	END SECTION				12" R.C.P.	W	902.37				4.57%
420	CURB INLET	24X24 BOX	904.86	R-3501-L2	12" R.C.P.	NE	901.15	12" R.C.P.	NE	901.15	0.86%
421	CURB INLET	24X24 BOX	903.57	R-3501-L2	12" R.C.P.	N	899.55	15" R.C.P.	S	899.47	1.25%
422	CURB INLET	24X24 BOX	903.65	R-3501-L2	12" R.C.P.	S	899.81	12" R.C.P.	S	899.81	1.00%
423	CURB INLET	24X24 BOX	903.64	R-3501-L2	12" R.C.P.	E	899.58	15" R.C.P.	W	899.50	1.19%
424	DOUBLE CURB INLET	DOUBLE CURB INLET	903.67	R-3501-TR-TL	12" R.C.P.	W	899.79	12" R.C.P.	W	899.79	0.81%
425	END SECTION				15" R.C.P.	N	896.25				
426	YARD INLET	STD. MH.	902.43	R-4342	15" R.C.P.	N	896.88	15" R.C.P.	S	896.78	0.30%
427	YARD INLET	24X24 BOX	901.28	R-4215-C	12" R.C.P.	N	897.61	15" R.C.P.	S	897.51	0.29%
428	YARD INLET	24X24 BOX	901.39	R-4215-C	12" R.C.P.	S	898.29	12" R.C.P.	S	898.29	0.33%
429	YARD INLET	EXISTING	899.87	R-4342	15" R.C.P.	NW	896.07	15" R.C.P.	W	895.87	
430					12" R.C.P.	E	895.82	21" R.C.P.	SE	895.72	-0.09%

S:\5632PIT-S1\DWG\C200-Site Development Plan.dwg - C201  
December 6, 2017 11:57:47 AM / cesposito  
December 6, 2017 2:03:31 PM / Christian Espoisto

**STOEPPELWERTH**  
SITE DEVELOPMENT PLAN  
WOODSIDE AT WEST CLAY  
HAMILTON COUNTY, INDIANA  
CARMEL

AS BUILT  
REVISED PER COMMENTS  
REVISED PER CTWD COMMENTS  
REVISED PER TAC COMMENTS

DATE MARK

REVISIONS

THIS DRAWING IS NOT INTENDED TO BE REPRESENTED AS A REFERENCE OR SURVEY OR A SURVEYOR LOCATION REPORT.


CERTIFIED: 03/17/17  
David J. Stoepelwerth

7965 East 10th Street, Fishers, IN 46038-2505  
phone: 317.249.2935 fax: 317.849.2942

DRAWN BY: KRK  
CHECKED BY: BKR  
SHEET NO: C201  
S&A JOB NO: 5632PIT-S1



File Name: S:\652PIT-S1DWG\C200-Site Development Plan.dwg - C200  
 Modified By: December 6, 2017 11:57:47 AM / casposito  
 Plotted By: December 6, 2017 2:05:10 PM / Christian Esposto

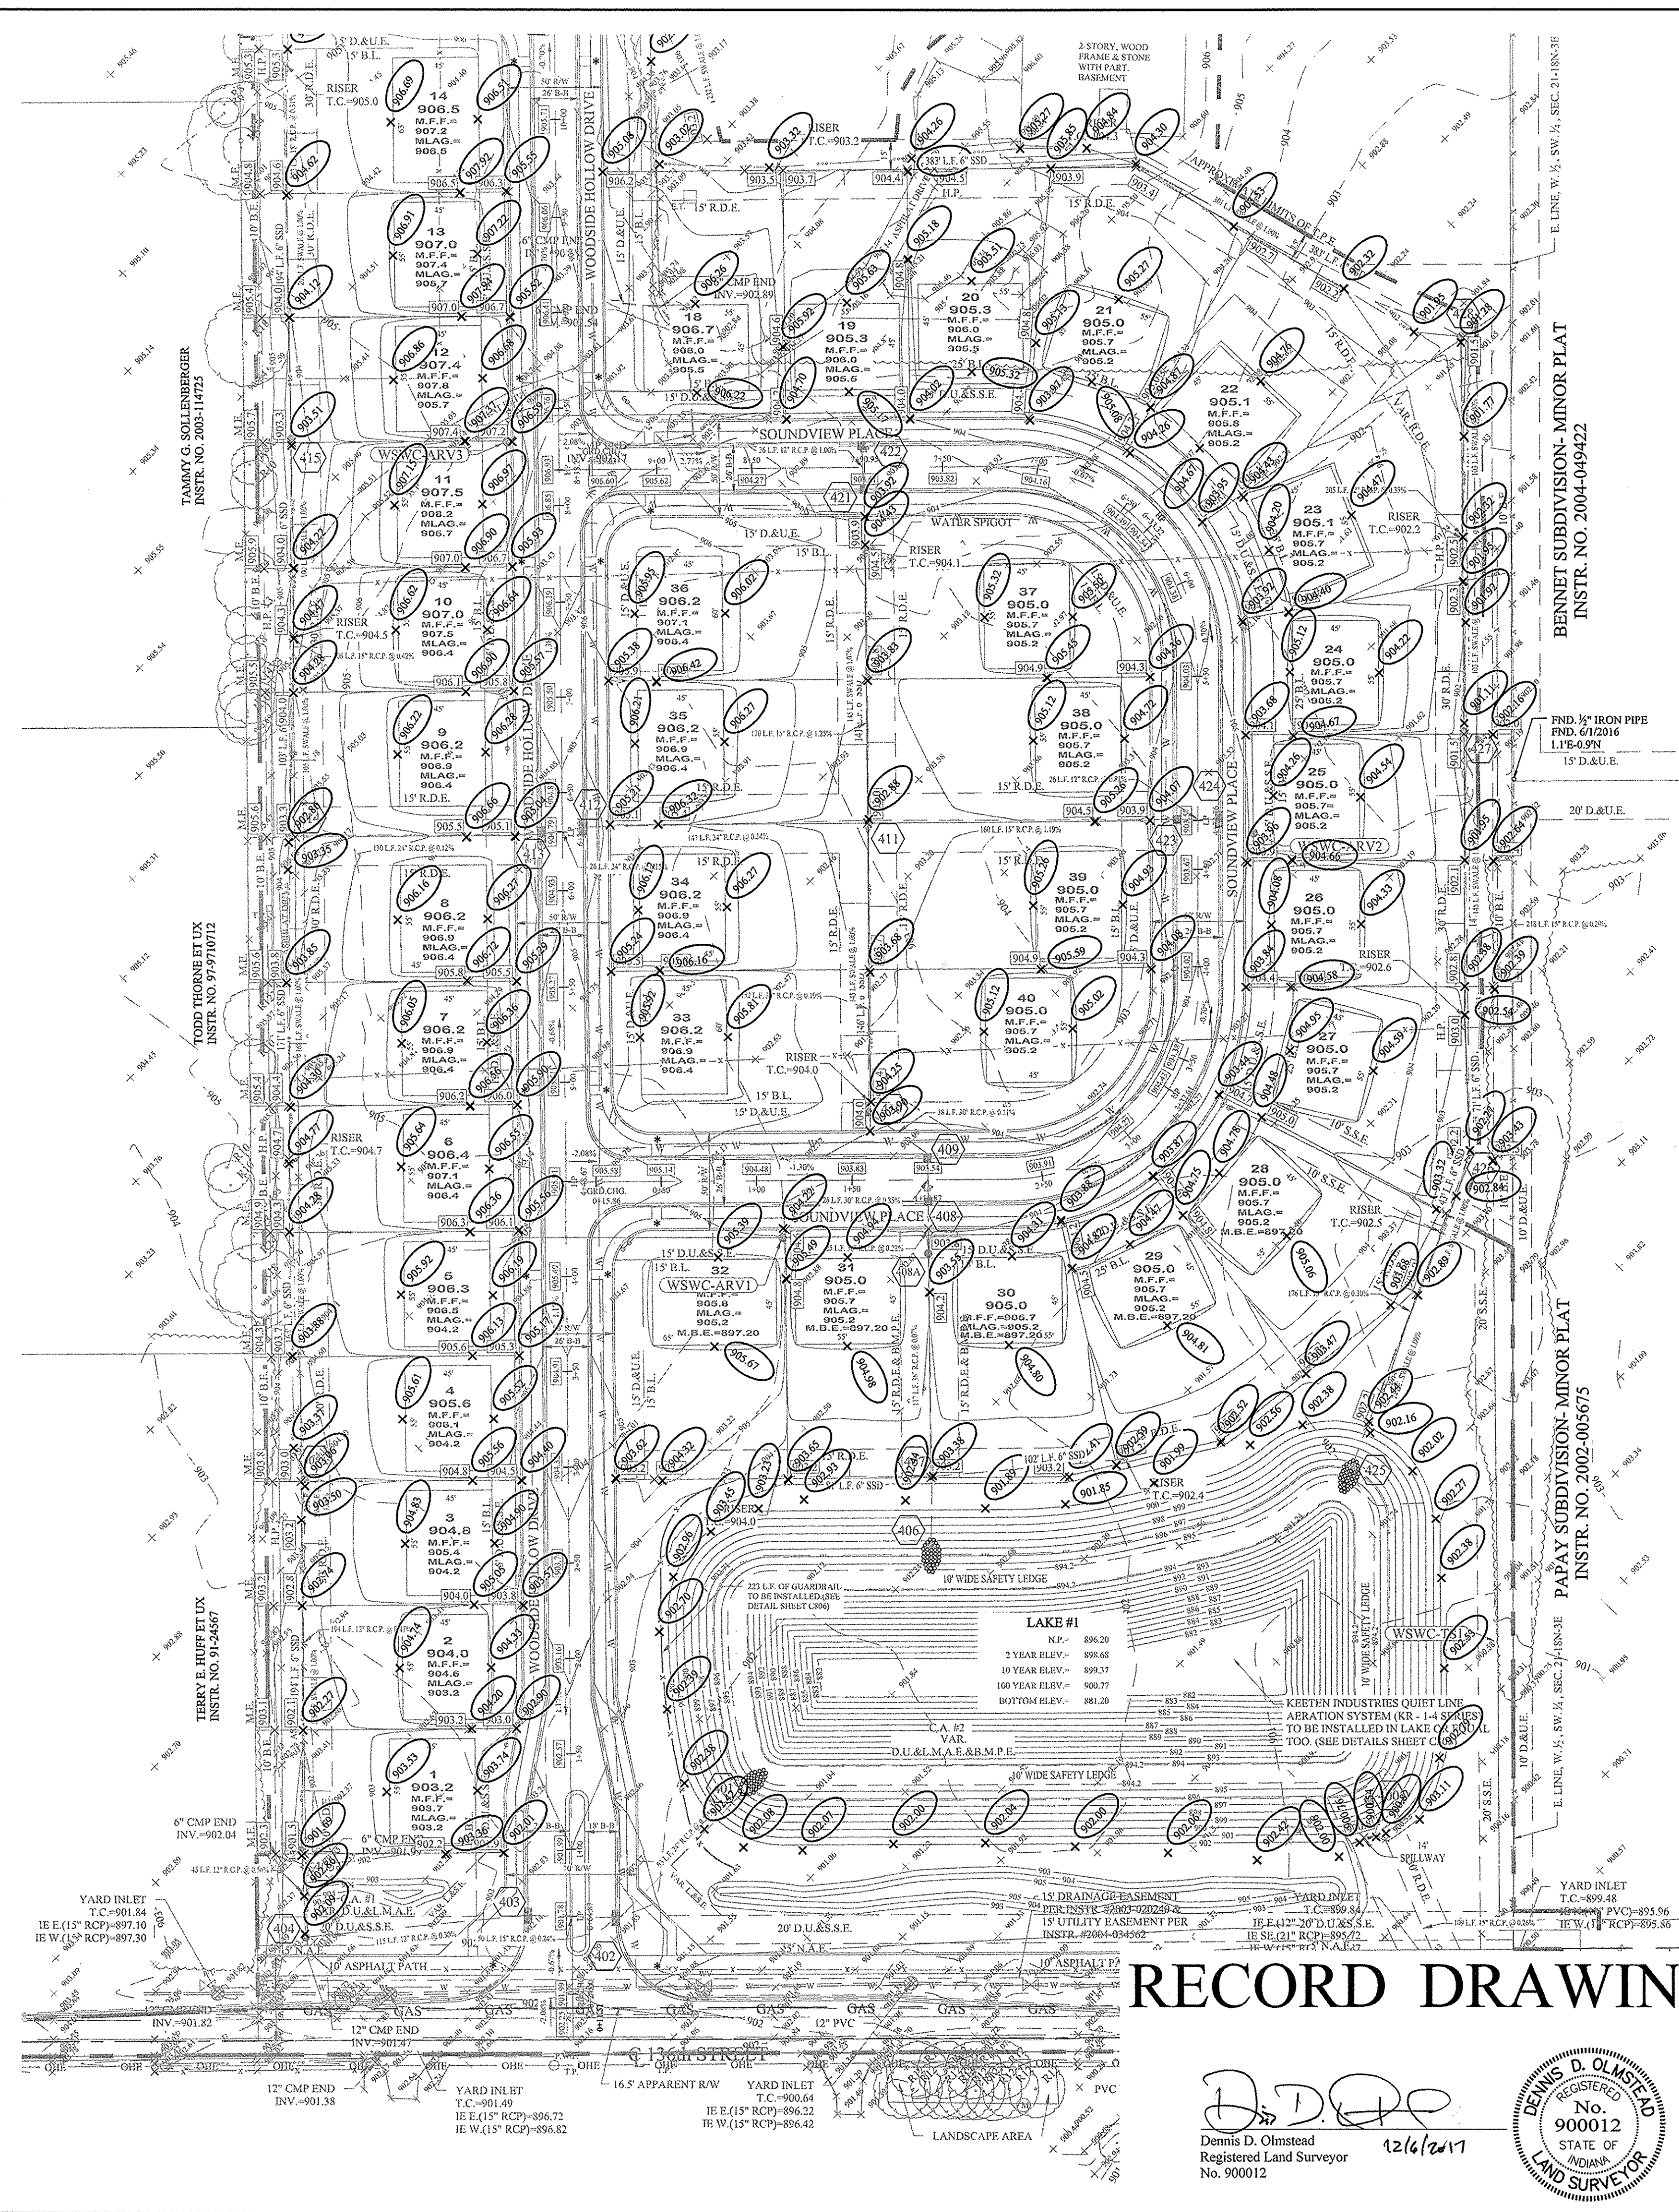

**NOTES TO CONTRACTOR:**  
 ALL PADS SHOULD BE TESTED TO ASSURE A COMPACTION OF AT LEAST 95 PERCENT OF THE MAXIMUM DRY DENSITY USING THE STANDARD PROCTOR TEST METHOD.  
 ANY PRIVATE TILES LOCATED ON THIS SITE WILL NEED TO BE LOCATED; BREATHERS SET AT THE DOWNSTREAM PROPERTY LINE AND CRUSHED OR REMOVED ACROSS THIS SITE. IF ANY OF THESE TILES EXTEND BEYOND THE LIMITS OF THIS PROJECT, THEY WILL NEED TO BE PROVIDED A POSITIVE OUTLET AND ALLOWED TO CONTINUE TO FUNCTION, AS IT IS ILLEGAL TO BLOCK OFF A PRIVATE "MUTUAL" TILE.  
 CONTRACTOR SHALL VERIFY DEPTHS OF ALL EXISTING ONSITE UTILITIES PRIOR TO CONSTRUCTION TO CONFIRM THERE IS NOT ANY CONFLICTS WITH OTHER UTILITIES, STORM SEWERS OR STREETS. CONFLICTS AFTER CONSTRUCTION BEGINS ARE SOLELY THE CONTRACTOR'S RESPONSIBILITY.  
 ALL PAVING WITHIN THE EXISTING AND PROPOSED CITY RIGHT-OF-WAY SHALL CONFORM TO THE REQUIREMENTS OF THE DEPARTMENT OF ENGINEERING. THE CONTRACTOR SHALL CONTACT THE DEPARTMENT OF ENGINEERING TO SCHEDULE A PRE-CONSTRUCTION MEETING TO REVIEW THE DEPARTMENT'S CONSTRUCTION REQUIREMENTS, STAFF NOTIFICATION REQUIREMENTS, REQUIRED INSPECTIONS FOR CERTAIN STAGES OF THE WORK AND TO REVIEW THE AUTHORITY OF THE DEPARTMENT AS IT RELATES TO WORK WITHIN THE EXISTING AND PROPOSED RIGHT-OF-WAY.  
 EXISTING PAVEMENT TO BE SAW CUT TO A CLEAN EDGE ADJACENT TO ANY WIDENING, AUXILIARY LANES, ETC.  
 NO EARTH DISTURBING ACTIVITY MAY TAKE PLACE WITHOUT AN APPROVED STORM WATER MANAGEMENT PERMIT.  
 THERE IS TO BE NO DRIVEWAY ENCROACHMENTS INTO EASEMENTS BETWEEN LOTS.  
 UTILITY RELOCATIONS REQUIRED BY THE PROJECT SHALL BE THE RESPONSIBILITY OF THE DEVELOPER. UTILITY LINE RELOCATIONS REQUIRED FOR ROAD PROJECTS THAT RESULT IN A CONFLICT WITH PROPOSED DEVELOPMENT SHALL BE THE RESPONSIBILITY OF THE DEVELOPER TO RESOLVE WITH THE UTILITY. EXISTING POLE LINES REQUIRED TO BE RELOCATED TO WITHIN ONE FOOT OF PROPOSED RIGHT-OF-WAY LINE.  
 DAMAGE TO THE EXISTING RIGHT-OF-WAY SHALL BE RESTORED/REPAIRED TO THE SATISFACTION OF THE CITY AT THE COMPLETION OF THE PROJECT. THE CONTRACTOR IS ENCOURAGED TO INSPECT THE RIGHT-OF-WAY WITH THE CITY PRIOR TO THE START OF CONSTRUCTION TO DOCUMENT THE EXISTING CONDITION OF THE RIGHT-OF-WAY.

**FLOOD STATEMENT**  
 THIS SITE DOES NOT LIE WITHIN A FLOODWAY OR FLOOD PLAIN PER COMMUNITY PANEL No. 18057C0205G OF THE FLOOD INSURANCE RATE MAPS DATED NOVEMBER 19, 2014

**VEGETATIVE COVER**  
 EXISTING SITE CONSIST MOSTLY OF GRASS AND WEEDS WITH WOODS ON THE SITE.

**ADJACENT PROPERTIES**  
 NORTH: RESIDENTIAL  
 EAST: RESIDENTIAL  
 SOUTH: RESIDENTIAL  
 WEST: RESIDENTIAL

**DRAINAGE SUMMARY**  
 REFERENCE SHEET C201 FOR DRAINAGE SUMMARY INFORMATION.  
 REFERENCE SHEET C201 FOR STRUCTURE DATA TABLE.

**EARTHWORK:**  
 1. EXCAVATION  
 A. Excavated material that is suitable may be used for fills. All unsuitable material and all surplus excavated material not required shall be removed from the site.  
 B. Provide and place any additional fill material from offsite as may be necessary to produce the grades required on plans. Fill obtained from offsite shall be of quality as specified for fills herein and the source approved by the Developer. It will be the responsibility of the Contractor for any costs for fill needed.  
 2. REMOVAL OF TREES  
 A. All trees and stumps shall be removed from areas to be occupied by a road surface structure area. Trees and stumps shall not be buried on site.  
 3. PROTECTION OF TREES  
 A. The Contractor shall, at the direction of the Developer, endeavor to save and protect trees of value and worth which do not impair construction of improvements as designed.  
 B. In the event cut or fill exceeds 0.5 foot over the root area, the Developer shall be consulted with respect to protective measure to be taken, if any, to preserve such trees.  
 4. REMOVAL OF TOPSOIL  
 A. All topsoil shall be removed from all areas beneath future pavements or building. Topsoil removal shall be to a minimum depth of 6 inches or to the depth indicated in the geotechnical report provided by the Developer to be excavated or filled. Topsoil should be stored at a location where it will not interfere with construction operations. The topsoil shall be free of debris and stones.  
 5. UTILITIES  
 A. Rules and regulation governing the respective utility shall be observed in executing all work under this section.  
 B. It shall be the responsibility of the Contractor to determine the location of existing underground utilities 2 working days prior to commencing work. For utility locations to be marked call Toll Free 1-800-382-5544 within Indiana or 1-800-428-5200 outside Indiana.  
 6. SITE GRADING  
 A. Do all cutting, filling, compacting of fills and rough grading required to bring entire project area to subgrade as shown on the drawing.  
 B. The tolerance for paved areas shall not exceed 0.05 feet above established subgrade. All other areas shall not exceed 0.05 feet plus or minus the established grade. Provide roundings at top and bottom of banks and other breaks in grade.  
 C. The Engineer shall be notified when the Contractor has reached the tolerance as stated above, so that field measurements and spot elevations can be verified by the Engineer. The Contractor shall not remove his equipment from the site until the Engineer has verified that the job meets the above tolerance.

**CONTACT:**  
 CARMEL UTILITIES (317) 571-2648 FOR WATER LOCATES  
 FOR SANITARY SEWER LOCATES  
 CONTACT: CLAY TOWNSHIP REGIONAL WASTE DISTRICT (317) 844-9200  
 NOTE:  
 FOR STORM AND PIPE CHARTS SEE SHEET C201

**REAR R/W**  
 MFPG=XXX.X  
 XX  
 XXX.X  
 MFPG=XXX.X  
 DENOTES REAR PROTECTION GRADE  
 LOT NUMBER  
 PAD ELEVATION  
 DENOTES FRONT PROTECTION GRADE

**MLAG=XXX.X**  
 MINIMUM LOWEST ADJACENT GRADE (FLOOD PROTECTION)

**CONSTRUCTION LIMITS**  
 4" SSD TO LOT  
 RISER TC  
 DUAL WALL, HANCOR HI-Q TYPE 4 SSD (SIZE NOTED ON PLANS)  
 SEE SUMP PLAN SHEETS C603 FOR CLARITY & LABELS








**BENCHMARK:**  
 HCBR-5  
 HAMILTON COUNTY CONTROL DISK AT THE NORTH END OF THE EAST HEADWALL OF DITCH ROAD OVER HENLEY CREEK.

NAVD. 88  
 ELEV. = 888.34

CONTRACTOR SHALL VERIFY DEPTHS OF ALL EXISTING ONSITE UTILITIES PRIOR TO CONSTRUCTION TO CONFIRM THERE IS NOT ANY CONFLICTS WITH OTHER UTILITIES, STORM SEWERS OR STREETS. CONFLICTS AFTER CONSTRUCTION BEGINS ARE SOLELY THE CONTRACTOR'S RESPONSIBILITY.

STORM SEWER FOR THIS PROJECT WILL BE PUBLIC, EXCEPT SUB-SURFACE DRAINS.

ALL STORM SEWERS WITHIN PUBLIC RIGHT-OF-WAY SHALL BE RCP CLASS III.

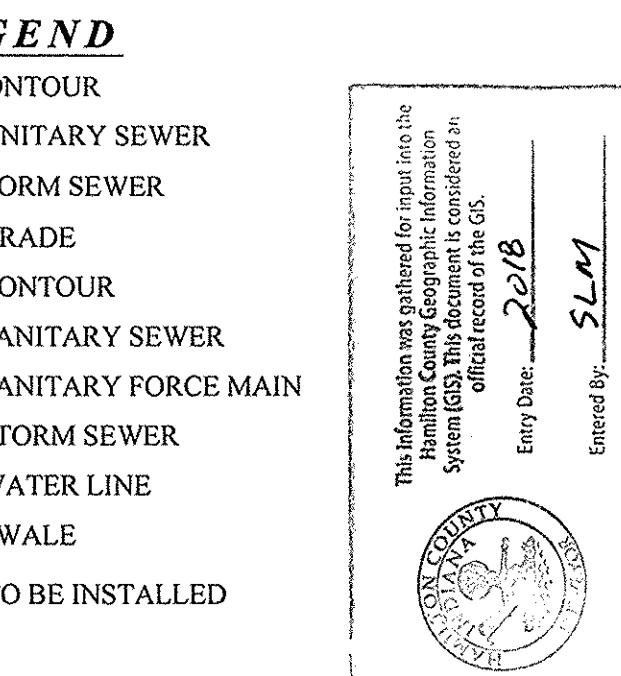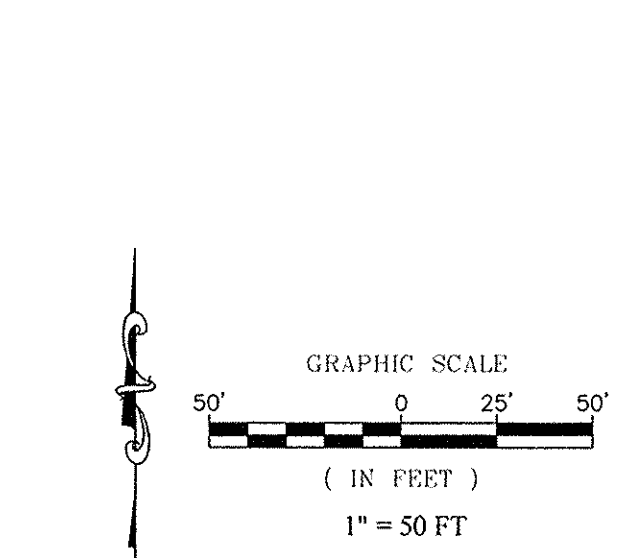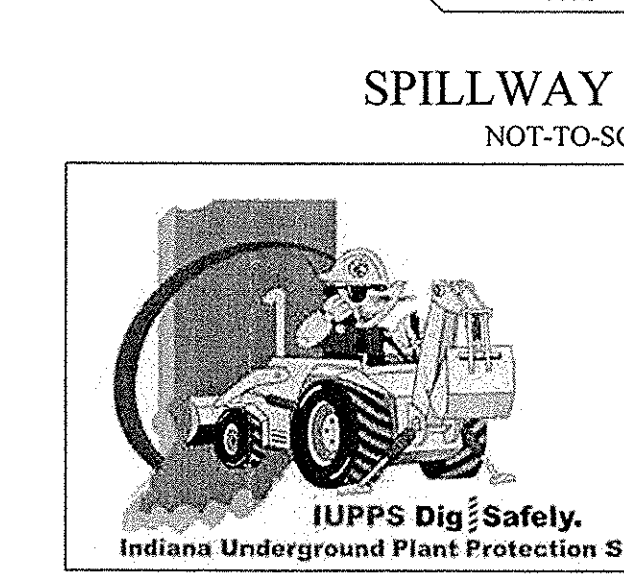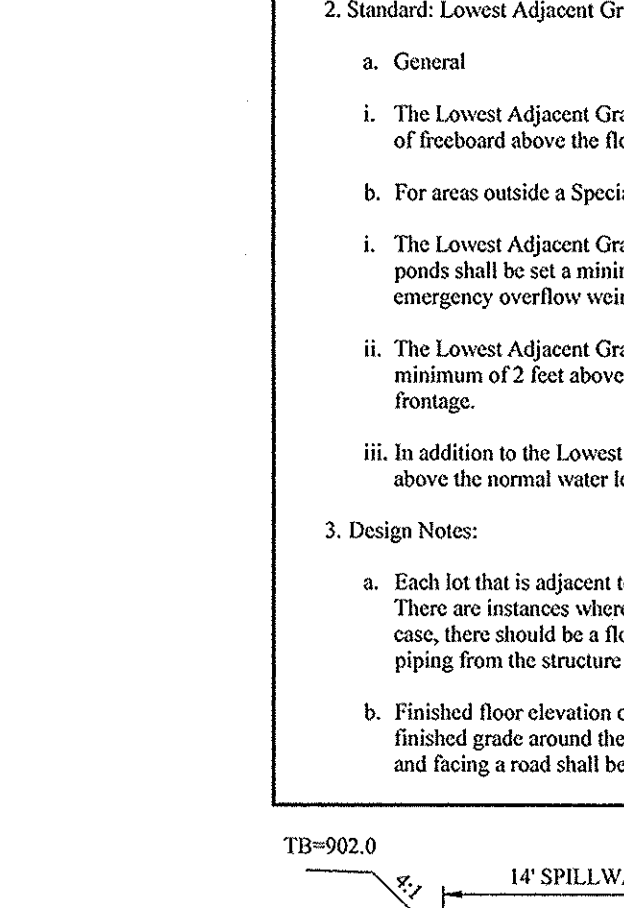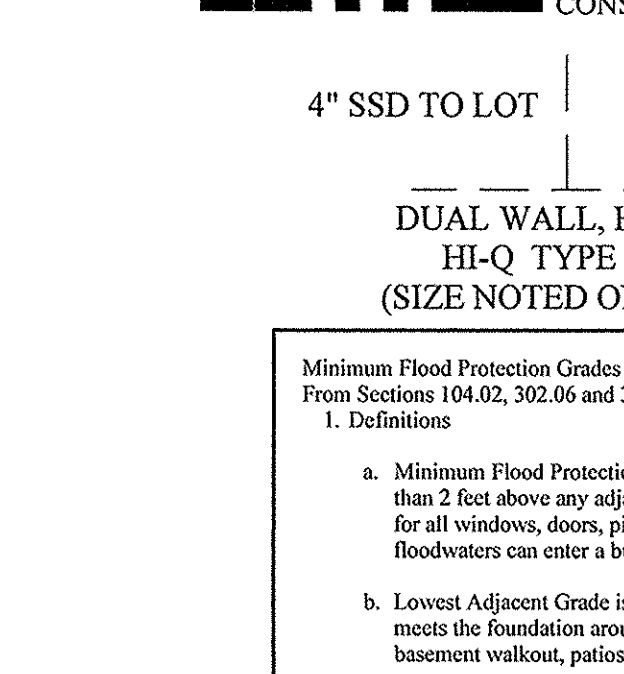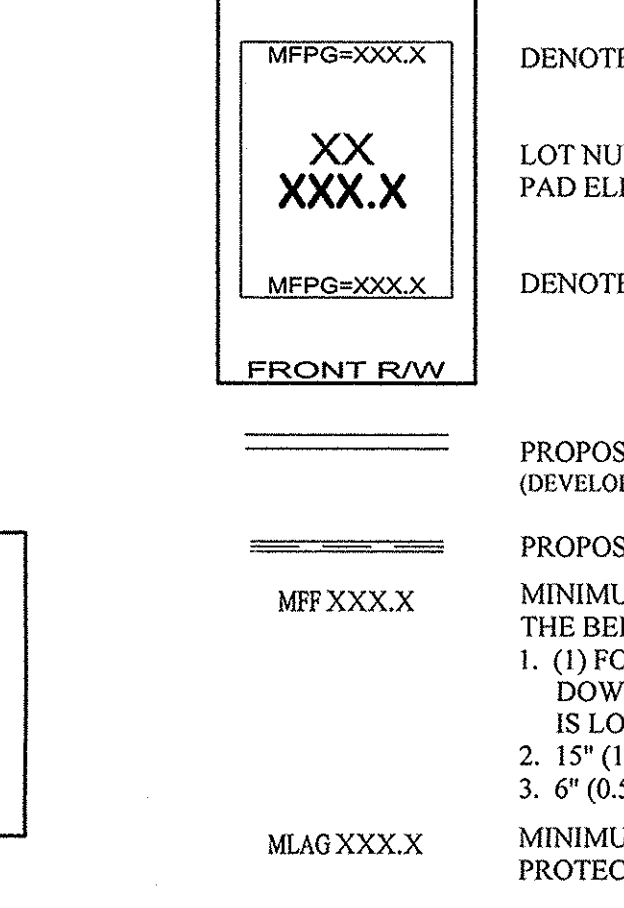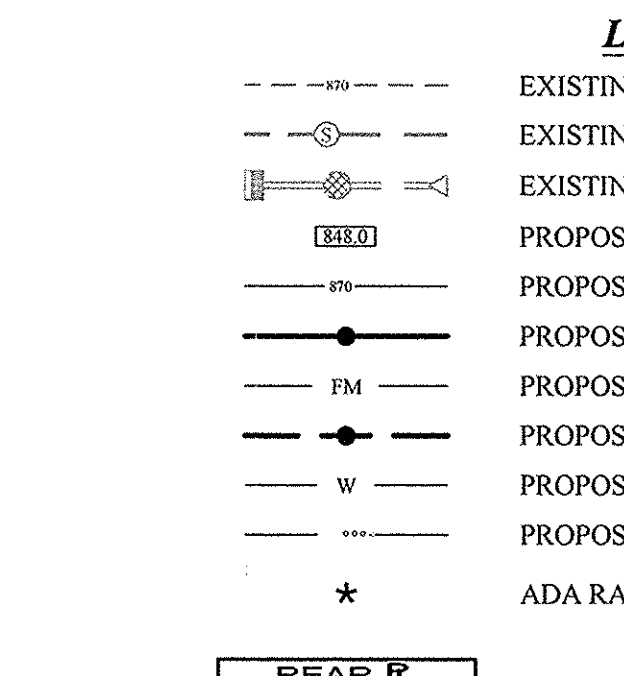

THIS DRAWING IS NOT INTENDED TO BE ORIGINAL BOUNDARY SURVEY, A ROUTE SURVEY OR A SURVEYOR LOCATION REPORT.

CERTIFIED: 03/17/17  
 David J. Stoepelwerth  
 7965 East 110th Street, Fishers, IN 46038-2305  
 phone: 317-849-3935 fax: 317-849-5492

**Minimum Flood Protection Grades**  
 From Sections 104.02, 302.06 and 303.07 of the City of Carmel Storm Water Technical Standards Manual

1. Definitions  
 a. Minimum Flood Protection Grade of all structures fronting a pond or open ditch shall be no less than 2 feet above any adjacent 100-year local or regional flood elevations, whichever is greater, for all windows, doors, pipe entrances, window wells, and any other structure member where floodwaters can enter a building.  
 b. Lowest Adjacent Grade is the elevation of the lowest grade adjacent to a structure, where the soil meets the foundation around the outside of the structure (including structural members such as basement walkout, patios, decks, porches, support posts or piers, and rim of the window well).

2. Standard: Lowest Adjacent Grade  
 a. General  
 i. The Lowest Adjacent Grade for residential, commercial, or industrial buildings shall have two feet of freeboard above the flooding source's 100-year flood elevation under proposed conditions.  
 b. For areas outside a Special Flood Hazards Area (SFHA) or FEMA or IDNR designated floodplain  
 i. The Lowest Adjacent Grade for all residential, commercial, or industrial buildings adjacent to ponds shall be set a minimum of 2 feet above the 100-year pond elevation or 2 feet above the emergency overflow weir elevation, whichever is higher.  
 ii. The Lowest Adjacent Grade for all residential, commercial, or industrial buildings shall be set a minimum of 2 feet above the highest noted overflow path/ponding elevation across the property frontage.  
 iii. In addition to the Lowest Adjacent Grade requirements, any basement floor must be at least a foot above the normal water level of any wet-bottom pond.

3. Design Notes:  
 a. Each lot that is adjacent to a pond, open ditch or flooding source has a flood protection grade. There are instances where there are multiple different flooding sources for 1 structure. In this case, there should be a flood protection grade listed for each side of the structure in the event that piping from the structure discharges to either flood source.  
 b. Finished floor elevation or the lowest building entry elevation shall be no less than 6 inches above finished grade around the building. Also, the building's lowest entry elevation that is adjacent to and facing a road shall be a minimum of 15 inches above the road elevation.

**RECORD DRAWING**

Dennis D. Olmstead  
 Registered Land Surveyor  
 No. 900012  
 12/6/2017

STATE OF INDIANA  
 LAND SURVEYOR

**STOEPPELWERTH**  
 ALWAYS ON  
 7965 East 110th Street, Fishers, IN 46038-2305  
 phone: 317-849-3935 fax: 317-849-5492


**811**  
 Know what's below. Call before you dig.  
 IUPPS Dig Safely, Indiana Underground Plant Protection Service

**C200**  
 SHEET NO. 56325PIT-S1

**REVISIONS**

NO.	DATE	BY	REVISIONS
1	03/17/17	BKR	AS BUILTS
2	06/20/17	BKR	REVISED PER COMMENTS
3	06/20/17	BKR	REVISED PER COMMENTS
4	06/20/17	BKR	REVISED PER TAC COMMENTS
5	06/20/17	BKR	REVISED PER TAC COMMENTS



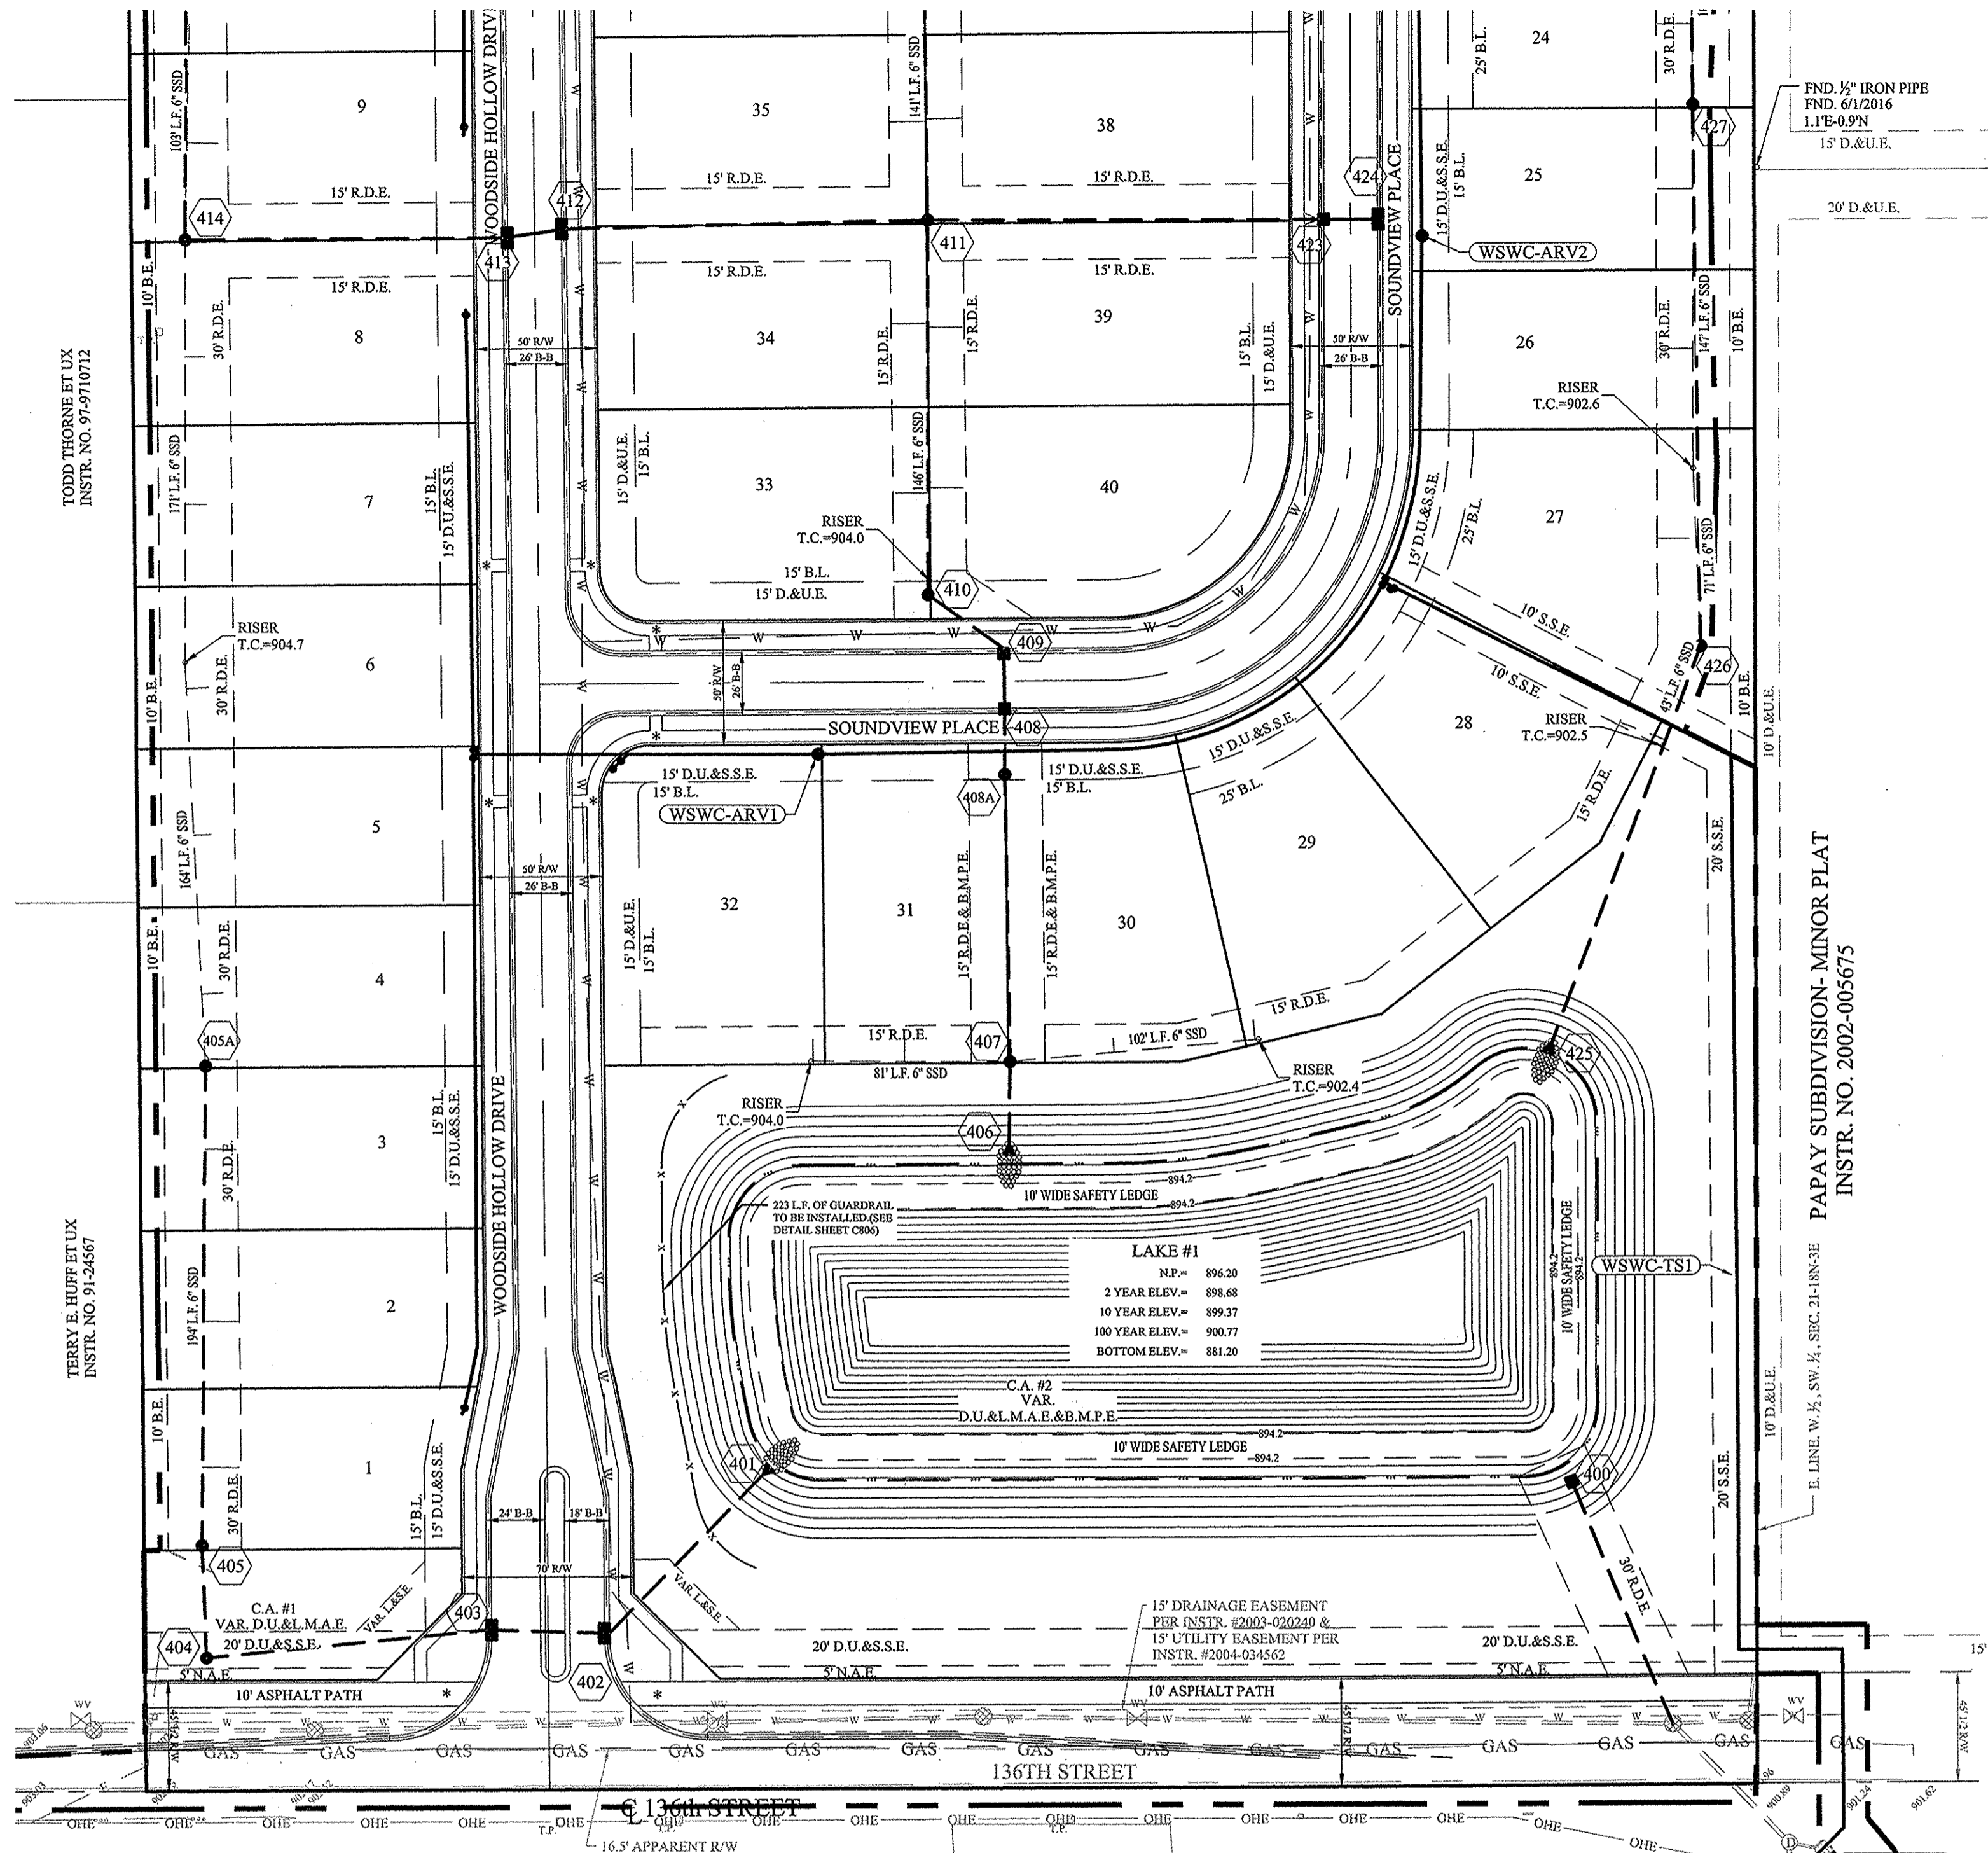


**STORM SEWER NOTE**

THE STORM SEWER SYSTEM SHALL BE CONSTRUCTED PER DESIGN SPECIFIED AND AS APPROVED BY THE CITY OF CARMEL ON THE FINAL APPROVED CONSTRUCTION PLANS. DESIGN SPECIFIED AND AS APPROVED BY THE CITY OF CARMEL ON THE FINAL APPROVED CONSTRUCTION PLANS. DEVIATIONS FROM THE APPROVED DESIGN SHALL ONLY BE PERMITTED DUE TO SPECIAL CIRCUMSTANCES OR DIFFICULTY DURING CONSTRUCTION AND WILL REQUIRE PRIOR FIELD APPROVAL FROM A DESIGNATED REPRESENTATIVE OF THE CITY OR CARMEL IN ADDITION TO SUPPLEMENTAL APPROVAL BY THE DESIGN ENGINEER. AN EXPLANATION OF ANY SUCH DEVIATION SHALL BE INCLUDED AS A REQUIREMENT ON AS-BUILT/RECORD DRAWINGS SUBMITTED FOR RELEASE OF PERFORMANCE GUARANTEES. APPROVED DESIGN SLOPES IDENTIFIED AS GENERATING VELOCITIES OF 2.5 FPS OR LESS AND 10 FPS OR GREATER (AT FULL FLOW CAPACITY) SHALL REQUIRE AS-BUILT CERTIFICATION AT THE TIME OF CONSTRUCTION, PRIOR TO BACKFILLING THE PIPE. THE CONTRACTOR IS INSTRUCTED TO AS-BUILT EACH SECTION OF STORM PIPE AS IT IS BEING INSTALLED TO ENSURE COMPLIANCE WITH THE DESIGN PLANS. AND AS APPROVED BY THE CITY OF CARMEL.


MINIMUM COVER FOR PIPE: THE MINIMUM COVER FROM THE TOP OF THE INSTALLED PAVEMENT TO THE TOP OF THE INSTALLED PIPE SHALL BE THE PAVEMENT SECTION, THICKNESS (ALL BITUMINOUS AND AGGREGATE MATERIAL ABOVE THE SUBGRADE) PLUS 1'-0", BUT UNDER NO CIRCUMSTANCES SHALL THE COVER ALONG ANY PART OF THE PIPE FROM THE FINAL PAVEMENT OR FINAL GROUND SURFACE ELEVATION TO THE TOP OF THE PIPE BE LESS THAN 2.5 FEET.

**STORM SYSTEM**  
WITH THE EXCEPTION OF REAR YARD SSDS, STORM SEWERS FOR THIS DEVELOPMENT WILL BE PUBLIC.


CONTRACTOR SHALL VERIFY DEPTHS OF ALL EXISTING ON-SITE UTILITIES PRIOR TO CONSTRUCTION TO CONFIRM THERE IS NOT ANY CONFLICTS WITH OTHER UTILITIES, STORM SEWERS OR STREETS. CONFLICTS AFTER CONSTRUCTION BEGINS ARE SOLELY THE CONTRACTOR'S RESPONSIBILITY.

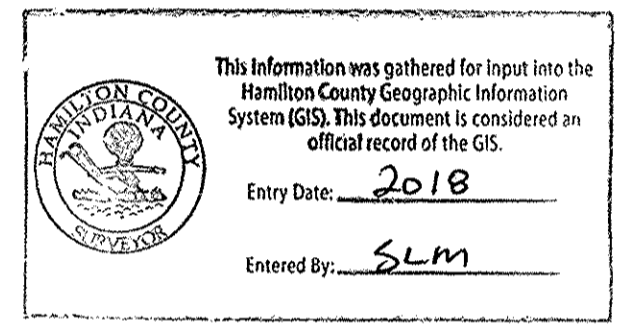

- NOTES:
- ALL STORM STRUCTURES TO RECEIVE SOLID LID CASTINGS ARE TO BE CONSTRUCTED TO PROVIDE ONE 4" RISER RING NO MORE, NO LESS TO ACHIEVE PLAN RIM GRADE.
  - ALL YARD INLETS ARE TO BE CONSTRUCTED AT A TOLERANCE OF +0.00' TO -0.20' OF PLAN GRADE.
  - ALL STORM SEWER CASTINGS SHALL BE LABELED "DUMP NO WASTE-DRAINS TO WATERWAY"
  - ALL SSD'S (SUBSURFACE DRAINS) WILL NEED TO BE DOUBLE WALL SMOOTH BORE PERFORATED (HDPE) PIPE.
  - DEBRIS GUARDS ARE TO BE INSTALLED ON ALL OPEN ENDED INLETS.
  - FOR STORM STRUCTURE SIZING AND CASTING TABLE SEE DETAIL D-18 ON SHEET C802.
  - ALL STORM SEWERS WITHIN PUBLIC RIGHT-OF-WAY SHALL BE RCP CLASS III.
  - FOR INSTALLATION OF STORM UNDER CITY STREETS AND COVER REQUIREMENTS, SEE SHEET No. C802 ON THE TRENCH DETAIL.
  - ALL TOP OF CASTING ELEVATIONS FOR STORM SEWERS SHALL BE CONSTRUCTED WITH A TOLERANCE OF 0.10 FT.±

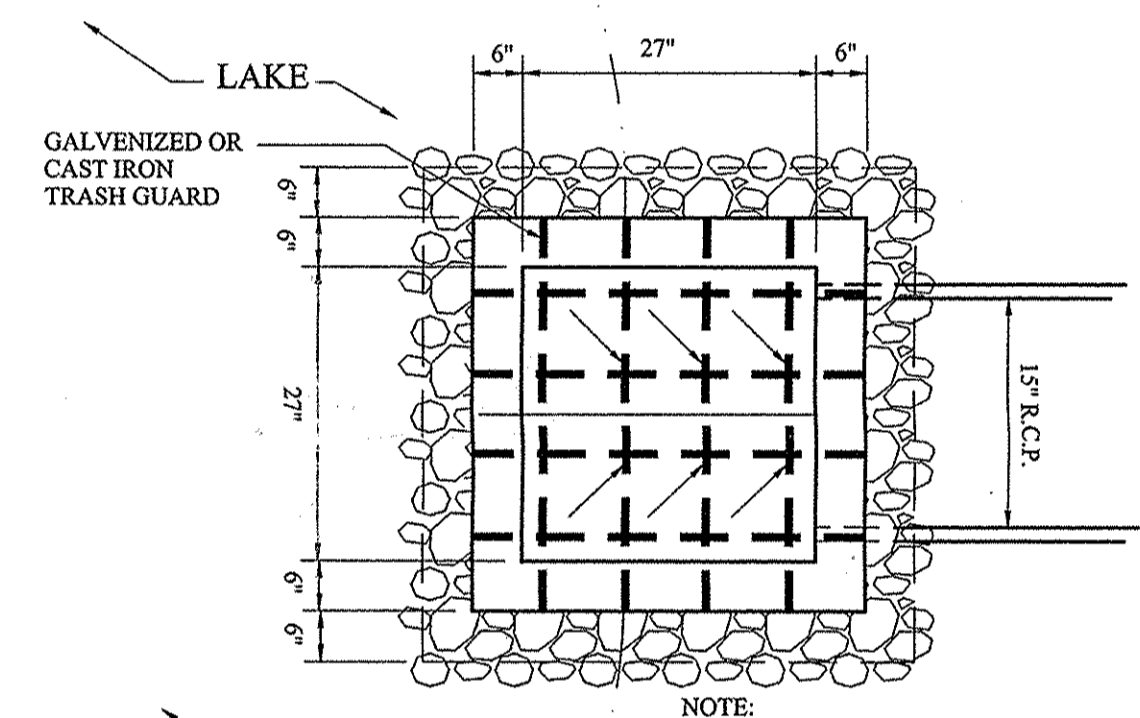

NOTE: CONTRACTOR SHALL VERIFY PROPER METHOD OF ATTACHING TO OUTLET STRUCTURE PRIOR TO FABRICATION & INSTALLATION

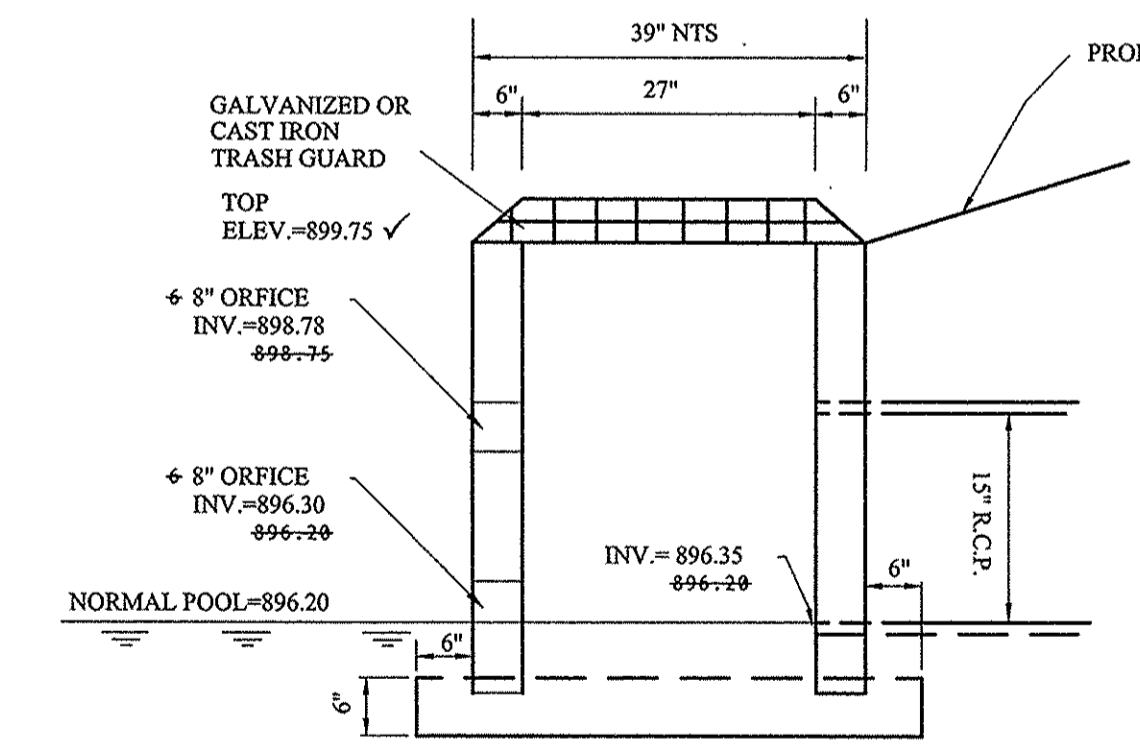


OUTLET CONTROL STRUCTURE #400 DETAIL NOT TO SCALE

BENCHMARK:  
HCBR-5  
HAMILTON COUNTY CONTROL DISK  
AT THE NORTH END OF THE EAST  
HEADWALL OF DITCH ROAD OVER  
HENLEY CREEK.

NAVD. 88  
ELEV.=888.34


**RECORD DRAWING**

Dennis D. Olmstead  
Registered Land Surveyor  
No. 900012

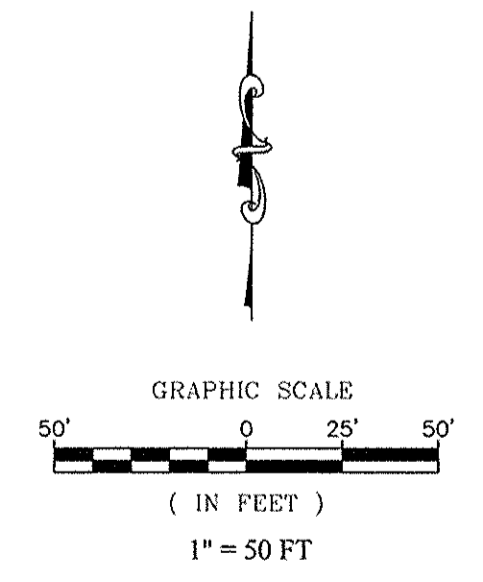


DENOTES FULL DEPTH GRANULAR BACKFILL SEE RCP TRENCH DETAIL SHEET C802


1" = 50' HOR.  
1" = 5' VERT.

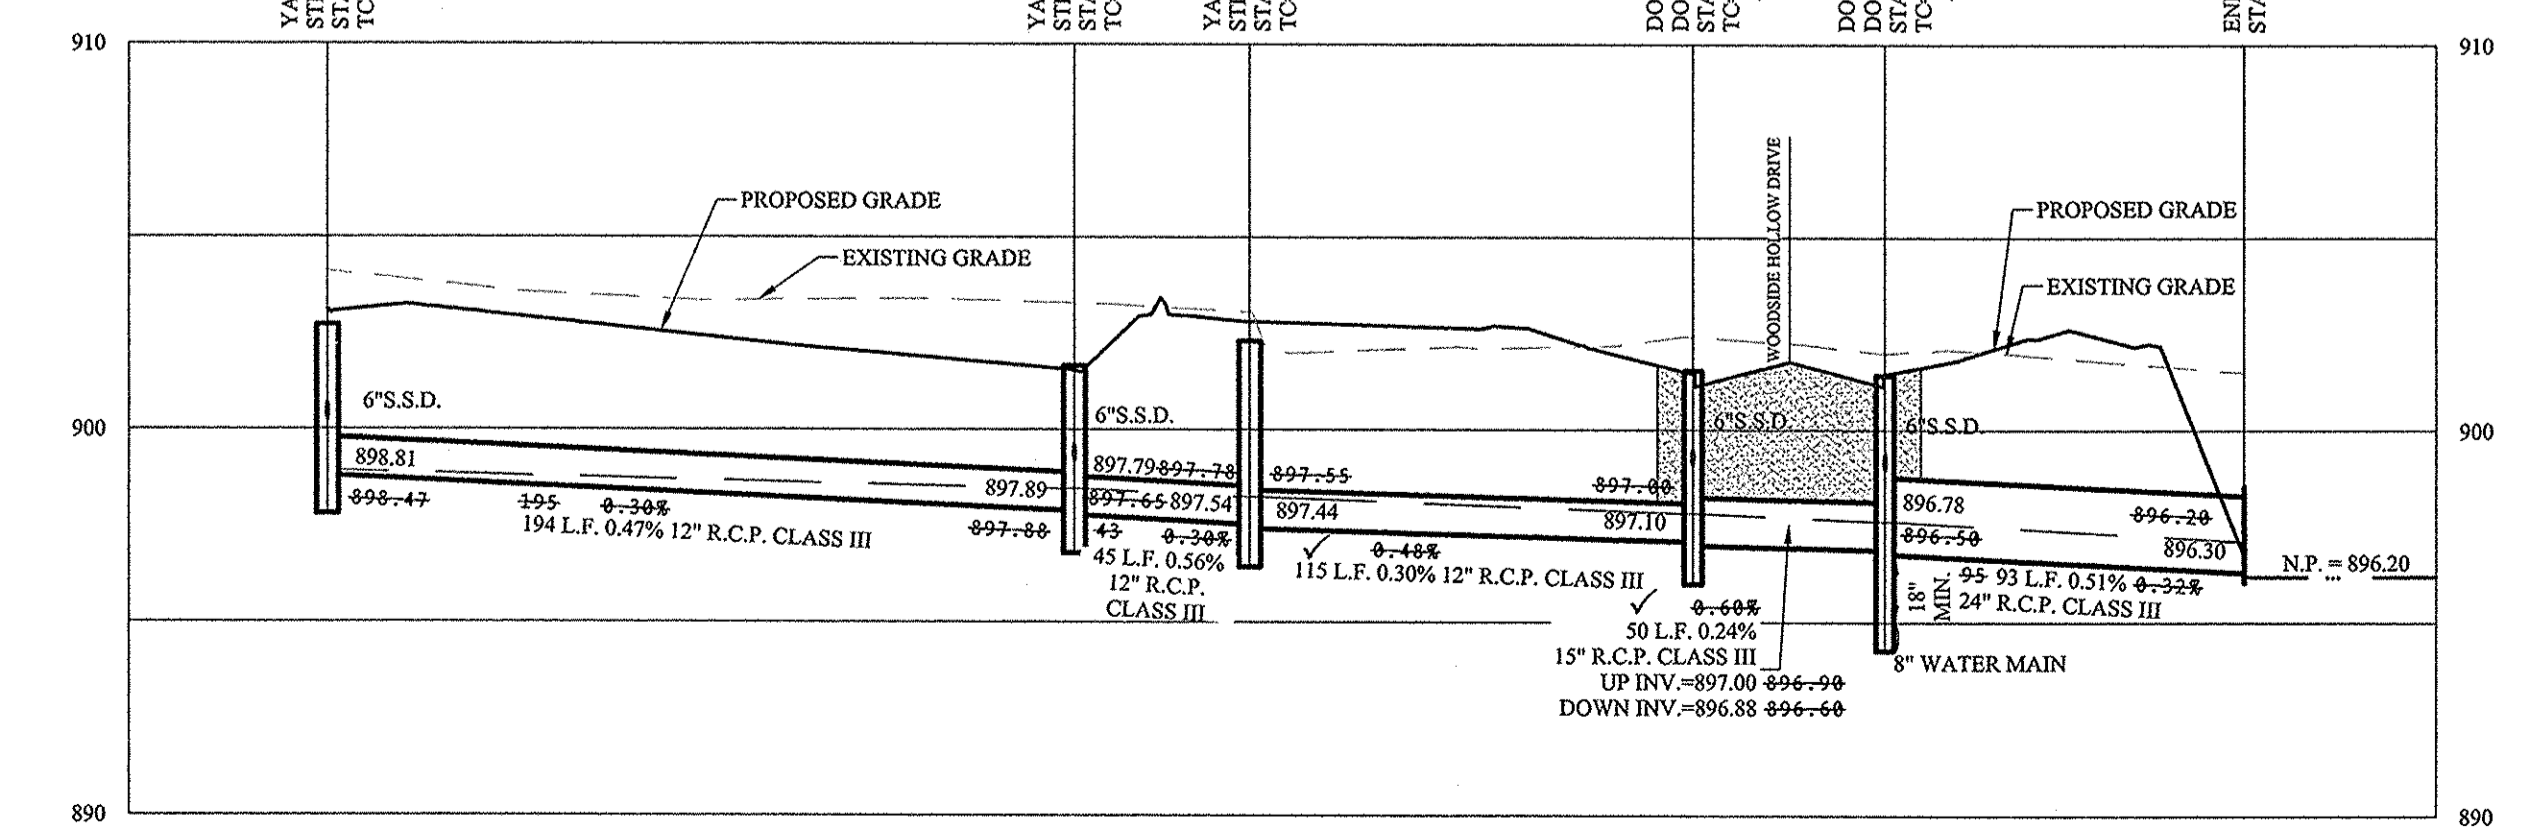

SCALE: 1" = 50' HOR.  
1" = 5' VERT.

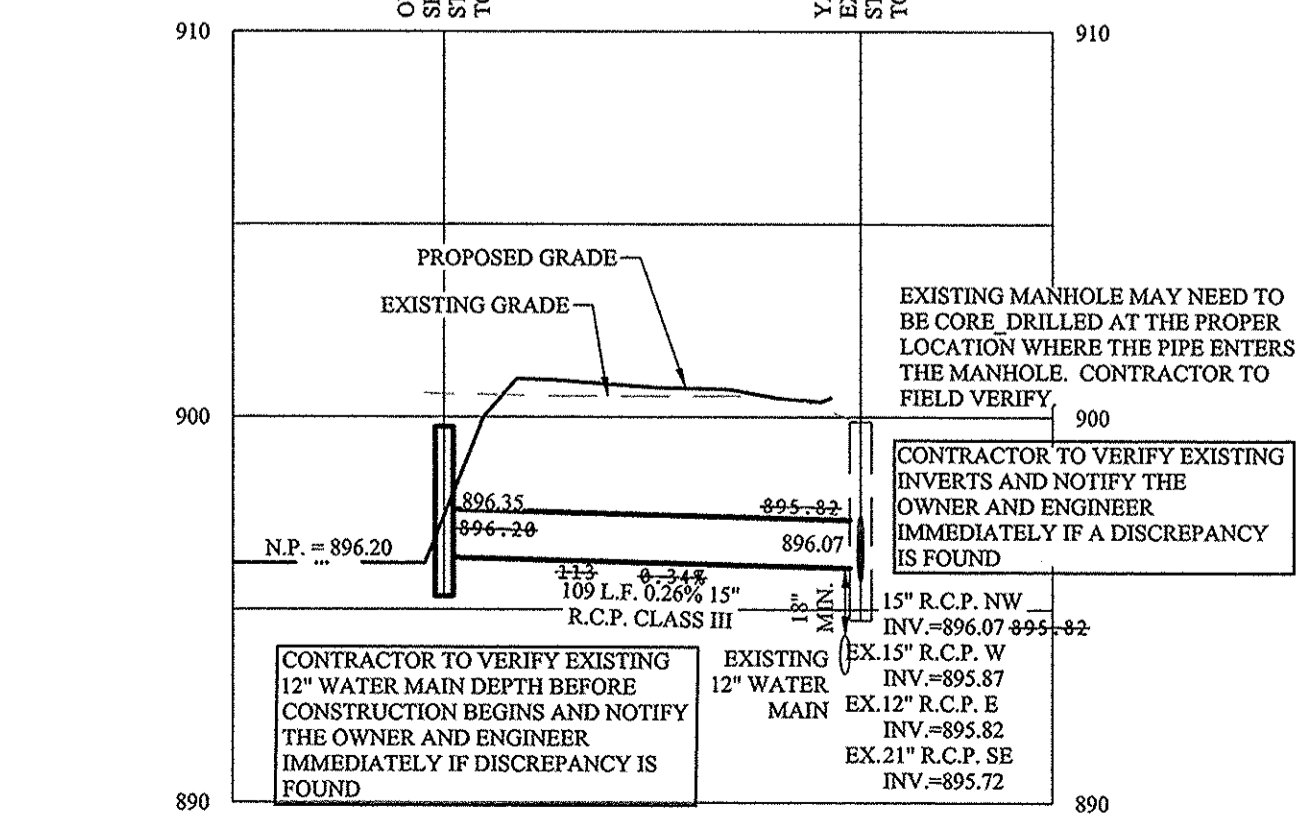

CONTRACTOR TO VERIFY EXISTING 12" WATER MAIN DEPTH BEFORE CONSTRUCTION BEGINS AND NOTIFY THE OWNER AND ENGINEER IMMEDIATELY IF A DISCREPANCY IS FOUND

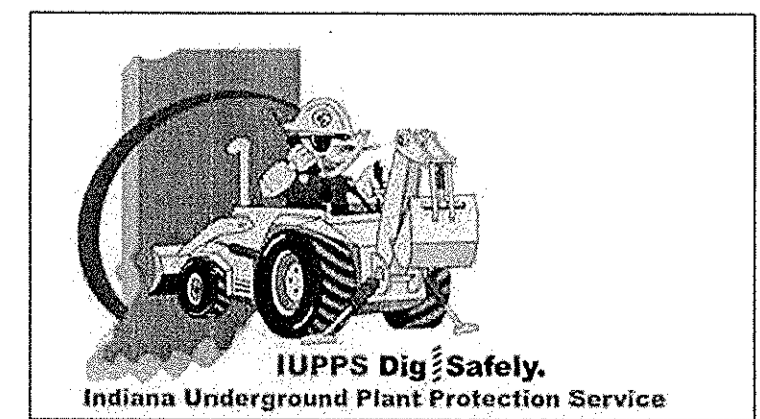

Know what's below.  
Call before you dig.

**STOEPPELWERTH**  
ALWAYS ON  
7965 East 10th Street, Fishers, IN 46038-2505  
Phone: 317.849.5953 Fax: 317.849.5942

**REGISTERED PROFESSIONAL ENGINEER**  
No. 19358  
STATE OF INDIANA  
CERTIFIED: 03/17/17  
David J. Stappert




**STORM PLAN & PROFILES**  
**WOODSIDE AT WEST CLAY**  
HAMILTON COUNTY, INDIANA  
CARMEL

AS BUILTS	2/20/17	REGISTERED
ADDED EX WATER CROSSING	07/17/17	REGISTERED
REVISED PER COMMENTS	06/07/17	REGISTERED
REVISED PER CTW COMMENTS	06/07/17	REGISTERED
REVISED PER TAC COMMENTS	06/07/17	REGISTERED
DCM		
DCM		
DCM		
BY		

DRAWN BY: KKG  
CHECKED BY: BKR  
SHEET NO: C600  
S & A JOB NO: 56325PIT-SI-1



S:\6525PIT-SI\DWG\C600-Storm Plan & Profiles.dwg - C600  
December 5, 2017 2:05:16 PM / Christian Esposito  
Plotted By: Christian Esposito  
December 5, 2017 2:05:16 PM / Christian Esposito



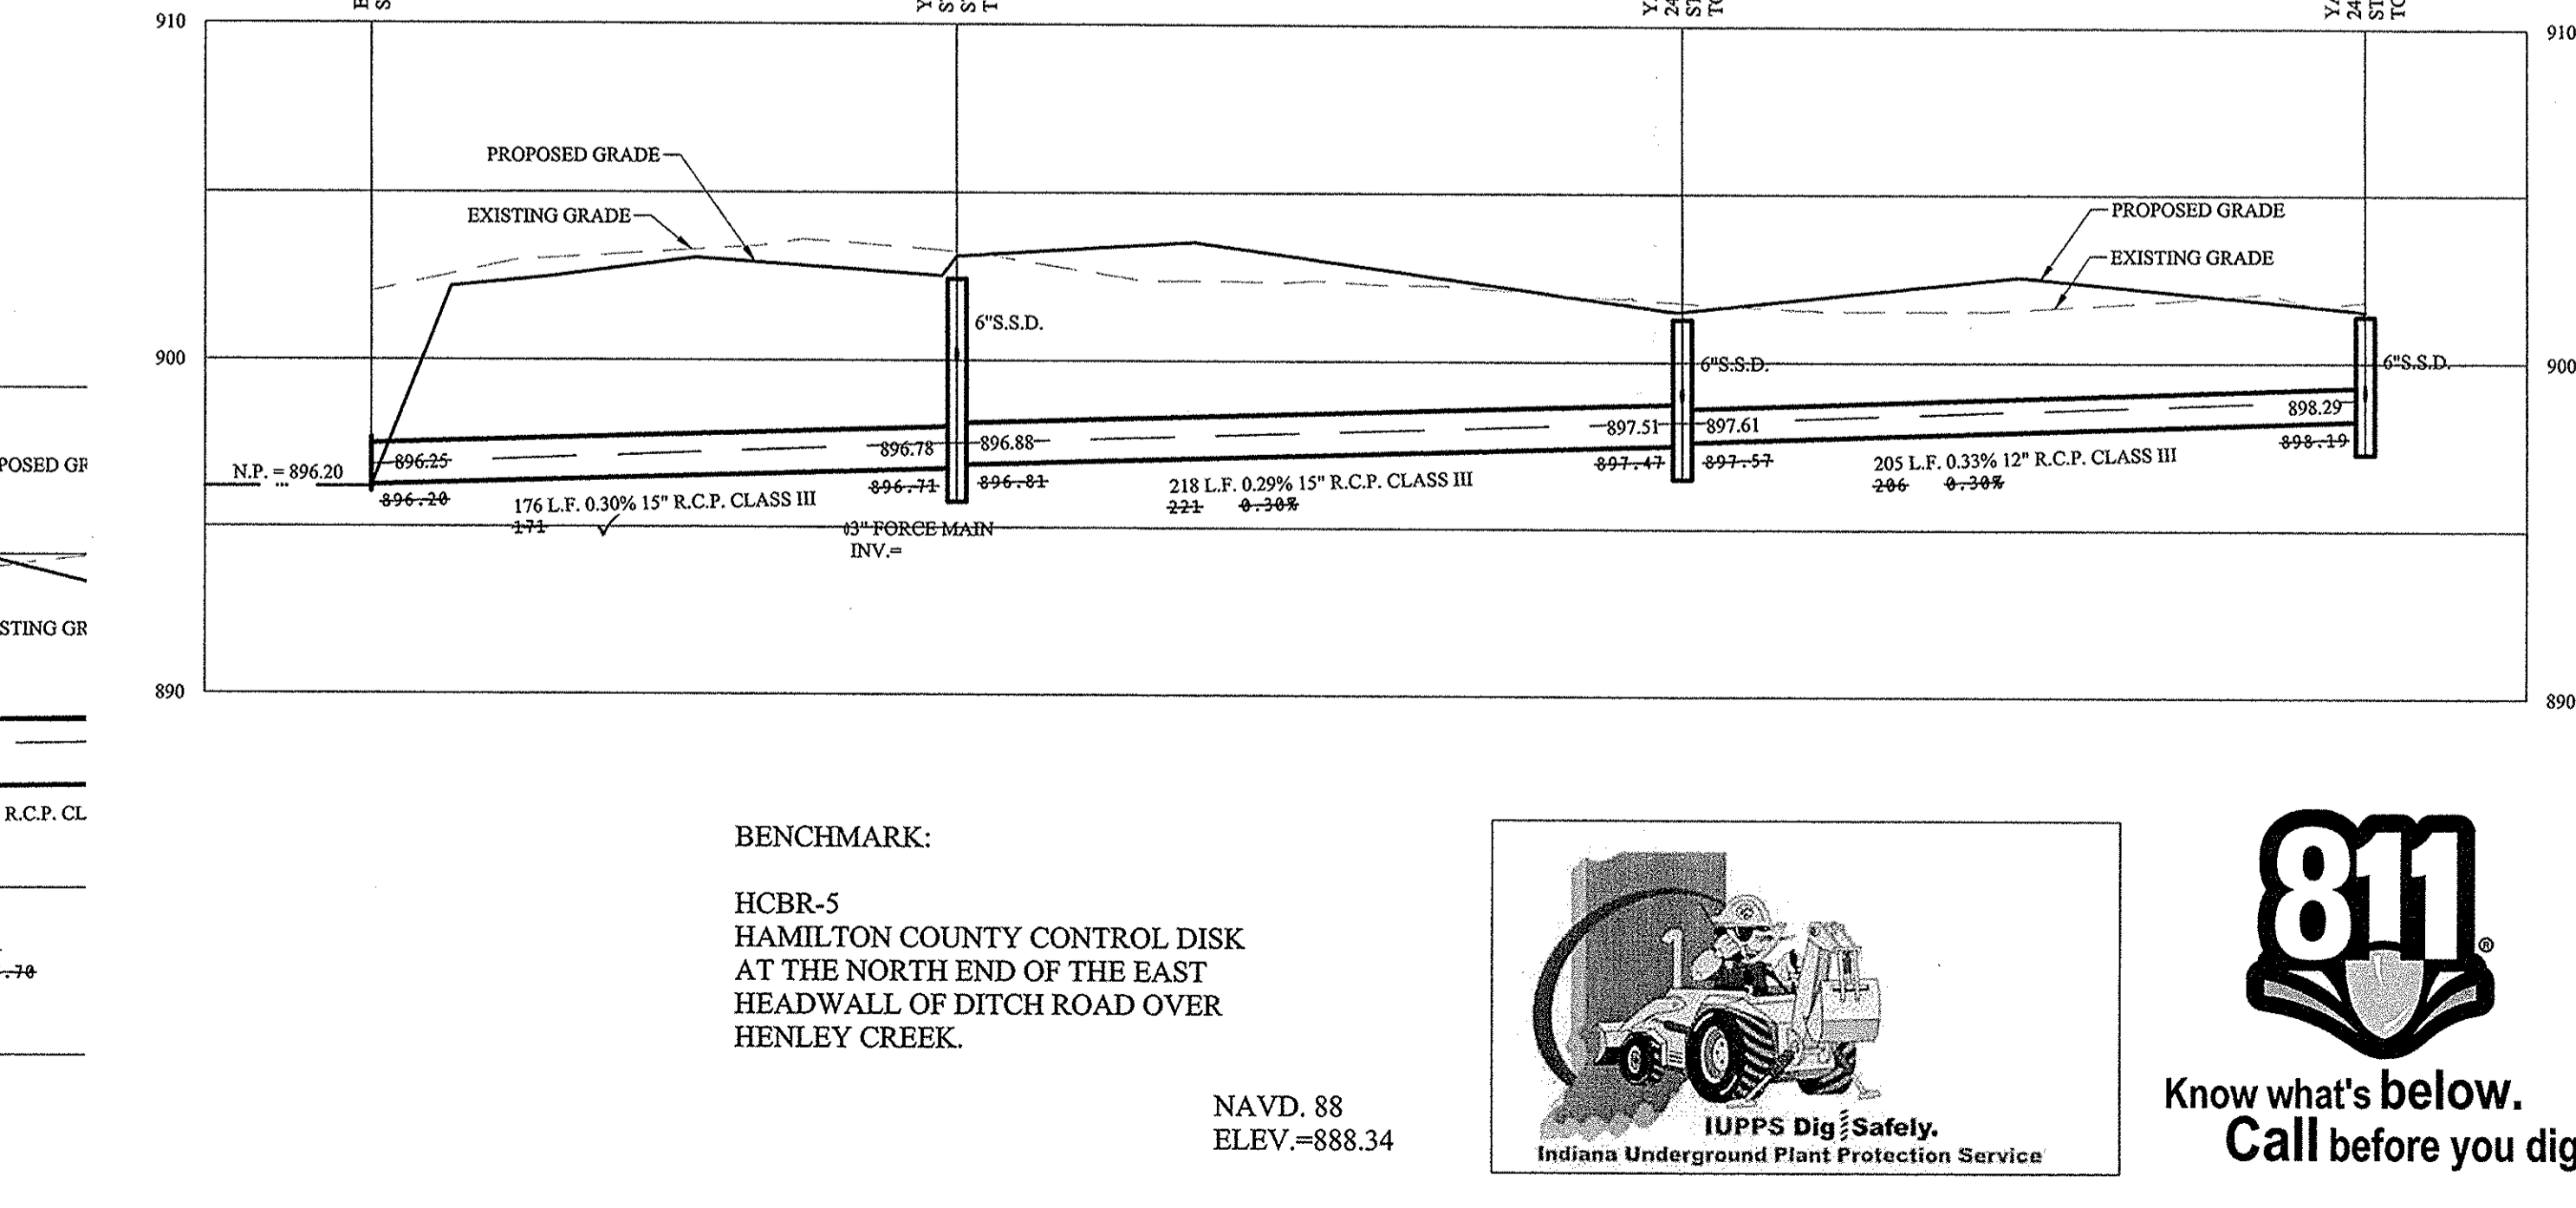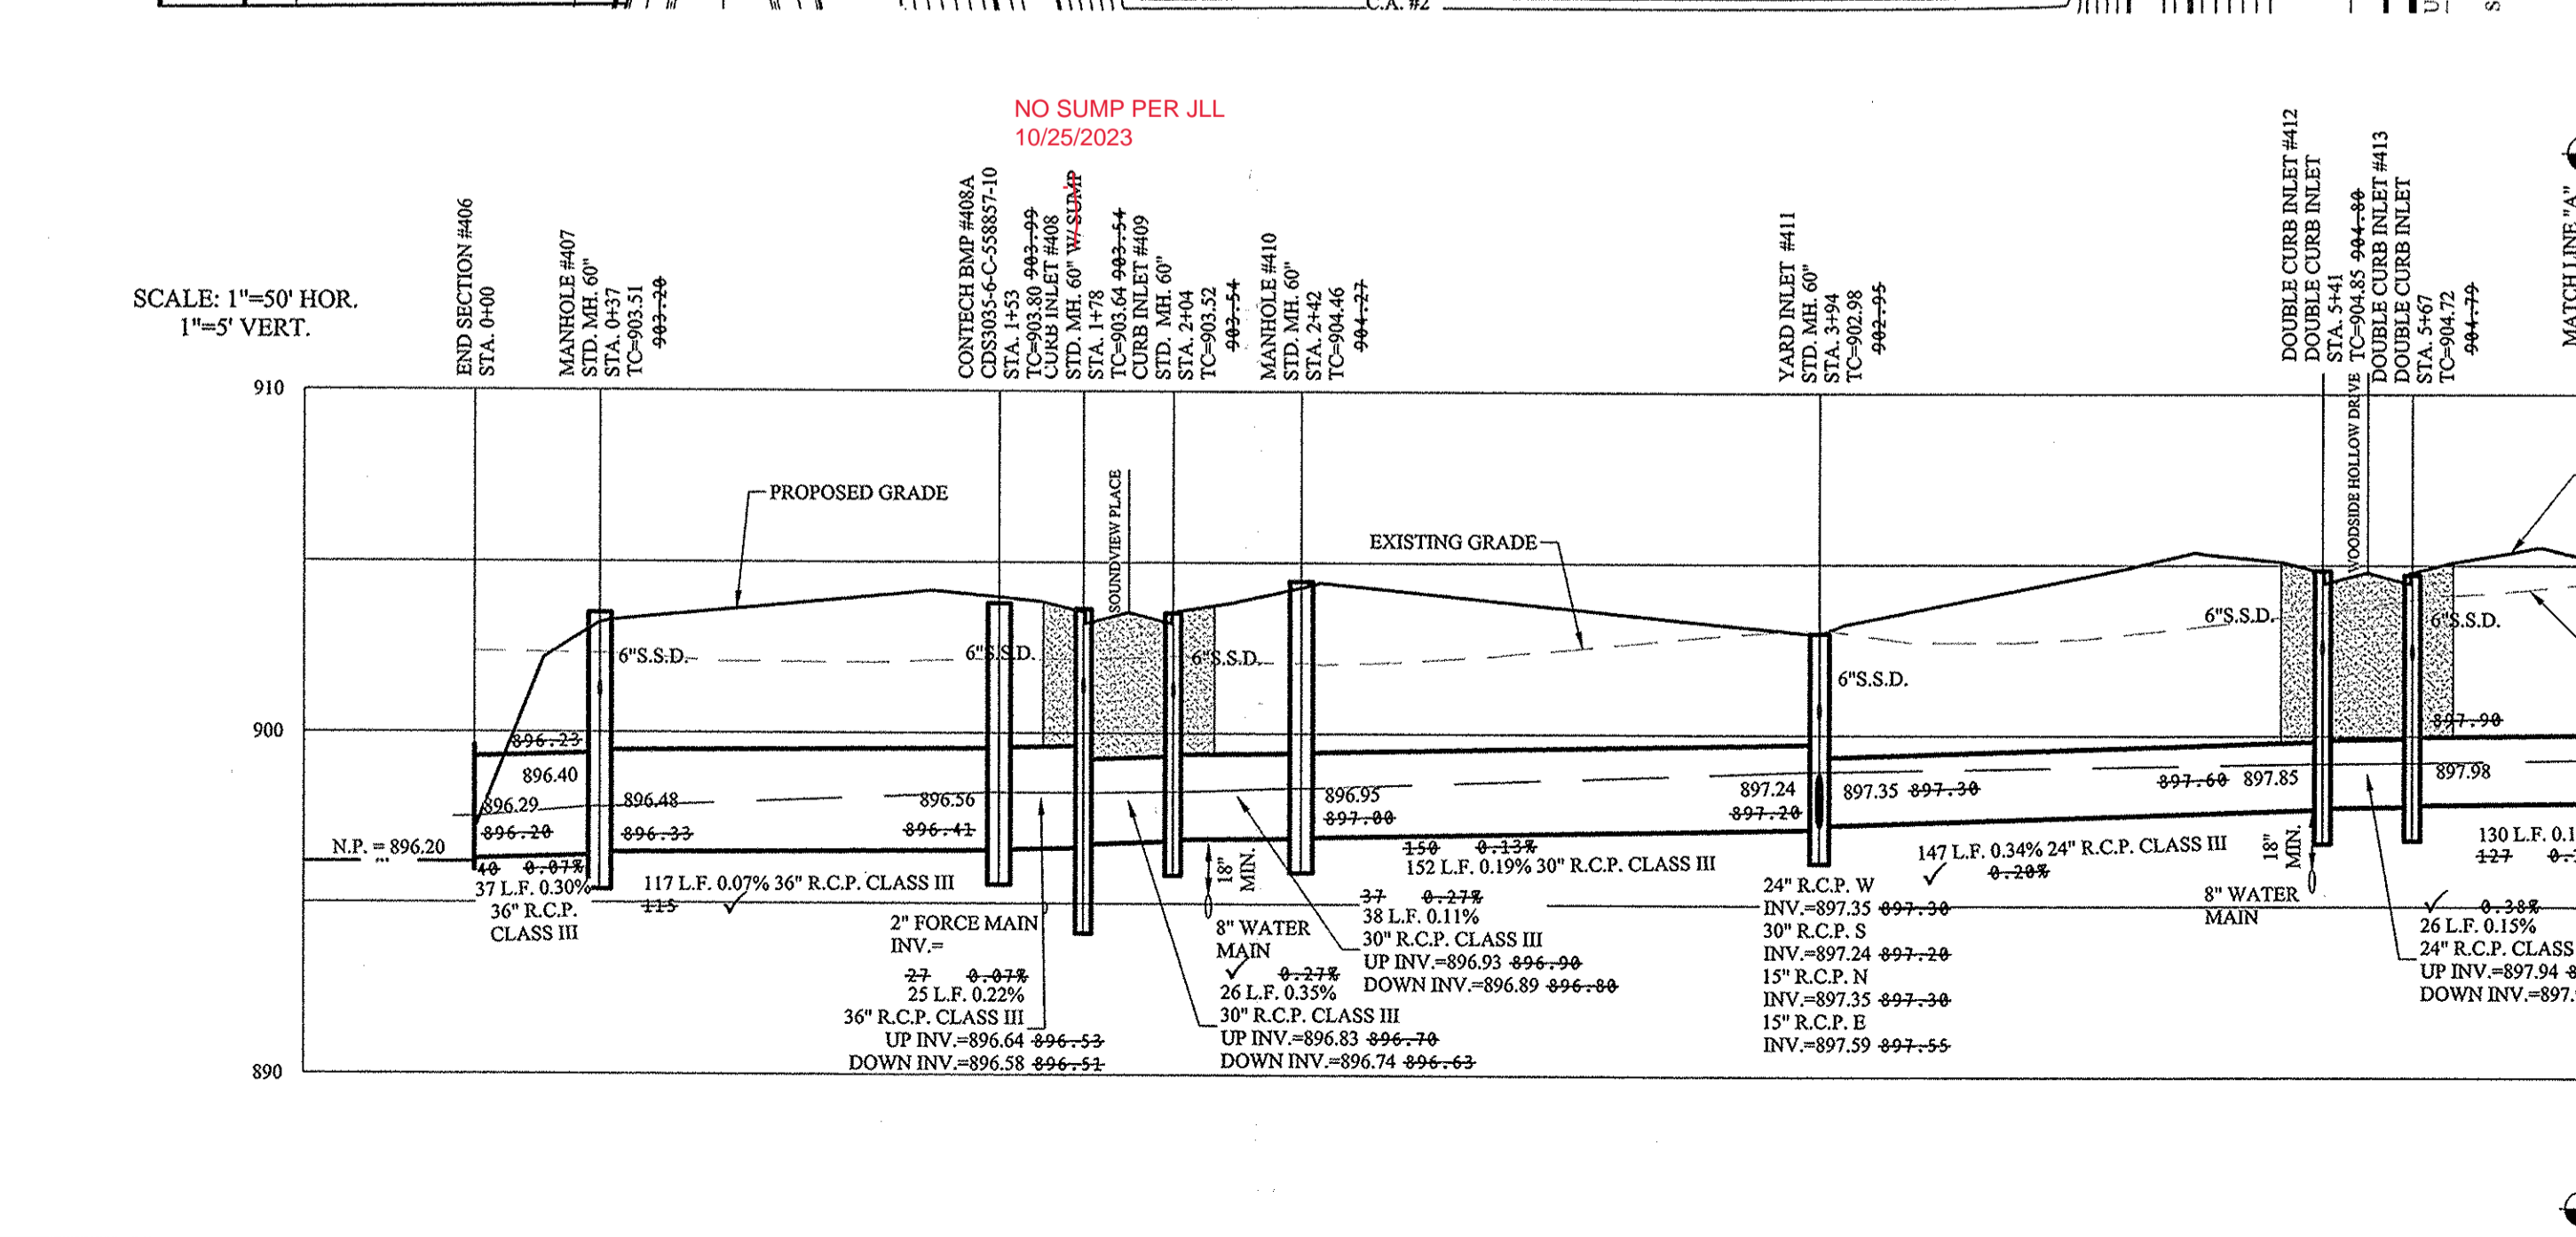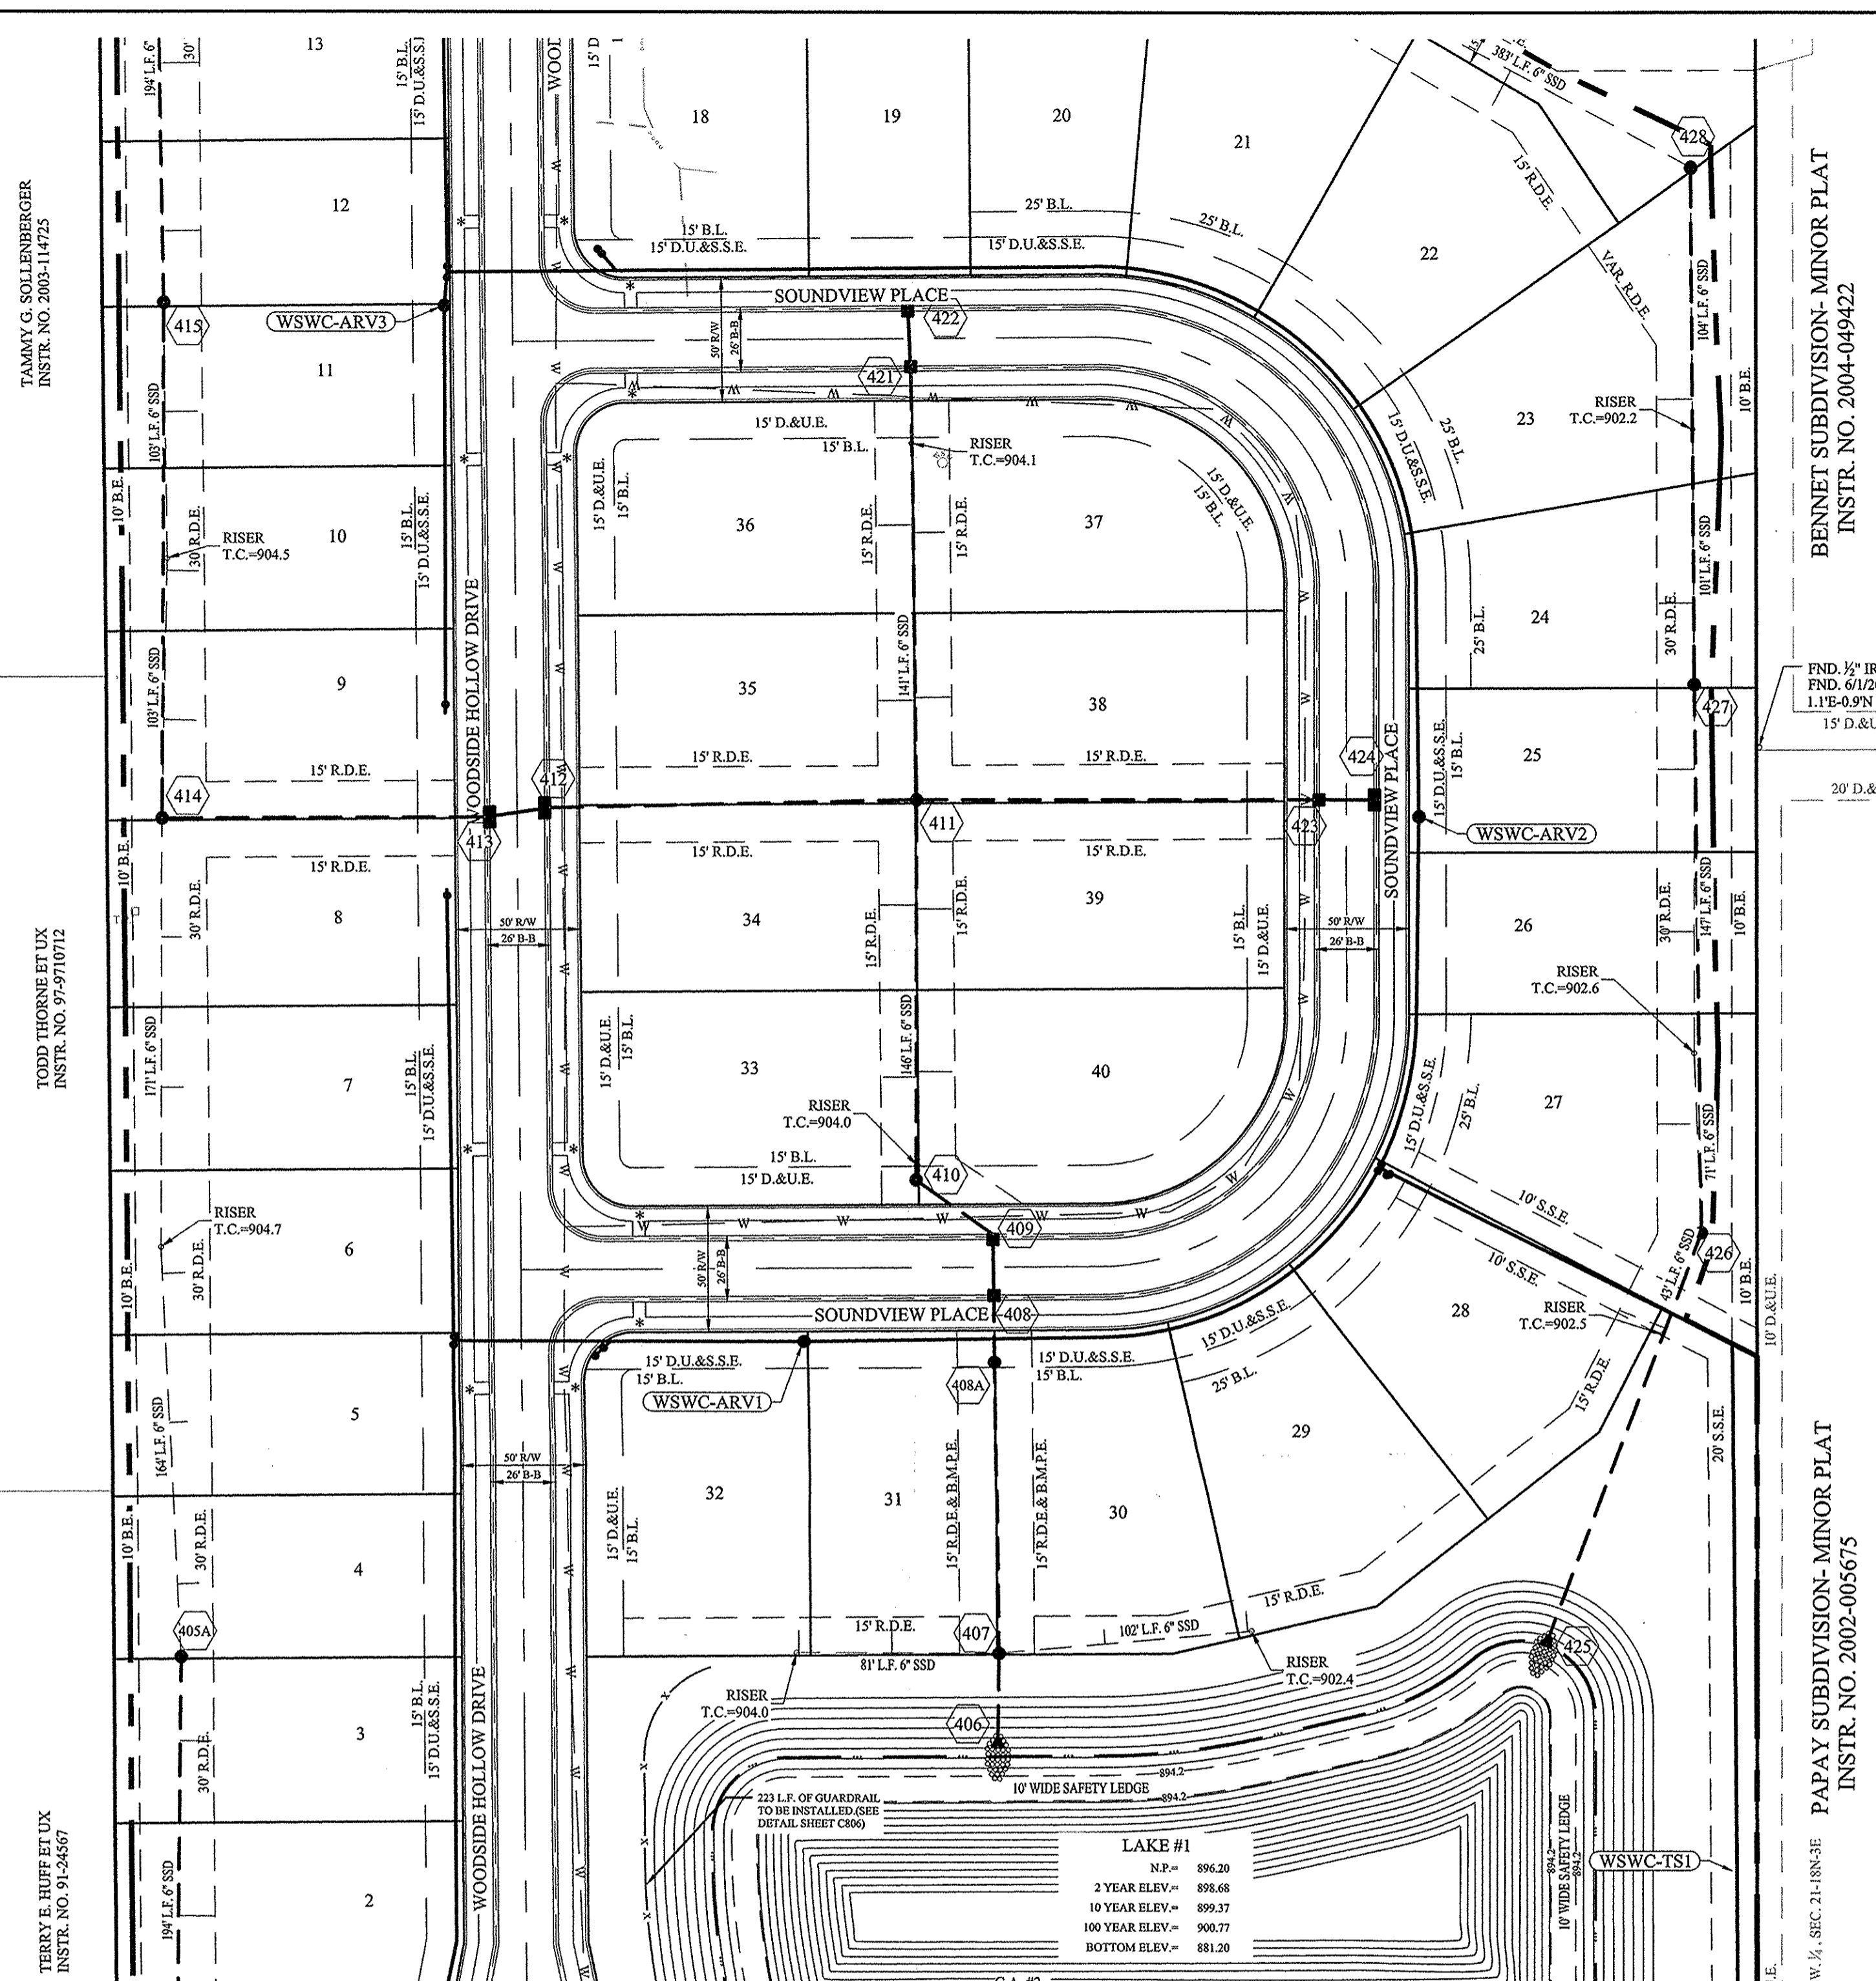


# RECORD DRAWING

Dennis D. Olmstead  
 Registered Land Surveyor  
 No. 900012  
 State of Indiana  
 12/6/2017

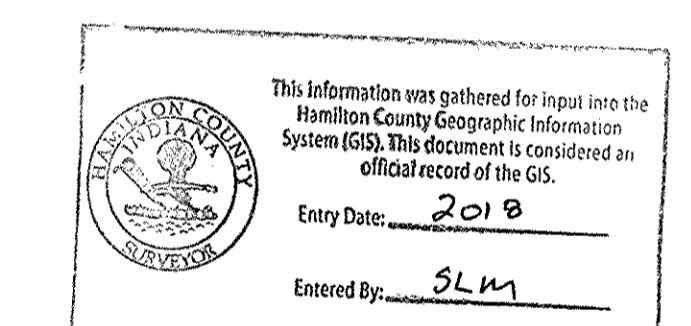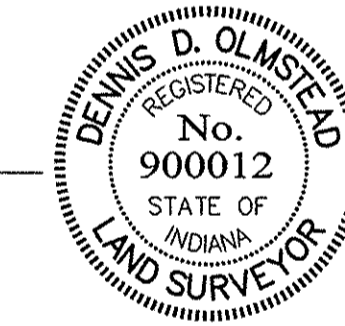

SCALE: 1"=50' HOR.  
 1"=5' VERT.

BENCHMARK:  
 HCBR-5  
 HAMILTON COUNTY CONTROL DISK  
 AT THE NORTH END OF THE EAST  
 HEADWALL OF DITCH ROAD OVER  
 HENLEY CREEK.

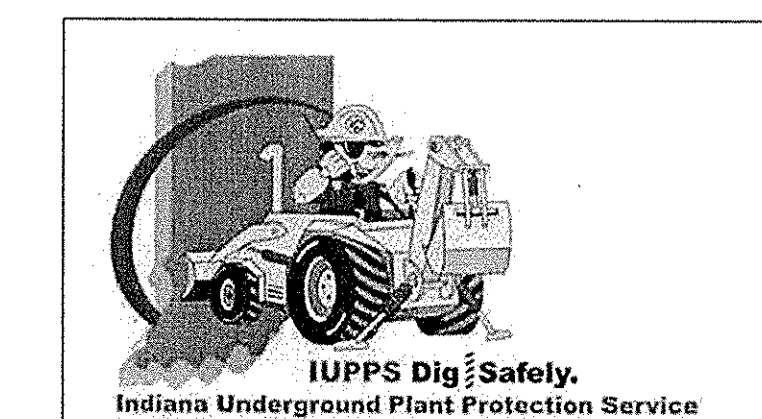

**811**  
 Know what's below.  
 Call before you dig.

- NOTES:
- ALL STORM STRUCTURES TO RECEIVE SOLID LID CASTINGS ARE TO BE CONSTRUCTED TO PROVIDE ONE 4" RISER RING NO MORE, NO LESS TO ACHIEVE PLAN RIM GRADE.
  - ALL YARD INLETS ARE TO BE CONSTRUCTED AT A TOLERANCE OF +0.00' TO -0.20' OF PLAN GRADE.
  - ALL STORM SEWER CASTINGS SHALL BE LABELED "DUMP NO WASTE-DRAINS TO WATERWAY"
  - ALL SSD'S (SUBSURFACE DRAINS) WILL NEED TO BE DOUBLE WALL SMOOTH BORE PERFORATED (HDPE) PIPE.
  - DEBRIS GUARDS ARE TO BE INSTALLED ON ALL OPEN ENDED INLETS.
  - FOR STORM STRUCTURE SIZING AND CASTING TABLE SEE DETAIL D-18 ON SHEET C802.
  - ALL STORM SEWERS WITHIN PUBLIC RIGHT-OF-WAY SHALL BE RCP CLASS III.
  - FOR INSTALLATION OF STORM UNDER CITY STREETS AND COVER REQUIREMENTS, SEE SHEET No. C802 ON THE TRENCH DETAIL.
  - ALL TOP OF CASTING ELEVATIONS FOR STORM SEWERS SHALL BE CONSTRUCTED WITH A TOLERANCE OF 0.10 FT ±

**STORM SEWER NOTE**


THE STORM SEWER SYSTEM SHALL BE CONSTRUCTED PER DESIGN SPECIFIED AND AS APPROVED BY THE CITY OF CARMEL ON THE FINAL APPROVED CONSTRUCTION PLANS. DESIGN SPECIFIED AND AS APPROVED BY THE CITY OF CARMEL ON THE FINAL APPROVED CONSTRUCTION PLANS. DEVIATIONS FROM THE APPROVED DESIGN SHALL ONLY BE PERMITTED DUE TO SPECIAL CIRCUMSTANCES OR DIFFICULTY DURING CONSTRUCTION AND WILL REQUIRE PRIOR FIELD APPROVAL FROM A DESIGNATED REPRESENTATIVE OF THE CITY OF CARMEL IN ADDITION TO SUPPLEMENTAL APPROVAL BY THE DESIGN ENGINEER. AN EXPLANATION OF ANY SUCH DEVIATION SHALL BE INCLUDED AS A REQUIREMENT ON AS-BUILT/RECORD DRAWINGS SUBMITTED FOR RELEASE OF PERFORMANCE GUARANTEES. APPROVED DESIGN SLOPES IDENTIFIED AS GENERATING VELOCITIES OF 2.5 FPS OR LESS AND 10 FPS OR GREATER (AT FULL FLOW CAPACITY) SHALL REQUIRE AS-BUILT CERTIFICATION AT THE TIME OF CONSTRUCTION, PRIOR TO BACKFILLING THE PIPE. THE CONTRACTOR IS INSTRUCTED TO AS-BUILT EACH SECTION OF STORM PIPE AS IT IS BEING INSTALLED TO ENSURE COMPLIANCE WITH THE DESIGN PLANS. AND AS APPROVED BY THE CITY OF CARMEL.

**STORM SYSTEM**  
 WITH THE EXCEPTION OF REAR YARD SSDS, STORM SEWERS FOR THIS DEVELOPMENT WILL BE PUBLIC.

MINIMUM COVER FOR PIPE: THE MINIMUM COVER FROM THE TOP OF THE INSTALLED PAVEMENT TO THE TOP OF THE INSTALLED PIPE SHALL BE THE PAVEMENT SECTION, THICKNESS (ALL BITUMINOUS AND AGGREGATE MATERIAL ABOVE THE SUBGRADE) PLUS 1'-0", BUT UNDER NO CIRCUMSTANCES SHALL THE COVER ALONG ANY PART OF THE PIPE FROM THE FINAL PAVEMENT OR FINAL GROUND SURFACE ELEVATION TO THE TOP OF THE PIPE BE LESS THAN 2.5 FEET.

CONTRACTOR SHALL VERIFY DEPTHS OF ALL EXISTING ONSITE UTILITIES PRIOR TO CONSTRUCTION TO CONFIRM THERE IS NOT ANY CONFLICTS WITH OTHER UTILITIES, STORM SEWERS OR STREETS. CONFLICTS AFTER CONSTRUCTION BEGINS ARE SOLELY THE CONTRACTOR'S RESPONSIBILITY.

DENOTES FULL DEPTH GRANULAR BACKFILL SEE RCP TRENCH DETAIL SHEET C802

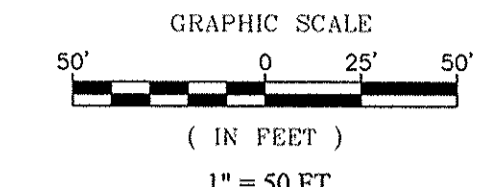

FILE NAME: S:\66252PIT\_SUD\WC600\_Storm Plan & Profile.dwg - C601  
 PLOTTED BY: Christian Esteposio  
 PLOTTED DATE: 2017 12:05:59 PM  
 PLOTTED BY: Christian Esteposio  
 PLOTTED DATE: 2017 2:05:32 PM

STORM PLAN & PROFILES  
**WOODSIDE AT WEST CLAY**  
 HAMILTON COUNTY, INDIANA  
 CARMEL



DRAWN BY: KRG  
 CHECKED BY: BKR  
 SHEET NO: C601  
 56325PIT-S1

REGISTERED PROFESSIONAL ENGINEER  
 No. 19358  
 STATE OF INDIANA  
 David J. Stoeppelwerth  
 CERTIFIED: 03/17/17

THIS DRAWING IS NOT INTENDED TO BE REPRESENTED AS A REFERENCE OR ORIGINAL BOUNDARY SURVEY, A ROUTE SURVEY OR A SURVEYOR LOCATION REPORT.

DATE: 12/6/2017  
 REVISIONS: BY: CCE, KRG, DCM, DCM



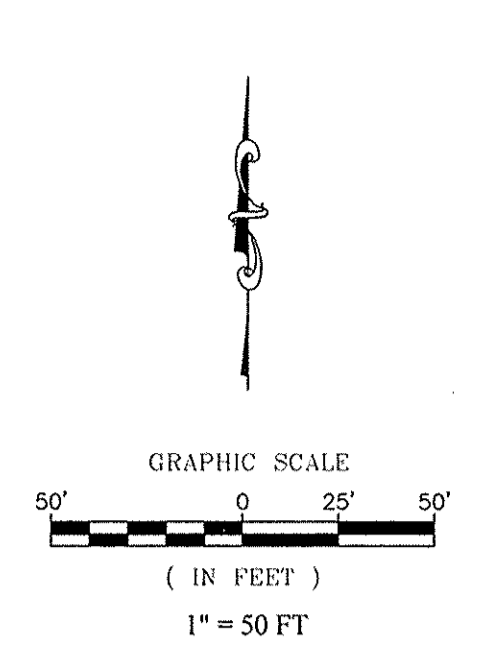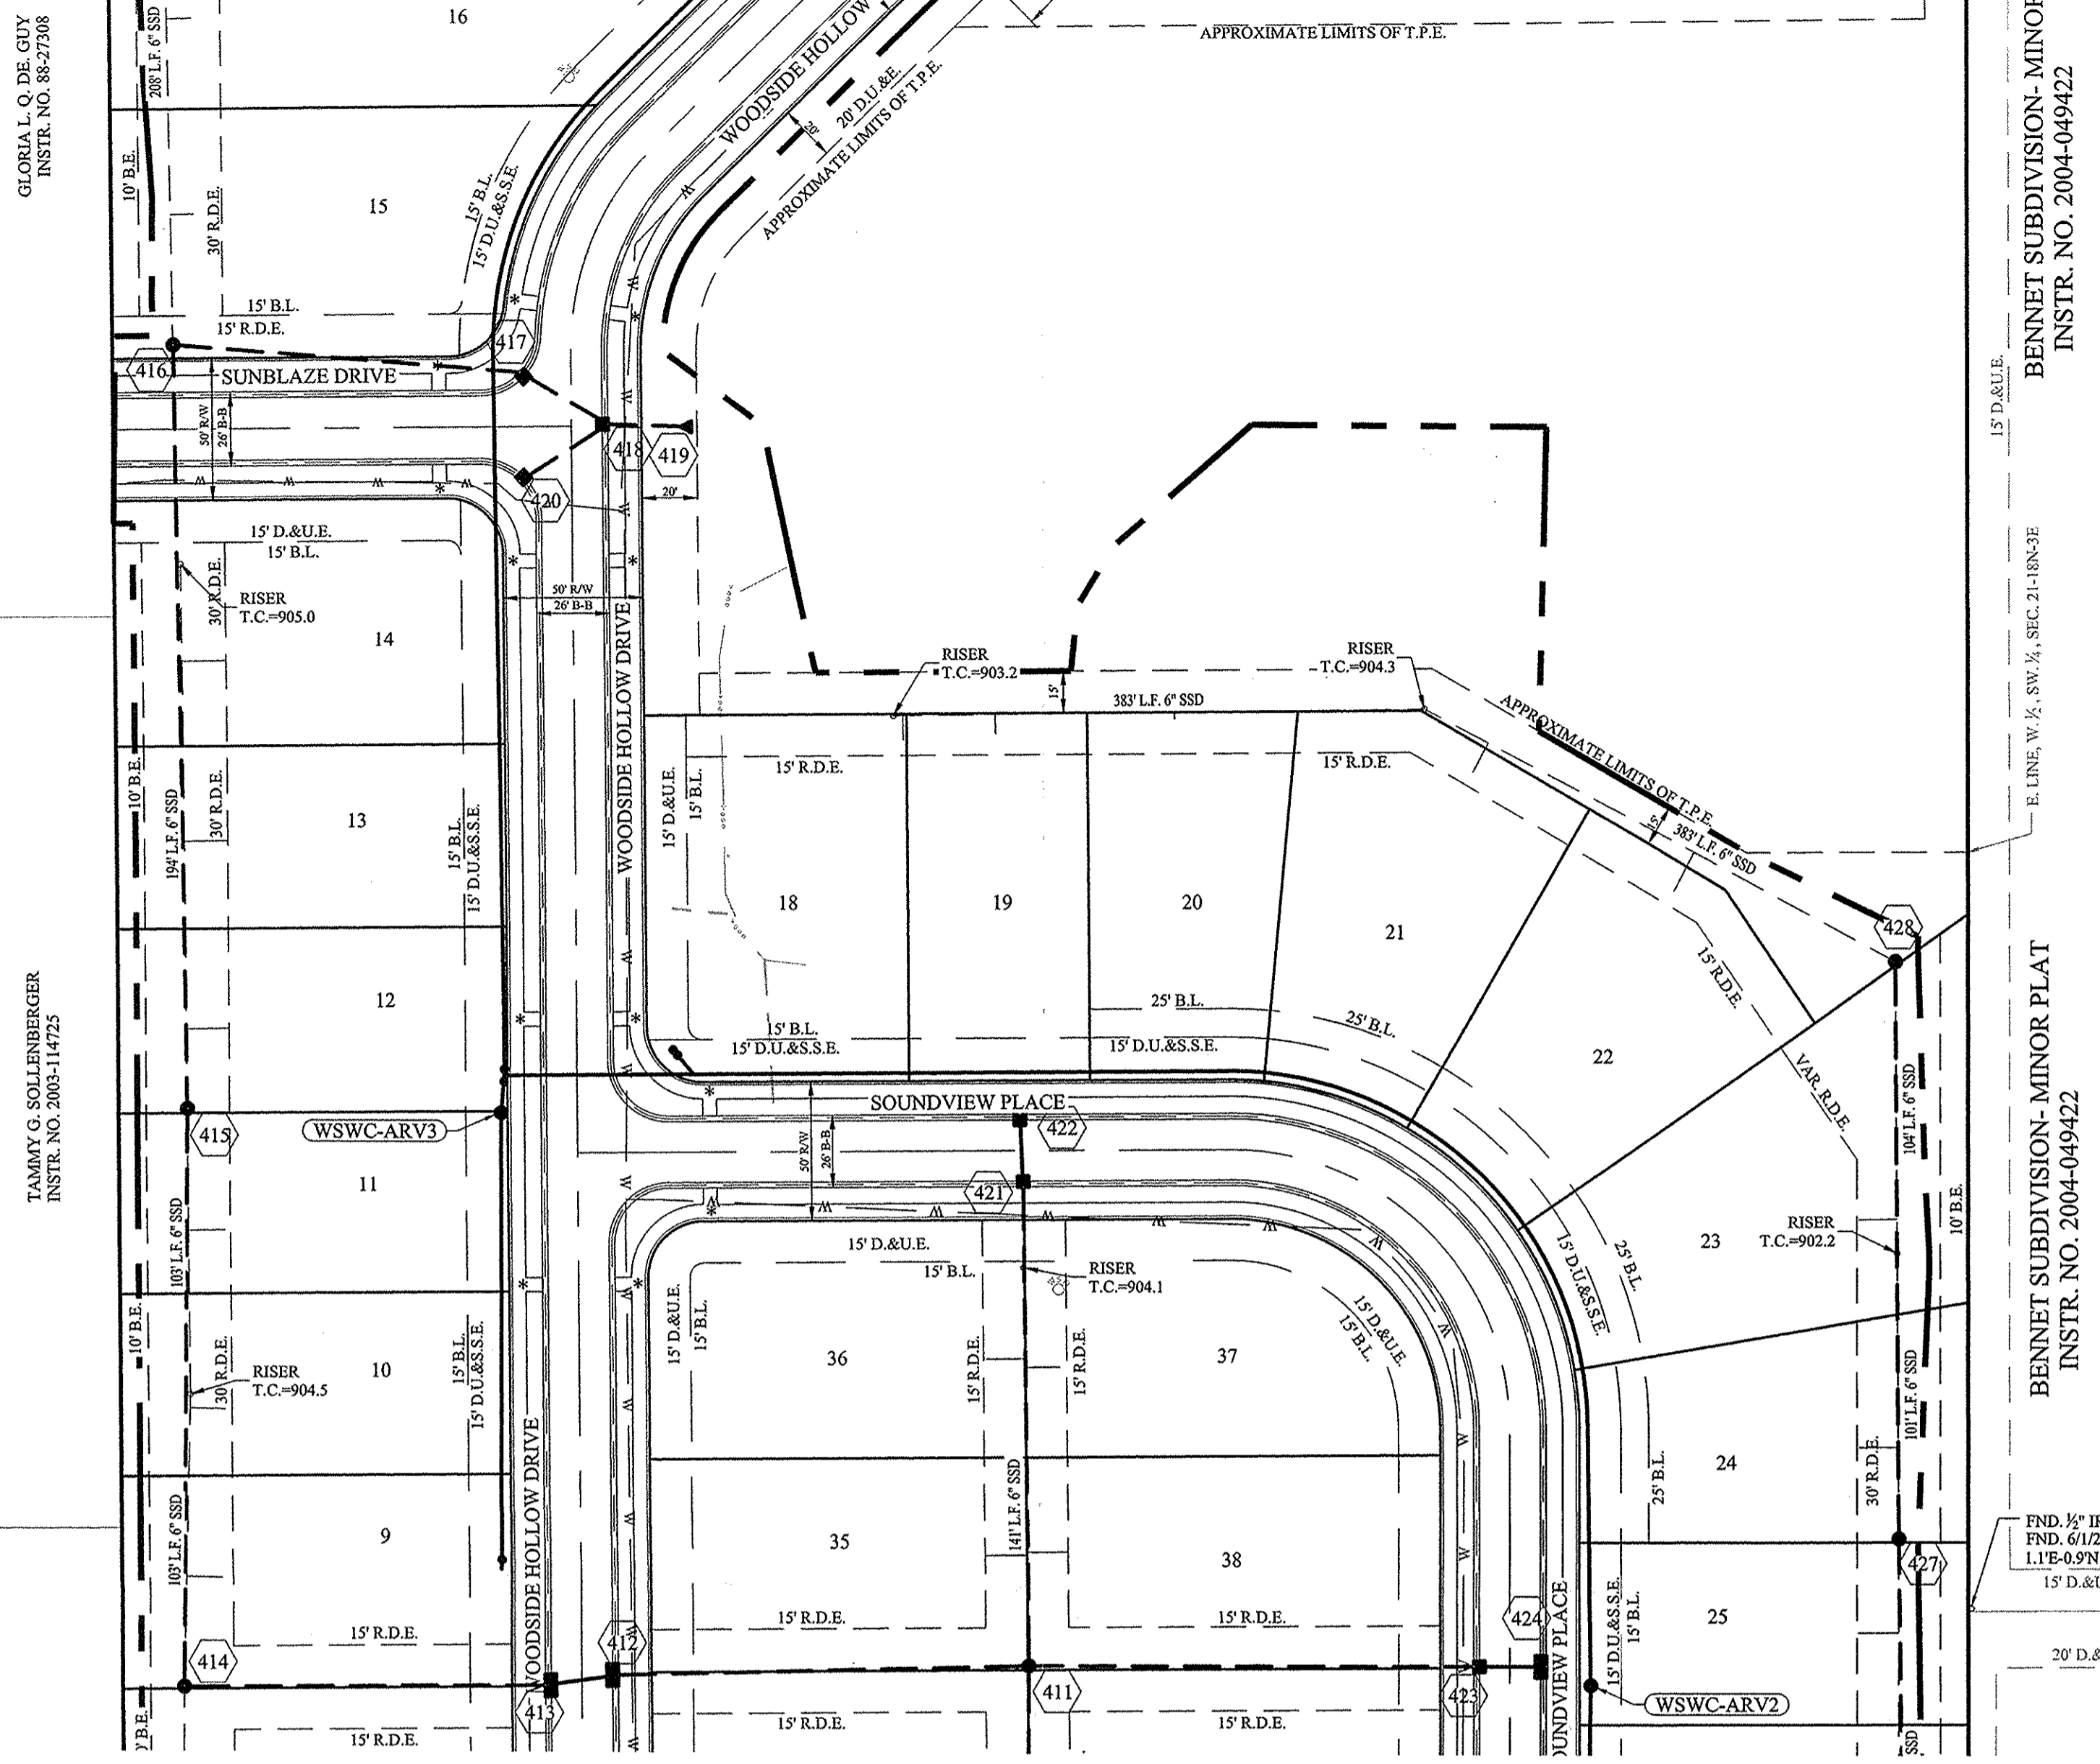


**STORM SYSTEM**  
 WITH THE EXCEPTION OF REAR YARD SSDs, STORM SEWERS FOR THIS DEVELOPMENT WILL BE PUBLIC.


MINIMUM COVER FOR PIPE: THE MINIMUM COVER FROM THE TOP OF THE INSTALLED PAVEMENT TO THE TOP OF THE INSTALLED PIPE SHALL BE THE PAVEMENT SECTION, THICKNESS (ALL BITUMINOUS AND AGGREGATE MATERIAL ABOVE THE SUBGRADE) PLUS 1'-0", BUT UNDER NO CIRCUMSTANCES SHALL THE COVER ALONG ANY PART OF THE PIPE FROM THE FINAL PAVEMENT OR FINAL GROUND SURFACE ELEVATION TO THE TOP OF THE PIPE BE LESS THAN 2.5 FEET.

CONTRACTOR SHALL VERIFY DEPTHS OF ALL EXISTING ON-SITE UTILITIES PRIOR TO CONSTRUCTION TO CONFIRM THERE IS NOT ANY CONFLICTS WITH OTHER UTILITIES, STORM SEWERS OR STREETS. CONFLICTS AFTER CONSTRUCTION BEGINS ARE SOLELY THE CONTRACTOR'S RESPONSIBILITY.

■ DENOTES FULL DEPTH GRANULAR BACKFILL SEE RCP TRENCH DETAIL SHEET C802



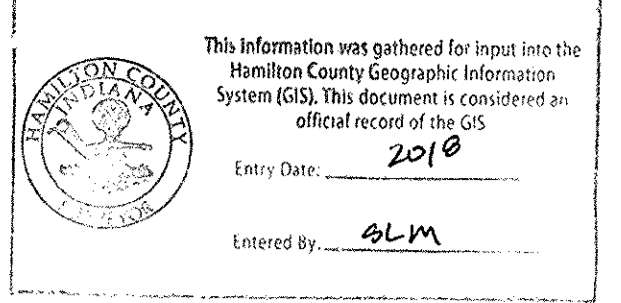


- NOTES:
- ALL STORM STRUCTURES TO RECEIVE SOLID LID CASTINGS ARE TO BE CONSTRUCTED TO PROVIDE ONE 4" RISER RING NO MORE, NO LESS TO ACHIEVE PLAN RIM GRADE.
  - ALL YARD INLETS ARE TO BE CONSTRUCTED AT A TOLERANCE OF +0.00' TO -0.20' OF PLAN GRADE.
  - ALL STORM SEWER CASTINGS SHALL BE LABELED "DUMP NO WASTE-DRAINS TO WATERWAY"
  - ALL SSD'S (SUBSURFACE DRAINS) WILL NEED TO BE DOUBLE WALL SMOOTH BORE PERFORATED (HDPE) PIPE.
  - DEBRIS GUARDS ARE TO BE INSTALLED ON ALL OPEN ENDED INLETS.
  - FOR STORM STRUCTURE SIZING AND CASTING TABLE SEE DETAIL D-18 ON SHEET C802.
  - ALL STORM SEWERS WITHIN PUBLIC RIGHT-OF-WAY SHALL BE RCP CLASS III.
  - FOR INSTALLATION OF STORM UNDER CITY STREETS AND COVER REQUIREMENTS, SEE SHEET No. C802 ON THE TRENCH DETAIL.
  - ALL TOP OF CASTING ELEVATIONS FOR STORM SEWERS SHALL BE CONSTRUCTED WITH A TOLERANCE OF 0.10 FT.±

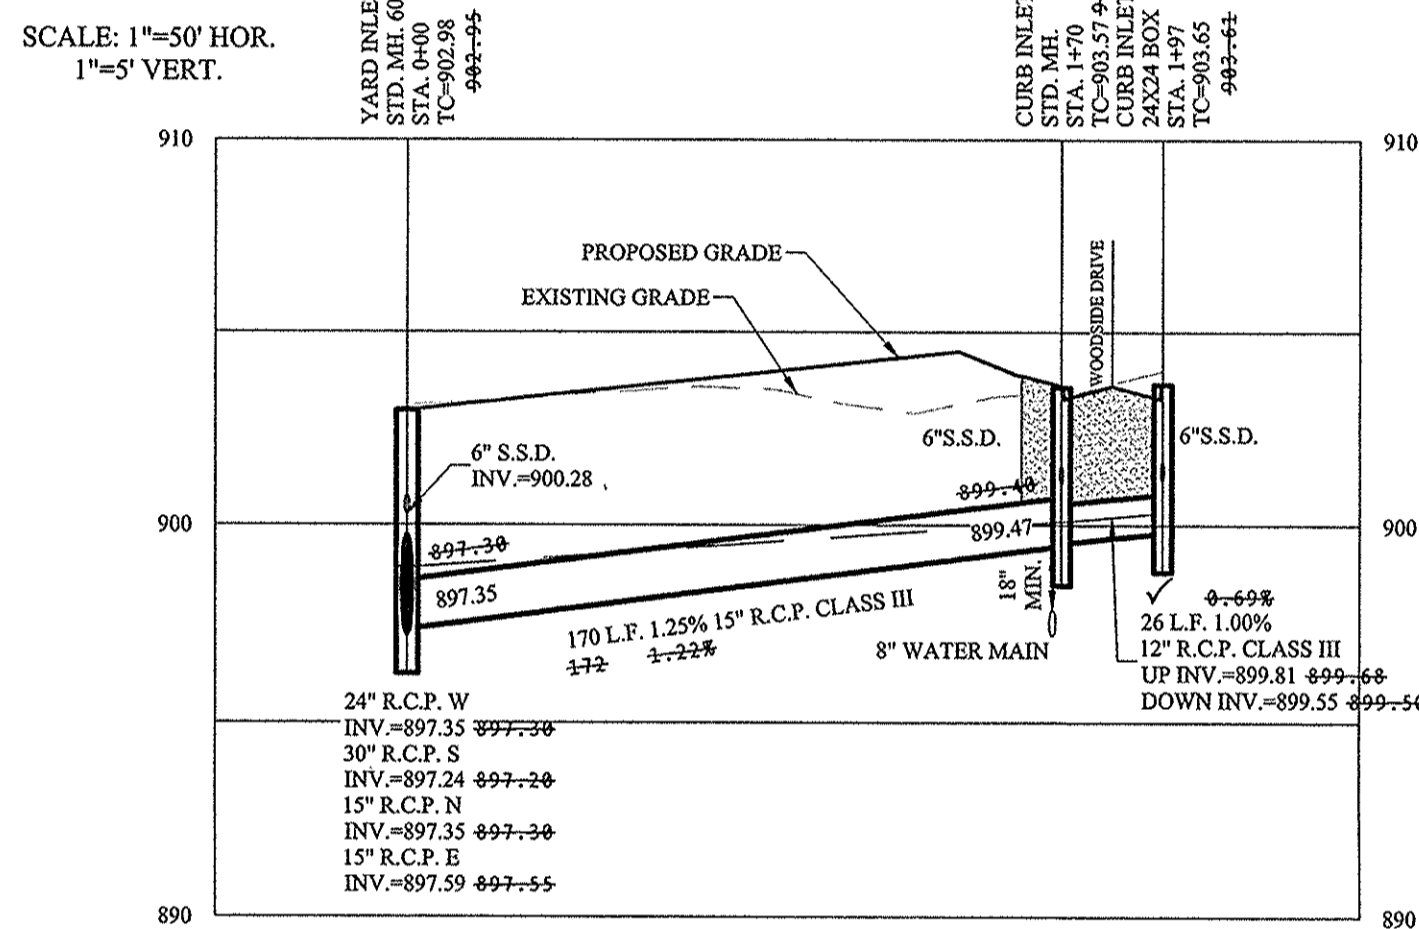

**STORM SEWER NOTE**

THE STORM SEWER SYSTEM SHALL BE CONSTRUCTED PER DESIGN SPECIFIED AND AS APPROVED BY THE CITY OF CARMEL ON THE FINAL APPROVED CONSTRUCTION PLANS. DESIGN SPECIFIED AND AS APPROVED BY THE CITY OF CARMEL ON THE FINAL APPROVED CONSTRUCTION PLANS. DEVIATIONS FROM THE APPROVED DESIGN SHALL ONLY BE PERMITTED DUE TO SPECIAL CIRCUMSTANCES OR DIFFICULTY DURING CONSTRUCTION AND WILL REQUIRE PRIOR FIELD APPROVAL FROM A DESIGNATED REPRESENTATIVE OF THE CITY OR CARMEL IN ADDITION TO SUPPLEMENTAL APPROVAL BY THE DESIGN ENGINEER. AN EXPLANATION OF ANY SUCH DEVIATION SHALL BE INCLUDED AS A REQUIREMENT ON AS-BUILT/RECORD DRAWINGS SUBMITTED FOR RELEASE OF PERFORMANCE GUARANTEES. APPROVED DESIGN SLOPES IDENTIFIED AS GENERATING VELOCITIES OF 2.5 FPS OR LESS AND 10 FPS OR GREATER (AT FULL FLOW CAPACITY) SHALL REQUIRE AS-BUILT CERTIFICATION AT THE TIME OF CONSTRUCTION, PRIOR TO BACKFILLING THE PIPE. THE CONTRACTOR IS INSTRUCTED TO AS-BUILT EACH SECTION OF STORM PIPE AS IT IS BEING INSTALLED TO ENSURE COMPLIANCE WITH THE DESIGN PLANS. AND AS APPROVED BY THE CITY OF CARMEL.

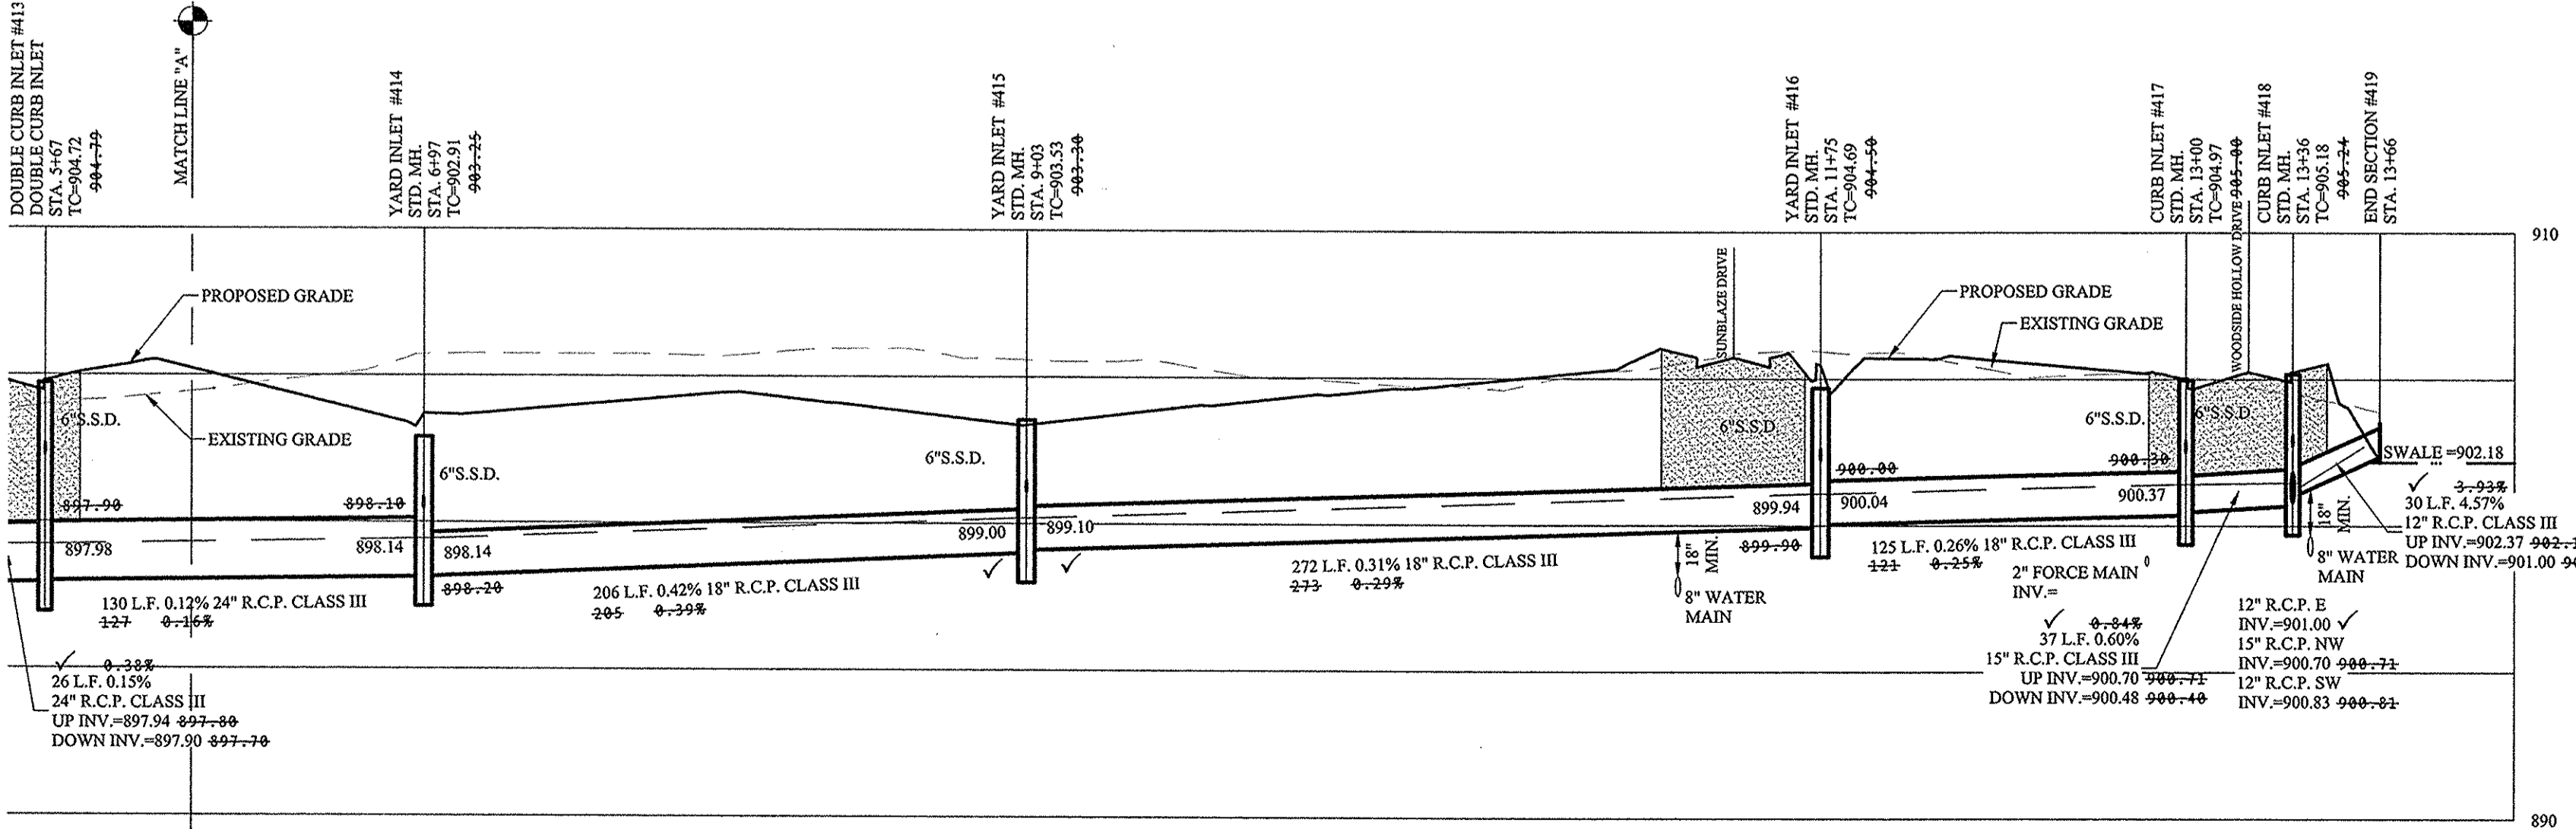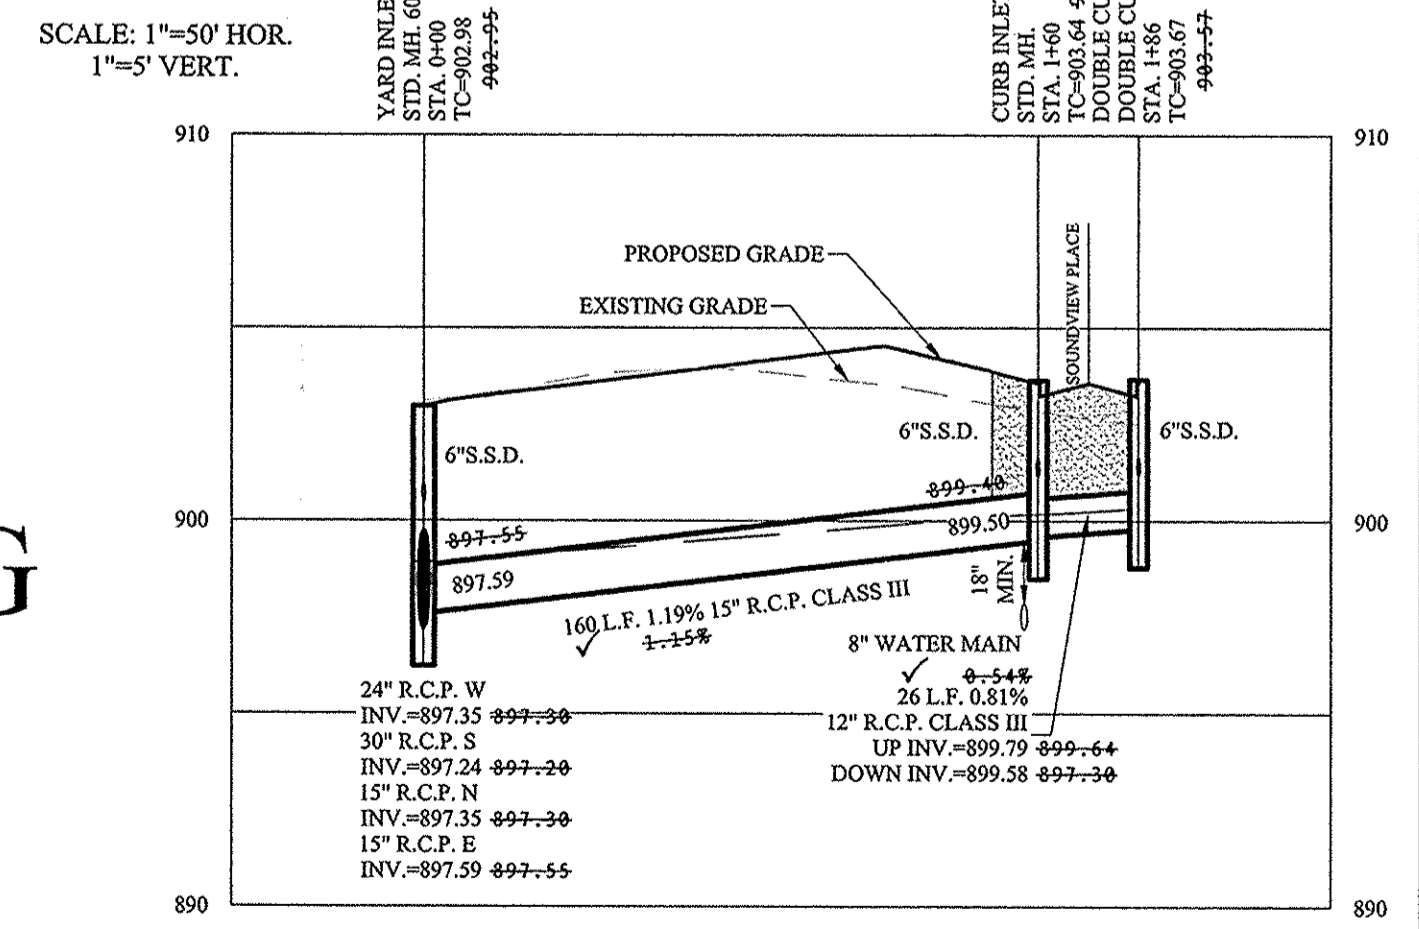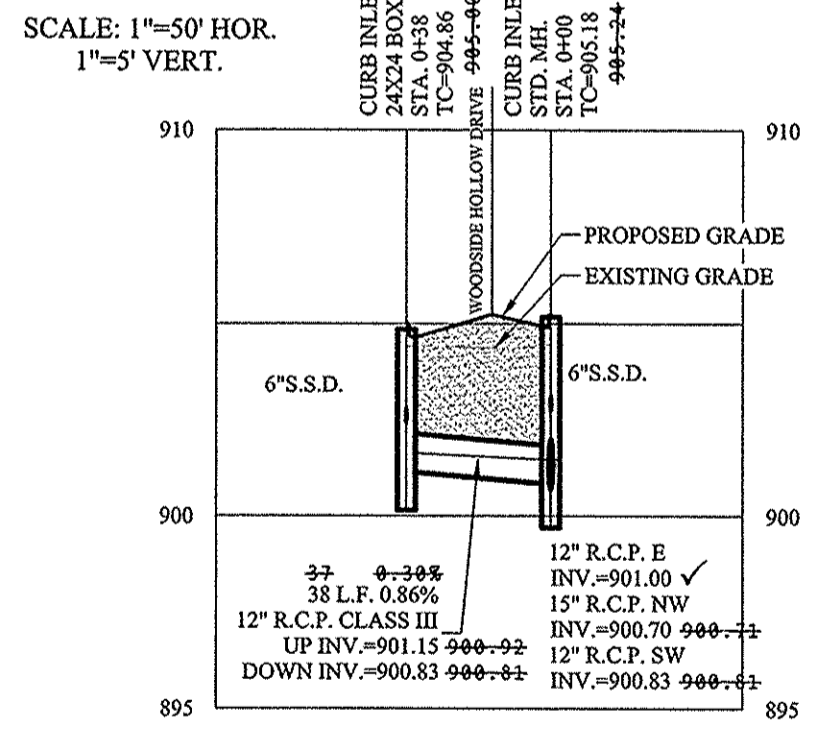


# RECORD DRAWING

*D.D.*  
 Dennis D. Olmstead  
 Registered Land Surveyor  
 No. 900012



BENCHMARK:  
 HCBR-5  
 HAMILTON COUNTY CONTROL DISK  
 AT THE NORTH END OF THE EAST  
 HEADWALL OF DITCH ROAD OVER  
 HENLEY CREEK.

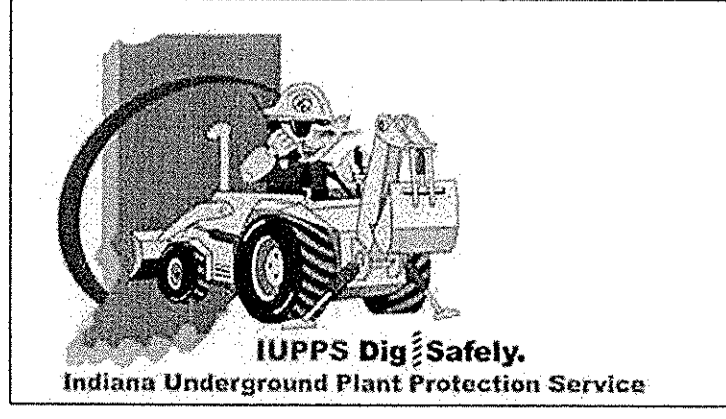

**811**  
 Know what's below.  
 Call before you dig.

**STOEPPELWERTH**  
 ALWAYS ON  
 7945 East 108th Street, Fishers, IN 46038-2505  
 phone: 317.849.5925 fax: 317.849.5942

HAMILTON COUNTY, INDIANA

STORM PLAN & PROFILES  
 WOODSIDE AT WEST CLAY

CARMEL

DATE	MARK	REVISIONS	BY
02/06/17		REVISED PER COMMENTS	KRG
06/20/17		REVISED PER COMMENTS	BKR
08/01/17		REVISED PER TAC COMMENTS	

THIS DRAWING IS NOT INTENDED TO BE REPRESENTED AS A RETACEMENT OR SUPPLEMENT TO ANY SURVEY, A ROUTE SURVEY OR A SURVEY FOR LOCATION REPORT.

CERTIFIED: 03/17/17  
*David J. Steppelwirth*

NO. 19358  
 STATE OF INDIANA  
 PROFESSIONAL ENGINEER

DRAWN BY: KRG  
 CHECKED BY: BKR

SHEET NO. **C602**  
 S & A JOB NO. 56325PIT-S1

S:\66325PIT-S1\DWG\C602-Storm Plan & Profile.dwg - C602  
 December 6, 2017 12:00:56 PM / cesposito  
 December 6, 2017 2:05:52 PM / Christian Esposito



BY	DATE	REVISIONS
CCE		AS BUILTS
KRG	02/09/17	REVISED PER COMMENTS
DCM	06/20/17	REVISED PER CTWDD COMMENTS
DCM	02/01/17	REVISED PER TAC COMMENTS
BY		

THIS DRAWING IS NOT INTENDED TO BE REPRESENTED AS A RETACEMENT OR SURVEY OR A SURVEYOR LOCATION REPORT.

CERTIFIED: 03/17/17

David J. Steppelwerth

REGISTERED PROFESSIONAL ENGINEER  
No. 19358  
STATE OF INDIANA

**STOEPPELWERTH**  
REGISTERED PROFESSIONAL ENGINEER  
No. 19358  
STATE OF INDIANA


7805 East 100th Street, Fishers, IN 46038-2905  
Phone: 317.878.9285 Fax: 317.886.5942

**811**  
Know what's below.  
Call before you dig.

INDIANA UNDERGROUND PLANT PROTECTION SERVICE

INDIANA UNDERGROUND PLANT PROTECTION SERVICE

6 A JOB NO. 56325PIT-S1

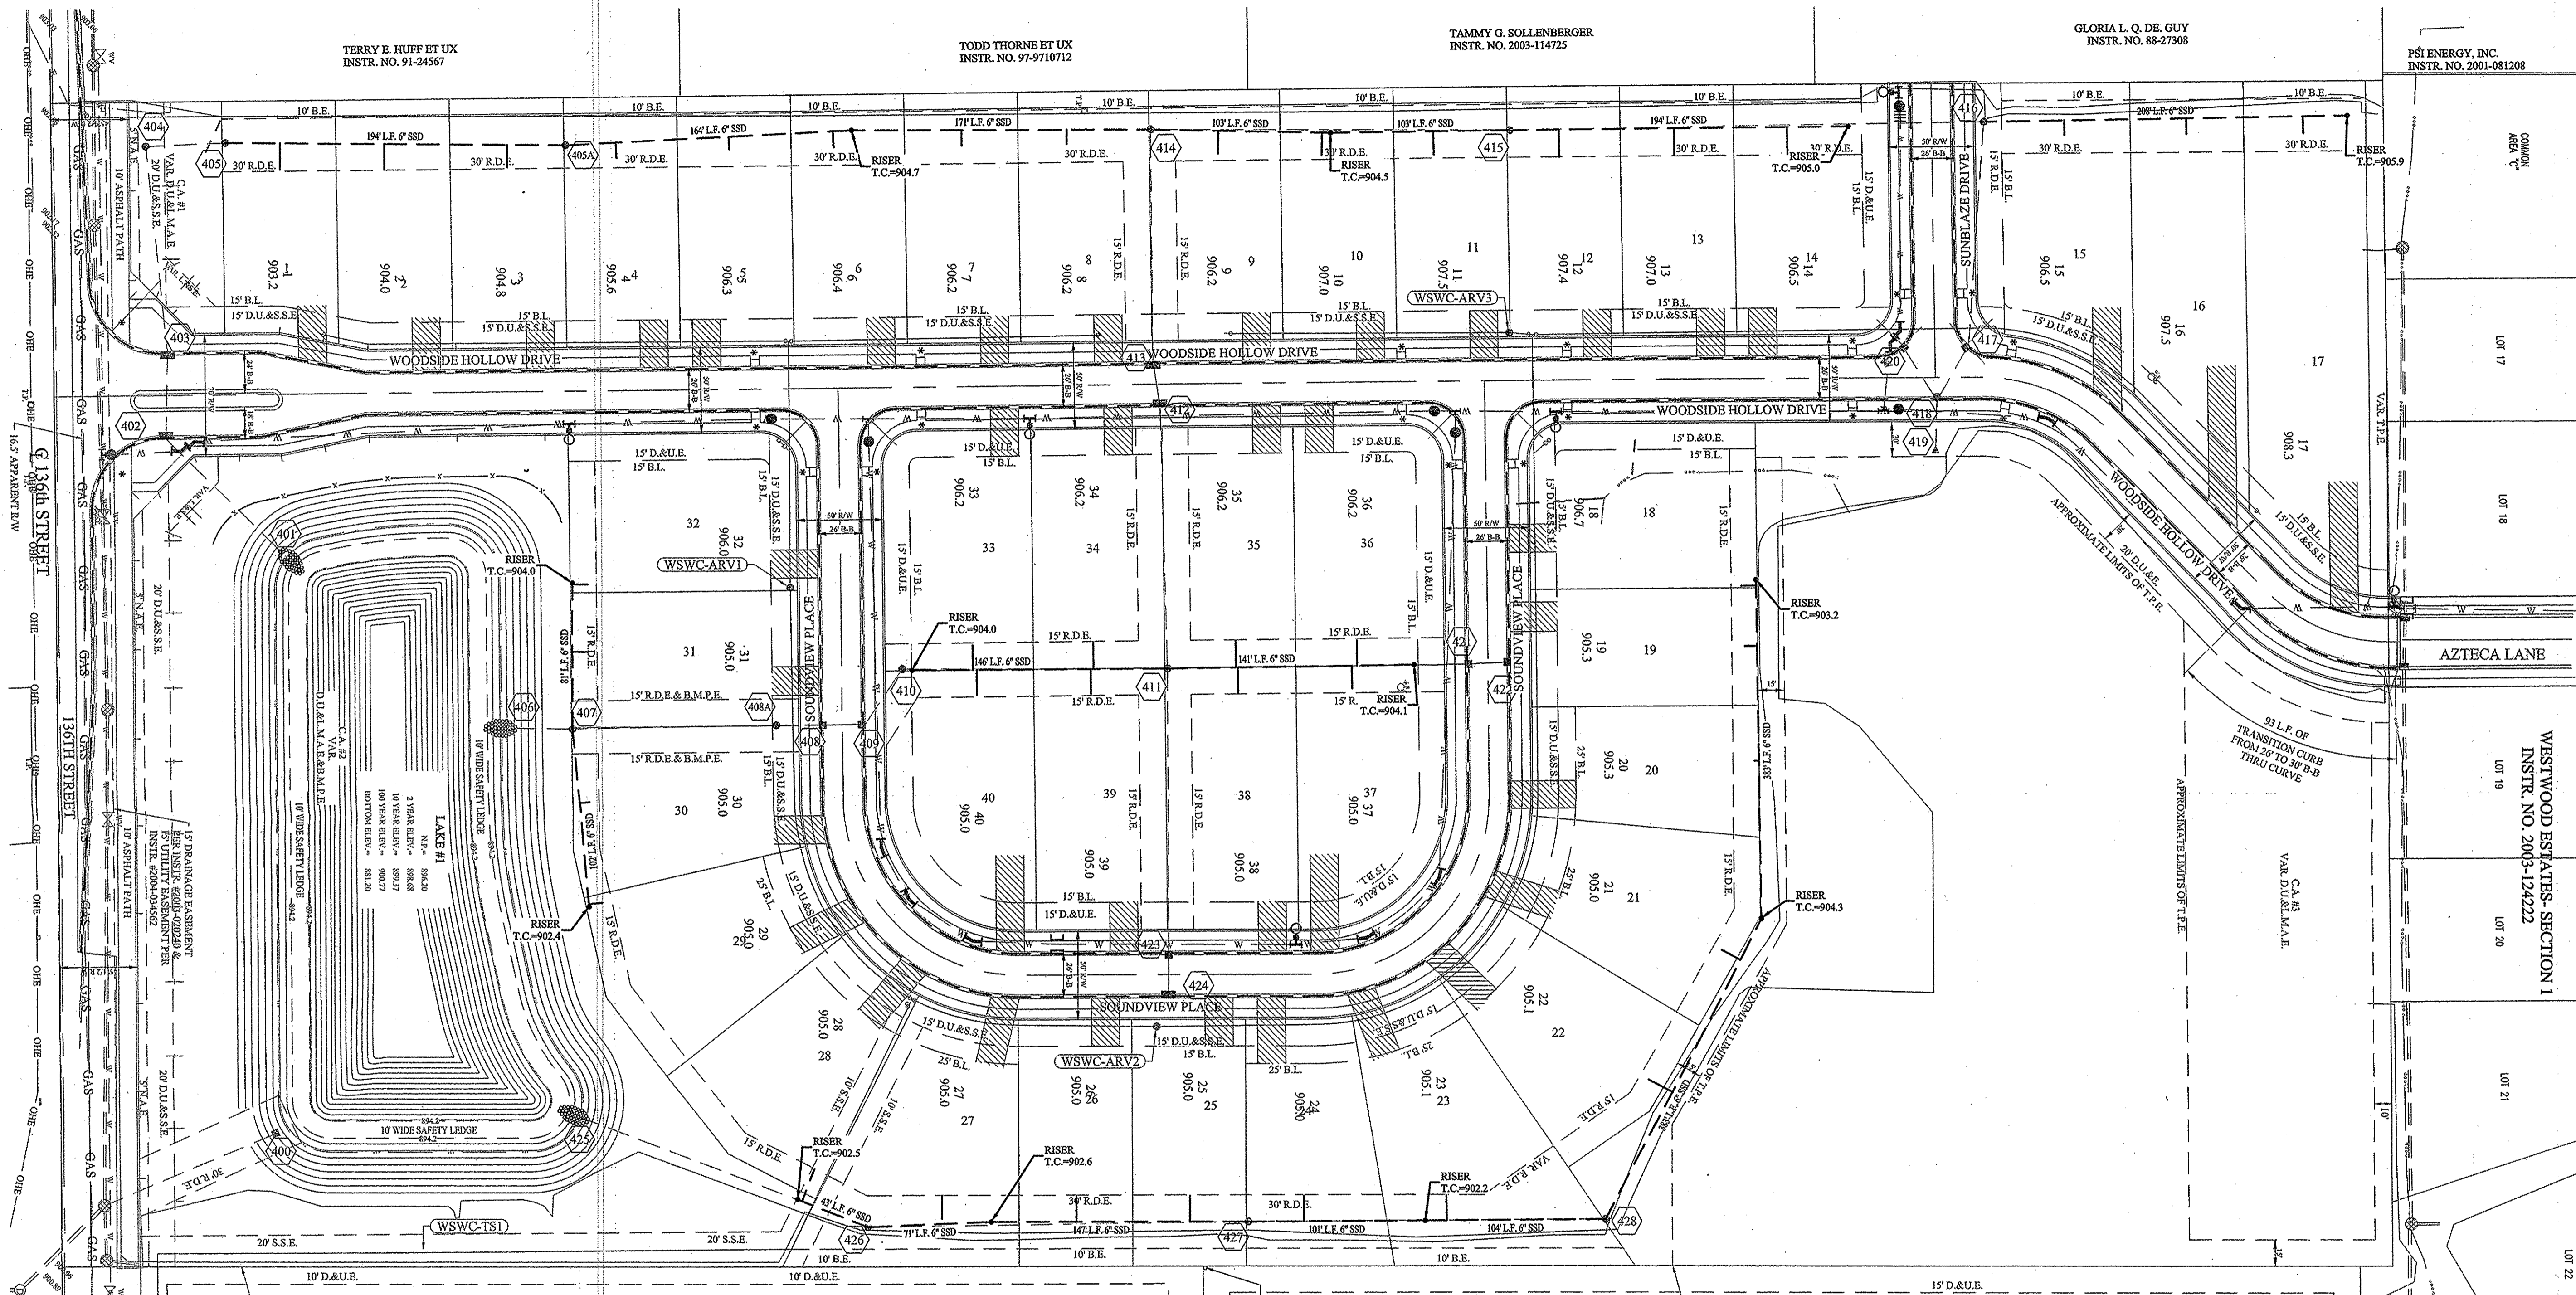

File Name: S:\6325PIT-S1\DWG\C603-Sub-Surface Drain Sump Plan.dwg - C603  
Modified by: December 6, 2017 2:18:32 PM / csesposito  
Plotted by: December 6, 2017 2:18:39 PM / Christian Estposito


This copy printed from Digital Archive of the Hamilton County Surveyor's Office, One Hamilton Co. Square, Ste., Noblesville, IN 46060

**RECORD DRAWING**

Dennis D. Olmstead  
Registered Land Surveyor  
No. 900012



This information was gathered for input into the Hamilton County Geographic Information System (GIS). This document is considered an official record of the GIS.  
Entry Date: 2018  
Entered By: SLM

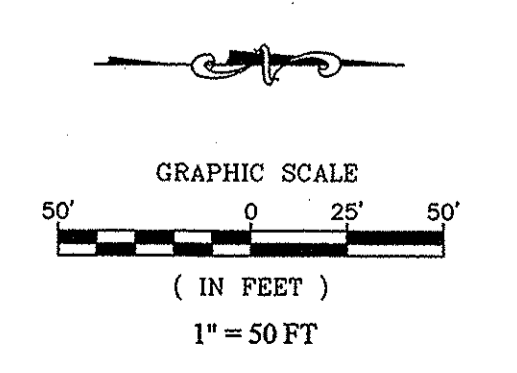

SUB-SURFACE DRAIN/ SUMP CONNECTION PLAN  
WOODSIDE AT WEST CLAY

DRAWN BY: KRG  
CHECKED BY: BKR  
SHEET NO. C603