



Kenton C. Ward, CFM
Surveyor of Hamilton County
Phone (317) 776-8495
Fax (317) 776-9628

Suite 188
One Hamilton County Square
Noblesville, Indiana 46060-2230

Map Correction-Field Verification

Drain Number: 218

Drain Length: n/a

Drain Name: Windjammer

Change + / - : n/a

Date: November 1, 2012

New Length: n/a

Verified By: SAB

Notes & Sketch: See attached notes and map. WO-2012-00254

Set a new manhole and enclosed 16 feet of open ditch with 12" CMP and 15" RCP


Suzanne L. Mills
GIS Specialist


W/O 2012-00254 WINDJAMMER
 Completed Sept. 21, 2012 by Agricon.

Curb inlet Sull of Sediment.
 12" CMP Sull of Sediment.
 15" RCP under Fall Creek blocked w/rip rap

12" CMP EXTENDED 13' and CONNECTED to Str
 4' DIA Manhole Str. SET.

15" RCP EXTENDED 3' and CONNECTED to Str
 4342 CASTING PLACED ON Str.

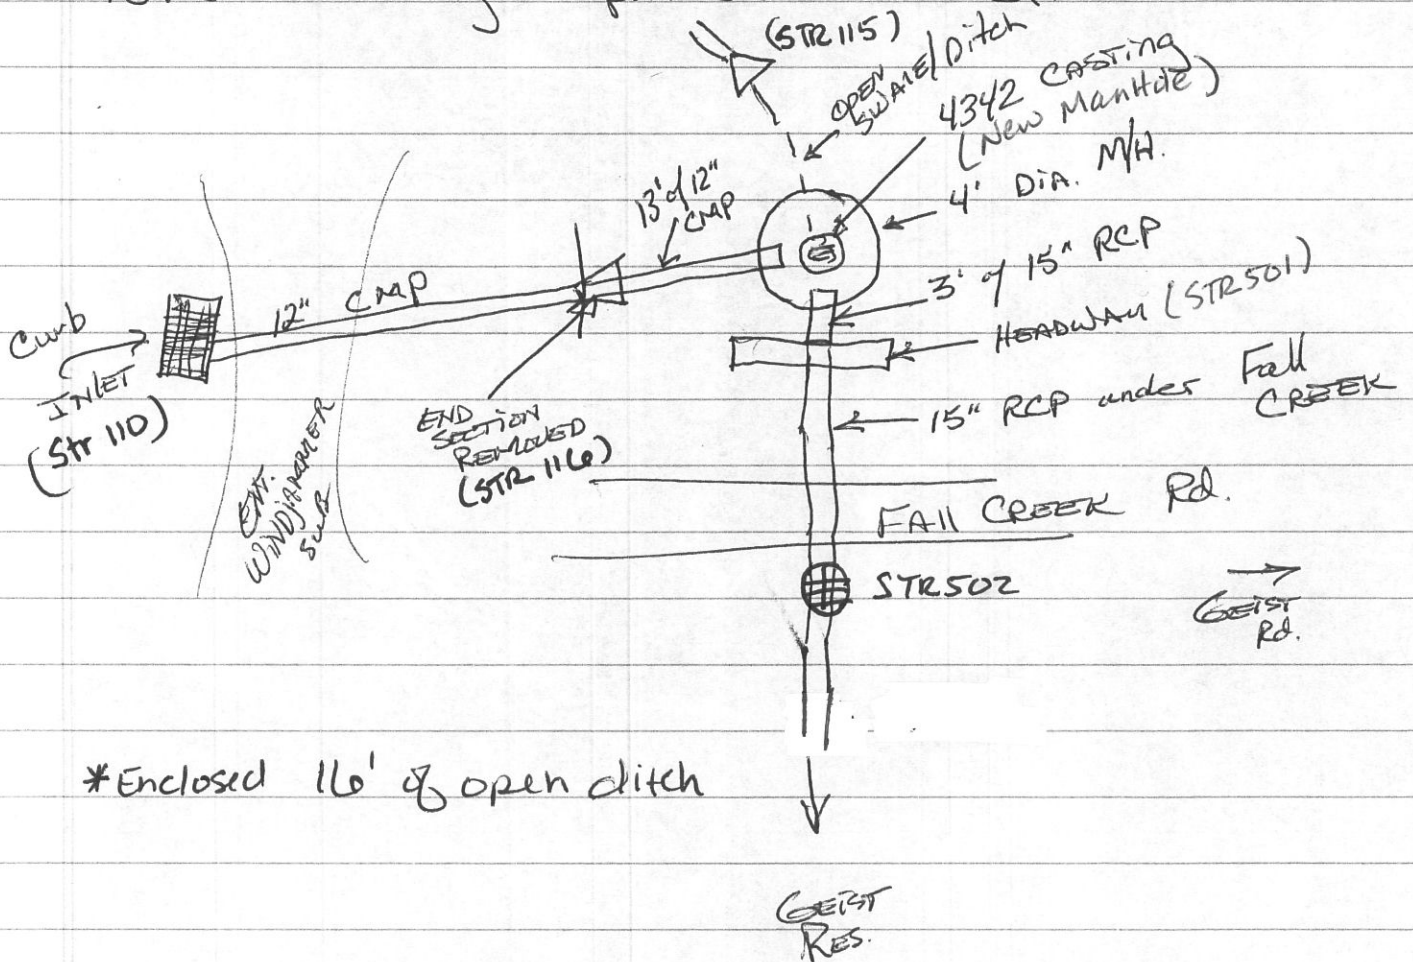

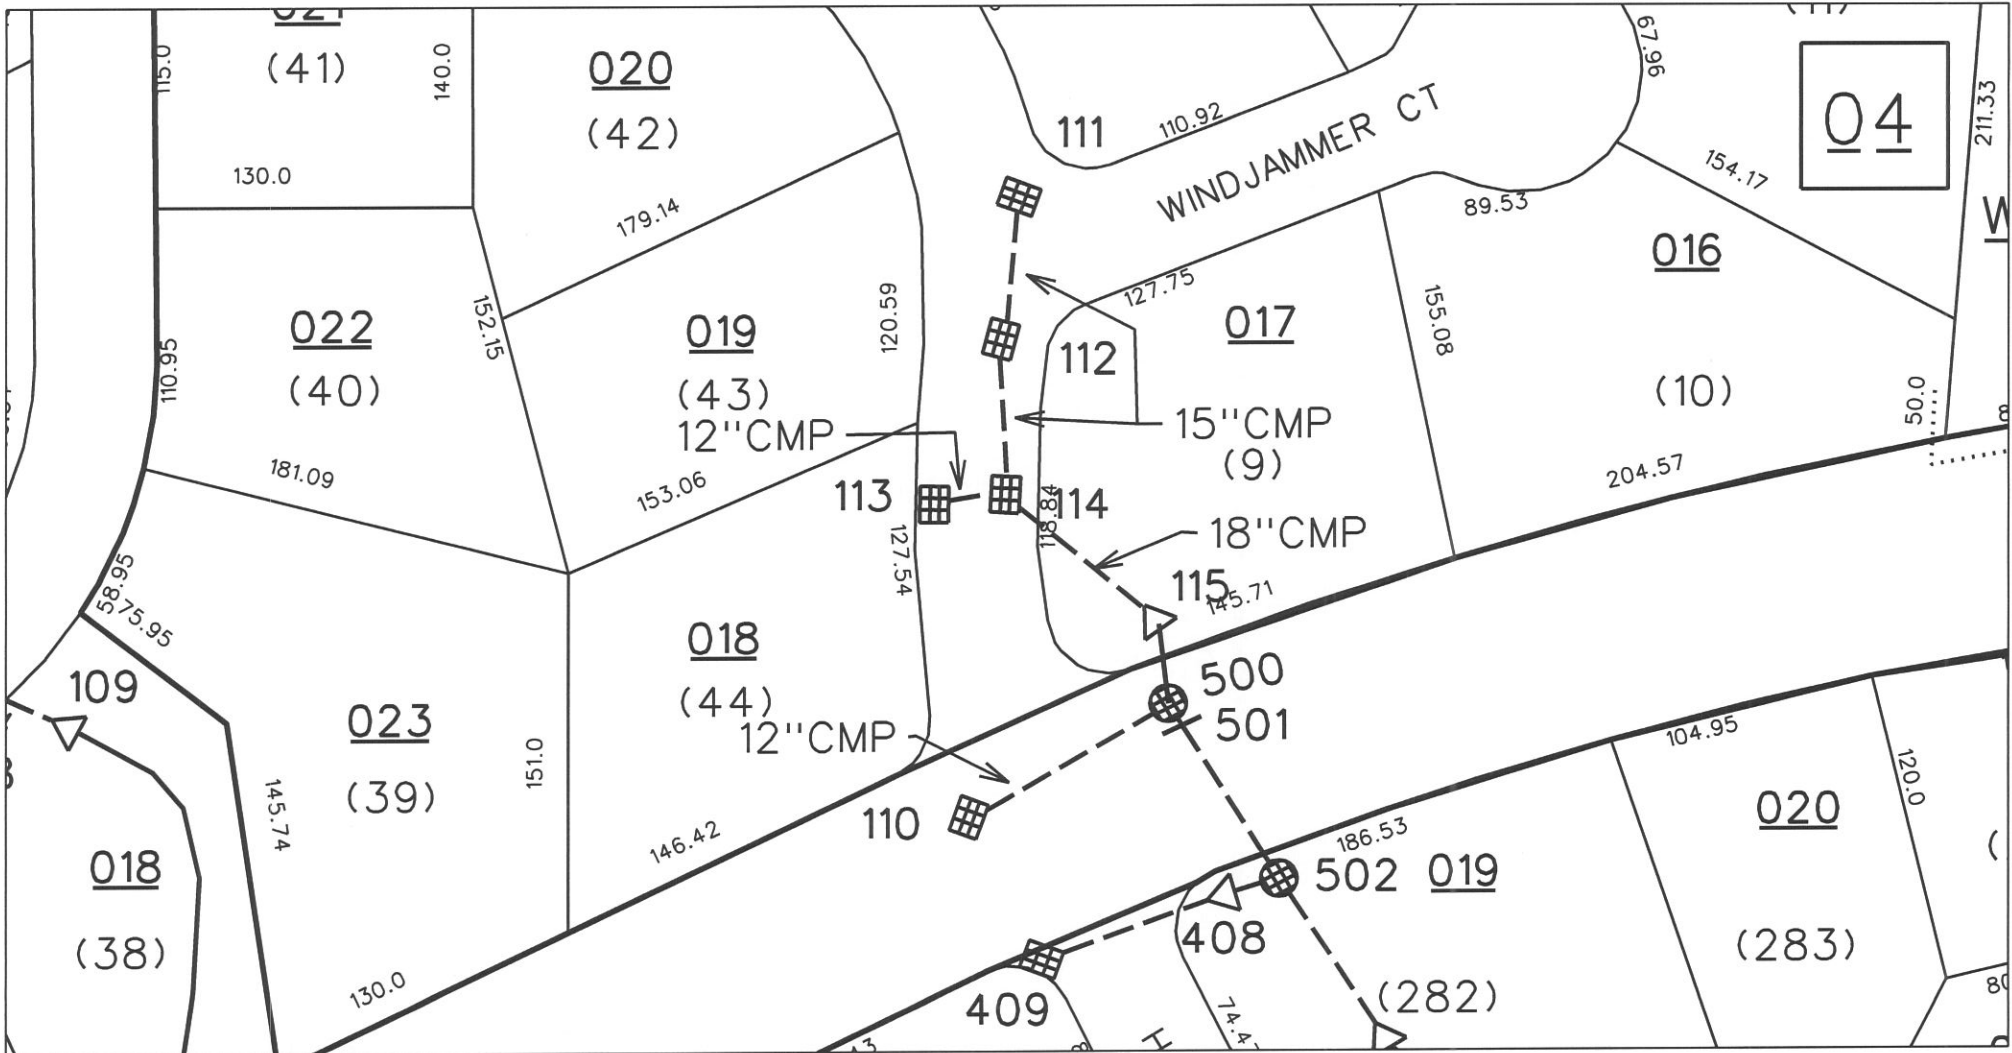

sub_rg_drn.dgn 10/31/2012 2:02:57 PM