



Kenton C. Ward, CFM
Surveyor of Hamilton County
Phone (317) 776-8495
Fax (317) 776-9628

Suite 188
One Hamilton County Square
Noblesville, Indiana 46060-2230

Map Correction-Field Verification

Drain Number: # 116

Drain Length: n/a

Drain Name: Grant Carey Drain

Change + / - : n/a

Date: 11-2-2012

New Length: n/a

Verified By: SAB

Notes & Sketch: See attached notes and map. See WO-2012-00249

Tile under Cornell Rd was replaced with 56 feet of 21" RCP. Existing catch basin and breather were removed and two manholes were set.


Suzanne L. Mills
GIS Specialist

Grant Carey Drain # 116


W/O # 2012-00249 - Elevation Excavation

Work Completed on 10-4-12

Set 2 man-holes & replace under road
with RCP (21")

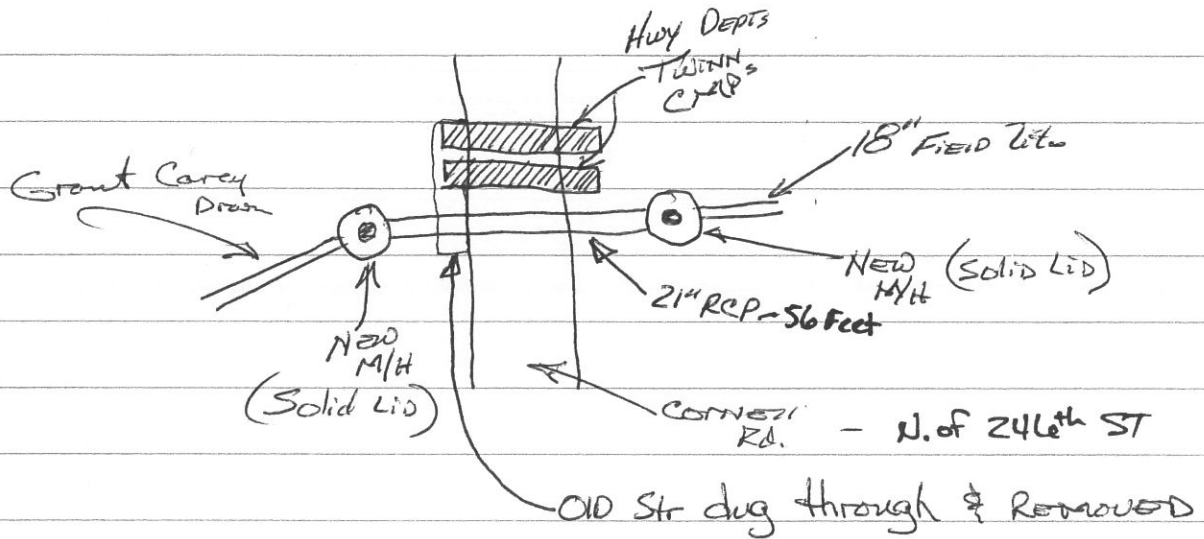

* Removed existing catch basin & breather.

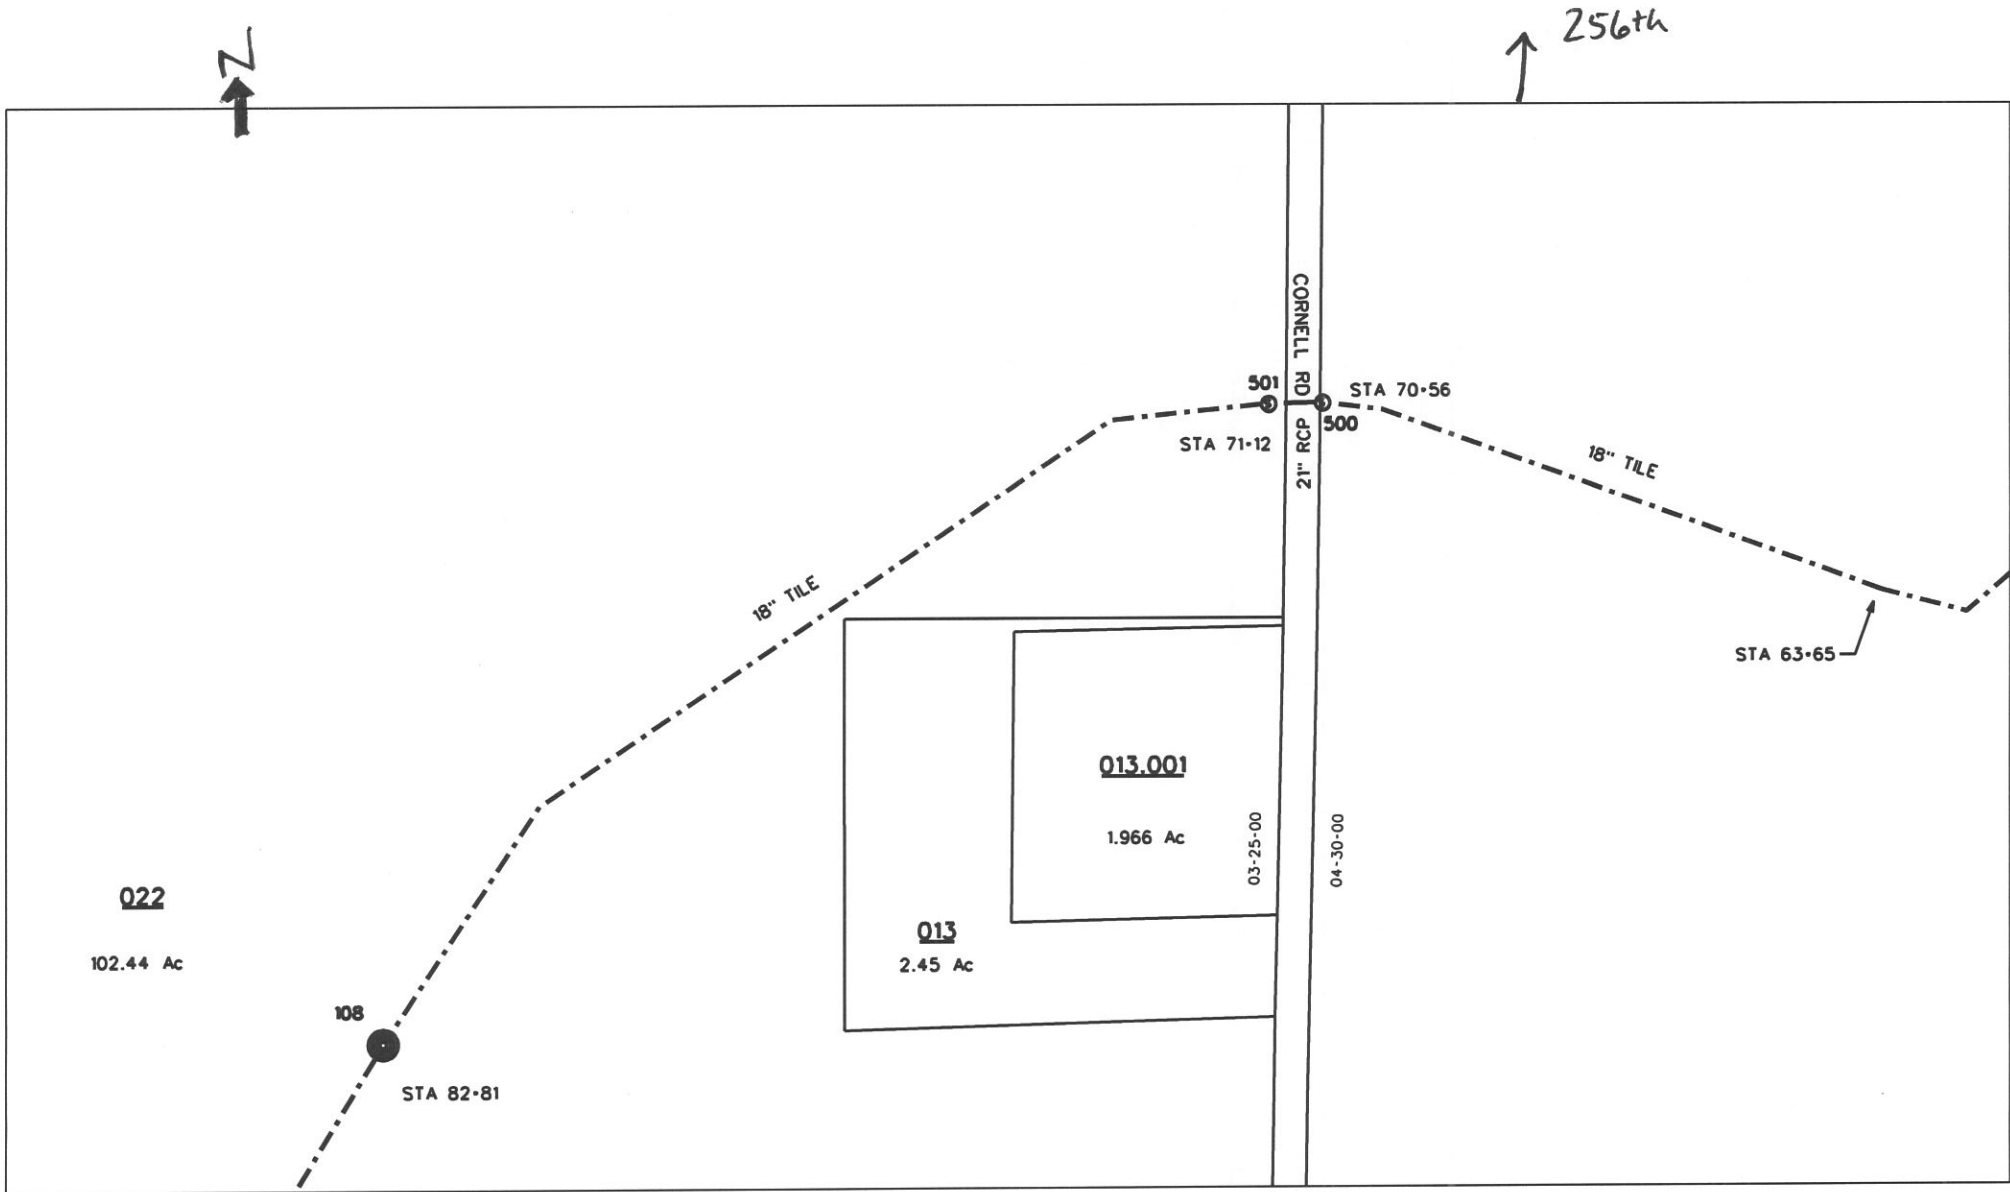

reg_drain_hc.dgn 11/2/2012 4:21:28 PM