

Drain: PL PORTER Drain #: 235
Improvement/Arm: _____
Operator: J. LIVINGSTON Date: 5-26-04
Drain Classification: Urban/Rural Year Installed: 1990

GIS Drain Input Checklist

- Pull Source Documents for Scanning JL
- Digitize & Attribute Tile Drains _____
- Digitize & Attribute Storm Drains JL
- Digitize & Attribute SSD _____
- Digitize & Attribute Open Ditch JL
- Stamp Plans JL
- Sum drain lengths & Validate JL
- Enter Improvements into Posse JL
- Enter Drain Age into Posse JL
- Sum drain length for Watershed in Posse JL
- Check Database entries for errors JL

**Gasb 34 Footages for Historical Cost
Drain Length Log**

Drain-Improvement: P L PORTER

Drain Type:	Size:	Length	Length (DB Query)	Length Reconcile	If Applicable:	
					Price:	Cost:
RCA	12"	7'	7'		7. ²⁵ /lf	50. ⁷⁵
	15"	673'	673'		9. ⁵⁰ /lf	6393. ⁵⁰
	24"	7'	7'		18. ⁰⁰ /lf	126. ⁰⁰
	27"	356'	356'		21. ⁸⁰ /lf	7582. ⁸⁰
	30"	50'	50'		24. ⁶⁰ /lf	1230. ⁰⁰
OPEL DITCH	—	300'	300'		19. ⁵⁵ /lf	5865. ⁰⁰

Sum: 1393' 1393' \$21,248.⁰⁵

Final Report: _____

Comments:



SURVEYOR'S OFFICE

Hamilton County

Kenton C. Ward, Surveyor

776-9626

942 Maple Avenue

Noblesville, Indiana 46060

February 27, 1990

TO: Hamilton County Drainage Board

RE: P.L. Porter Drain

Attached is a petition, plans, calculations and assessment roll for the P.L. Porter Drain.

I have reviewed the submittals and petition and have found each to be in proper form. I have made a personal inspection of the land described in the petition. Upon doing so, I believe that the drain is practicable; will improve the public health; benefit a public highway and be of public utility; and that the costs, damages and expenses of the proposed drain will probably be less than the benefits accruing to the owners of land likely to be benefitted. The drain will consist of the following:

15"	RCP	665ft	30"	RCP	50ft
24"	RCP	25ft	Open	Ditch	300ft
27"	RCP	360ft			


The total length of the drain will be 1400 feet.

The drain will begin at a point approximately forty (40') feet North of the Center line of 196th Street and fifteen (15') feet East of the North East corner of Morgan Woods as recorded in Plat Book 4, page 93 and 94. The drain will run in a Southerly direction to its terminus in the Wheeler-Beals Drain. A stub from Structure 612 will serve the Chance property, 06-30-00-00-006.000, in the future.

I have reviewed the plans and believe the drain will benefit each tract equally. Therefore, I recommend each tract be assessed equally. I recommend a maintenance assessment fo \$5.00 per acre, with a minimum of \$30.00. With this assessment the total annual assessment for the drain will be 1207⁶⁰ . 1177⁶⁰ NFO 4/20/90


I recommend that a Performance Bond be submitted by the petitioner for 100% of the project cost. The bond should be submitted within fifteen (15) days of approval and shall be for a one (1) year period. The drain should be completed one (1) year from date of approval. The bond shall be released upon final inspection by the Surveyor and submittal of "As Built" drawings.

I recommend a hearing be set for May 1990.

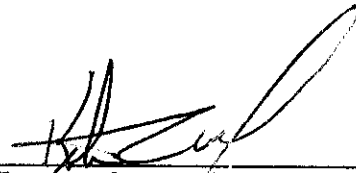

Kenton C. Ward-
Hamilton County Surveyor

KCW/no

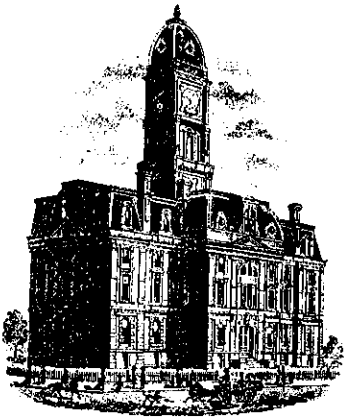

SURVEYOR'S OFFICE
Hamilton County

Kenton C. Ward, Surveyor

776-9626

942 Maple Avenue

Noblesville, Indiana 46060

February 28, 1992

TO: Hamilton County Drainage Board

RE: P.L. Porter Drain

A final inspection has been made of the P.L. Porter Drain. This drain was set as a regulated drain on May 21, 1990 per my report dated February 27, 1990. At the time of inspection the drain was found to be complete and acceptable. As built drawings and Engineer Certificate of Completion have been submitted.

The drain was modified slightly during construction.


A length of twelve (12") inch pipe was installed between Lots 7 and 6 which shall become part of the pipe the drain. The structure 602 was built to the side of the pipe in lieu of on line and only one length of twenty-four (24") inch pipe was stubbed out of STR 603 .

The final length of the drain is as follows:

15" RCP	673ft	12" RCP	7ft
24" RCP	7ft	Open Ditch	300ft
30" RCP	50ft	27" RCP	356ft

The total length of the drain is 1393 feet.

I recommend the Board approve the drain as complete and acceptable.

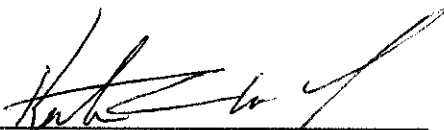

Kenton C. Ward
Hamilton County Surveyor

KCW/no

CERTIFICATE OF COMPLETION AND COMPLIANCE

TO: COUNTY SURVEYOR'S OFFICE, HAMILTON COUNTY
ATTN: Mr. Kenton Ward
FROM: Paul I. Cripe, Inc., Engineers
SUBJECT: P.L. Porter Co. / Westfield / 196th Street & U.S. 31

I hereby certify that

- 1) I am familiar with the plans and specifications for the above referenced project,
- 2) I have personally observed the completion of the above referenced project, and
- 3) To the best of my knowledge, information and belief, the above referenced project has been performed and completed in conformity with all plans and specifications, except _____

Signature *Christopher R. White* Date February 21, 1991

Type or Printed Name Christopher R. White

Business Address Paul I. Cripe, Inc.
7172 Graham Road / Indianapolis, IN 46250

Telephone 842-6777



Seal

Indiana Registration Number

20491

ADM:t1
1/13/84

NOTE:
 1. CUTS SHOWN ARE APPROXIMATE, TAKEN FROM EXISTING GRADE TO INVERT OF PIPE.
 2. FIELD ADJUSTMENT BY ENGINEER MAY BE REQUIRED AT ALL OUTFALL POINTS TO INSURE PROPER OUTFALL CONDITIONS.

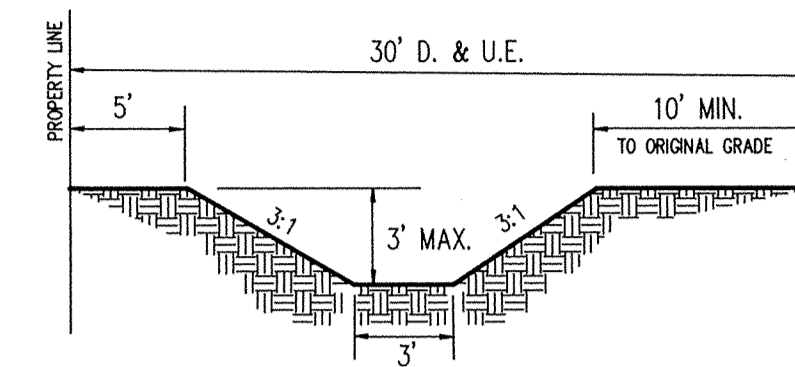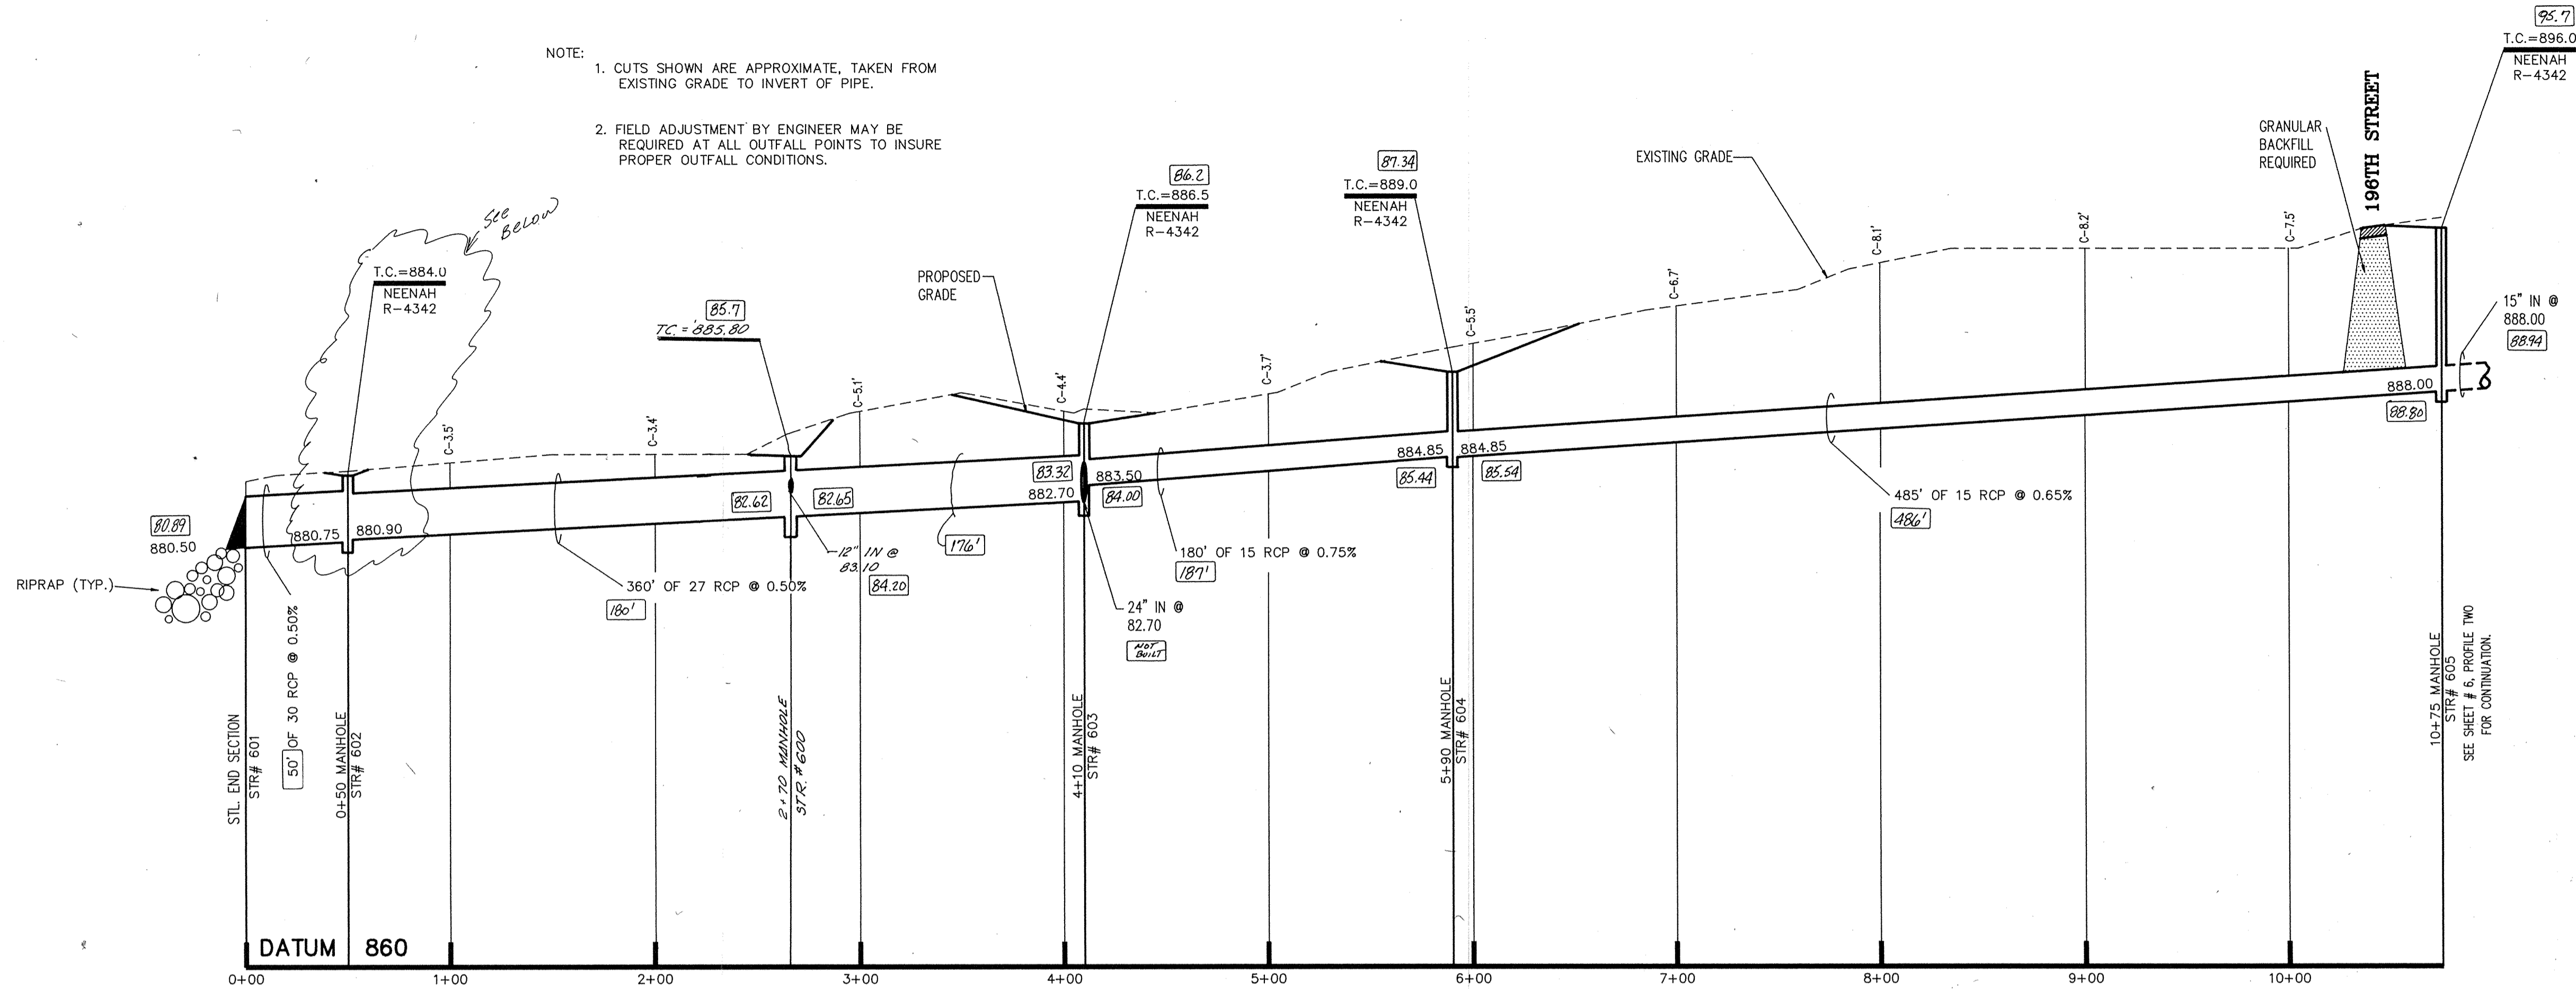

SECTION A-A SWALE DETAIL
 NOT TO SCALE


HAMILTON COUNTY INDIANA
 1825

This information was gathered for input into the Hamilton County Geographical Information System. This document is considered an official record of the GIS.

Entry Date: 5-26-04
 Entered by: [Signature]

PROFILE ONE

00.0 = AS-BUILT INFORMATION

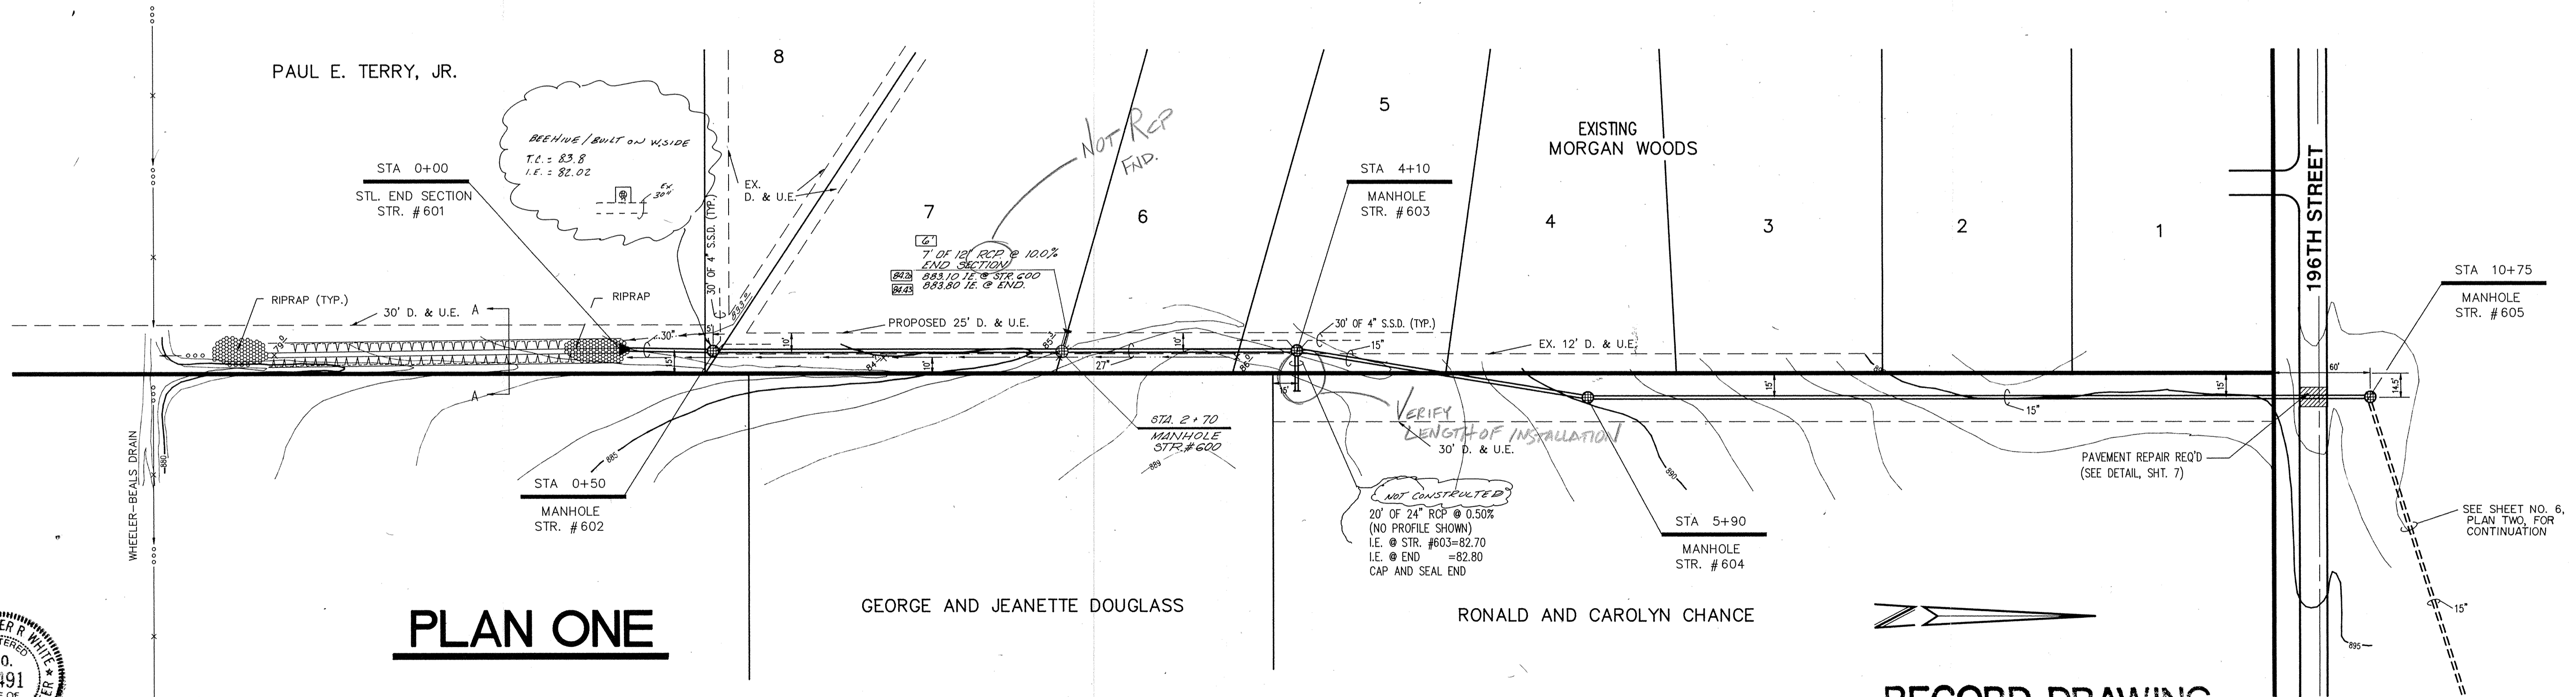

PLAN ONE


RECORD DRAWING

FILE NAME: PORTER\89463F1



CERTIFIED BY:
 Christopher R. White
 3-13-90 DATE

REVISIONS	
9-24-90	Added Structure #600 @ LOTS 2-7 I additional grade @ lot 2
2-20-91	ADDED AS-BUILT INFORMATION DTS

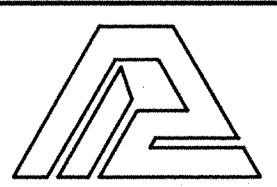

PAUL I. CRIFE, INC.
 7172 GRAHAM ROAD
 INDIANAPOLIS, INDIANA 46250
 (317) 842-6777

- CIVIL ENGINEERING
- LAND SURVEYING
- ARCHITECTURE
- LAND PLANNING

TECH CHK: JG
 DRAWN BY: [Signature]
 DRFTNG. CHK: [Signature]

DRAWING TITLE: OFF-SITE STORM PLAN & PROFILE

SCALE: VERT: 1"=5'
 HORIZ: 1"=50'

DATE: 3-15-90
 CLIENT: P.L. PORTER CO.

DWG. TYPE	FILE NUMBER	SHEET:
		5
JOB NUMBER		OF 9
894631-000000		