

Kenton C. Ward, CFM  
Surveyor of Hamilton County  
Phone (317) 776-8495  
Fax (317) 776-9628

Suite 188  
One Hamilton County Square  
Noblesville, Indiana 46060-2230

### *Map Correction-Field Verification*

**Drain Number:** #32

**Drain Length:** 4444

**Drain Name:** Village Farms Sec. 8

**Change +/- :** 37

**Date:** 07-13-2011

**New Length:** 4481

**Verified By:** SLM, GRH, SAB


---

#### **Notes & Sketch:**

It was discovered in the field that the drain was not mapped as it exists. The GIS did not truly reflect what was on the asbuilts. See the attached map for further detail.

*This correction added the pipe between str 116 & 116A, which consisted of 9' of 12" RCP. Also added was 28' of 36" RCP between str. 11A and 116.*

  
Suzanne L. Mills  
GIS Specialist

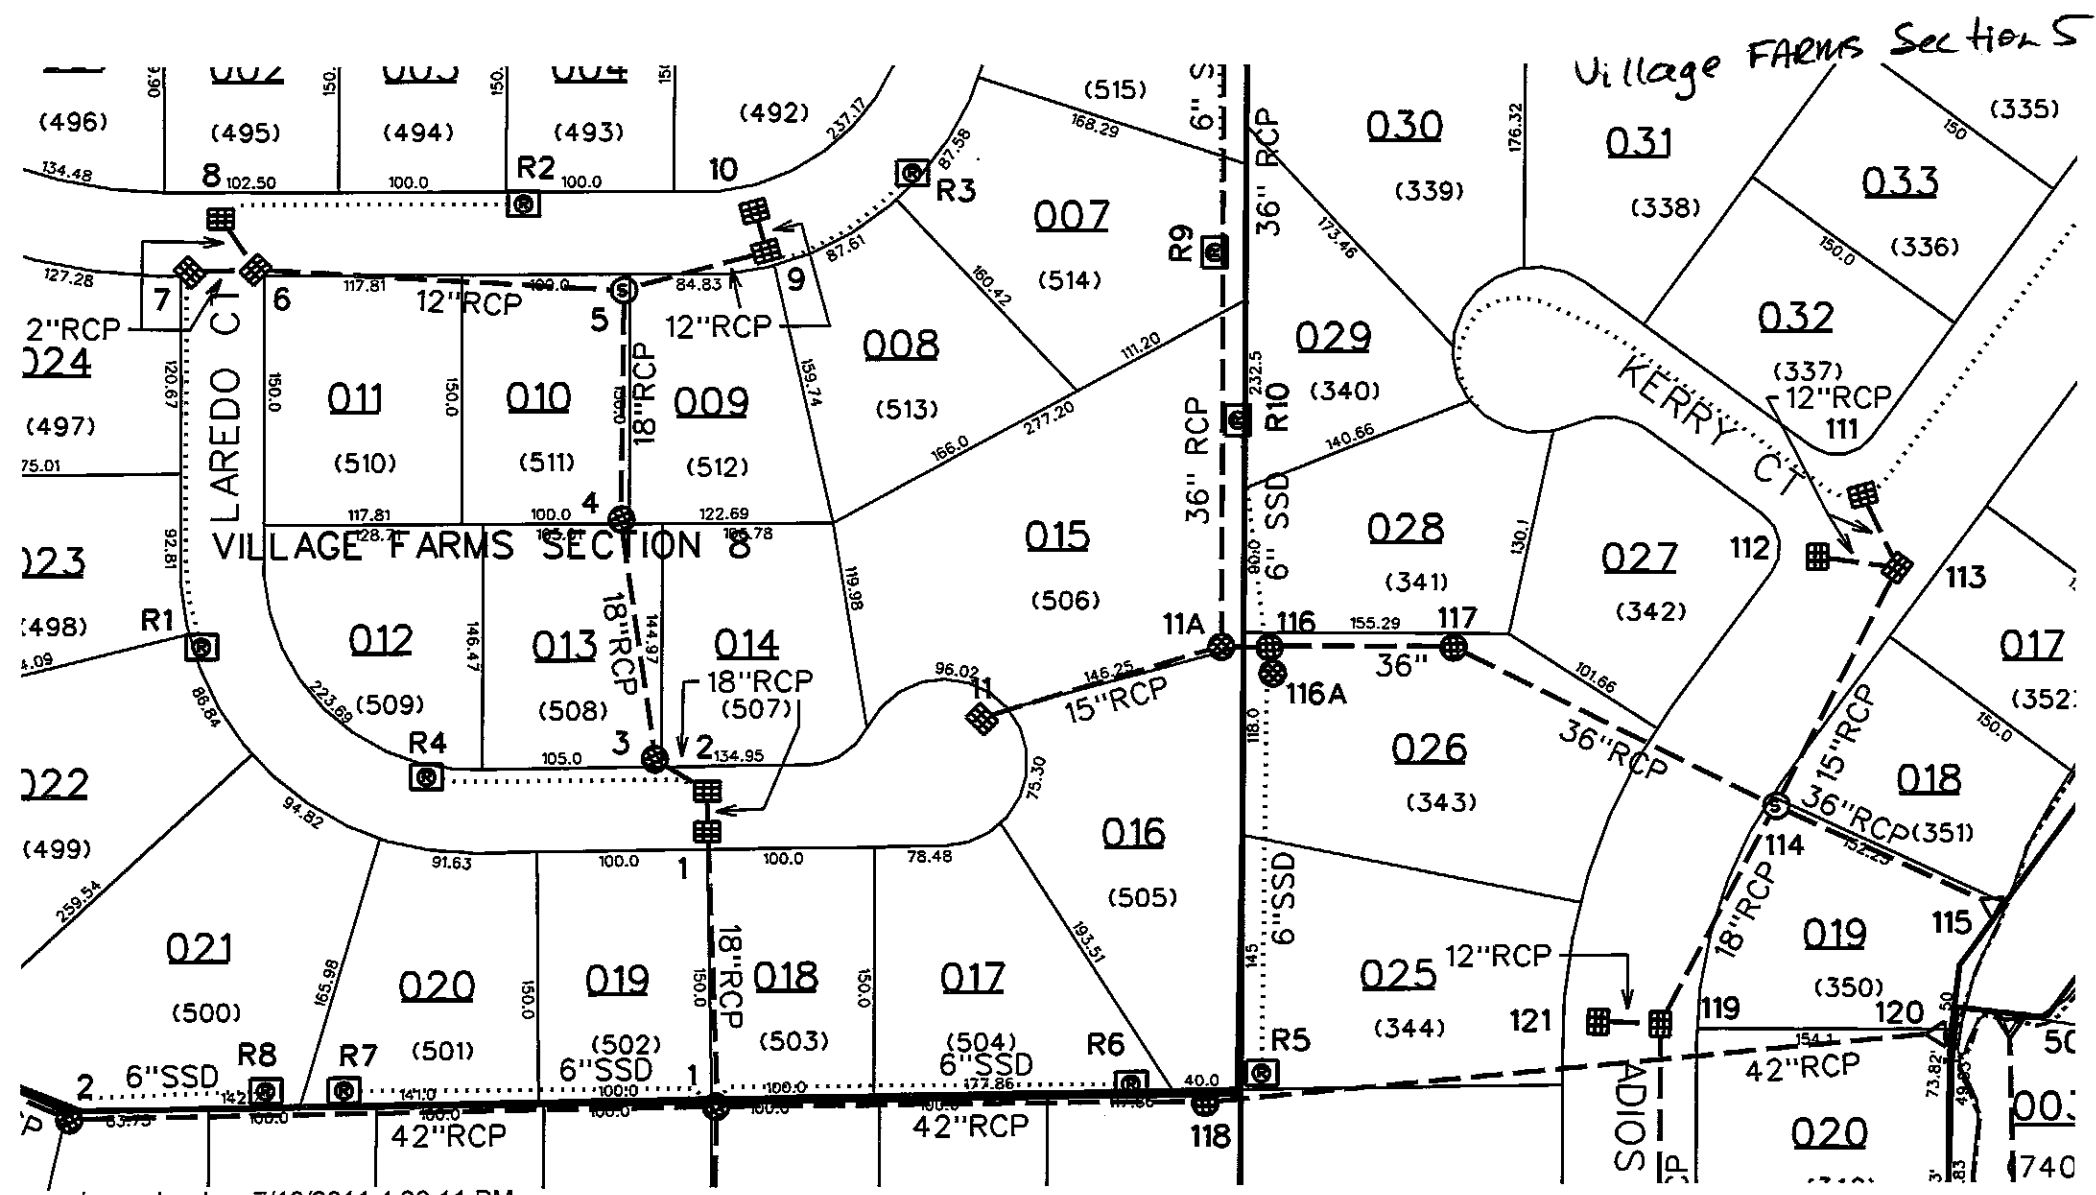

sub\_rg\_drn.dgn 7/13/2011 4:26:11 PM