



Kenton C. Ward, CFM Surveyor of Hamilton County Phone (317) 776-8495 Fax (317) 776-9628

Suite 188 One Hamilton County Square Noblesville, Indiana 46060-2230

November 15, 2007

To: Hamilton County Drainage Board

Re: W. R. Fertig Drain: 122nd Street Road Improvements

Attached are petition, plans and other information for the 122nd Street Road Improvement project petitioned by the City of Carmel. An inspection of the drainage facilities for this project has been made and the facilities were found to be complete and acceptable.

This report will serve as an initial and final report for this construction. This road project began approximately 400 feet West of Hancock Street and followed 122nd Street to its intersection with Carmel Dr. During this construction of this project affected the W. R. Fertig Drain. The changes are as follows:

WR Fertig Drain #176

Carmel Science and Technology Park Arm:

The project replaced existing Structures 555 and 554 with a manhole. A new manhole was placed between existing Structures 553 and 554, noted on the plans as Structure 37. A new manhole (Structure 40A) was placed 58 feet east of existing Structure 553 and a manhole (Structure 43) was placed 196 feet east of new Structure 40A. A new round casting was placed on Structure 545. Structures 545 & 546 were converted from double to single curb inlets. A new manhole (Structure 57) was placed just 25 feet north of existing Structure 544. Also discovered was existing Carmel Science & Technology Park Drain between Structures 28, 35 and existing Structure 553. This added 460 feet of 42" RCP to this drain.

The project removed the following drain: existing stub – Structure 545, existing stub – Structure 551, Structure 551-549, Structure 549-548, Structure 550 - 549, Structure 561 - 562, Structure 562 - 563 and Structure 563 – existing stub. As a result of this removal, there was a total of 228 feet removed from the Carmel Science and Technology Park Arm. Overall there was 232 feet of drain added to the Carmel Science and Technology Park Arm and to the Fertig west shed.

Upon approval of the reconstruction I recommend the Board approve the drain's construction as complete and acceptable.

Sincerely,

Kenton C. Ward, CFM Hamilton County Surveyor

KCW/slm

Gasb 34 Asset Price & Drain Length Log

Drain-Improvement: 122nd Street Improvements

					If Applicable	
Drain Type:	Size:	Length	Length (DB Query)	Length Reconcile	Price:	Cost:
RCP	42"	460	460	0	\$52.65 LF	\$24,219
	Sum:	460				\$24,219
Final Report:				,		
Comments:						
						
. 1.u					* -	


HAMILTON COUNTY DRAINAGE BOARD NOBLESVILLE, INDIANA

IN RE: R - 27472					
Hamilton County, Indiana)					
PETITION FOR RELOCATION AND RECONSTRUCTION					
(hereinafter Petitioner"),					
hereby petitions the Hamilton County Drainage Board for authority to relocate and improve a					
section of the W.R. Fertia Drain, and in support of					
said petition advises the Board that:					
1. Petitioner owns real estate through which a portion of the N.R. Fertig					
Drain runs.					
2. Petitioner plans to develop its real estate with roads, buildings, utilities, storm drains,					
sanitary sewers and other structures.					
Petitioner's proposed development of its real estate will require relocation and					
reconstruction of a portion of the W.R. Fertig Drain, as					
specifically shown on engineering plans and specifications filed with the Hamilton					
County Surveyor.					
4. The work necessary for the proposed relocation and reconstruction will be undertaken at					
the sole expense of the Petitioner and such work will result in substantial improvement to					
the W.R. Fer tig Drain, without cost to other property owners					
on the watershed of the W.R. Fertig Drain.					
WHEREFORE, Petitioner requests that an Order issued from the Hamilton County					
Drainage Board authorizing relocation and reconstruction of the W.R. Fertig					
Drain, in conformance with applicable law and plans and specifications on file with the Hamilton					
County Surveyor.					
Signed MICHAEL T. McBRISE Printed					
Printed T. MCBRISE					

MARTE 2003

Martin Comments of the comments of

Adobs PDF Filiable Form

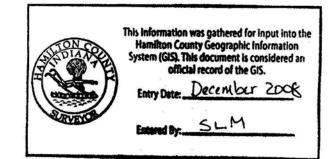

INDIANA DEPARTMENT OF TRANSPORTATION

AS BUILT PLAN AND PROFILE PLANS FOR STATE HIGHWAY


STP-PROJECT NO.-9929 P.E. STP-PROJECT NO.-9929 R/W STP-PROJECT NO.-IN36 (001)CN

PROJECT DESCRIPTION


BEGINNING AT THE INTERSECTION OF 122nd STREET AND PENNSYLVANIA STREET EXTENDING IN A NORTHEASTLY DIRECTION APPROXIMATELY 800 FEET NORTHEAST OF CLARK STREET, LOCATED IN SECTIONS 35 AND 36, T18N, R3E, ALL IN CLAY TOWNSHIP, HAMILTON COUNTY, INDIANA

> GROSS LENGTH: - 1.116 MI. NET LENGTH: - 1.116 MI

MAX. GRADE: 2.00%

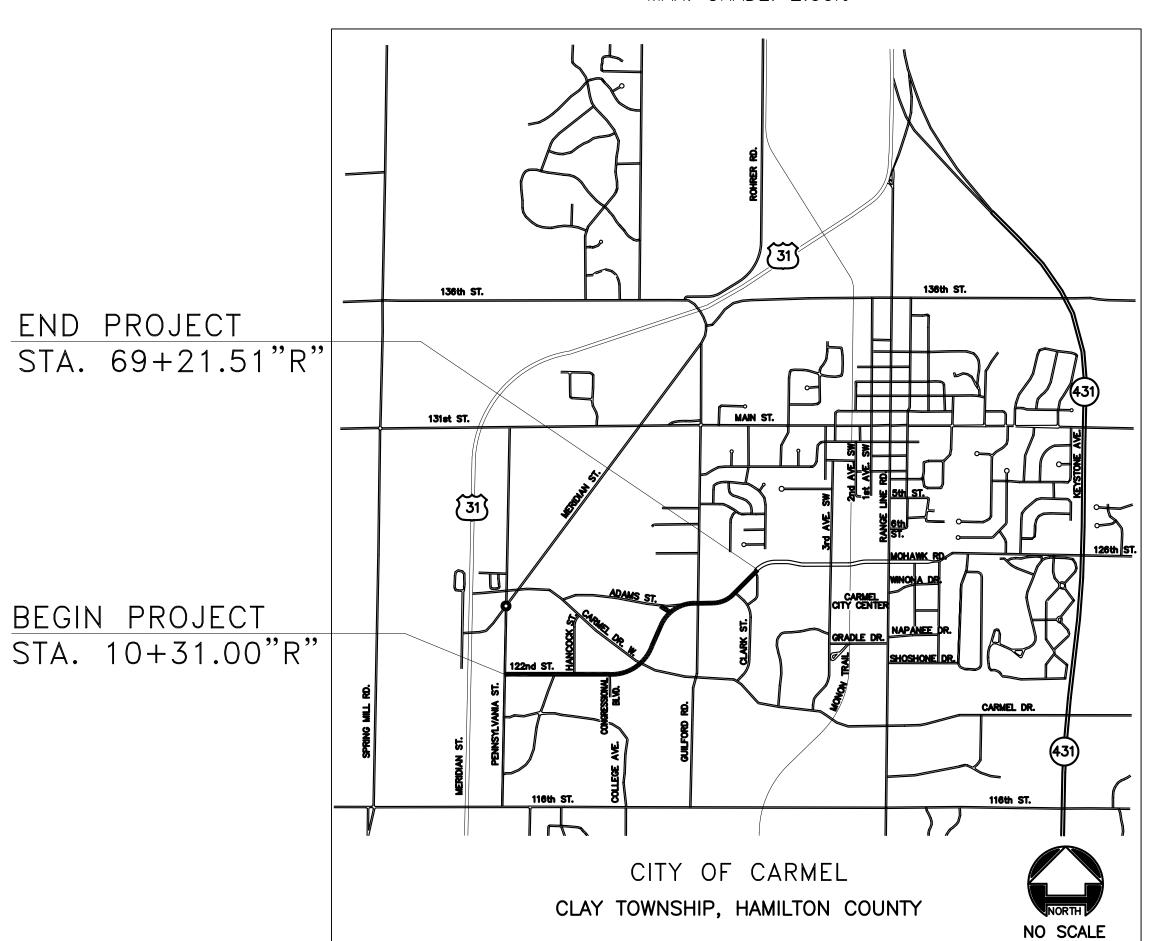

TRAFFIC DATA 10,650 V.P.D. 18,420 V.P.D. 1,390 V.P.H. A.A.D.T. D.H.V. DIRECTIONAL DISTRIBUTION 4% D.H.V. 5% A.A.D.T. ESAL'S MAINLINE/SHOULDER 1,525,000 DESIGN DATA DESIGN SPEED 40 M.P.H. PROJECT DESIGN CRITERIA RECONSTRUCTION (NON-FREEWAY) FUNCTIONAL CLASSIFICATION PRINCIPAL ARTERIAL RURAL/URBAN **URBAN (INTERMEDIATE)**

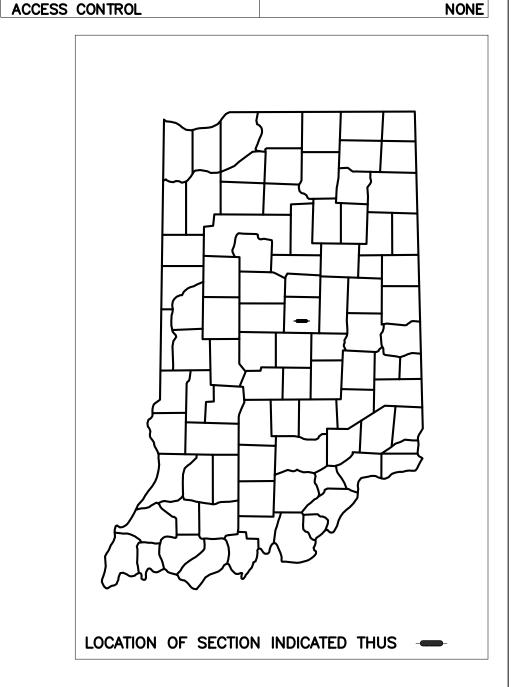

PLANS PREPARED BY:



WOOLPERT LLP 7140 Waldemar Drive Indianapolis, Indiana 46268-4192 317.299.7500 **WOOLPERT** FAX: 317.291.5805

AS BUILT PLANS PREPARED BY:



Development Consultants

CROSSROAD ENGINEERS, P.C. 3417 SOUTH SHERMAN DRIVE BEECH GROVE, IN 46107 PHONE: 317-780-1555 FAX: 317-780-6525


EMAIL: INFO@CROSSROADENGINEERS.COM


FEDERAL HIGHWAY ADMINISTRATION DEPARTMENT OF TRANSPORTATION

APPROVED DIVISION ADMINISTRATOR DATE


STANDARD SPECIFICATIONS DATED 1999 TO BE USED WITH THESE PLANS.

INDIANA DEPARTMENT OF TRANSPORTATION

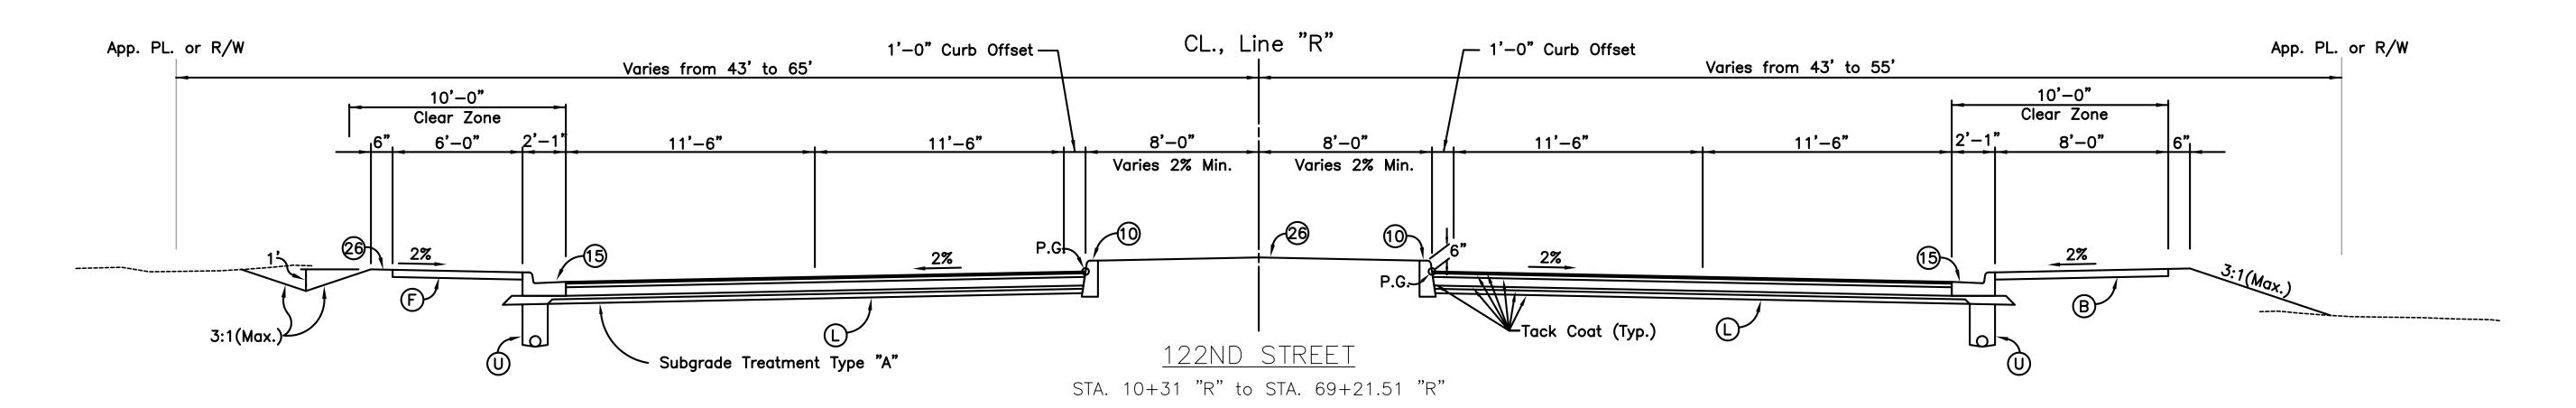


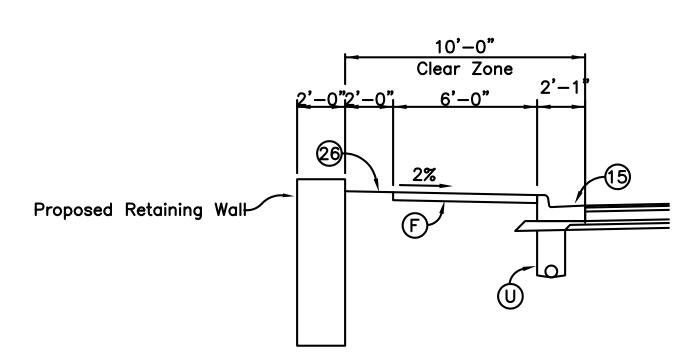

STA. 35+41 "R" to STA. 39+18 "R"

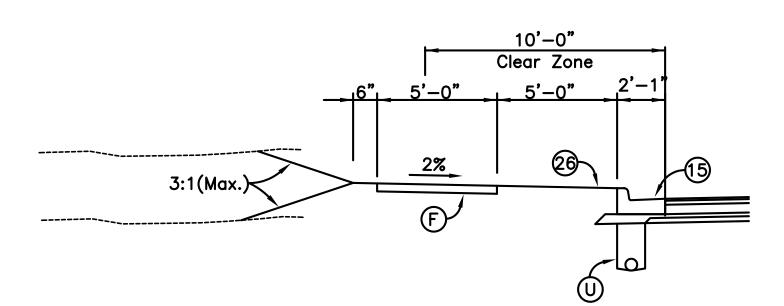


STA. 42+68.30 "R" to STA. 55+01.55 "R"

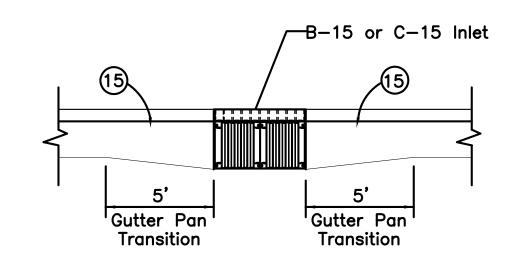


MODIFIED CURB AT INLET Not To Scale


* Cost to be included in modified concrete curb, and gutter.

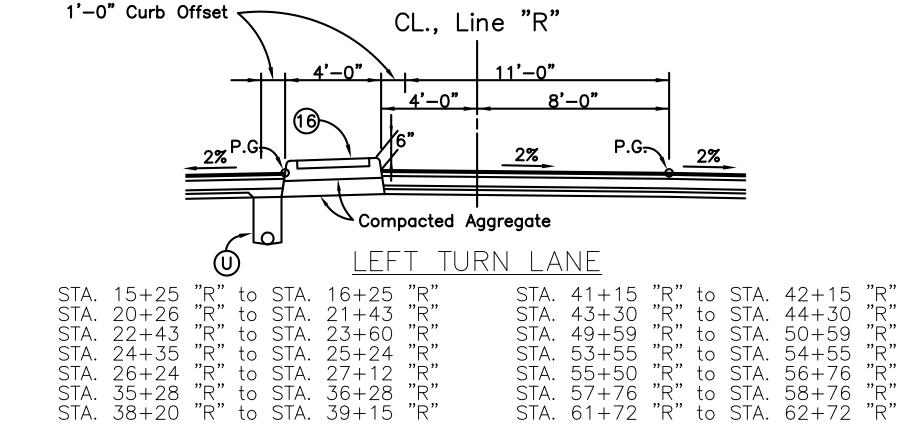


REVERSE AS NECESSARY

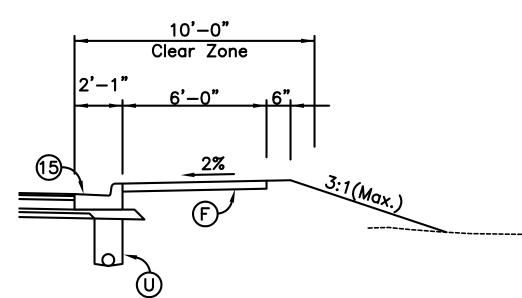

STA. 61+32.23 "R" to STA. 69+21.51 "R"

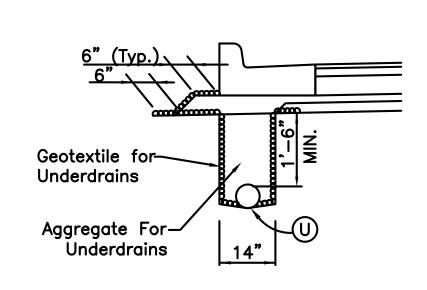

GEOTEXTILE AND UNDERDRAIN DETAIL

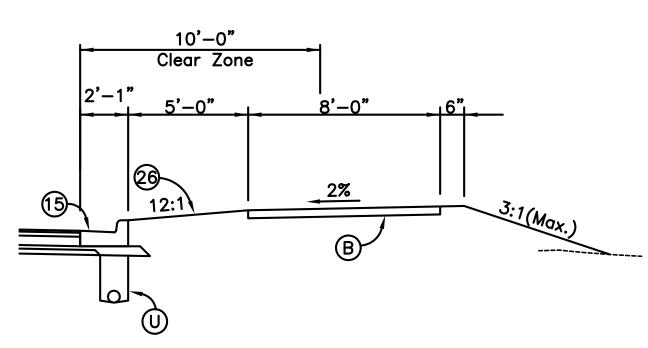

STA. 42+68.30 "R" to STA. 55+01.55 "R"

TYPICAL DITCH SODDING DETAIL

No Scale


6" CEMENT CONCRETE PAVEMENT FOR DRIVEWAYS

LEGEND

6" COMPACTED AGGREGATE, NO. 53, BASE

140#/SYD HMA, TYPE A, SURFACE ON 300#/SYD HMA, TYPE A, INTERMEDIATE ON 5" COMPACTED AGGREGATE, NO. 53, BASE

- E HMA, TYPE A, APPROACHES 140#/SYD HMA, TYPE A, SURFACE ON 300#/SYD HMA, TYPE A, INTERMEDIATE ON 860#/SYD HMA, TYPE A, BASE
- F 4" CONCRETE SIDEWALK
- F) PATTERNED CONCRETE
- (K) QC/QA-HMA RESURFACING 165#/SYD QC/QA - HMA, 2, 64, SURFACE, 9.5 mm
- FULL DEPTH QC/QA-HMA PAVEMENT: 165#/SYD QC/QA — HMA, 2, 64, SURFACE, 9.5 mm ON 275#/SYD QC/QA — HMA, 2, 64, INTERMEDIATE, 19 mm ON 440#/SYD QC/QA — HMA, 2, 64, BASE, 25 mm ON 300#/SYD QC/QA — HMA, 5, 76, INTERMEDIATE, C19.0 mm ON 330#/SYD QC/QA - HMA, 2, 64, BASE, 25 mm
- HMA, TYPE A, APPROACHES 140#/SYD HMA, TYPE A, SURFACE ON 300#/SYD HMA, TYPE A, INTERMEDIATE ON 8" COMPACTED AGGREGATE, NO. 53, BASE
- N SURFACE MILLING 1 1/2"
- HANDICAP RAMP "AS DESIGNATED"
- WIDENING WITH QC/QA-HMA 275#/SYD QC/QA - HMA, 2, 64, INTERMEDIATE, 19 mm ON 440#/SYD QC/QA - HMA, 2, 64, BASE, 25 mm ON 300#/SYD QC/QA - HMA, 5, 76, INTERMEDIATE, C19.0 mm ON 330#/SYD QC/QA - HMA, 2, 64, BASE, 25 mm
- UNDERDRAIN
- ONCRETE CURB
- MODIFIED COMBINED CONCRETE CURB & GUTTER
- MODIFIED CONCRETE CENTER CURB (SEE SHEET NO. 4 FOR DETAILS)
- SODDING (NURSERY)
- CONDUIT, 4", PVC
- HANDHOLE

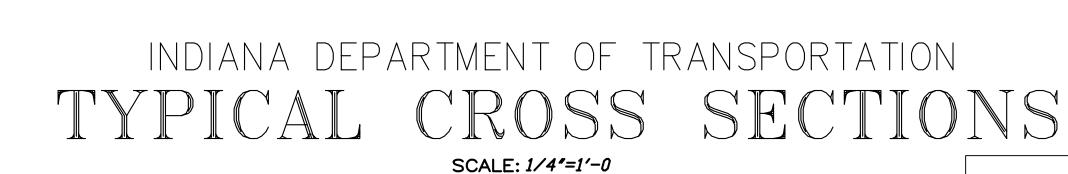

PROLECT NO. LINE SHEET TOTAL SHEETS

STP-9929() "R" 2 19

