

Kenton C. Ward, CFM
Surveyor of Hamilton County
Phone (317) 776-8495
Fax (317) 776-9628

Suite 188
One Hamilton County Square
Noblesville, Indiana 46060-2230

Map Correction-Field Verification

Drain Number: 359

Drain Length: N/A

Drain Name: J.C. Ringer

Change +/-: N/A

Date: 7-10-2013


New Length: N/A

Verified By: SLM, SAB

Notes & Sketch:

Map correction is from sta 0 to Sta 9+11. General location of tile was adjusted based upon field work done by Steve Baltz. A RISER was mapped (str. 99). This was set in with WO-2013-00179. The length of drain stayed the same.

Suzanne L. Mills
GIS Specialist

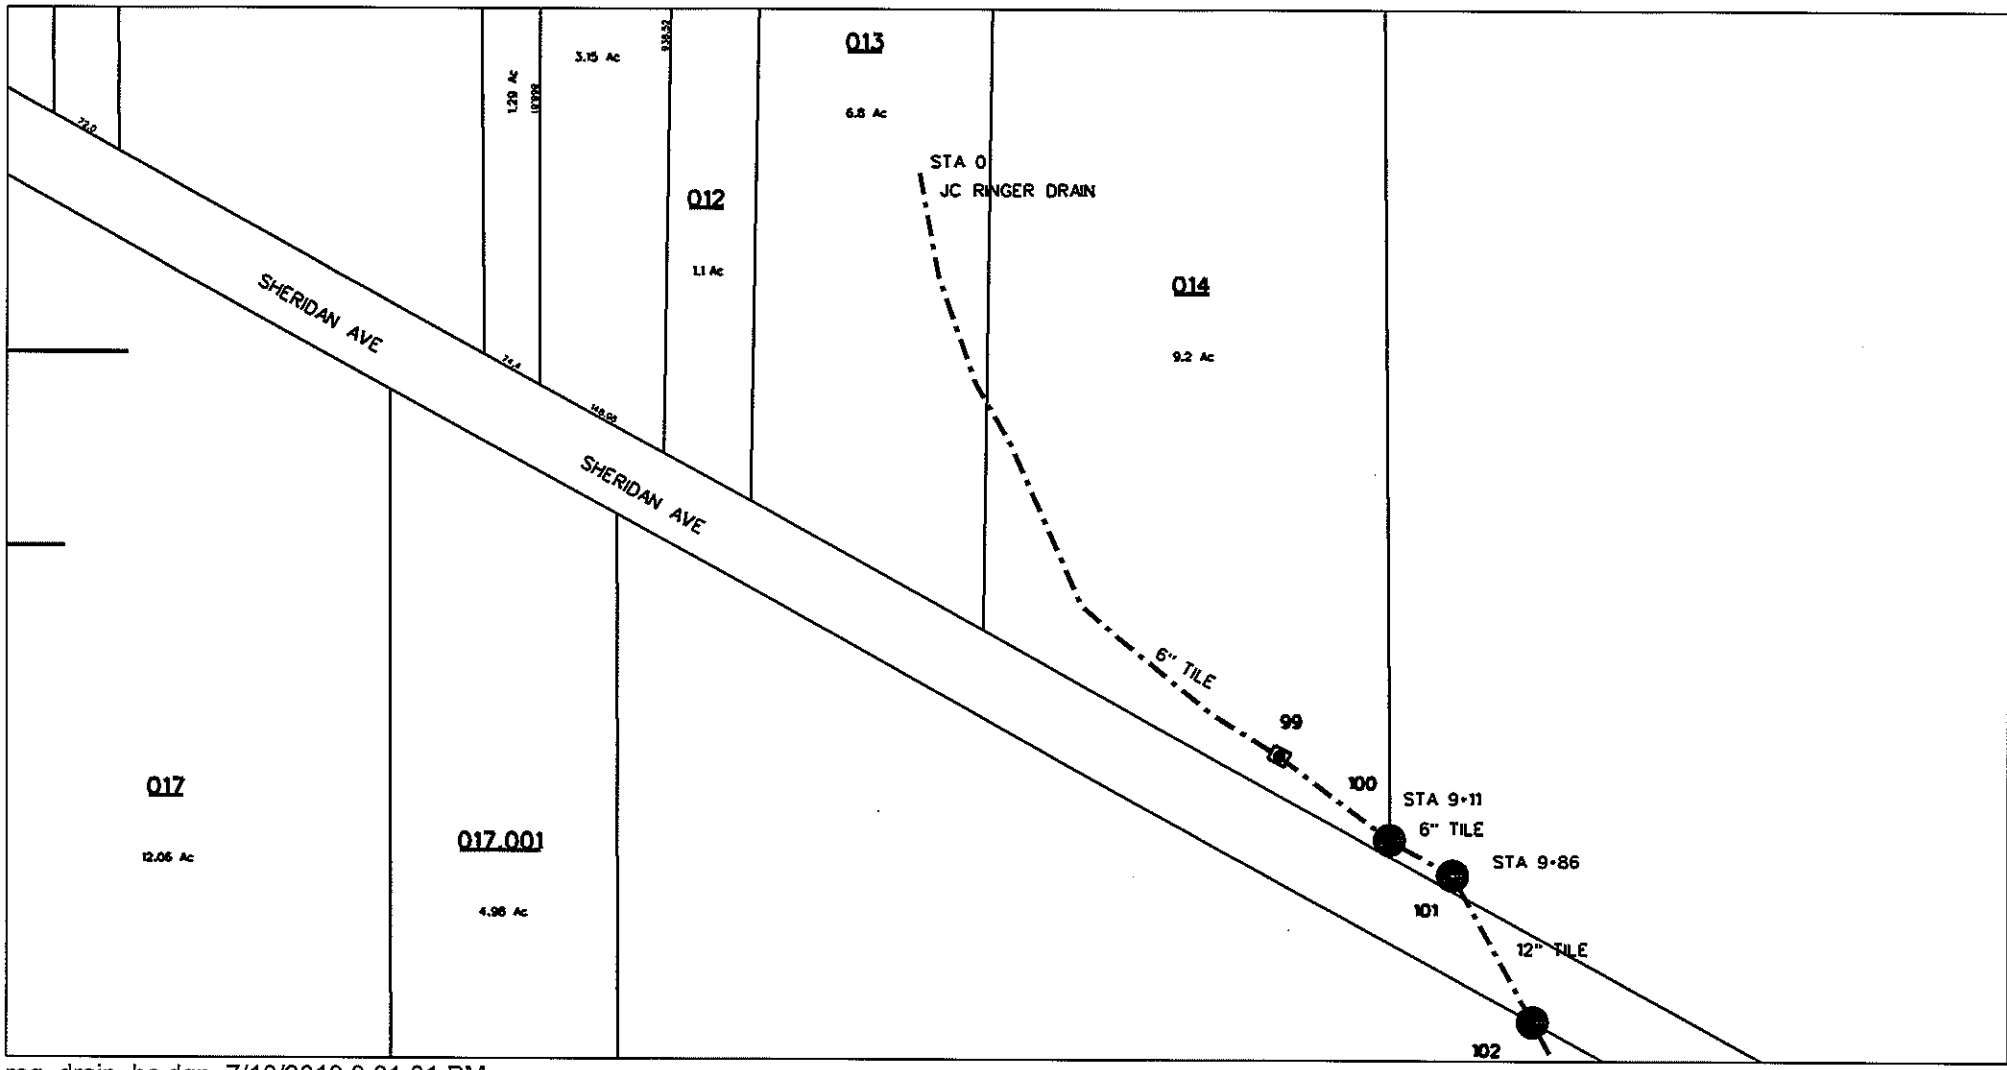

reg_drain_hc.dgn 7/10/2013 3:01:01 PM