

Kenton C. Ward, Surveyor

Phone (317) 776-8495

Fax (317) 776-9628

Suite 188

One Hamilton County Square

Noblesville, Indiana 46060-2230

Map Correction-Field Verification

Drain Number: #167

Drain Length: 21+88

Drain Name: Kercheval-Reagan
(JC Kercheval)

Change +/-: -319 (10" Tile)

Date: 10-21-04

New Length: 18+69


Verified By: Steve Baitz (00-2004-00221)

Notes & Sketch:

* See attached map. The tile was dug up at various points to verify the location of the JC Kercheval drain. This reduced its length by 319'. This reduces the historical cost of the drain as originally reported for GASB 34 by \$957⁰⁰.

Suzanne L. Mills
GIS Specialist

AL-REAGAN DRAIN

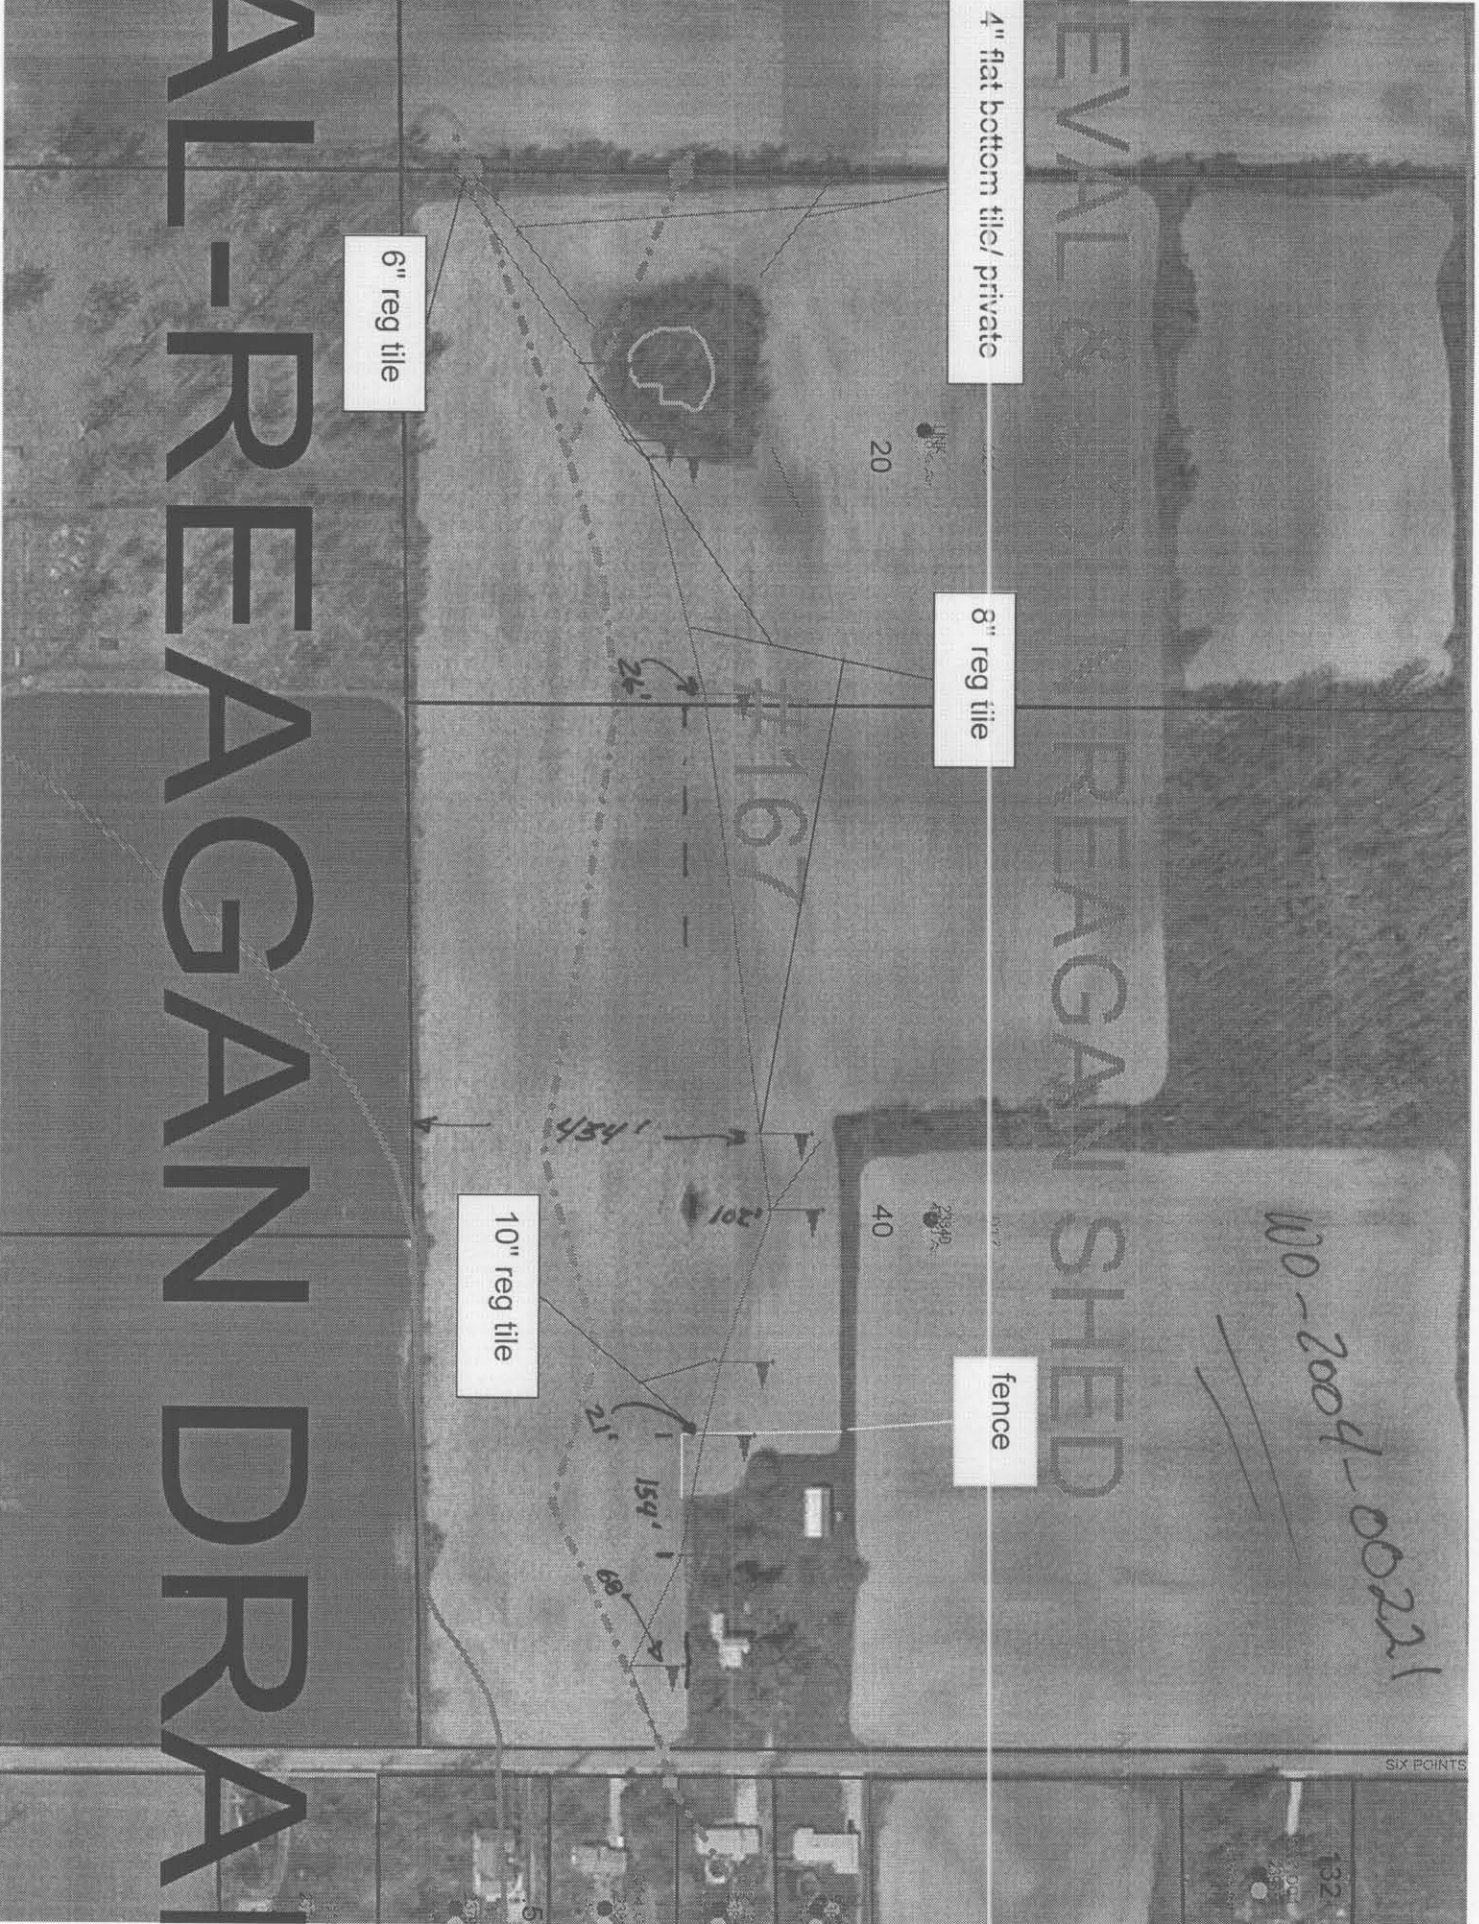

4" flat bottom tile/ private

6" reg tile

8" reg tile

10" reg tile

fence

HEVAL & REAGAN SHED

100-2004-00221

#167

20

40

SIX POINTS

132