

HAMILTON COUNTY DRAINAGE BOARD
NOBLESVILLE, INDIANA

FILED

OCT 19 2020

OFFICE OF HAMILTON COUNTY SURVEYOR

IN RE: W.C. Inman)
Hamilton County, Indiana)

PETITION FOR RELOCATION AND RECONSTRUCTION

Chatham Hills, LLP (hereinafter "Petitioner"),

hereby petitions the Hamilton County Drainage Board for authority to relocate and improve a section of the W.C. Inman Drain, and in support of said petition advises the Board that:

1. Petitioner owns real estate through which a portion of the W.C. Inman Drain runs.
2. Petitioner plans to develop its real estate with roads, buildings, utilities, storm drains, sanitary sewers and other structures.
3. Petitioner's proposed development of its real estate will require relocation and reconstruction of a portion of the W.C. Inman Drain, as specifically shown on engineering plans and specifications filed with the Hamilton County Surveyor.
4. The work necessary for the proposed relocation and reconstruction will be undertaken at the sole expense of the Petitioner and such work will result in substantial improvement to the W.C. Inman Drain, without cost to other property owners on the watershed of the W.C. Inman Drain.
5. Proposed relocation and reconstruction will not adversely affect other land owners within the drainage shed.
6. Petitioner requests approval of the proposed relocation and reconstruction under IC 36-9-27-52.5.

WHEREFORE, Petitioner requests that an Order issued from the Hamilton County Drainage Board authorizing relocation and reconstruction of the W.C. Inman Drain, in conformance with applicable law and plans and specifications on file with the Hamilton County Surveyor.


Signed

Brad Henke, Chatham Hills, LLP
Printed

STATE OF INDIANA)
) ss:
COUNTY OF HAMILTON)

BEFORE THE HAMILTON COUNTY
DRAINAGE BOARD
NOBLESVILLE, INDIANA

IN THE MATTER OF THE
RECONSTRUCTION OF THE
**Isaac Jones Drain, W. C. Inman Arm 1, Chatham Villages Section 1
Reconstruction**

FINDINGS AND ORDER FOR RECONSTRUCTION

The matter of the proposed Reconstruction of the **Isaac Jones Drain, W. C. Inman Arm 1, Chatham Villages Section 1 Reconstruction** came before the Hamilton County Drainage Board for hearing **on June 14, 2021**, on the Reconstruction Report consisting of the report and the Schedule of Damages and Assessments. The Board also received and considered the written objection of an owner of certain lands affected by the proposed Reconstruction, said owner being:

Evidence was heard on the Reconstruction Report and on the aforementioned objections.

The Board, having considered the evidence and objections, and, upon motion duly made, seconded and unanimously carried, did find and determine that the costs, damages and expenses of the proposed Reconstruction will be less than the benefits accruing to the owners of all land benefited by the Reconstruction.


The Board having considered the evidence and objections, upon motion duly made, seconded and unanimously carried, did adopt the Schedule of Assessments as proposed, subject to amendment after inspection of the subject drain as it relates to the lands of any owners which may have been erroneously included or omitted from the Schedule of Assessments.

The Board further finds that it has jurisdiction of these proceedings and that all required notices have been duly given or published as required by law.

Wherefore, it is ORDERED, that the proposed Reconstruction of the **Isaac Jones Drain, W. C. Inman Arm 1, Chatham Villages Section 1 Reconstruction** be and is hereby declared established.

Thereafter, the Board made inspection for the purpose of determining whether or not the lands of any owners had been erroneously included or excluded from the Schedule of Assessments. The Board finds on the basis of the reports and findings at this hearing as follows:


HAMILTON COUNTY DRAINAGE BOARD

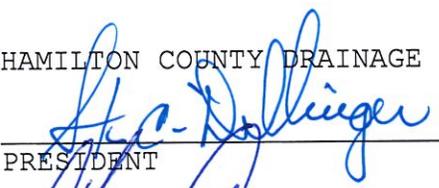

PRESIDENT



Member

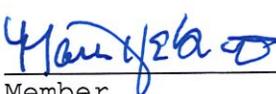

Member

ATTEST:


Executive Secretary

FILED

OCT 22 2020


CHATHAM VILLAGES -SECTION 1
W.C. INMAN REGULATED DRAIN
RECONSTRUCTION ENGINEERS ESTIMATE

OFFICE OF HAMILTON COUNTY SURVEYOR

STORM DRAINAGE					
1	Selective Demolition	1	LS	\$ 2,000.00	\$ 2,000.00
2	36" RCP Includes Bedding	96	LF	\$ 70.00	\$ 6,720.00
3	12" RCP Includes Bedding	12	LF	\$ 55.00	\$ 660.00
4	Earthwork	1	LS	\$ 200,000.00	\$ 200,000.00
5	Permanent Seeding and Erosion Blanket	1	LS	\$ 20,000.00	\$ 20,000.00
6	Outlet Structure	1	EA	\$ 2,500.00	\$ 2,500.00
7	Storm Manhole and Casting	1	EA	\$ 3,000.00	\$ 3,000.00
8	36" RCP Concrete End Section	1	EA	\$ 1,500.00	\$ 1,500.00
9	Rip-Rap Outlet Protection	1	LS	\$ 3,000.00	\$ 3,000.00
REGULATED DRAIN RECONSTRUCTION COST					\$239,380.00
CONSTRUCTION BOND 120% OF RECONSTRUCTION COST					\$284,856.00

Completed by: Christopher M. Wiseman, PE



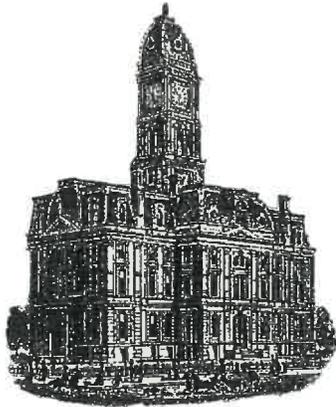

Kenton C. Ward, CFM
Surveyor of Hamilton County
Phone (317) 776-8495
Fax (317) 776-9628

Suite 188
One Hamilton County Square
Noblesville, Indiana 46060-2230

To: Hamilton County Drainage Board

April 18, 2023

Re: Isaac Jones – WC Inman Drain, Arm 1 – Chatham Villages Sec. 1 Reconstruction

Attached are as-builts and other information for Chatham Villages Sec. 1 Reconstruction. An inspection of the drainage facilities for this section has been made and the facilities were found to be complete and acceptable.

During construction, changes were made to the drain, which will alter the plans submitted with my report for this drain-dated June 11, 2021. The report was approved by the Board at the hearing held June 14, 2021. (See Drainage Board Minutes Book 20, Pages 62-63)
The changes are as follows: the open drain was shortened from 1437 feet to 1336 feet. The length of the drain due to the changes described above is now **1336 feet**. The project removed 1374 feet of existing drain.


The non-enforcement was approved by the Board at its meeting on June 14, 2021 and recorded under instrument #2022015015. The following sureties were guaranteed by Great American Insurance Co and released by the Board on its April 10, 2023, meeting.

Bond-LC No: 3705255
Amount: \$284,856.00
For: Storm Sewers
Issue Date: Nov. 20, 2020

I recommend the Board approve the drain's construction as complete and acceptable.

Sincerely,


Kenton C. Ward, CFM
Hamilton County Surveyor

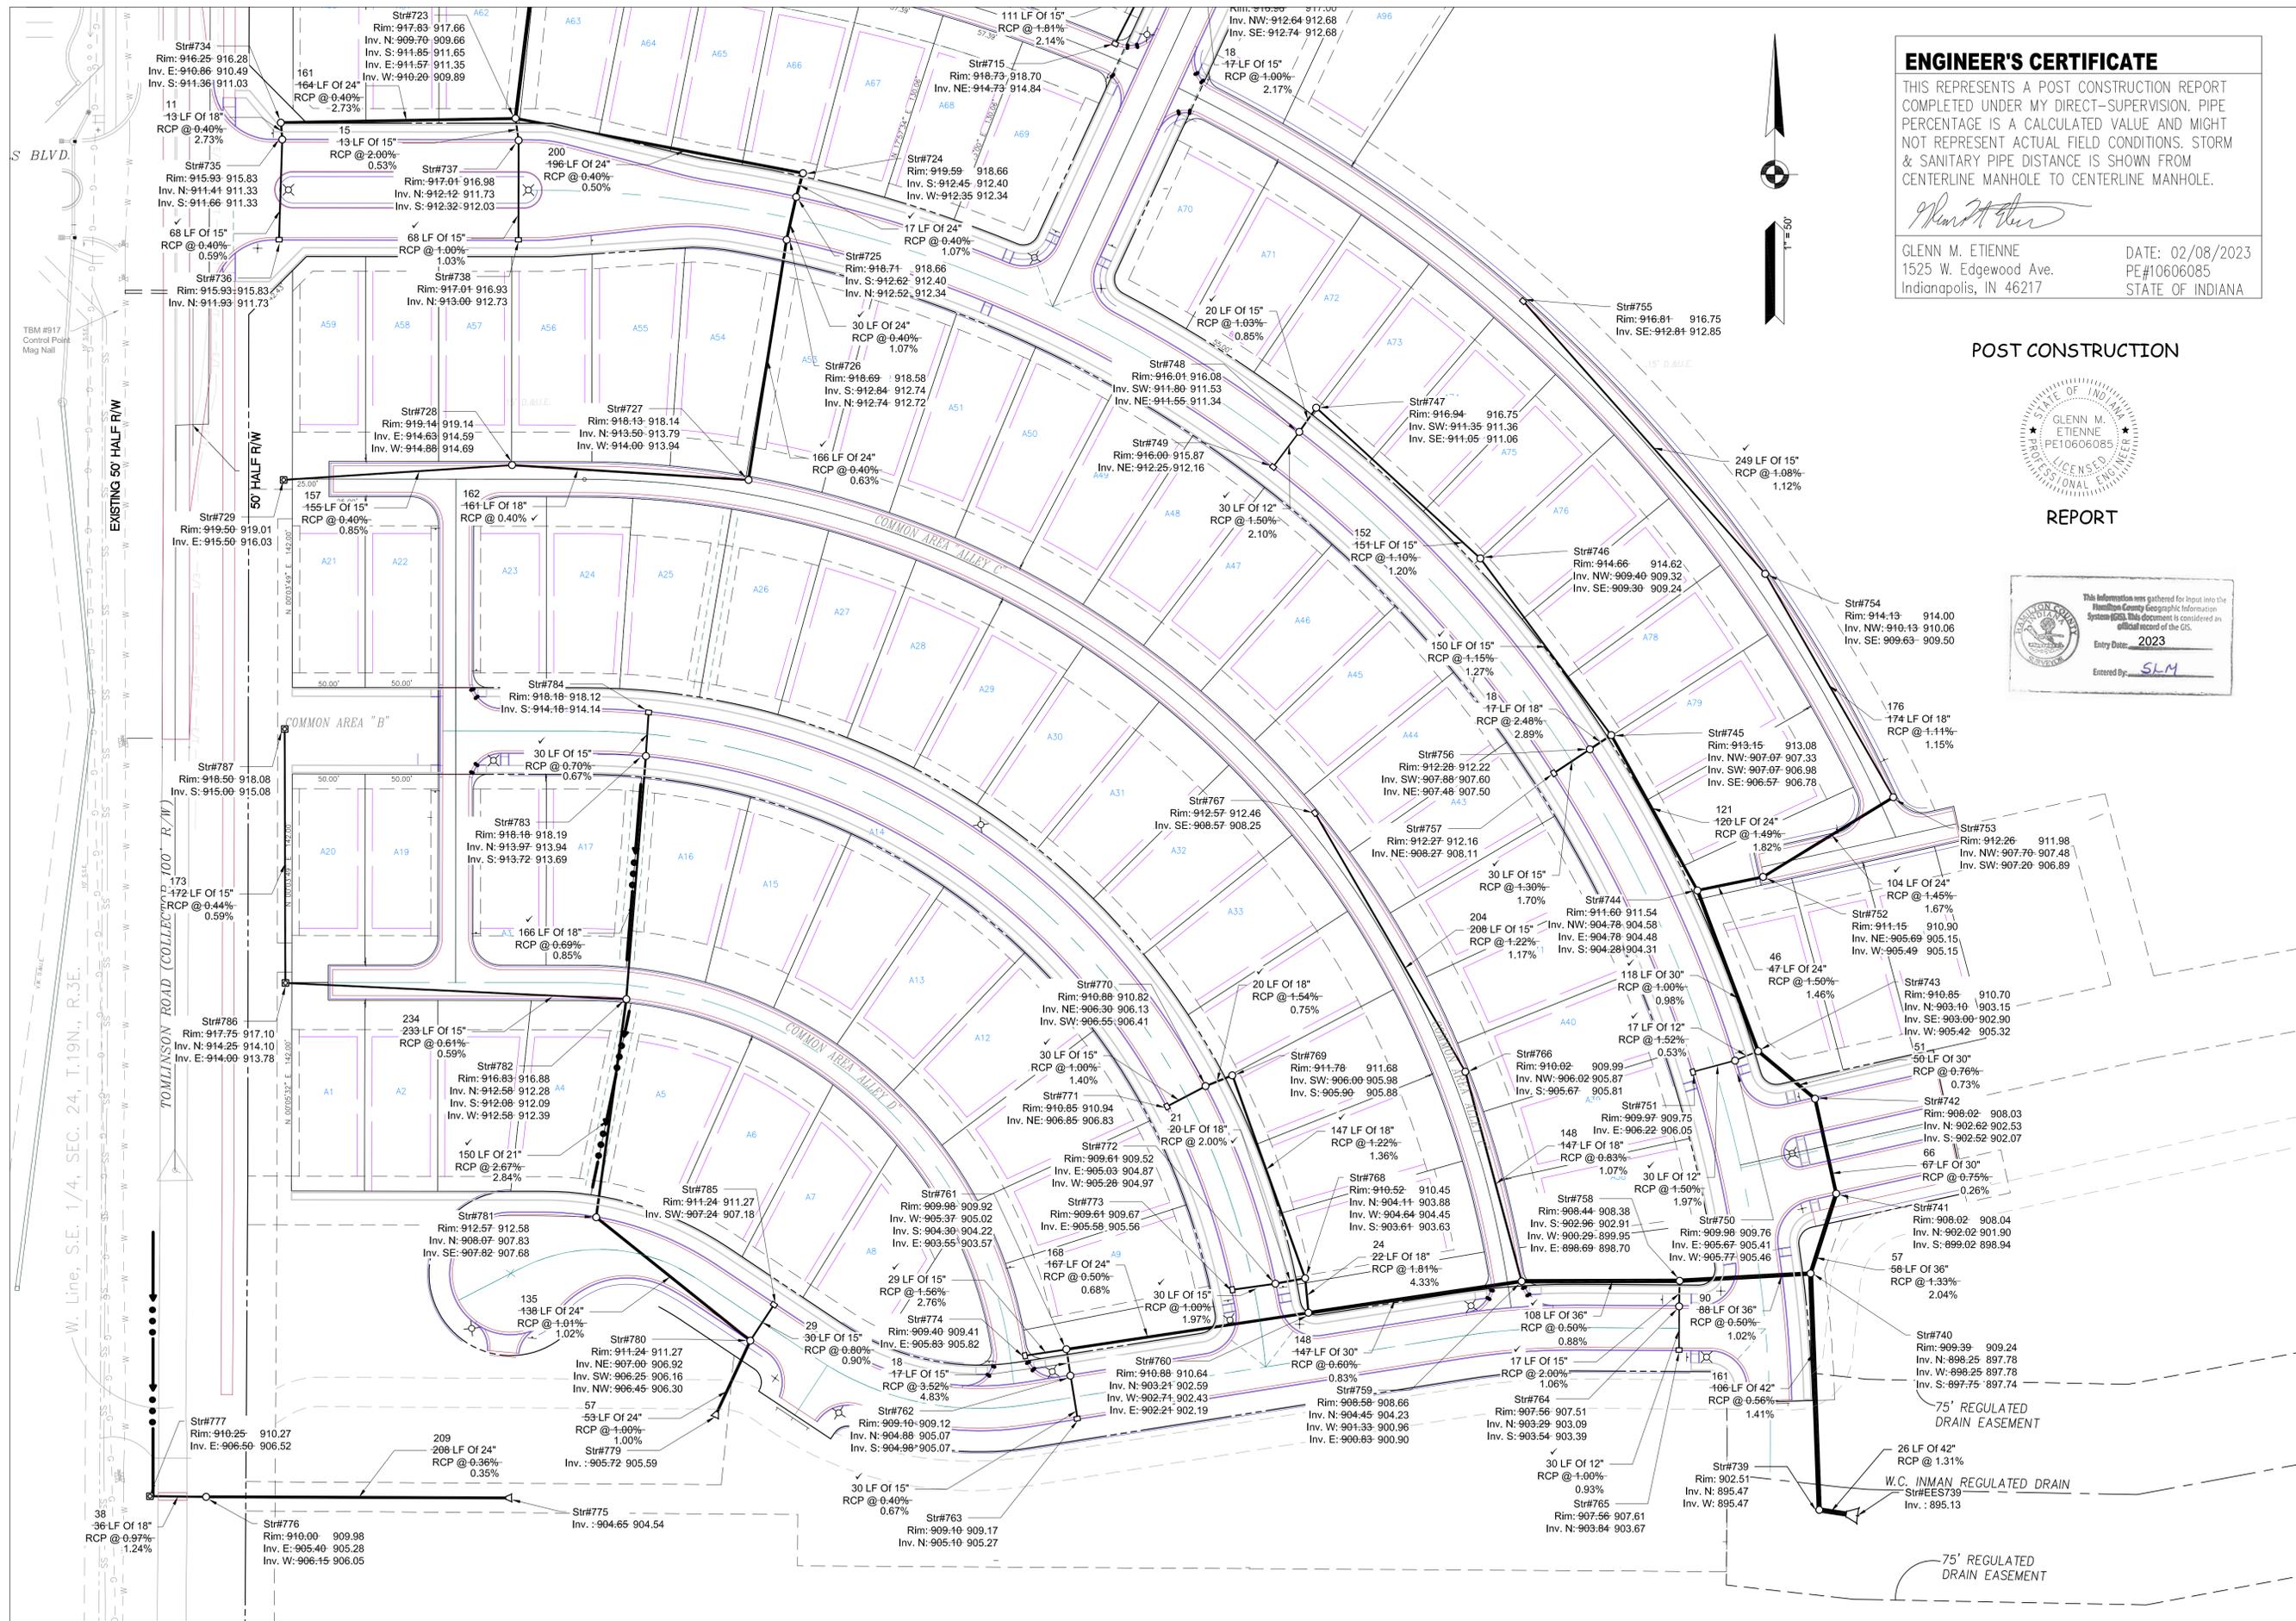

ENGINEER'S CERTIFICATE

THIS REPRESENTS A POST CONSTRUCTION REPORT COMPLETED UNDER MY DIRECT-SUPERVISION. PIPE PERCENTAGE IS A CALCULATED VALUE AND MIGHT NOT REPRESENT ACTUAL FIELD CONDITIONS. STORM & SANITARY PIPE DISTANCE IS SHOWN FROM CENTERLINE MANHOLE TO CENTERLINE MANHOLE.

Glenn M. Etienne


GLENN M. ETIENNE
1525 W. Edgewood Ave.
Indianapolis, IN 46217

DATE: 02/08/2023
PE#10606085
STATE OF INDIANA

POST CONSTRUCTION



REPORT

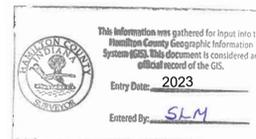

PAGE 1 OF 2
Job # 21-0079


Drawn: BMF
Check: GME
Date: 02/08/2023
Scale: 1" = 50'

Prepared for:
GRADEX, LLC.
10220 N. ILLINOIS ST
CARMEL, IN 46290

CHATHAM VILLAGES - SECTION 1
WESTFIELD, IN 46074

STORM POST CONSTRUCTION REPORT

Prepared by:
CES, LLC.
1525 W. Edgewood Ave
Indianapolis, IN 46217

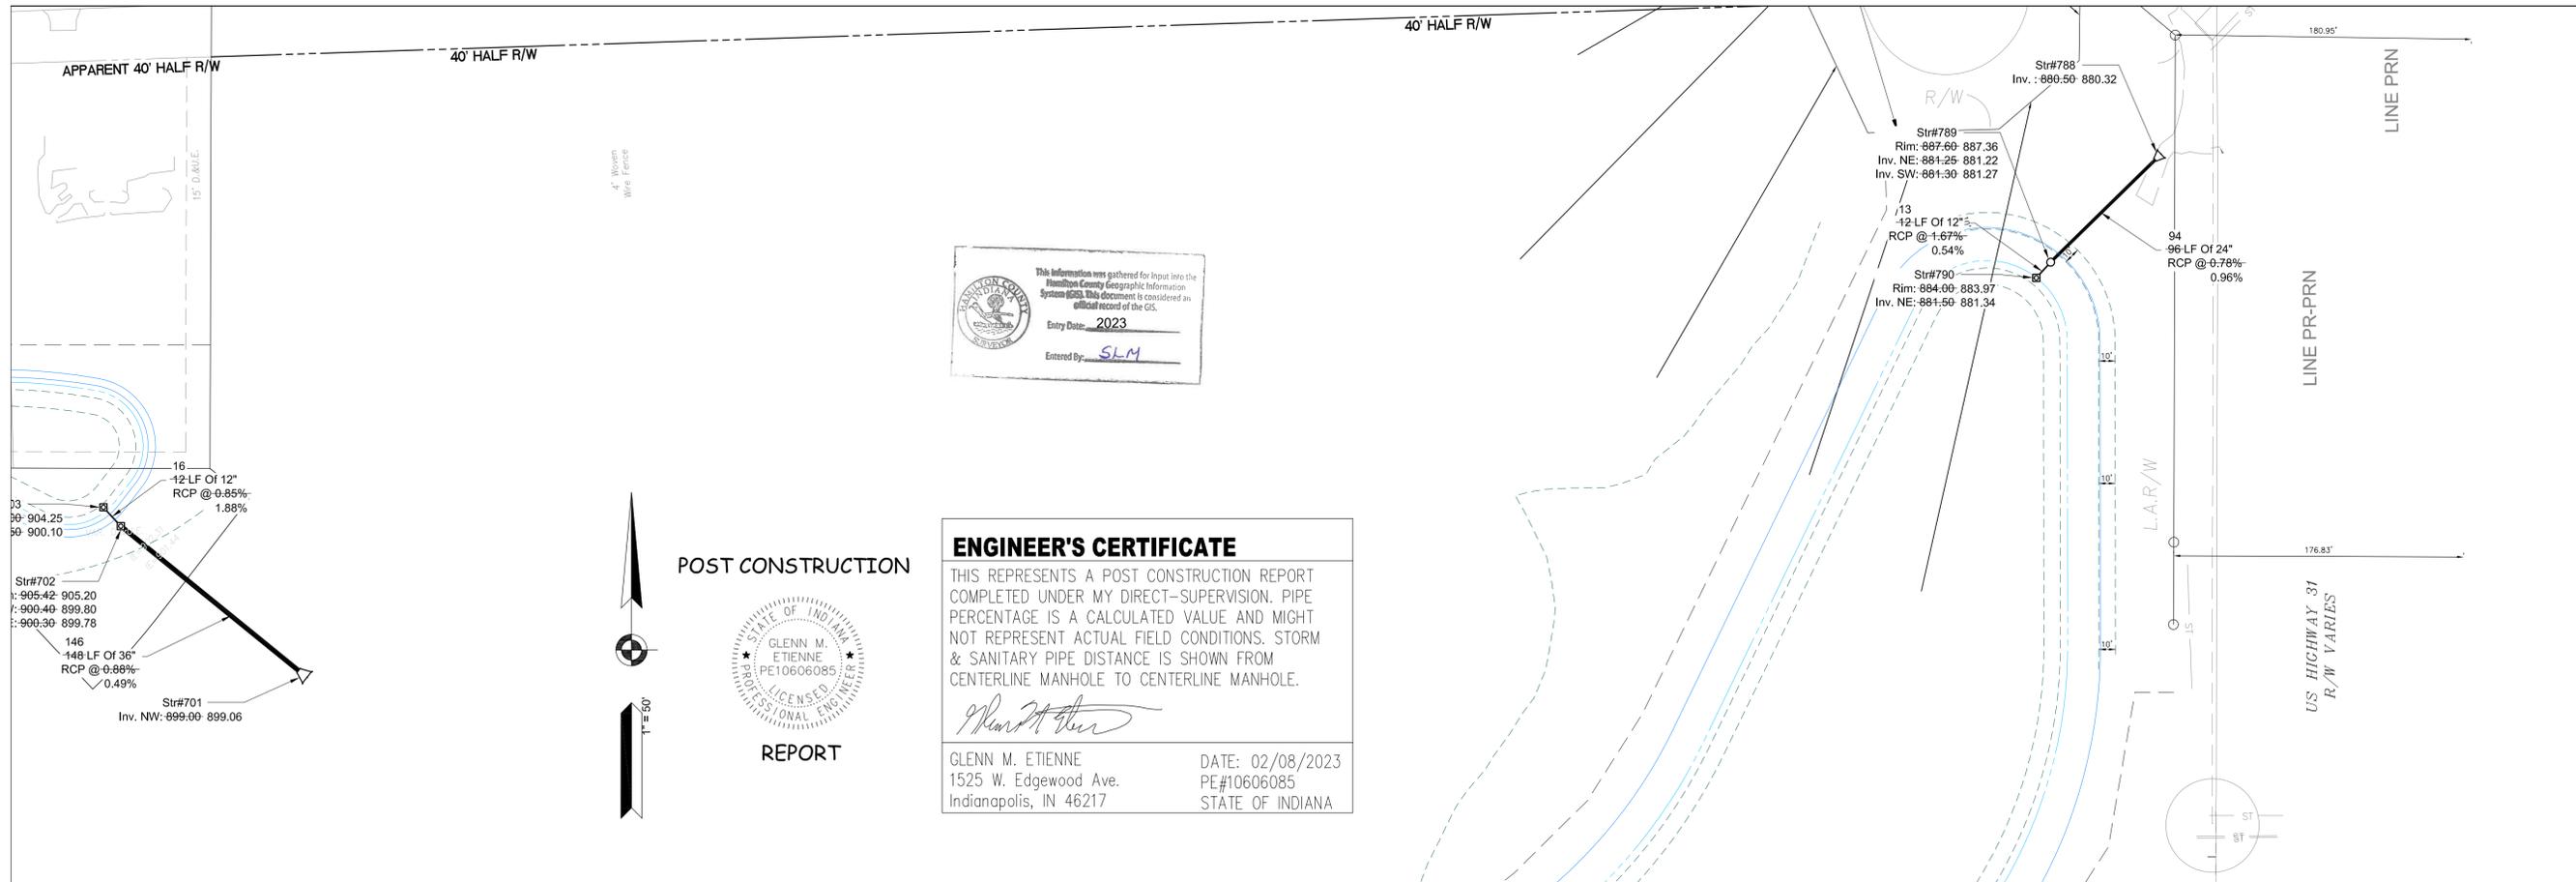

This information was gathered for input into the Hamilton County Geographic Information System (GIS). This document is considered an official record of the GIS.
 Entry Date: 2023
 Entered By: SLM

POST CONSTRUCTION




ENGINEER'S CERTIFICATE
 THIS REPRESENTS A POST CONSTRUCTION REPORT COMPLETED UNDER MY DIRECT-SUPERVISION. PIPE PERCENTAGE IS A CALCULATED VALUE AND MIGHT NOT REPRESENT ACTUAL FIELD CONDITIONS. STORM & SANITARY PIPE DISTANCE IS SHOWN FROM CENTERLINE MANHOLE TO CENTERLINE MANHOLE.
 Glenn M. Etienne
 1525 W. Edgewood Ave.
 Indianapolis, IN 46217
 DATE: 02/08/2023
 PE#10606085
 STATE OF INDIANA

REPORT

Drawn: BMF
 Check: GME
 Date: 02/08/2023
 Scale: 1" = 50'

Prepared for:
 GRADEX INC.
 10220 N. ILLINOIS ST
 CARMEL, IN 46290

CHATHAM VILLAGES - SECTION 1
 WESTFIELD, IN 46074
 STORM POST CONSTRUCTION REPORT

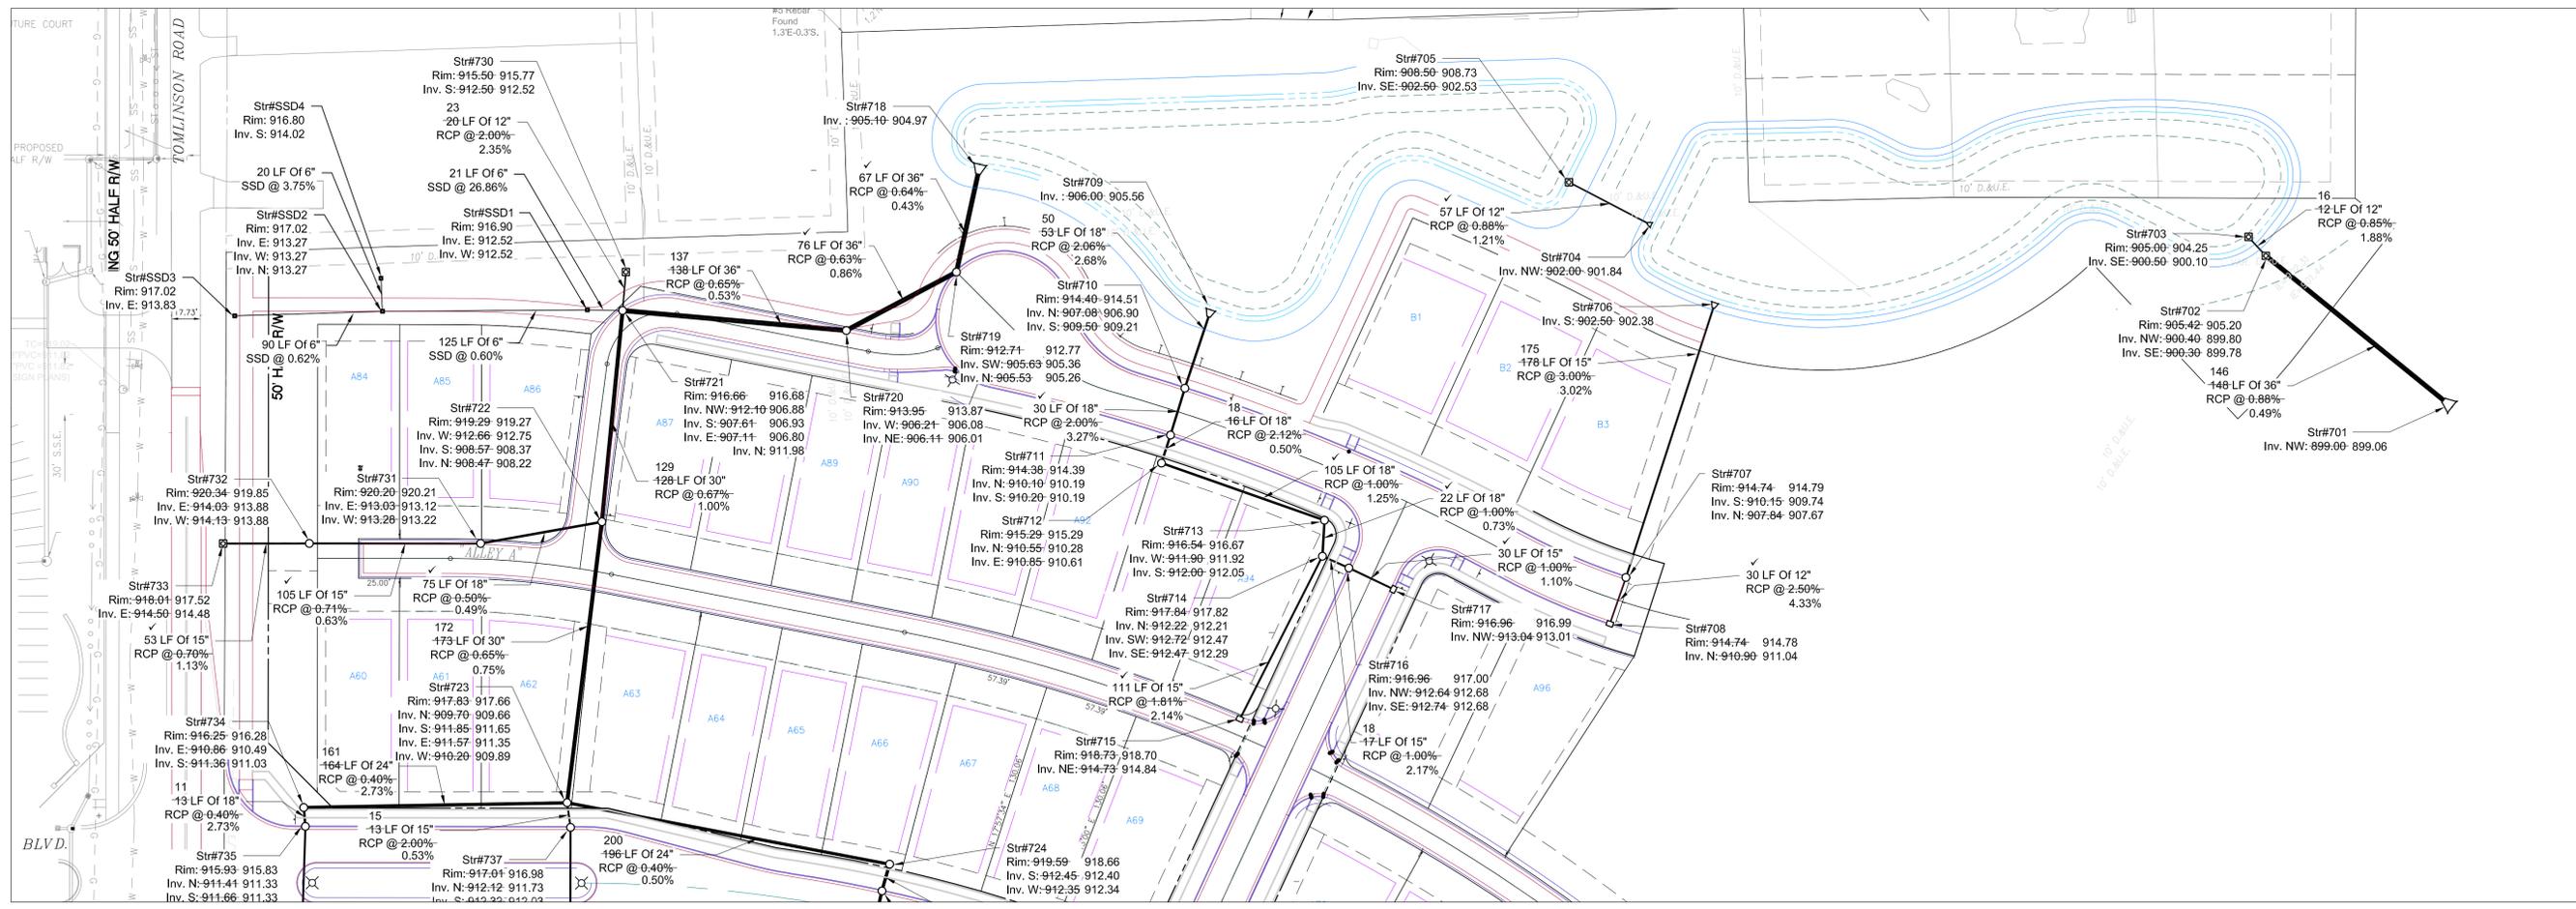

Revision	Date	Number	Description

Prepared by:
 CES, LLC
 1525 W. Edgewood Ave
 Indianapolis, IN 46217