

Kenton C. Ward, CFM
Surveyor of Hamilton County
Phone (317) 776-8495
Fax (317) 776-9628

Suite 188
One Hamilton County Square
Noblesville, Indiana 46060-2230

Map Correction-Field Verification

Drain Number: 210

Drain Length: N/A

Drain Name: Clara Knotts

Change +/-: N/A

Date: 2-28-2011


New Length: N/A

Verified By: (SLM)(JLL)

Notes & Sketch:

STR # 3 was placed upon the existing Clara Knotts - Meridian Corp. Plaza arm, also existing structure #04 was changed from an inlet to a solid manhole. New structure #3 is an inlet. This was done as a part of the Methodist Medical Plaza Parking Lot Expansion. Plans were done by American structure point - with job no IN.2005.0482.


Suzanne L. Mills
GIS Specialist

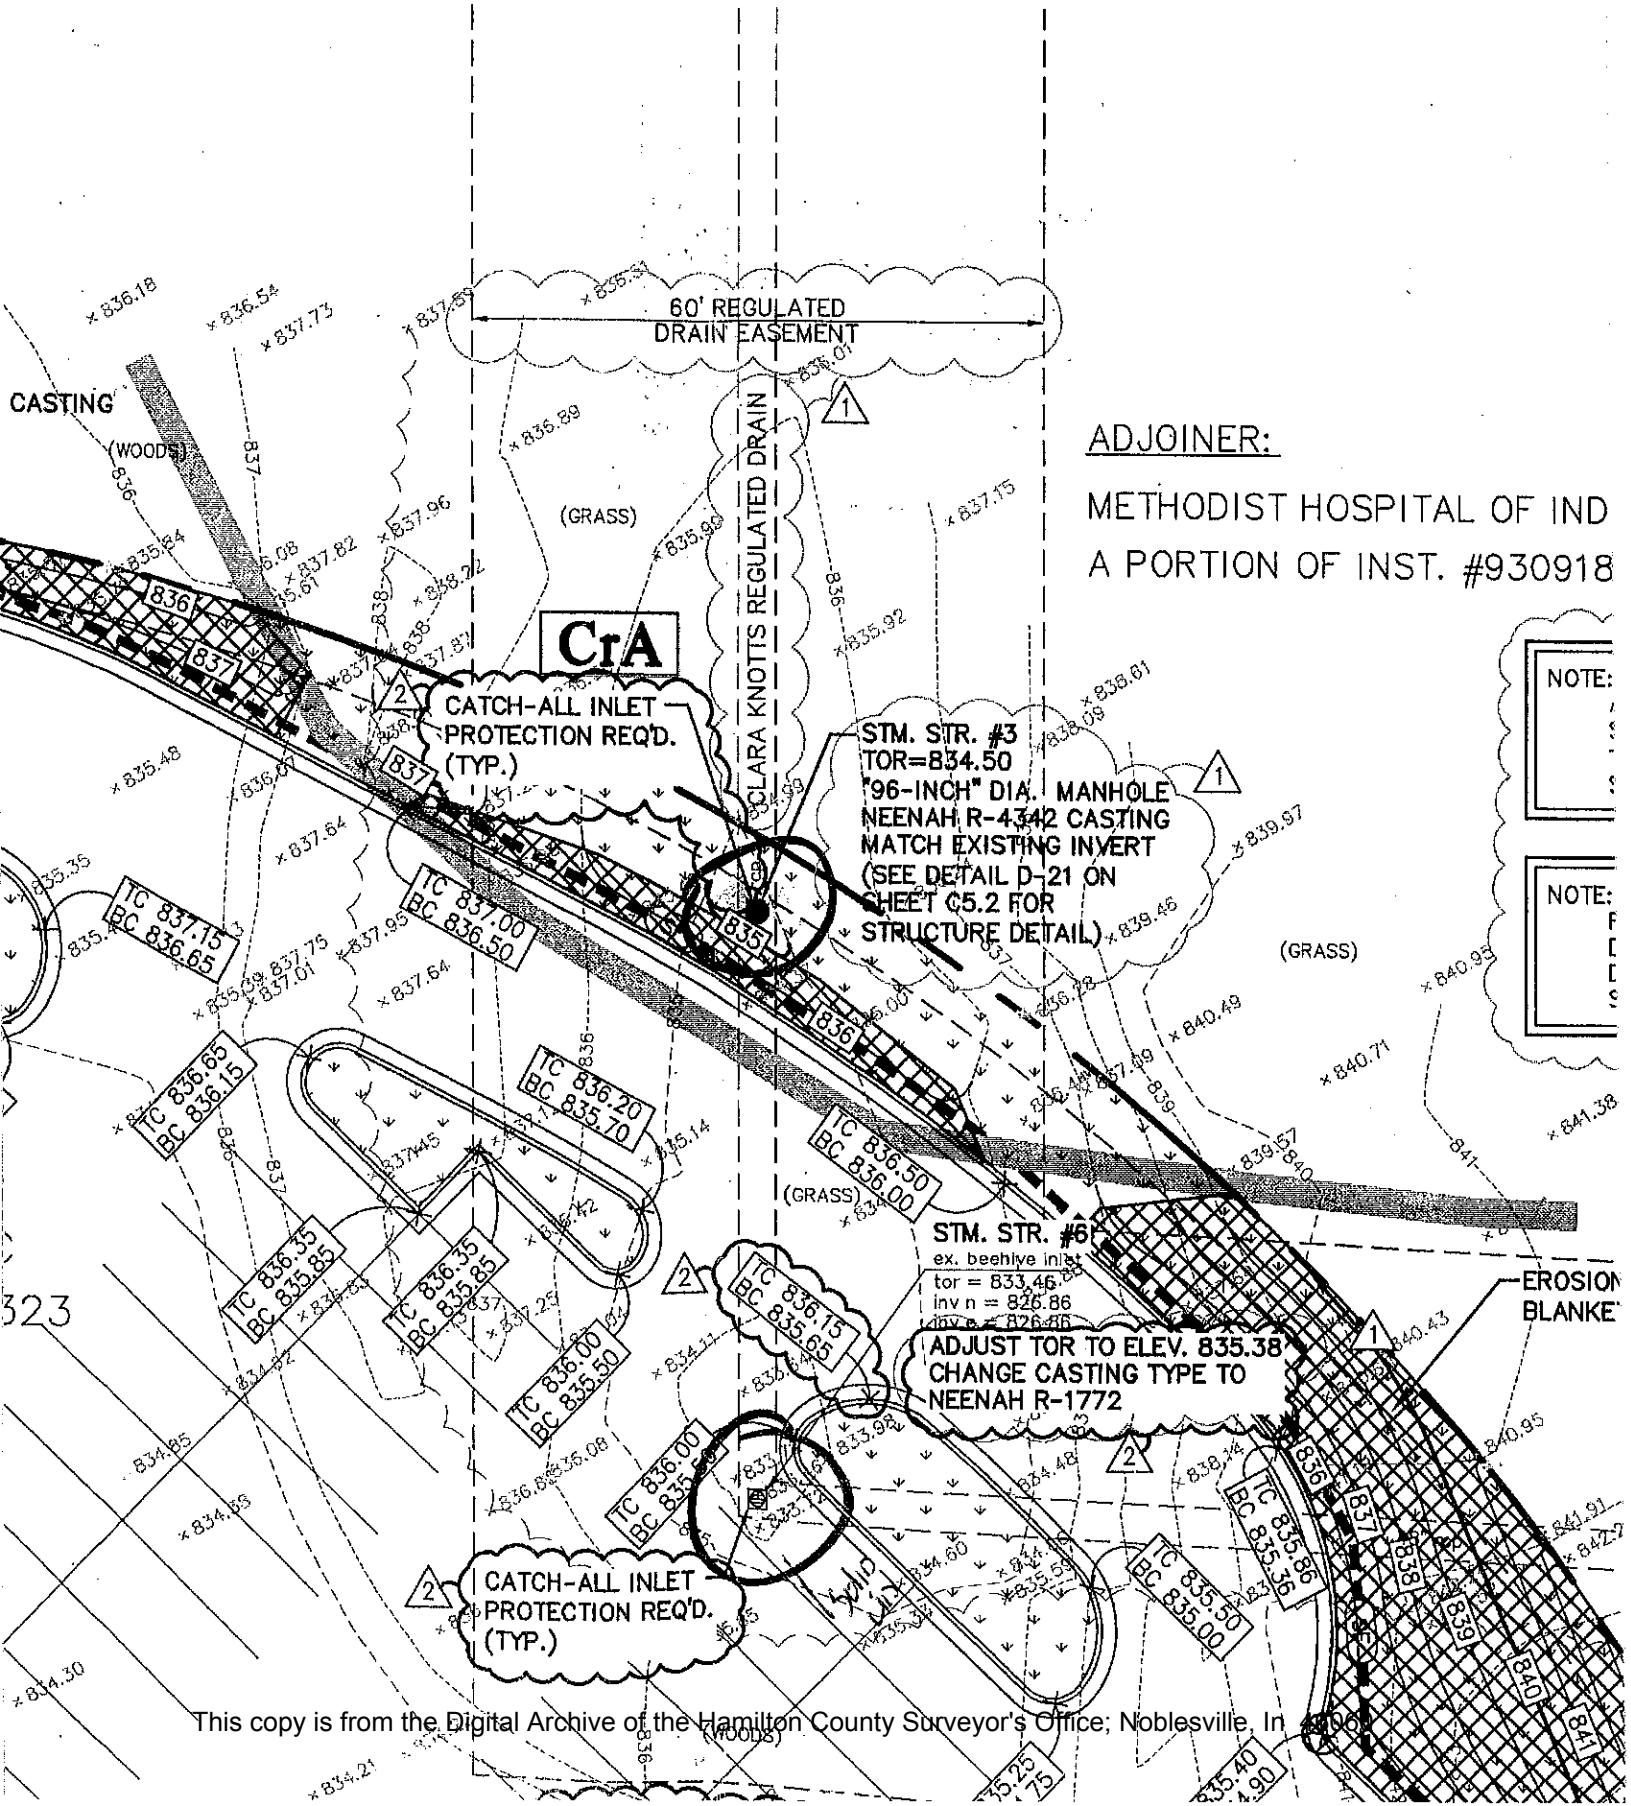

ADJOINER:
 METHODIST HOSPITAL OF IND
 A PORTION OF INST. #930918

NOTE:
 NOTE: