

Kenton C. Ward, CFM
Surveyor of Hamilton County
Phone (317) 776-8495
Fax (317) 776-9628

Suite 188
One Hamilton County Square
Noblesville, Indiana 46060-2230

Map Correction-Field Verification

Drain Number: # 3

Drain Length: N/A

Drain Name: William Lehr

Change +/-: N/A


Date: 2-25-2011


New Length: N/A

Verified By: JLL & SLM

Notes & Sketch:

The city of Noblesville installed a structure on the William Lehr drain. This was done at approximately station 0+57. This was done as a part of the roundabout installed at 141st St. and Maribyn Rd. ^{Inlet}

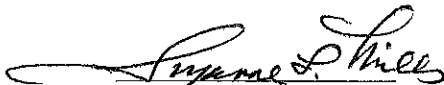
Suzanne L. Mills
GIS Specialist

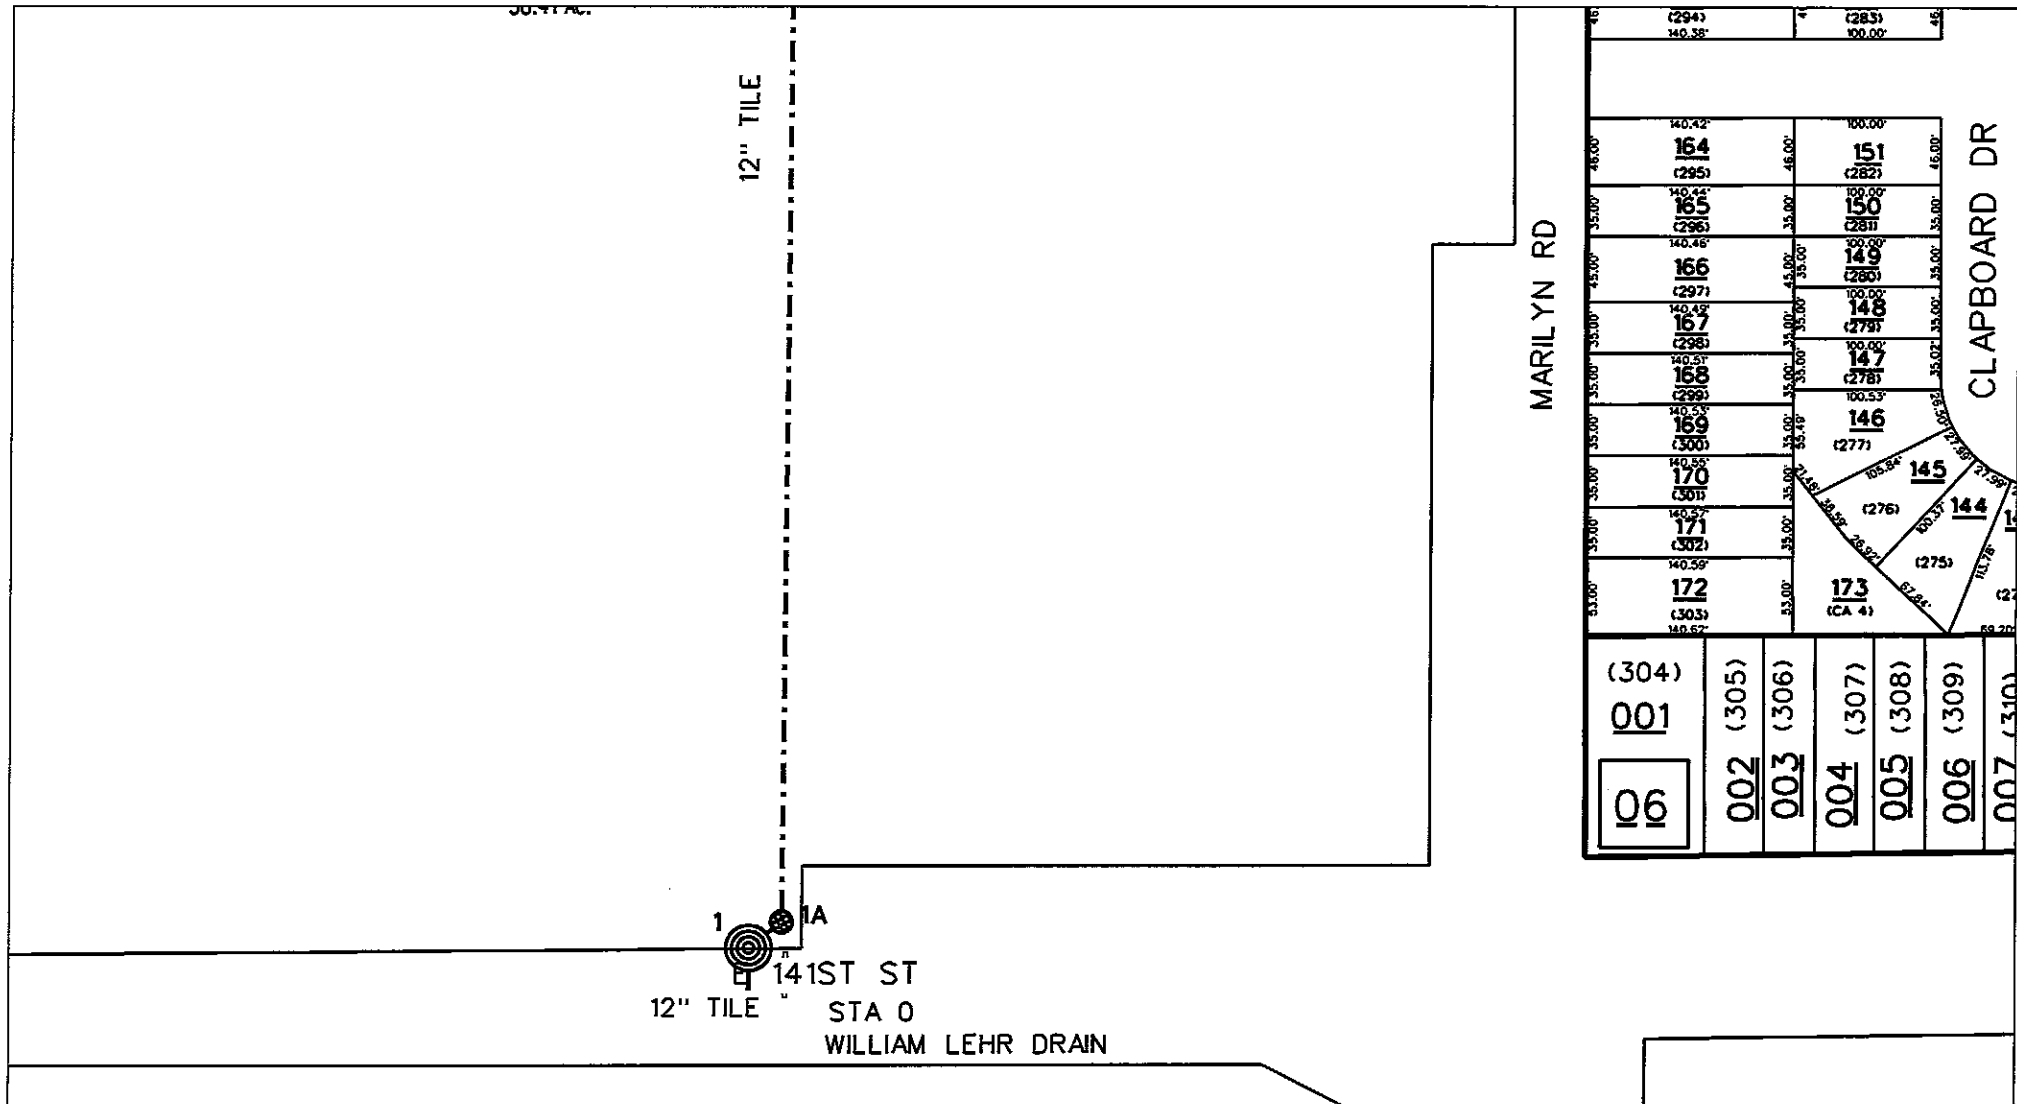

reg_drain_hc.dgn 2/24/2011 3:28:38 PM