



July 1, 2015

Kenton C. Ward, CFM Surveyor of Hamilton County Thone (317) 776-8495 Fax (317) 776-9628 Suite 188 One Hamilton County Square Noblesville, Indiana 46060-2230

To: Hamilton County Drainage Board

Re: Little Eagle Creek Drain, Grannan Grove Arm

Attached is a petition filed by Grannan Grove Development, LLC, along with a non-enforcement request, plans, calculations, quantity summary and assessment roll for Grannan Grove Arm, Little Eagle Creek Drain to be located in Clay Township. I have reviewed the submittals and petition and have found each to be in proper form.

I have made a personal inspection of the land described in the petition. Upon doing so, I believe that the drain is practicable, will improve the public health, benefit a public highway, and be of public utility and that the costs, damages and expenses of the proposed drain will probably be less than the benefits accruing to the owners of land likely to be benefited. The drain will consist of the following:

12" RCP	619 ft.	21" RCP	283 ft.
15" RCP	263 ft.	Open Ditch	122 ft.
18" RCP	703 ft.	6" SSD	3,532 ft.

The total length of the drain will be 5,522 feet.

The open ditch listed above will be the drain path between Str. 524 to 522, Str. 520 to Str. 513A, and Str. 500 to the west property line of parcel 17-09-19-00-026.000, owned by H. Richard & Roxysann Durbin.

The retention pond (lake), bio-swale, and wetland Enhancement Area, all located in Common Area #4 is not to be considered part of the regulated drain. Pond maintenance assumed by the Drainage Board shall only include the inlets and outlet as part of the regulated drain. The maintenance of the retention pond (lake) and bio-swale such as sediment removal and erosion control along the banks, mowing and aquatic vegetation maintenance and control will be the responsibility of the Homeowners Association The Board will also retain jurisdiction for ensuring the storage volume for which the pond was designed will be retained. Thereby, allowing no fill or easement encroachments.

The subsurface drains (SSD) to be part of the regulated drain are those located under the curbs and those main lines in rear yards. Only the main SSD lines as described below, which are located within the easement or right of way are to be maintained as regulated drain. Laterals for individual lots will not be considered part of the regulated drain. The portions of the SSD which will be regulated and maintained are as follows:

Curbline SSD in Streets: Grannan Lane Aldrew Place 141st Street Rear Yard SSDs:
Rear yard lot 1 from Str. 514 to riser
Rear yard lots 2 & 3 from Str. 514 to Str. 515
Rear yard lots 4 & 5 from Str. 515 to Str. 519
Rear/side yard lots 6 & 7 from Str. 519 to riser

Rear yard lots 8 & 9 from Str. 513 to riser
Rear yard lots 10 to 12 from Str. 513 to Str. 518

Rear yard lots 13 & 14 from Str. 518 to riser

I have reviewed the plans and believe the drain will benefit each lot equally. Therefore, I recommend each lot be assessed equally. I also believe that no damages will result to landowners by the construction of this drain. I recommend a maintenance assessment of \$65.00 per lot, \$10.00 per acre for common areas, with \$65.00 minimum, and \$10.00 per acre for roadways. With this assessment the total annual assessment for this drain will be \$1,212.30. Parcel 17-09-19-00-00-026.000 will not be assessed at this time.

The petitioner has submitted surety for the proposed drain at this time. The sureties which are in the form of a Subdivision Performance Bond from contractor and cash bond from developer are as follows:

Agent: The Guarantee Company of North America USA

Date: June 2, 2015 Number: 20115507

For: Storm Sewers & Sub-Surface Drains

Amount: \$206,143.00

I believe this proposed drain meets the requirements for Urban Drain Classification as set out in IC 36-9-27-67 to 69. Therefore, this drain shall be designated as an Urban Drain.

The offsite easement for this subdivision outlet will be the easement recorded as instrument number 2015000268 in the office of the Hamilton County Recorder. This easement is on parcel 17-09-19-00-026.000, owned by H. Richard & Roxysann Durbin.

I recommend that upon approval of the above proposed drain that the Board also approve the attached non-enforcement request. The request will be for the reduction of the regulated drain easement to those easement widths as shown on the secondary plat for Grannan Grove as recorded in the office of the Hamilton County Recorder.

I recommend the Board set a hearing for this proposed drain for August 24, 2015.

Kenton C. Ward, CFM Hamilton County Surveyor

KCW/pll

(Revised 06/08/04)

STATE OF INDIANA)
COUNTY OF HAMILTON)

FILED
JAN 2 0 2015

TO: HAMILTON COUNTY DRAINAGE BOARD

% Hamilton County Surveyor
One Hamilton County Square, Suite 188
Noblesville, IN. 46060-2230

OFFICE OF HAMILTON COUNTY SURVEYOR

In the matter of	Grannan Grove	Subdivision, Section
	Drain Petition.	

Petitioner is the owner of all lots in the land affected by the proposed new regulated drain. The drainage will affect various lots in ______ Grannan Grove ______, a subdivision in Hamilton County, Indiana. The general route of such drainage shall be in existing easements and along public roads as shown in the plans on file in the Surveyor's Office.

Petitioner believes that the cost, damages and expenses of the proposed improvement will be less than the benefits which will result to the owners of the land likely to be benefited thereby. Petitioner believes the proposed improvements will:

- (a) improve public health
- (b) benefit a public street
- (c) be of public utility

Petitioner agrees to pay the cost of construction of the drainage system and requests periodic maintenance assessments by the Board thereafter.

The Petitioner also agrees to the following:

- 1. To provide the Drainage Board a Performance Bond or Non-Revocable Letter of Credit for the portion of the drainage system which will be made a regulated drain. The bond will be in the amount of 120% of the Engineer's estimate. The bond will be in effect until construction of 100% of the system is completed and so certified by the Engineer.
- The Petitioner shall retain an Engineer throughout the construction phase.
 At completion of the project the Petitioner's Engineer shall certify that the drainage system which is to be maintained as a regulated drain has been constructed as per construction plans.
- 3. The Petitioner agrees to request in writing to the County Surveyor any changes from the approved plan and must receive written authorization from the County Surveyor prior to implementation of the change. All changes shall be documented and given to the Surveyor to be placed in the Drain file.
- 4. The Petitioner shall instruct his Engineer to provide a reproducible print on a 24" x 36" Mylar of the final design of the Drainage System. This shall be submitted to the County Surveyor prior to the release of the Performance Bond.
- 5. The Petitioner shall comply with the Erosion Control Plan as specified on the construction plans. Failure to comply with the Erosion Control Plan shall be determined by the Board as being an obstruction to the drainage system. The County Surveyor shall immediately install or repair the needed measures at Petitioners cost as per IC 36-9-27-46.

Adobe PDF Fillable Form

The Petitioner further requests that the Drain be classified as an Urban Drain as per IC 36-9-27-69(d).

RECORDED OWNER(S) OF LAND INVOLVED

Signed Water	Signed
Timothy J. Walter	
Printed Name	Printed Name
January 16, 2015	
Date	Date
Signed	Signed
Printed Name	Printed Name
Date	Date

Adobe PDF Fillable Form

FINDINGS AND ORDER

CONCERNING THE MAINTENANCE OF THE

Little Eagle Creek Drain, Grannan Grove Arm

On this 24^{th} day of August, 2015, the Hamilton County Drainage Board has held a hearing on the Maintenance Report and Schedule of Assessments of the Little Eagle Creek Drain, Grannan Grove Arm.

Evidence has been heard. Objections were presented and considered. The Board then adopted the original/amended Schedule of Assessments. The Board now finds that the annual maintenance assessment will be less than the benefits to the landowners and issues this order declaring that this Maintenance Fund be established.

HAMILTON COUNTY DRAINAGE BOARD

President

Member

Member al

Attest: Livele Mashaugh Executive Secretary **Grannan Grove**

Engineers Estimate - Storm Sewers & Monumentation

Prepared on: 5/6/2015

Item	Unit	ι	Jnit Cost	Quantities		Cost
Storm Drainage						
12" Pipe	LF	\$	33.89	624	\$	21,147
12" End Section	EA	\$	645.00	4	\$	2,580
12" Trash Guard	EA	\$	615.00	4	\$	2,460
15" Pipe	LF	\$	34.89	264	\$	9,211
18" Pipe	LF	\$	39.21	727	\$	28,506
18" End Section	EA	\$	726.50		\$	1,453
18" Trash Guard	EA	\$	670.00	2	\$	1,340
21" Pipe	LF	\$	47.21	288	\$	13,596
21" End Section	EA	\$	821.00	1	\$	821
21" Trash Guard	EA	\$	800.00	1	\$	800
Standard Storm Manholes	EA	\$	2,055.00	3	\$	6,165
Large Storm Manholes & Double Inlets	EA	\$	1,882.00	3	\$	5,646
Storm Inlets	EA	\$	2,203.33	7	\$	15,423
Sand Backfill and Bedding	TON	\$	21.80	440.00	\$	9,592
Sub-to	tal				\$	118,741
Sub-surface Drains - under curb	LF	\$	10.50	2,700	\$	28,350
Sub-surface Drains - swales	LF	\$	14.24	1,300	\$	18,512
Sub-surface Drains - sump laterals	EA	\$	244.50	14	\$	3,423
Sub-to	tal		B0/890/4880/4080/		\$	50,285
	tal				\$	169,026
Monuments & Markers						
Lot Corner Monuments	LOT	\$	100.00	14.00	\$	1,400
Street Centerline Monumentation	EA	\$	170.00	8.00	\$	1,360
	tal	•	170.00	0.00	\$	2,760
Erosion Control	LS		NA	NA	NA	
> Not Applicable - Property annexed by City		aover	3.55	INA	14/4	
by Carmel MS4 permit.	-:	30.3.				
10	tal				\$	-
Grand To	tal				\$	171,786
Per Hamilton County Ordinance - Bond Am				120%	\$	206,143
rer nammon County Ordinance - Bond Am	iount			12070	Ψ	200,143

BY:

Timothy J. Walter, P.E.

Indiana Registration No. 19900152

THE GUARANTEE COMPANY OF NORTH AMERICA USA

25800 Northwestern Highway. Suite 720 Southfield, Michigan 48075 Tel 248-281-0281 Fax 248-750-0431

SUBDIVISION PERFORMANCE BOND

03-2015-0030

KNOW ALL MEN BY THESE PRESENTS, THAT WE JDH Contracting, Inc. located at 8109 Network Drive, Plainfield, IN 46168 as Principal, and The Guarantee Company of North America USA, 1 Towne Square, Ste 1470, Southfield, MI 48076 a Michigan Corporation, as Surety are held and firmly bound unto Hamilton County Board of Commissioners, One Hamilton County Square, Noblesville, IN 46060 as Obligee in the penal sum of Two Hundred Six Thousand, One Hundred Forty Three and 00/100 Dollars (\$206,143.00), lawful money of the United States of America for the payment of which well and truly to be made, we bind ourselves, our heirs, executors, administrators, successors and assigns, jointly and severally, firmly by these presents

WHEREAS, JDH Contracting, Inc. has agreed to construct in Grannan Grove the following improvements:

Storm Sewers & Monumentation

NOW, THEREFORE, THE CONDITION OF THIS OBLIGATION IS SUCH, that if the said Principal shall construct, or have constructed the improvements herein described, and shall save the Obligee harmless from any loss, cost or damage by reason of its failure to complete said work, then this obligation shall be null and void, otherwise to remain in full force and effect, and the Surety, upon receipt of a resolution of the Obligee indicating that the improvements have not been installed or completed, will complete the improvements or pay to the Obligee such amount up to the Principal amount of this bond which will allow the Obligee to complete the improvements.

Upon approval by the Obligee, this instrument may be proportionately reduced as the public improvements are completed.

Signed, sealed and dated this 2nd day of June, 2015.

June

STATE OF INDIANA

2nd day of

County of Marion

On this

in and for the County of Marion, duly commissioned and qualified, came Keith Corder, Attorney-In-Fact of The Guarantee Company of North America USA, to me personally known to be the individual described in, and who executed the preceding and foregoing instrument, and acknowledged the execution of the same, and being by me duly sworn, deposed and says that he/she is the said Attorney-In-Fact for the Company aforesaid, and that the scall Robin L volume affixed to the foregoing instrument is the corporate seal of said Company and that said corporate seal and his/her signature were duly affixed and subscribed to the said instrument by the authority and direction of the said
In Witness Whereof, I have hereunto set my hand affixed my official seal this day and year first above written.
Commission Expires: 06-10-21 Robin L. Young Notable Public Robin L. Young



The Guarantee Company of North America USA

Southfield, Michigan

POWER OF ATTORNEY

KNOW ALL BY THESE PRESENTS: That THE GUARANTEE COMPANY OF NORTH AMERICA USA, a corporation organized and existing under the laws of the State of Michigan, having its principal office in Southfield, Michigan, does hereby constitute and appoint

> Keith Corder, Daniel C. Appel, Kathleen T. DeVito, Robin Young Gregory & Appel, Inc.

its true and lawful attorney(s)-in-fact to execute, seal and deliver for and on its behalf as surety, any and all bonds and undertakings, contracts of indemnity and other writings obligatory in the nature thereof, which are or may be allowed, required or permitted by law, statute, rule, regulation, contract or otherwise.

The execution of such instrument(s) in pursuance of these presents, shall be as binding upon THE GUARANTEE COMPANY OF NORTH AMERICA USA as fully and amply, to all intents and purposes, as if the same had been duly executed and acknowledged by its regularly elected officers at the principal office.

The Power of Attorney is executed and may be certified so, and may be revoked, pursuant to and by authority of Article IX, Section 9.03 of the By-Laws adopted by the Board of Directors of THE GUARANTEE COMPANY OF NORTH AMERICA USA at a meeting held on the 31st day of December, 2003. The President, or any Vice President, acting with any Secretary or Assistant Secretary, shall have power and authority:

To appoint Attorney(s)-in-fact, and to authorize them to execute on behalf of the Company, and attach the Seal of the Company thereto, 1. bonds and undertakings, contracts of Indemnity and other writings obligatory in the nature thereof; and

2. To revoke, at any time, any such Attorney-in-fact and revoke the authority given, except as provided below

In connection with obligations in favor of the Florida Department of Transportation only, it is agreed that the power and authority hereby given to the Attorney-in-Fact includes any and all consents for the release of retained percentages and/or final estimates on engineering and construction contracts required by the State of Florida Department of Transportation. It is fully understood that consenting to the State of Florida Department of Transportation making payment of the final estimate to the Contractor and/or its assignee, shall not relieve this surety company of any of its obligations under its bond.

In connection with obligations in favor of the Kentucky Department of Highways only, it is agreed that the power and authority hereby given to the Attorney-In-Fact cannot be modified or revoked unless prior written personal notice of such intent has been given to the Commissioner – Department of Highways of the Commonwealth of Kentucky at least thirty (30) days prior to the modification or revocation.

Further, this Power of Attorney is signed and sealed by facsimile pursuant to resolution of the Board of Directors of the Company adopted at a meeting duly called and held on the 6th day of December 2011, of which the following is a true excerpt:

RESOLVED that the signature of any authorized officer and the seal of the Company may be affixed by facsimile to any Power of Attorney or certification thereof authorizing the execution and delivery of any bond, undertaking, contracts of indemnity and other writings obligatory in the nature thereof, and such signature and seal when so used shall have the same force and effect as though manually affixed.



IN WITNESS WHEREOF, THE GUARANTEE COMPANY OF NORTH AMERICA USA has caused this instrument to be signed and its corporate seal to be affixed by its authorized officer, this 23rd day of February, 2012.

THE GUARANTEE COMPANY OF NORTH AMERICA USA

STATE OF MICHIGAN **County of Oakland**

Stephen C. Ruschak, President & COO

Mily Clevelat

Randall Musselman, Secretary

On this 23rd day of February, 2012 before me came the individuals who executed the preceding instrument, to me personally known, and being by me duly swom, said that each is the herein described and authorized officer of The Guarantee Company of North America USA; that the seal affixed to said instrument is the Corporate Seal of said Company; that the Corporate Seal and each signature were duly affixed by order of the Board of Directors of

Cynthia A. Takai Notary Public, State of Michigan County of Oakland My Commission Expires February 27, 2018 Acting In Oakland County

IN WITNESS WHEREOF, I have hereunto set my hand at The Guarantee Company of North America USA offices the day and year above written.

Cynthia a. Takai

I. Randall Musselman, Secretary of THE GUARANTEE COMPANY OF NORTH AMERICA USA, do hereby certify that the above and foregoing is a true and correct copy of a Power of Attorney executed by THE GUARANTEE COMPANY OF NORTH AMERICA USA, which is still in full force and effect.

IN WITNESS WHEREOF, I have thereunto set my hand and attached the seal of said Company this 2nd day of

June ,2015

Randall Musselman, Secretary

OFFICE OF HAMILTON COUNTY SURVEYOR

ESCROW AGREEMENT

This Escrow Agreement entered into by and between Grannan Grove Developer, LLC ("the Developer"), as the Developer of a subdivision named Grannan Grove ("the Subdivision"), located on south side of 141st Street and west of Shelbome Road, and the Board of Commissioners of Hamilton County, acting on behalf of the Hamilton County Drainage Board ("the Drainage Board").

WHEREAS, the Developer is constructing storm sewers, street/rear yard underdrains, and monuments & markers ("the Project") for the Subdivision; and,

WHEREAS, JDH Contracting, Inc. (the "Contractor") has posted a Performance Bond for the construction of the Project, and,

WHEREAS, the Developer has agreed to post cash in the amount of Thirteen Thousand Nine Hundred Twenty-two Dollars (\$13,922) in lieu of a Performance Bond for the Project, which represents approximately eight percent (8%) of the estimated cost of the project and,

WHEREAS, the Hamilton County Drainage Board is desirous of the Developer completing the Project as quickly as possible.

IT IS THEREBY AGREED by and between the parties as follows:

- 1. The Drainage Board ratifies the plans and specifications for the construction of the Project.
- The Drainage Board agrees to accept the Thirteen Thousand Nine Hundred Twenty-two Dollars (\$13,922) in cash from the Developer in lieu of performance bond for the construction of the Project.
- 3. The Developer acknowledges that no residential Improvement location permits will be applied for construction with the Subdivision until the construction of the Project has been completed, inspected, accepted, and delivery of final as-built drawings to the Drainage Board, at which time the cash posted under this Escrow Agreement will be paid to the Developer.
- 4. In the event the Developer falls to complete the Project pursuant to the approved plans within two hundred ten (210) days of the approval of this Escrow Agreement by the Drainage Board, the surety may be forfeited and the Drainage Board may also file suit against the

Developer to recover the Drainage Boards' cost of completing the Project, plus reasonable attorney's fees.

ALL OF WHICH IS AGREED by and between the parties on the date set out herein.

DATED: 06-23-15	Grannan Grove Developer, LLC By:				
	Printed: STEVEN R. EAWARAS				
	TILLO: VICE PRESIDENT - CHIEF FINANCIAL OFFICE				
ALL OF WHICH IS AGREED BY THE Board	of Commissioners of Hamilton County, acting on behalf of the				
Hamilton County Drainage Board this	_ day of, 2015.				
	BOARD OF COMMISSIONERS OF HAMILTON COUNTY ON BEHALF OF THE HAMILTON COUNTY DRAINAGE BOARD				
	Christine Altman				
	Mark Heirbrandt				
ATTEST:	Steven C. Dillinger				
DawnCoverdale, Auditor	•				
I affirm, under the penalties of perjury, that I have taken reasonable care to redact each soda I security number in the document, unless required by law. Michael A, Howard					

This copy printed from Digital Archive of the Hamilton County Surveyor's Office; One Hamilton Co. Square, Ste., Noblesville, In 46060

This instrument prepared by Michael A. Howard, Attorney at Law, 694 Logan Street, Noblesville, Indiana 46060, 773-4212.

BEFORE THE HAMILTON COUNTY DRAINAGE BOARD IN THE MATTER OF

Little Eagle Creek Drain, Grannan Grove Arm

NOTICE

То	Whom	It	May	Concern	and:	

Notice is hereby given of the hearing of the Hamilton County Drainage Board on the Little Eagle Creek Drain, Grannan Grove Arm on August 24, 2015 at 9:05 A.M. in Commissioners Court, Hamilton County Judicial Center, One Hamilton County Square, Noblesville, Indiana, and which construction and maintenance reports of the Surveyor and the Schedule of Assessments made by the Drainage Board have been filed and are available for public inspection in the office of the Hamilton County Surveyor.

Hamilton County Drainage Board

Attest: Lynette Mosbaugh

ONE TIME ONLY

BEFORE THE HAMILTON COUNTY DRAINAGE BOARD IN THE MATTER OF THE

Little Eagle Creek Drain, Grannan Grove Arm

NOTICE


Notice is hereby given pursuant to Section 405 of the 1965 Indiana Drainage Code that this Board, prior to final adjournment on August 24, 2015 has issued an order adopting the Schedule of Assessments, filed the same and made public announcement thereof at the hearing and ordered publication. If judicial review of the findings and order of the Board is not requested pursuant to Article Eight of this code within twenty (20) days from the date of this publication, the order shall be conclusive.

Hamilton County Drainage Board

Attest: Lynette Mosbaugh

ONE TIME ONLY



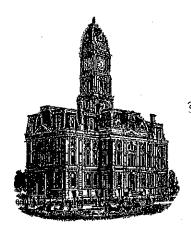



Kenton C. Ward, CFM Surveyor of Hamilton County Phone (317) 776-8495 Fax (317) 776-9628 Sutte 188 One Hamilton County Square Noblesville, Indiana 46060-2230

To: Hamilton County Drainage Board

August 15, 2016

Re: Little Eagle Creek: Grannan Grove

Attached are as-built, certificate of completion & compliance, and other information for Grannan Grove. An inspection of the drainage facilities for this section has been made and the facilities were found to be complete and acceptable.

During construction, changes were made to the drain, which will alter the plans submitted with my report for this drain-dated _. The report was approved by the Board at the hearing held August 24, 2015. (See Drainage Board Minutes Book 16, Pages 275-277) The changes are as follows:

The 12" RCP was shortened from 619 feet to 614 feet. The 15" RCP was shortened from 263 feet to 262 feet. The 18" RCP was lengthened from 703 feet to 712 feet. The 21" RCP was lengthened from 283 feet to 289 feet. The open ditch was shortened from 122 feet to 103 feet. The 6" SSD was lengthened from 3,532 feet to 3,681 feet. The length of the drain due to the changes described above is now **5,661 feet**.

The non-enforcement was approved by the Board at its meeting on August 24, 2015 and recorded under instrument #2016007636.

The following sureties were guaranteed by Guarantee Company of North America and released by the Board on its August 8, 2016 meeting.

Bond-LC No: 20115507 Amount: \$206,143.00

For: Storm Sewers & Monumentation

Issue Date: June 02, 2015

I recommend the Board approve the drain's construction as complete and acceptable.

Sincerely,

Kenton C. Ward, CFM Hamilton County Surveyor


CERTIFICATE OF COMPLETION AND COMPLIANCE

To: Hamilton County Surveyor Re: Grannan Grove I hereby certify that: 1. I am a Registered Land Surveyor or Engineer in the State of Indiana. 2. I am familiar with the plans and specifications for the above referenced subdivision. 3. I have personally observed and supervised the completion of the drainage facilities for the above referenced subdivision. 4. The drainage facilities within the above referenced subdivision to the best of my knowledge, information and belief have been installed and completed in conformity with all plans and specifications. 5. The drainage facilities within the above referenced subdivision to the best of my knowledge, information and belief have been correctly represented on the Record Drawings, Digital Record Drawings and the Structure Data Spreadsheet. Date: January 12, 2016 Signature: Dennis D. Olmstead - Stoeppelwerth & Associates, Inc. Type or Print Name: 7965 East 106th Street Business Address: Fishers, Indiana 46038 Telephone Number: (317) 570-4700 INDIANA REGISTRATION NUMBER SEAL

900012

146th STREE

LOCATION MAP SCALE: 1"=1000'

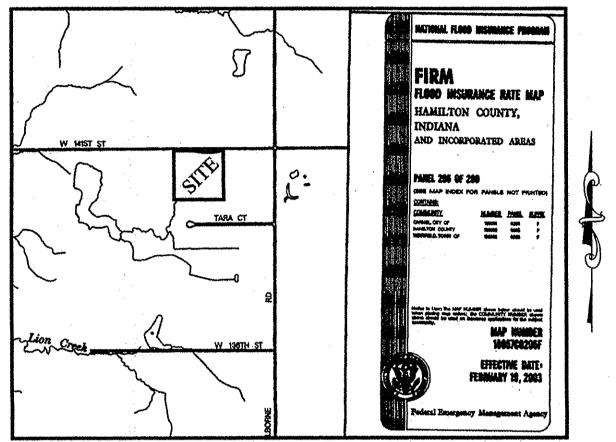

This is to certify that NO portion of the property is located within a Special Flood Hazard Area (Zone AE) as said property plots by scale on Community Panel No. 18057C 0205F of the Flood Insurance Rate Maps

GRAPHIC SCALE

(IN FEET)

1 inch = 80 ft.

Andrea J. deVoursney

Inst. No.: 97-43123

Martin J. Clampitt Inst. No.: 95-39554

REVISIONS

DESCRIPTIONS

REVISED PER CITY COMMENTS - 02/03/15 - HAM

C200, C300, REVISED PER WETLAND - 04/14/15 - ADG

C200, C500, ASBUILTS - 01/08/165 - ADG

C301, C600,

C302&C305

REVISED PER ENGINEERING COMMENTS - 01/08/15 - JSM

DEPTH STRUC. #517, STRUCTURE TABLE - 03/13/15 - DCM

REVISED PER WETLAND COMMENT - 05/29/15 - JSM

REVISED INVERTS ON MH #CG-801, #512 THRU #517 & #519, SUMP

	INDEX
SHT.	DESCRIPTION
C001	COVER SHEET
C100	TOPOGRAPHICAL SURVEY
C200-C201	SITE DEVELOPMENT PLANS EMERGECNY FLOOD ROUTE
C300-C304	STORMWATER POLLUTION & PREVENTION PLANS & SPECS
C400-407	STREET PLAN & PROFILES/ENTRANCE PLAN/INTERSECTION DETAILS/TRAFFIC CONTROL PLAN/PAVING POLICIES/CURBING POLICIES
C500	SANITARY SEWER PLAN & PROFILES
C600-C601	STORM PLAN & PROFILES / SUMP PLAN
C700	WATER PLAN
C800-C804	CONSTRUCTION DETAILS

A part of the Southeast quarter of Section 19, Township 18 North, Range 3 East, in Clay Township, Hamilton County, Indiana more particularly described as follows:

Beginning at the Northwest corner of the East half of said Southeast quarter; thence North 89 degrees 24 minutes 07 seconds East 657.81 feet along the North line of said Southeast quarter; thence South 00 degrees 20 minutes 18 seconds East 656.34 feet along the East line of the North half of the North half of the East half of said Southeast quarter to the North line of Edgewood Addition, a subdivision in Hamilton County, Indiana, the plat of which is recorded as Instrument Number 11263, Book 3, Page 98-99, Dated: October 31, 1969 in the Office of the Recorder, Hamilton County, Indiana; thence South 89 degrees 26 minutes 59 seconds West 657.49 feet along said North line to the West line of the East half of said Southeast quarter; thence North 00 degrees 21 minutes 59 seconds West 655.79 feet along said West line to the place of beginning, containing 9.905 acres, more or less.

A part of the Southeast quarter of Section 19, Township 18 North, Range 3 East, in Clay Township, Hamilton County, Indiana more particularly described as follows:

Commencing at the Northeast corner of said Southeast quarter; thence South 89 degrees 24 minutes 07 seconds West 680.86 feet along the North line of said Southeast quarter; thence South 00 degrees 35 minutes 53 seconds East 16,50 feet to the POINT OF BEGINNING of this description; thence South 80 degrees 12 minutes 06 seconds West 128.22 feet; thence South 89 degrees 24 minutes 07 seconds West 121.75 feet parallel with said North line; thence North 84 degrees 21 minutes 35 seconds West 188.65 feet; thence North 89 degrees 24 minutes 07 seconds East 435.85 feet parallel to said North line to the place of beginning, containing 0.131 acres, more or less

GRANNAN GROVE PUD ZONING

Owner & Developed by: PLATINUM PROPERTIES MANAGEMENT COMPANY, LLC

9757 Westpoint Drive, Suite 600

Indianapolis, IN 46256 Phone: (317) 863-2056

Contact Person: Ken Brasseur

141st STREET

Fax: 317-216-8635

ALDREW PLACE

Homeowner Association Inc

PARCEL NO. 17-09-19-00-03-063.000

C.A. 4

WET POND

Email: kbrasseur@platinum-properties.com

EDGEWOOD ADDITION

Inst. No.: 11263 Book 3, Page 98-99

Overbrook Farms

PARCEL NO.

17-09-19-00-03-064.000

C.A. 3

PLATINUM PROPERTIES MANAGEMENT COMPANY, LLC

OPERATOR ON N.O.I. LETTER:

9757 WESTPOINT DRIVE, SUITE 600 **INDIANAPOLIS, IN 46256** PHONE: (317) 863-2056 CONTACT PERSON: KEN

OPERATING AUTHORITY CITY OF CARMEL (317) 571-2441 ONE CIVIC SQUARE CARMEL, INDIANA 46032

UTILITY CONTACTS:

Clay Township Regional Waste District 10701 College Avenue Indianapolis, Indiana 46280

3450 West 131st Street Westfield, IN 46074


AT & T 5858 North College Avenue Indianapolis, Indiana 46220

Brighthouse Networks 3030 Roosevelt Avenue Indianapolis, Indiana 46218


Duke Energy 16475 Southpark Drive Westfield, Indiana 46074

Indianapolis Power & Light Company 3600 North Arlington Avenue Indianapolis, Indiana 46218


Vectren Energy 16000 Allisonville Road Noblesville, Indiana 46060

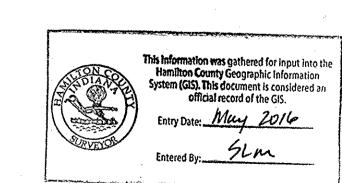

RECORD DRAWING

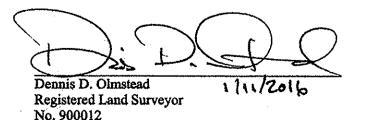

Riggs J. Overley Inst. No.: 2000-008132

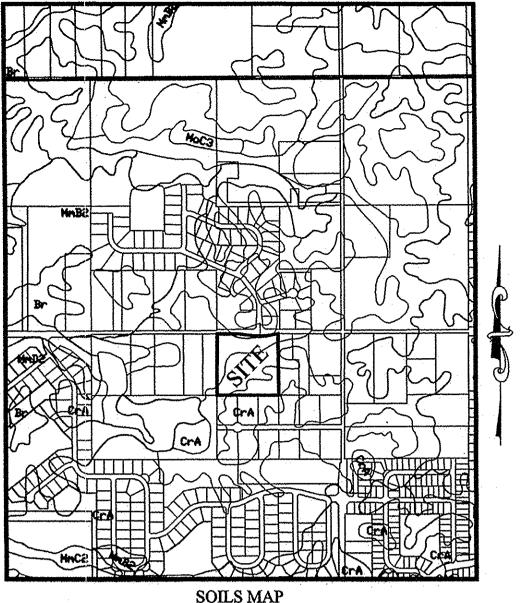

SCALE: 1"1000"

Map Unit: Br - Brookston silty clay loan

is in depressions. Slopes are 0 to 2 percent. The native vegetation is water tolerant grasses and hardwoods. The surface layer is silty clay loam and has moderate or high organic matter content (2.0 to 5.0 percent). Permeability is moderately slow (0.2 to 0.6 in/hr) in the most restrictive layer above 60 inches. Available water capacity is high (10.0 inches in the upper 60 inches). The pH of the surface layer in non-limed areas is 6.1 to 7.3. This soil is hydric. Wetness is a management concern for crop production. This soil responds well to tile

Map Unit: CrA - Crosby silt loam, 0 to 2 percent slopes

CrA-Crosby silt loam, 0 to 2 percent slopes This is a somewhat poorly drained soil and has a seasonal high watertable at 0.5 to 2.0 ft. and is on rises on uplands. Slopes are 0 to 2 percent. The native vegetation is hardwoods. The surface layer is silt loam and has moderately low or moderate organic matter content (1.0 to 3.0 percent). Permeability is very slow (< 0.06 in/hr) in the most restrictive layer above 60 inches. Available water capacity is moderate (6.2 inches in the upper 60 inches). The pH of the surface layer in non-limed areas is 5.1 to 6.0. Droughtiness and wetness are management concerns for crop production. This soil responds well to tile drainage.

PRIMARY BUILDING SETBACKS

MIN. FRONT BUILDING LINE	25
SIDE YARD/AGGREGATE	10' MIN./20' AGGREGATE
REAR YARD	20'

(heyand 10' from primary building)

	(beyond i	o nom primary building)	
Γ	MIN. FRONT BUILDING LINE	25' FROM FRONT OF BUILDING OR	
	MIN: TROIT BOILDING EINE	SETBACK LINE - WHICH EVER IS GREATER	
	SIDE / REAR YARD	5' FROM LOT LINE OR 3' FROM EASEMENT	

ACCESSORY BUILDING SETBACKS

(within 10' of primary building) MIN. FRONT BUILDING LINE 25' FROM FRONT OF BUILDING OR SETBACK LINE - WHICH EVER IS GREATER SIDE / REAR YARD see PRIMARY BUILDING SETBACKS

CONSTRUCTION LIMITS

DESIGN DATA

 $SITE = 9.905 \text{ Ac.} \pm$ 14 LOTS ==

1.41 LOTS/ACRE

GRANNAN LANE 583.01 L.F. ALDREW PLACE 392.75 L.F. TOTAL 975.76 L.F. **DESIGN SPEED LIMIT: 25 MPH**

PLANS PREPARED BY:


STOEPPELWERTH & ASSOCIATES, INC. CONSULTING ENGINEERS & LAND SURVEYORS 7965 E. 106TH STREET, FISHERS, INDIANA 46038 PHONE: (317)-849-5935 FAX: (317)-849-5942 CONTACT PERSON: BRETT A. HUFF EMAIL: BHUFF@STOEPPELWERTH.COM

PLANS CERTIFIED BY:

DAVID J. STOEPPELWERTH PROFESSIONAL LAND SURVEYOR NO. 19358





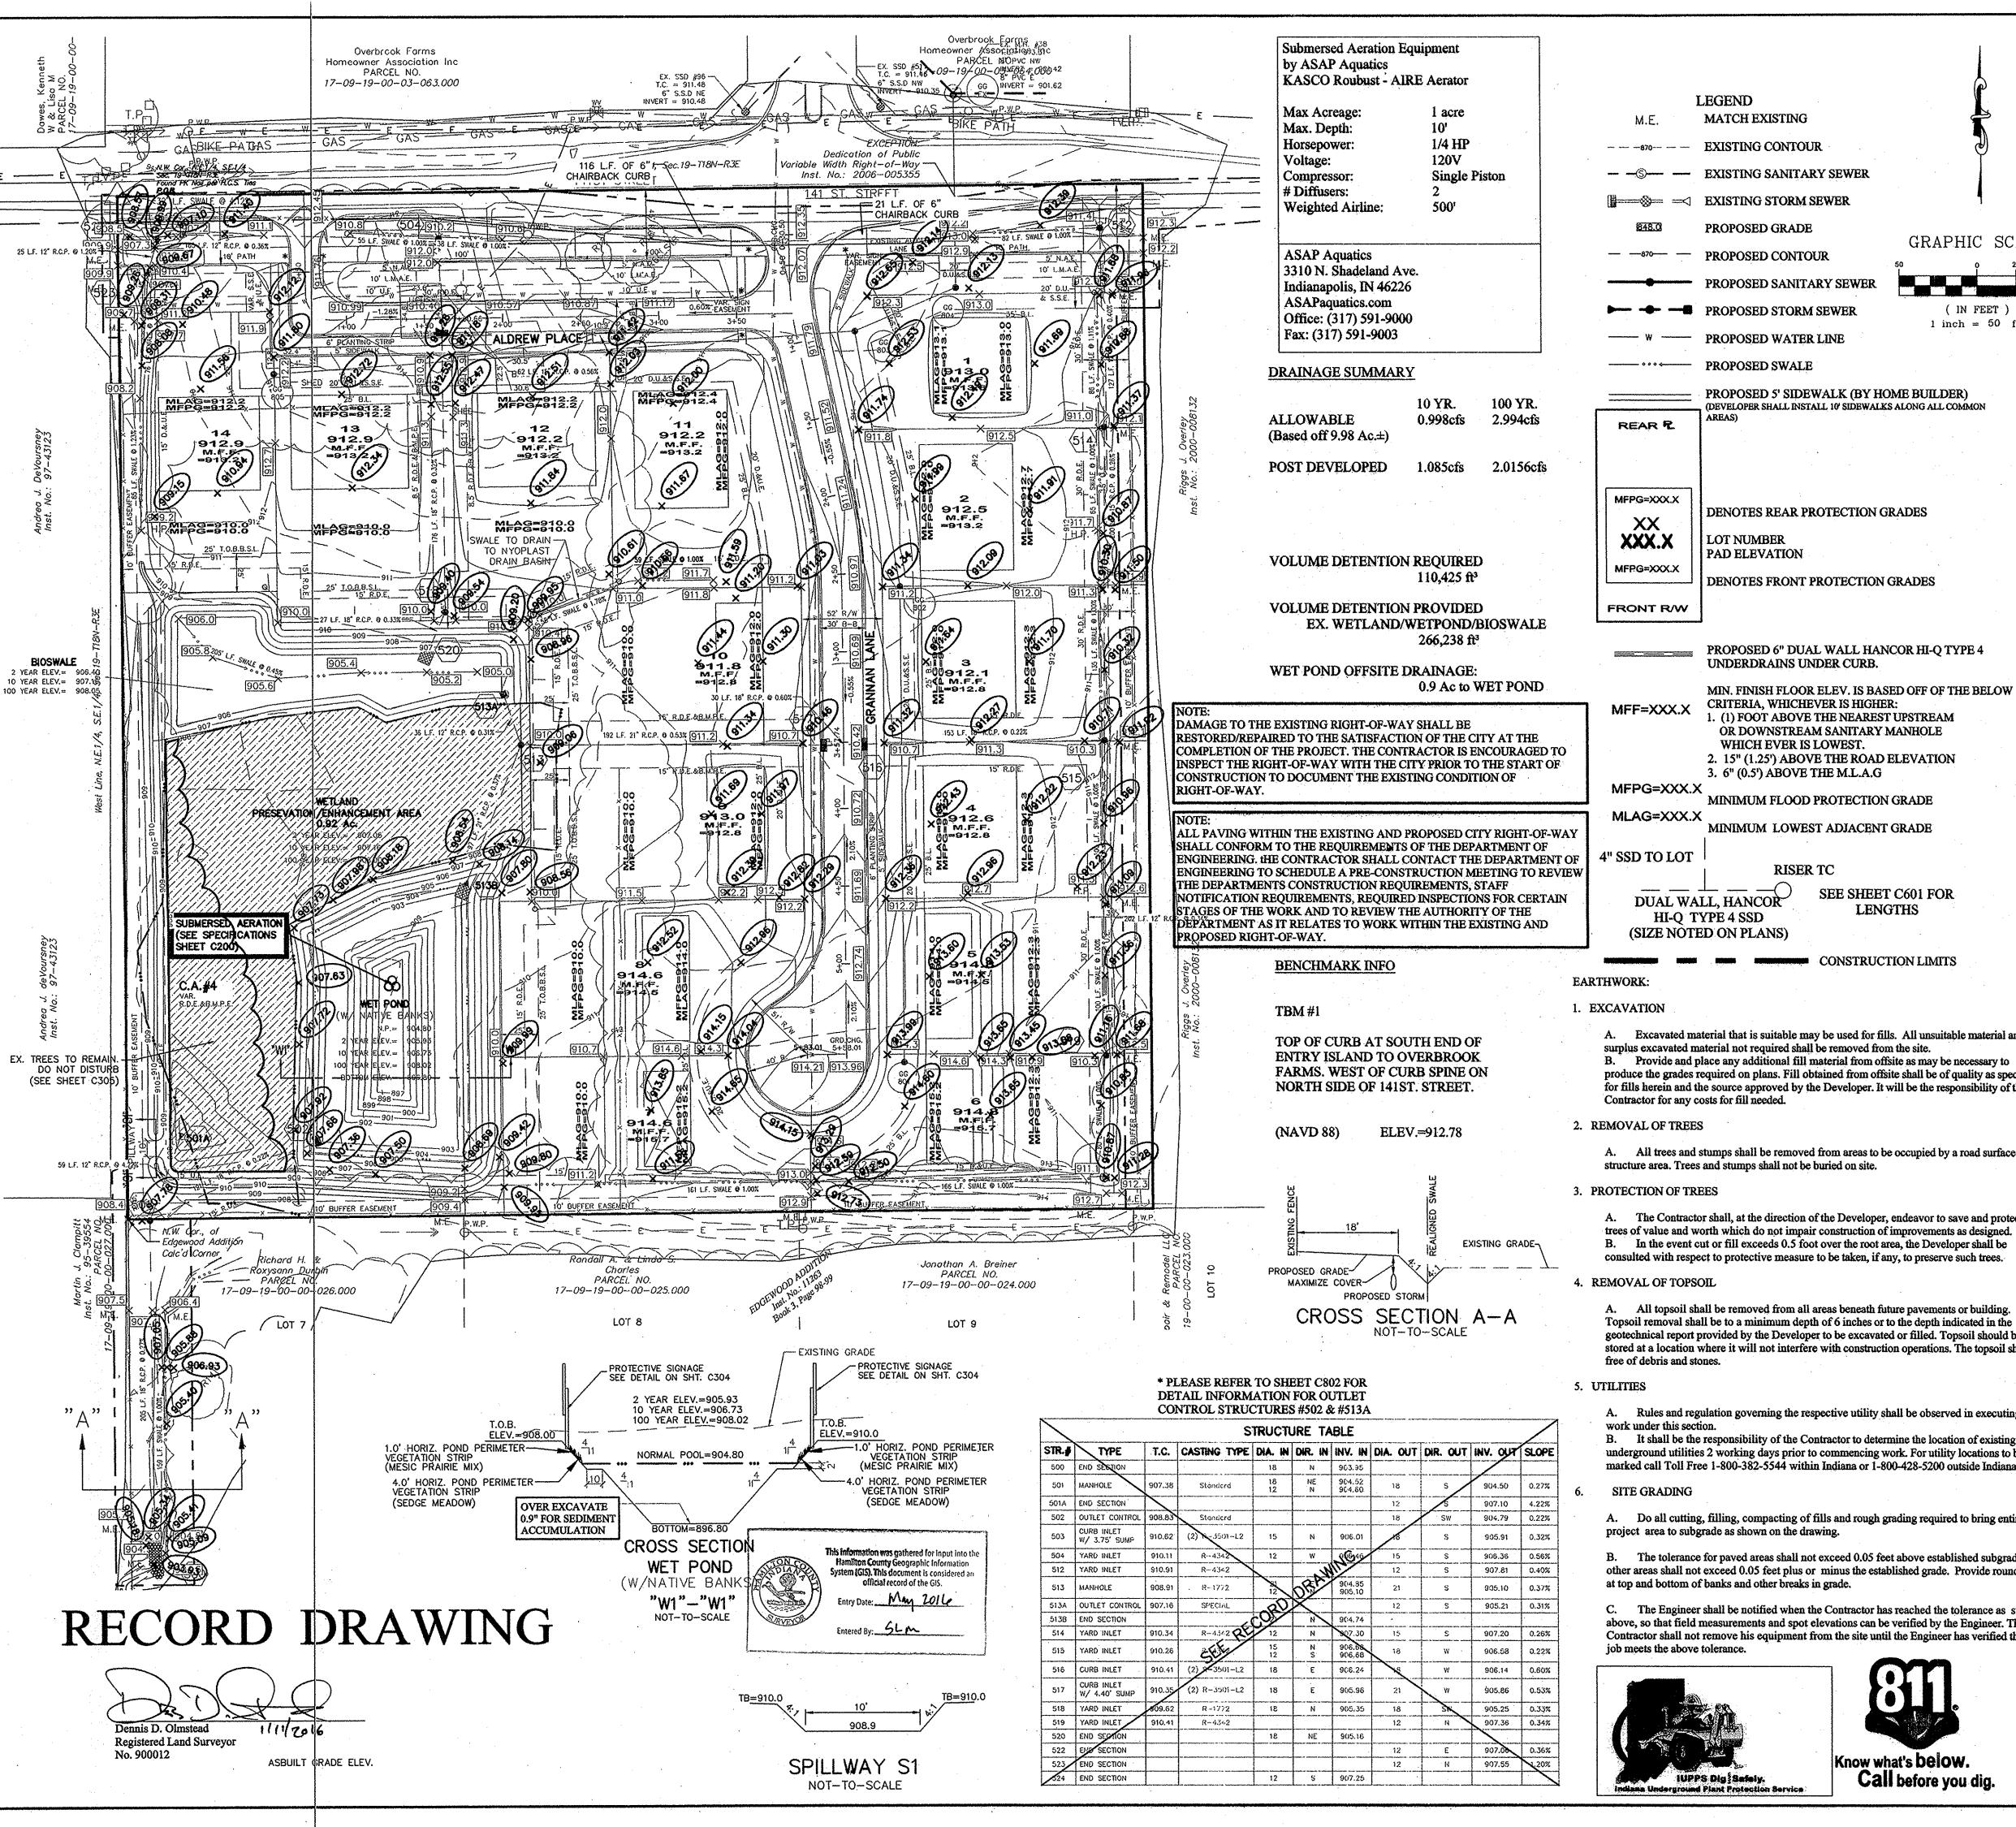

This copy printed from Digital Archive of the Hamilton County Surveyor's Office; One Hamilton Co. Square, Ste., Noblesville, In 46060

MATCH EXISTING EXISTING CONTOUR **EXISTING SANITARY SEWER** EXISTING STORM SEWER PROPOSED GRADE GRAPHIC SCALE PROPOSED CONTOUR PROPOSED SANITARY SEWER PROPOSED STORM SEWER (IN FEET) 1 inch = 50 ft.---- W ----- PROPOSED WATER LINE PROPOSED SWALE PROPOSED 5' SIDEWALK (BY HOME BUILDER) (DEVELOPER SHALL INSTALL 10' SIDEWALKS ALONG ALL COMMON DENOTES REAR PROTECTION GRADES LOT NUMBER PAD ELEVATION DENOTES FRONT PROTECTION GRADES

> PROPOSED 6" DUAL WALL HANCOR HI-Q TYPE 4 UNDERDRAINS UNDER CURB.

1. (1) FOOT ABOVE THE NEAREST UPSTREAM OR DOWNSTREAM SANITARY MANHOLE WHICH EVER IS LOWEST. 2. 15" (1.25') ABOVE THE ROAD ELEVATION

3. 6" (0.5') ABOVE THE M.L.A.G MINIMUM FLOOD PROTECTION GRADE

MINIMUM LOWEST ADJACENT GRADE

RISER TC

SEE SHEET C601 FOR DUAL WALL, HANCOR LENGTHS HI-Q TYPE 4 SSD

A. Excavated material that is suitable may be used for fills. All unsuitable material and all surplus excavated material not required shall be removed from the site. B. Provide and place any additional fill material from offsite as may be necessary to produce the grades required on plans. Fill obtained from offsite shall be of quality as specified for fills herein and the source approved by the Developer. It will be the responsibility of the

A. All trees and stumps shall be removed from areas to be occupied by a road surface or structure area. Trees and stumps shall not be buried on site.

A. The Contractor shall, at the direction of the Developer, endeavor to save and protect trees of value and worth which do not impair construction of improvements as designed. B. In the event cut or fill exceeds 0.5 foot over the root area, the Developer shall be consulted with respect to protective measure to be taken, if any, to preserve such trees.

A. All topsoil shall be removed from all areas beneath future pavements or building. Topsoil removal shall be to a minimum depth of 6 inches or to the depth indicated in the geotechnical report provided by the Developer to be excavated or filled. Topsoil should be stored at a location where it will not interfere with construction operations. The topsoil shall be

A. Rules and regulation governing the respective utility shall be observed in executing all

B. It shall be the responsibility of the Contractor to determine the location of existing underground utilities 2 working days prior to commencing work. For utility locations to be marked call Toll Free 1-800-382-5544 within Indiana or 1-800-428-5200 outside Indiana.

A. Do all cutting, filling, compacting of fills and rough grading required to bring entire project area to subgrade as shown on the drawing.

B. The tolerance for paved areas shall not exceed 0.05 feet above established subgrade. All other areas shall not exceed 0.05 feet plus or minus the established grade. Provide roundings at top and bottom of banks and other breaks in grade.

C. The Engineer shall be notified when the Contractor has reached the tolerance as stated above, so that field measurements and spot elevations can be verified by the Engineer. The Contractor shall not remove his equipment from the site until the Engineer has verified that the job meets the above tolerance.



(now what's be OW. Call before you dig. CONTACT: CARMEL UTILITIES (317) 571-2648 FOR WATER LOCATES FOR SANITARY SEWER LOCATES CONTACT: CLAY TOWNSHIP REGIONAL WASTE DISTRICT

(317) 844-9200

STORM SEWER FOR THIS PROJECT WILL BE PUBLIC. WITH EXCEPTION OF REAR YARD SSD'S.

ALL STORM SEWERS WITHIN PUBLIC RIGHT-OF-WAY SHALL BE RCP CLASS III. WITH EXCEPTION OF REAR YARD SSD'S.

FOR STORM AND PIPE CHARTS SEE THIS SHEET

NOTES TO CONTRACTOR:

LL PADS SHOULD BE TESTED TO ASSURE A COMPACTION OF AT LEAST 95 PERCENT OF THE MAXIMUM DRY DENSITY USING THE STANDARD ROCTOR TEST METHOD.

[장 [사] 원 [원 [원]

OPMEN.

DEVEL

S.

ANY PRIVATE TILES LOCATED ON THIS SITE WILL NEED TO BE LOCATED; REATHERS SET AT THE DOWNSTREAM PROPERTY LINE AND CRUSHED OR REMOVED ACROSS THIS SITE. IF ANY OF THESE TILES EXTEND BEYOND THE LIMITS OF THIS PROJECT. THEY WILL NEED TO BE PROVIDED A POSITIVE OUTLET AND ALLOWED TO CONTINUE TO FUNCTION, AS IT IS ILLEGAL TO BLOCK OFF A PRIVATE "MUTUAL" TILE.

ONTRACTOR SHALL VERIFY DEPTHS OF ALL EXISTING ONSITE UTILITIES PRIOR TO CONSTRUCTION TO CONFIRM THERE IS NOT ANY CONFLICTS WITH OTHER UTILITIES, STORM SEWERS OR STREETS. CONFLICTS AFTER

ONTRACTOR SHALL CONTACT THE DEPARTMENT OF ENGINEERING CHEDULE A PRE-CONSTRUCTION MEETING TO REVIEW THE TO REVIEW THE AUTHORITY OF THE DEPARTMENT AS IT RELATES TO WORK WITHIN THE EXISTING AND PROPOSED CITY R/W.

EXISTING PAVEMENT TO BE SAW CUT TO A CLEAN EDGE ADJACENT TO ANY WIDENING, AUXILIARY LANES, ETC.

NO EARTH DISTURBING ACTIVITY MAY TAKE PLACE WITHOUT AN APPROVED STORM WATER MANAGEMENT PERMIT.

THERE IS TO BE NO DRIVEWAY ENCROACHMENTS INTO EASEMENTS

UTILITY RELOCATIONS REQUIRED BY THE PROJECT SHALL BE THE RESPONSIBILITY OF THE DEVELOPER, UTILITY LINE RELOCATIONS REQUIRED FOR ROAD PROJECTS THAT RESULT IN A CONFLICT WITH DEVELOPER TO RESOLVE WITH THE UTILITY. EXISTING POLE LINES REQUIRED TO BE RELOCATED TO WITHIN ONE FOOT OF PROPOSED RIGHT-OF-WAY LINE.

LOOD STATEMENT THIS SITE DOES NOT LIE WITHIN A FLOODWAY OR FLOOD PLAIN PER FIRM 18057C0205F DATED FEB. 19, 2003

VEGETATIVE COVER EXISTING SITE CONSIST MOSTLY OF GRASS AND WEEDS WITH WOODS ON THE SITE.

ADJACENT PROPERTIES NORTH: RESIDENTIAL **EAST: AGRICULTURE** SOUTH: RESIDENTIAL WEST: AGRICULTURE

> From Sections 104.02, 302.06 and 303.07 of the City of Carmel Storm Water Technical Standards Manual

Definitions pond or open ditch shall be no less than 2 feet above any adjacent 100-year local or regional flood elevations, whichever is greater, for all windows, doors, pipe entrances, window wells, and any other structure member where floodwaters can enter a building. Lowest Adjacent Grade is the elevation of the lowest grade adjacent to a structure, where the soil meets the foundation around the outside of the structure (including structural members such as basement walkout, patios,

decks, porches, support posts or piers, and rim of the window well. 2. Standard: Lowest Adjacent Grade

The Lowest Adjacent Grade for residential, commercial, or industrial buildings shall have two feet of freeboard above the flooding source's 100-year flood elevation

For areas outside a Special Flood Hazards Area (SFHA) or FEMA or IDNR designated floodplain
i. The Lowest Adjacent Grade for all residential, commercial, or industrial buildings adjacent to ponds shall be set a minimum of 2 feet above the 100-year pond elevation or 2 feet above the emergency overflow

under proposed conditions.


weir elevation, whichever is higher. ii. The Lowest Adjacent Grade for all residential, commercial, or industrial buildings shall be set a minimum of 2 feet above the highest noted overflow

is adjacent to and facing a road shall be a minimum of 15

path/ponding elevation across the property frontage. In addition to the Lowest Adjacent Grade requirements, any basement floor must be at least a foot above the normal water level of any wet-bottom pond.

3. Design Notes: a. Each lot that is adjacent to a pond, open ditch or flooding source has a flood protection grade. There are instances where there are multiple different flooding sources for 1 structure. In this case, there should be a flood protection grade listed for each side of the structure in the event that piping from the structure discharge to either flood source. Finished floor elevation or the lowest building entry elevation shall be no less than 6 inches above finished grade around the building. Also, the building's lowest entry elevation that

inches above the road elevation.

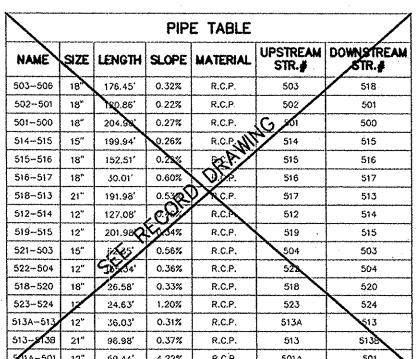

501A-501 12" 59.44' 4.22% R.C.P. 501A

DRAWN BY: CHECKED BY:

