


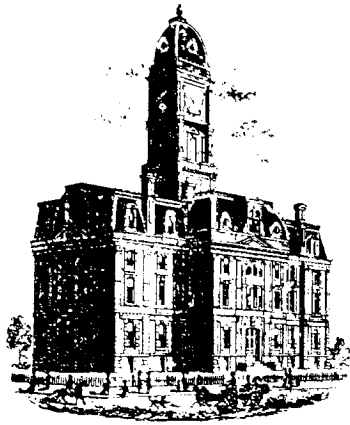

March 4, 2009

Kenton C. Ward, CFM
Surveyor of Hamilton County
Phone (317) 776-8495
Fax (317) 776-9628

Suite 188
One Hamilton County Square
Noblesville, Indiana 46060-2230

To: Hamilton County Drainage Board

Re: Booth Snead Drain, 126th Street Arm

Attached is a 52.5 petition and plans for the proposed relocation of the Booth Snead Drain, 126th Street Arm. The relocation is being proposed by the Town of Fishers. The proposal is to relocate the drain across 126th Street right of way owned by the Town of Fishers as part of the 126th Street project per plans by R.W. Armstrong., Job No. 20043560, revision date January 13, 2009.

Per the plans, the existing culvert pipe under 126th Street will be extended north by 22' replacing existing open ditch.

The line will consist of the following:

54" RCP 22 ft.

The total length of new drain shall be 22 feet. The 22 feet of original drain between Sta.17+49 and Sta.17+71 shall be vacated. This proposal will not affect the drain's total length.

The cost of the relocation is to be paid by the Town of Fishers. The Town is not required to provide surety.

The project falls under the requirements as set out in IC 36-9-27-52.5. Therefore, a hearing is not required for the petition. I recommend that the Board approve this petition and report as submitted.

Kenton C. Ward, CFM
Hamilton County Surveyor

KCW/pll

**Gasb 34 Asset Price &
Drain Length Log**

Drain-Improvement: Mud Creek - Sand Creek: Booth -Snead Drain: 126th Street Arm

Drain Type:	Size:	Length	Length (DB Query)	Length Reconcile	If Applicable	
					Price:	Cost:
Open		10	10	0	\$19.55 If	\$195.50
RCP	54	22	22	0	\$85.45 If	\$1,879.90
Sum:		<u>32</u>	<u>32</u>	<u>0</u>		<u>\$2075.40</u>

Final Report: 32

Comments:

HAMILTON COUNTY DRAINAGE BOARD
NOBLESVILLE, INDIANA

IN RE: 126th Street Project, Fishers)
Hamilton County, Indiana)


PETITION FOR RELOCATION AND RECONSTRUCTION

The Town of Fishers (hereinafter "Petitioner"),
 hereby petitions the Hamilton County Drainage Board for authority to relocate and improve a
 section of the Booth Snead Drain, and in support of
 said petition advises the Board that:

1. Petitioner owns real estate through which a portion of the Booth Snead
 Drain runs.
2. Petitioner plans to develop its real estate with roads, buildings, utilities, storm drains,
 sanitary sewers and other structures.
3. Petitioner's proposed development of its real estate will require relocation and
 reconstruction of a portion of the Booth Snead Drain, as
 specifically shown on engineering plans and specifications filed with the Hamilton
 County Surveyor.
4. The work necessary for the proposed relocation and reconstruction will be undertaken at
 the sole expense of the Petitioner and such work will result in substantial improvement to
 the Booth Snead Drain, without cost to other property owners
 on the watershed of the Booth Snead Drain.
5. Proposed relocation and reconstruction will not adversely affect other land owners within
 the drainage shed.
6. Petitioner requests approval of the proposed relocation and reconstruction under
 IC 36-9-27-52.5.

WHEREFORE, Petitioner requests that an Order issued from the Hamilton County
 Drainage Board authorizing relocation and reconstruction of the Booth Snead
 Drain, in conformance with applicable law and plans and specifications on file with the Hamilton
 County Surveyor.


 Signed _____
JEFFREY HEIKLING
 Printed _____

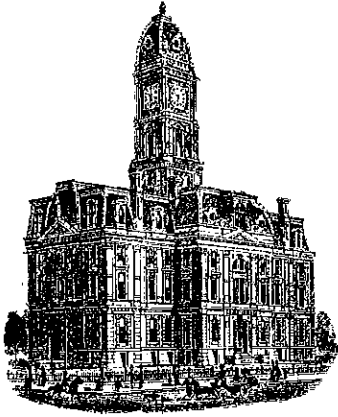

Kenton C. Ward, CFM
Surveyor of Hamilton County
Phone (317) 776-8495
Fax (317) 776-9628

Suite 188
One Hamilton County Square
Noblesville, Indiana 46060-2230

To: Hamilton County Drainage Board

August 9, 2011

Re: Mud Creek – Sand Creek: Booth-Snead Drain: 126th Street Arm

Attached are as-builts, certificate of completion & compliance, and other information for Booth – Snead: 126th Street. An inspection of the drainage facilities for this section has been made and the facilities were found to be complete and acceptable.

During construction, changes were made to the drain, which will alter the plans submitted with my report for this drain-dated March 4, 2009. The report was approved by the Board at the hearing held March 9, 2009. (See Drainage Board Minutes Book 11, Page 516)

The changes are as follows:

The project removed an additional 10 feet of the original Booth- Snead tile and replaced it with open ditch. The original tile was removed from Sta. 17+39 to Sta. 17+71. The length of the drain due to the changes described above is now **32 feet**.



A non-enforcement was not needed as all work was done within existing and new road right of way. No sureties were required as the project was paid for by the Town of Fishers.

I recommend the Board approve the drain's construction as complete and acceptable.

Sincerely,

Kenton C. Ward, CFM
Hamilton County Surveyor

KCW/slm

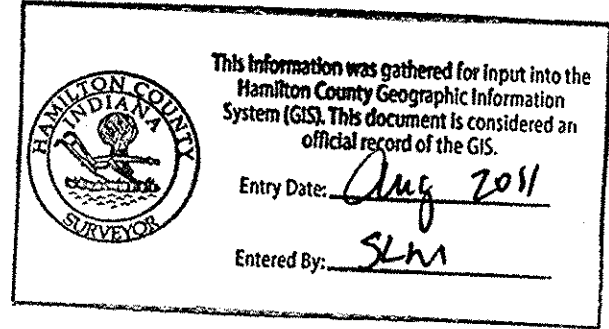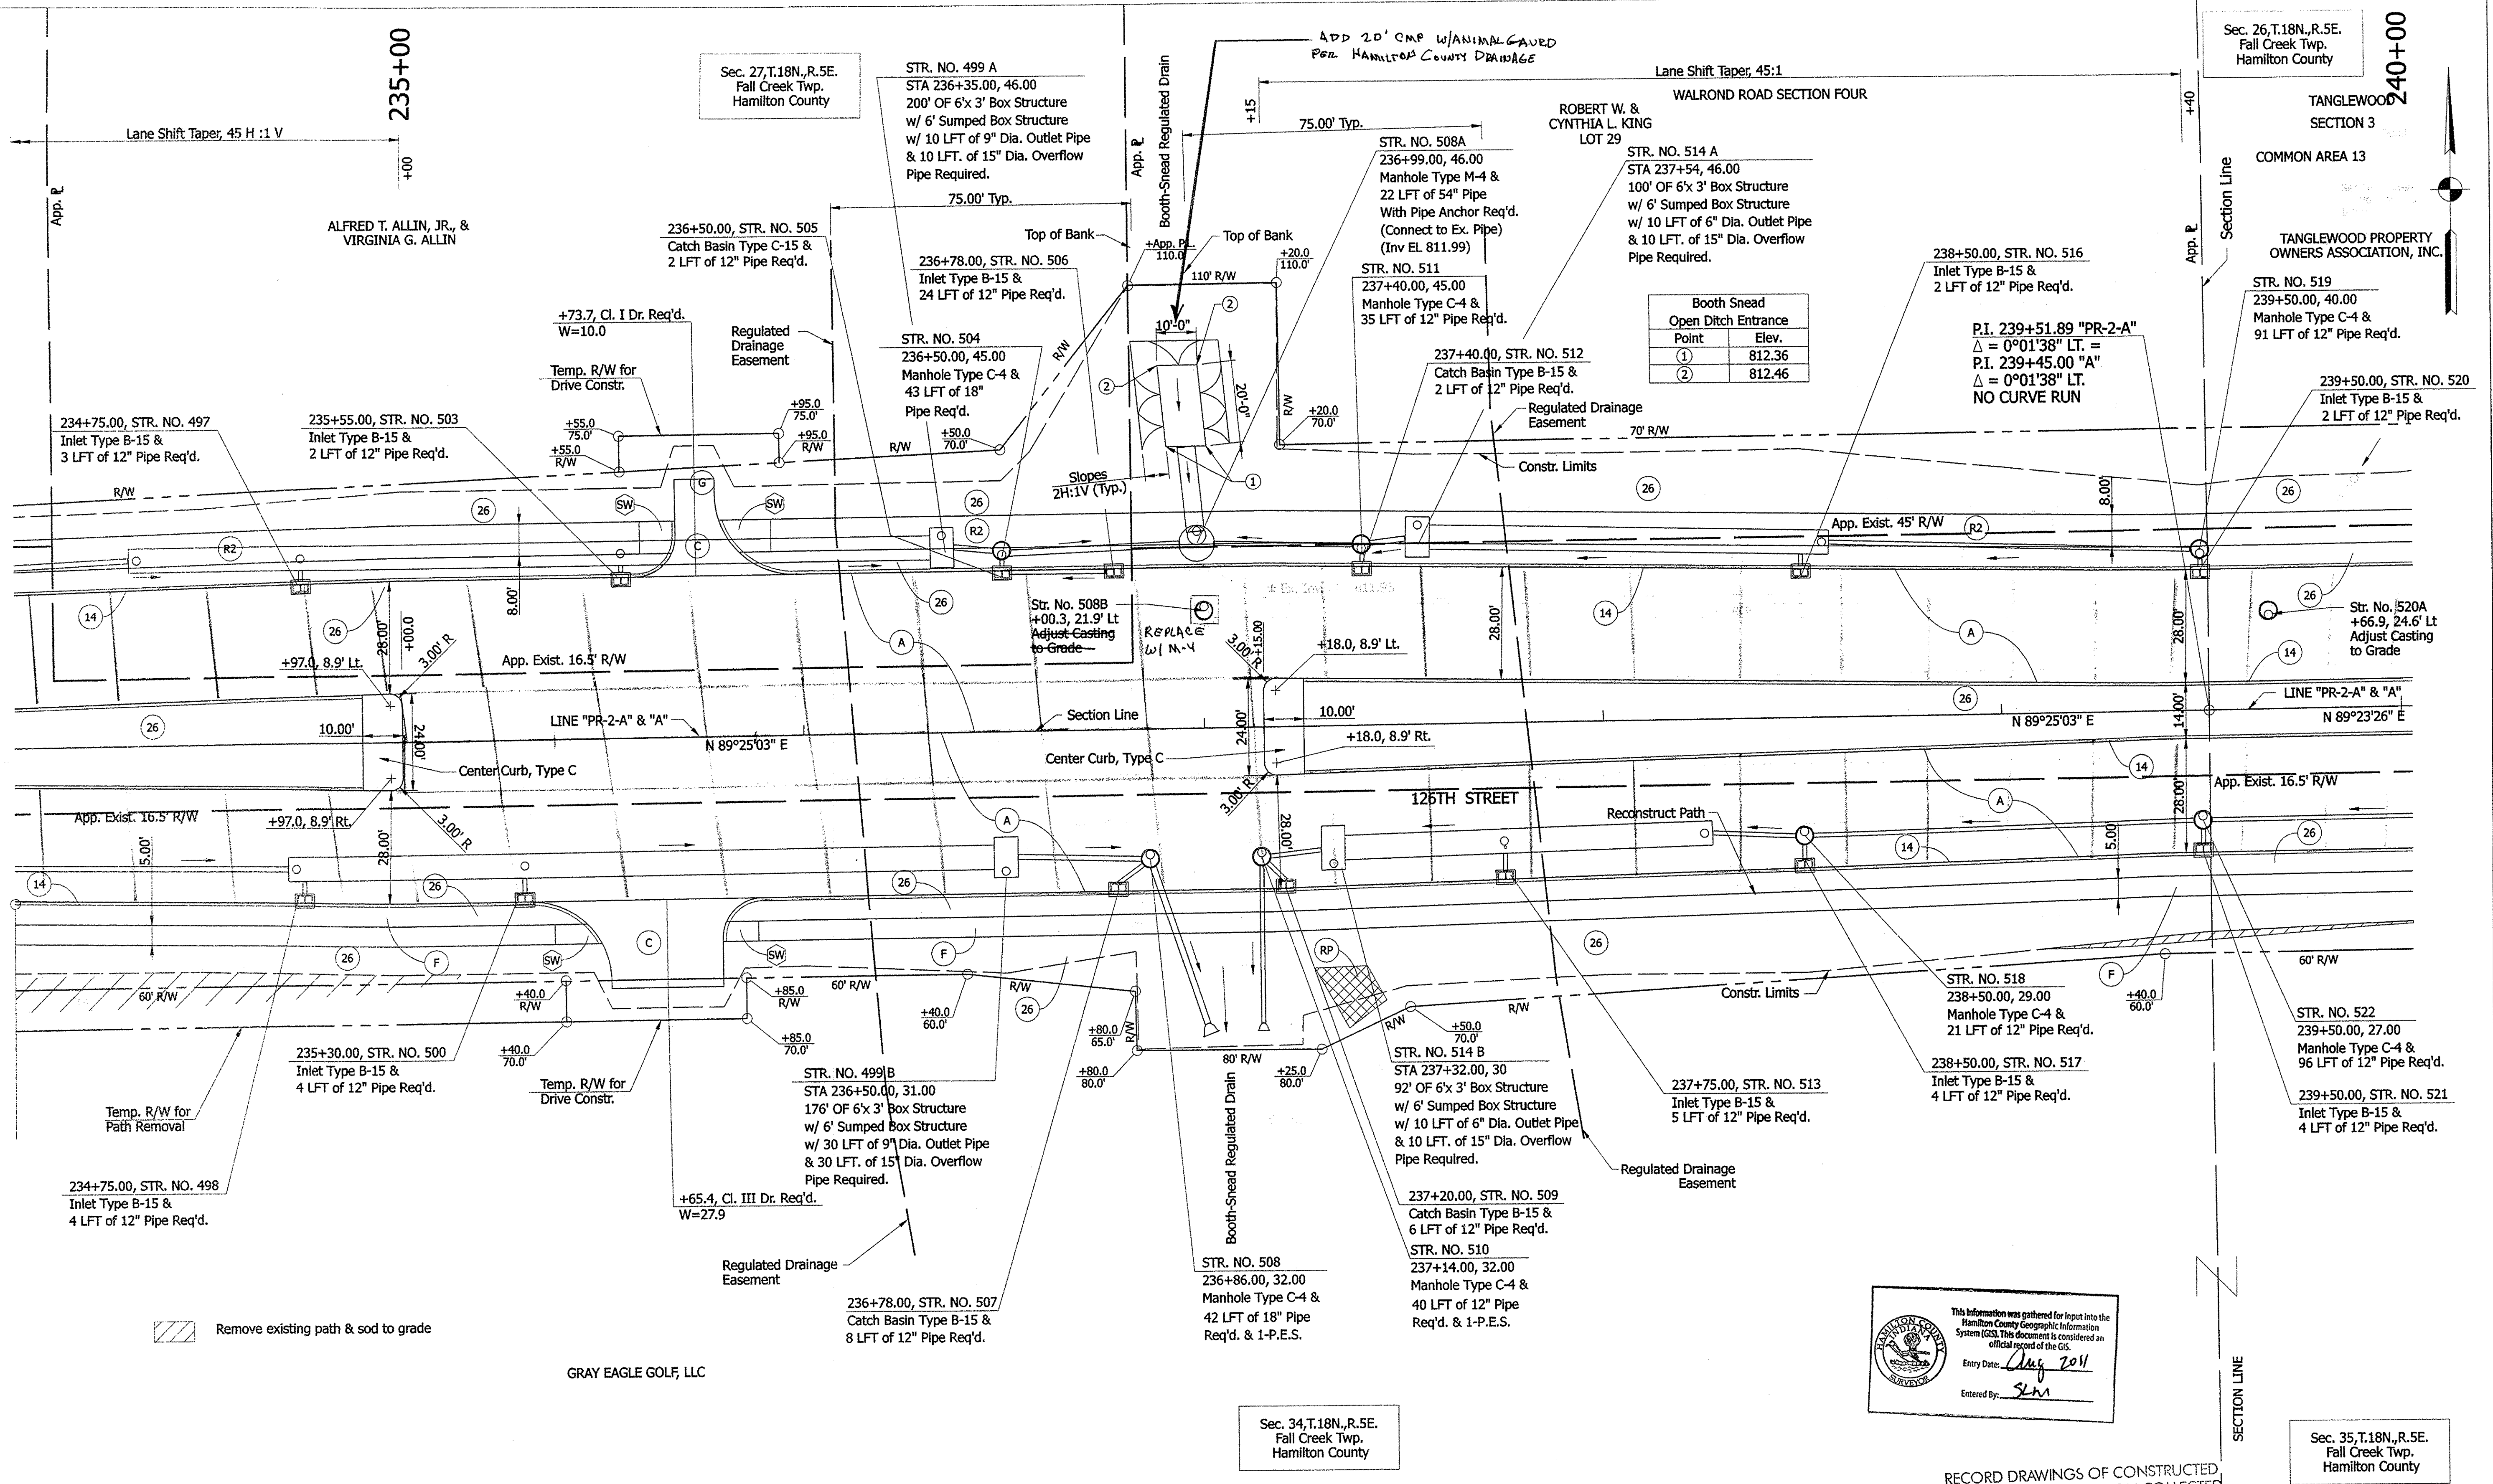

RECORD DRAWINGS OF CONSTRUCTED PROJECT PER INFORMATION COLLECTED DURING CONSTRUCTION


TOWN OF FISHERS

126th STREET - LINE "PR-2-A"
CONSTRUCTION DETAILS

HORIZONTAL SCALE	BRIDGE FILE
1" = 20'	DESIGNATION
VERTICAL SCALE	0401388
SURVEY BOOK	SHEET
ELECTRONIC	35 of 157
CONTRACT	PROJECT
R-31688	STP-9929()

All Dimensions are in Feet Unless Noted.
All R/W Callouts from Line "PR-1-A" or "PR-2-A" Unless Noted

CONSTRUCTION LEGEND			
(A) 15" PLAIN CEMENT CONCRETE PAVEMENT	(H) WIDENING WITH HMA	(3) LONGITUDINAL JOINT	(17) CONC. MONOLITHIC CURB
(B) BRICK	(K) FULL DEPTH HMA PAVEMENT	(12) CONCRETE CURB, BARRIER	(22) CONC. CENTER CURB, TYPE "D", MODIFIED
(C) PCCP FOR DRIVEWAYS	(K2) FULL DEPTH STR. APPR. (SEE STD. DRWG'S)	(13M) CONCRETE CURB, BARRIER, MODIFIED	(23) CONC. CENTER CURB, TYPE "A"
(D) HMA FOR APPROACHES	(R) RESURFACE (SEE TYPICAL SECTIONS)	(14) INTEGRAL CONC. CURB, TYPE "C"	(26) SODDING
(D1) OVERLAY: HMA FOR APPROACHES	(R1) RESURFACE (SEE TYPICAL SECTIONS)	(15) COMBINED CONC. CURB & GUTTER, TYPE "C"	(C) CURB RAMP, TYPE "L"
(F) 4" CEMENT CONCRETE SIDEWALK	(R2) SHARED-USE PATH	(15A) COMBINED CONC. CURB & GUTTER, 2' WIDTH, MODIFIED	(SW) SIDEWALK TRANSITION
(G) AGGREGATE	(S) HMA SHOULDER (SEE TYPICAL SECTIONS)	(16) CONC. CURB & GUTTER, ROLLED	(RP) REMOVE EXISTING PAVEMENT (ASPHALT)
	(W) WALL		

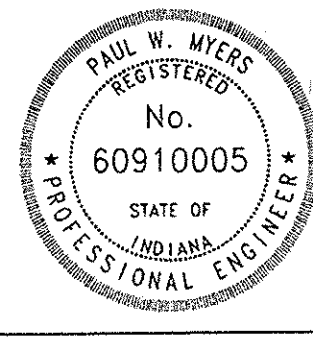

Sec. 34, T.18N., R.5E.
Fall Creek Twp.
Hamilton County

RECOMMENDED FOR APPROVAL	DESIGN ENGINEER	DATE
PAUL W. MYERS	PAUL W. MYERS	2-16-09
DESIGNED: VA / PWM	DRAWN: AGL	
CHECKED: PWM	CHECKED: PWM	

[illegible]

RECORD DRAWINGS OF CONSTRUCTED
PROJECT PER INFORMATION COLLECTED
DURING CONSTRUCTION

TOWN OF FISHERS	HORIZONTAL SCALE	SHEET NO.	
	VERTICAL SCALE	DESIGNATION	
STRUCTURE DATA TABLE	SURVEY BOOK	156	of 157
	ELECTRONIC	PROJECT	
	CONTRACT	STP-9929()	
	R-31668		