

Kenton C. Ward, CFM
Surveyor of Hamilton County
Phone (317) 776-8495
Fax (317) 776-9628

Suite 188
One Hamilton County Square
Noblesville, Indiana 46060-2230

Map Correction-Field Verification

Drain Number: 362

Drain Length: 570

Drain Name: Round Up Reconstruction

Change + / - : 22

Date: 11-6-2014


New Length: 592

Verified By: Brian Rayle


Notes & Sketch:

The as-builts reflect that there was 592 feet of 12" HDPE installed with this project. The original surveyor's report dated March 12, 2013 had proposed 570 feet of pipe.


Suzanne L. Mills
GIS Specialist

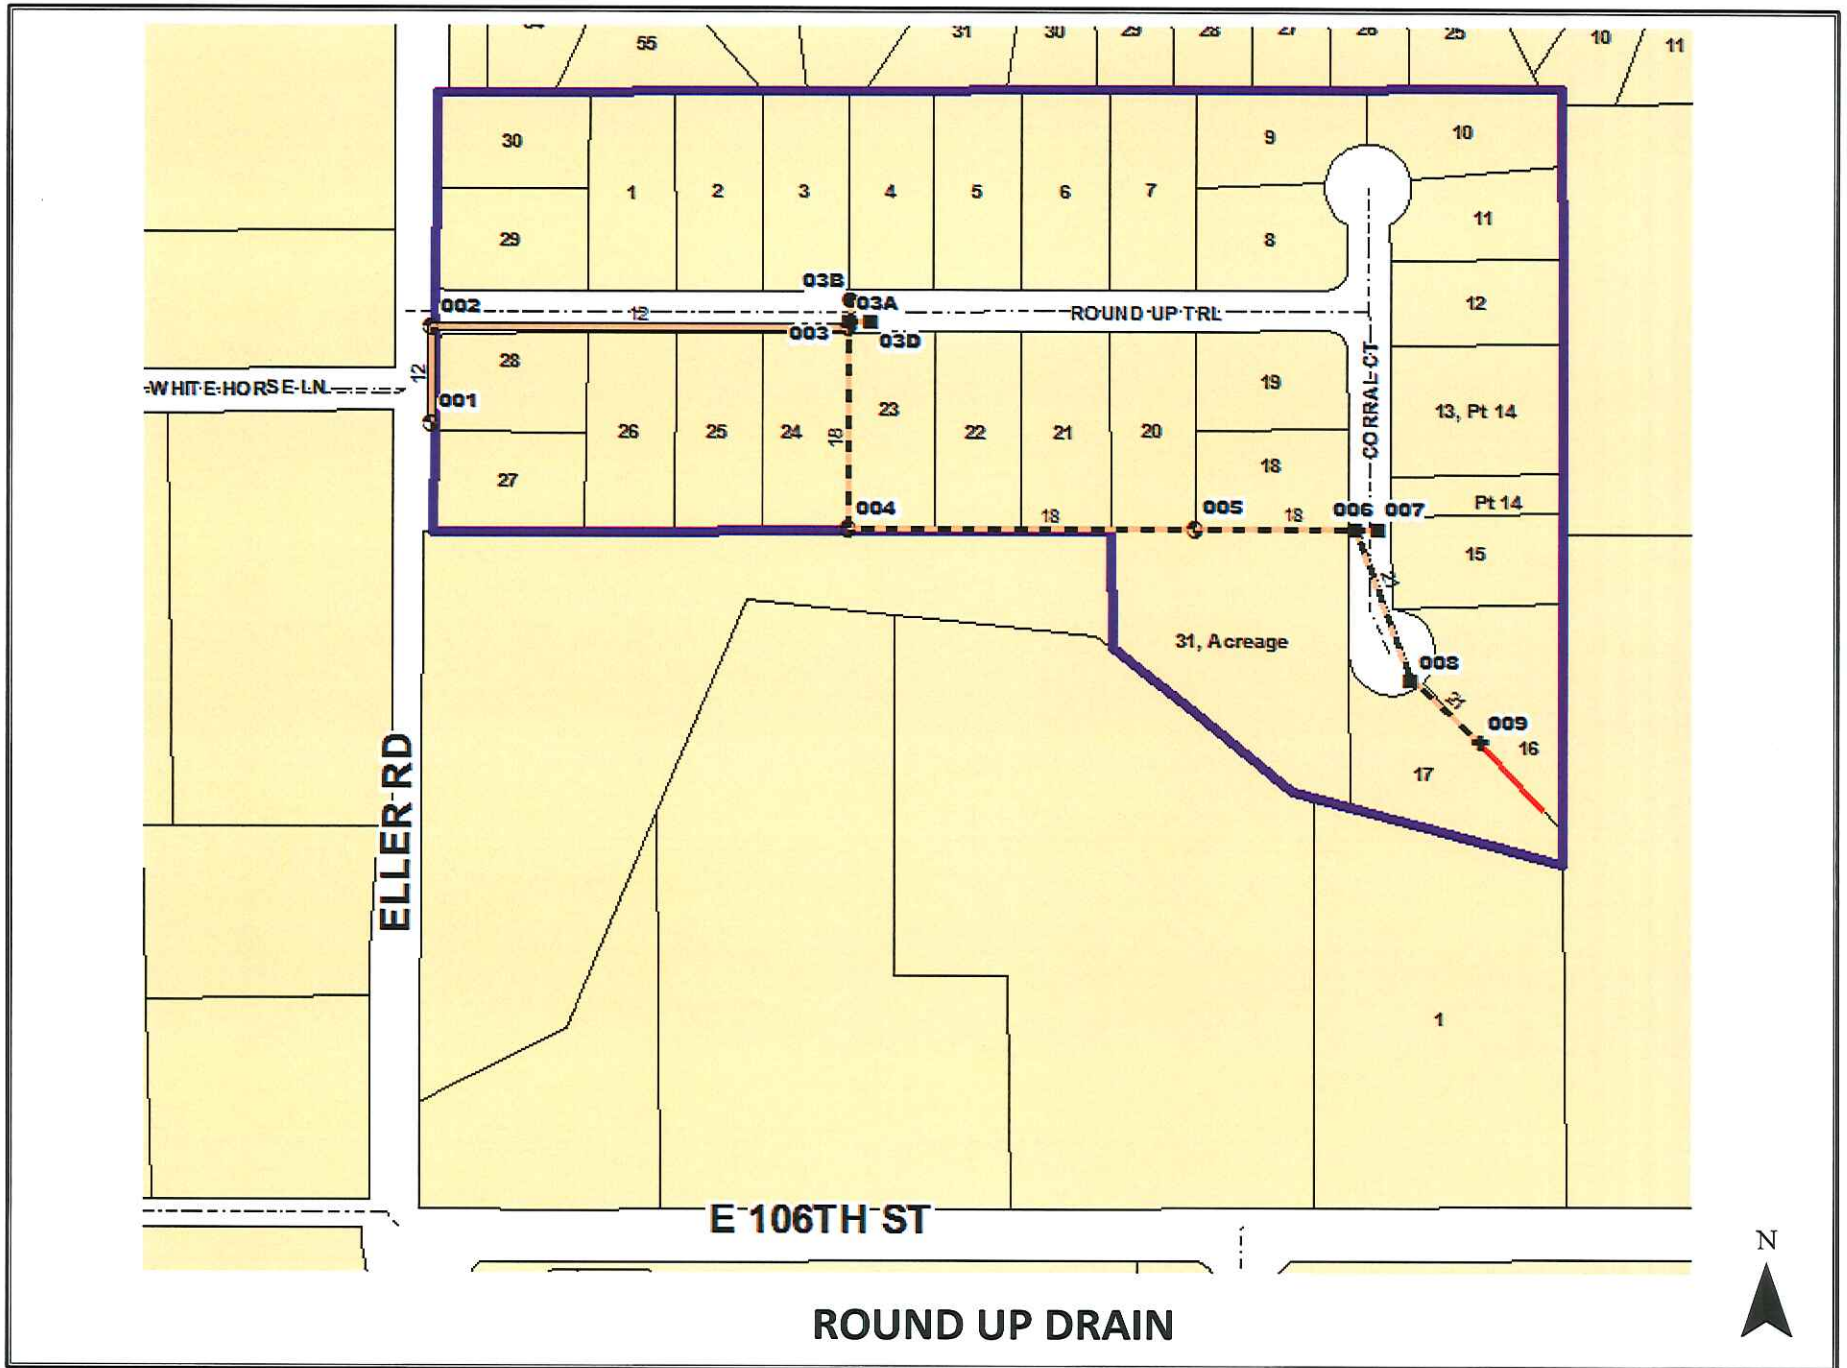

592'

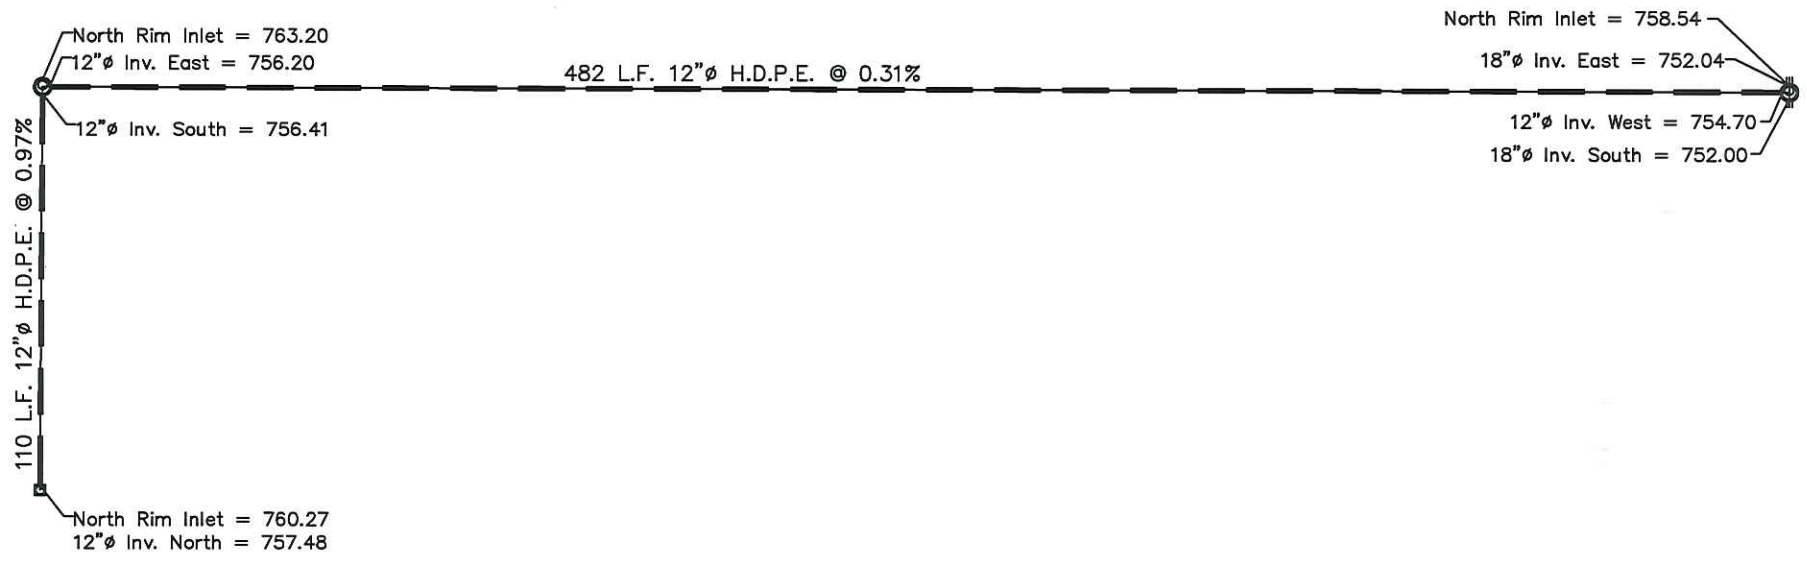

Asbuilt by
BRIAN Rayle, L.S.
11-6-2014
slw