



Kenton C. Ward, CFM
Surveyor of Hamilton County
Phone (317) 776-8495
Fax (317) 776-9628

Suite 188
One Hamilton County Square
Noblesville, Indiana 46060-2230

Map Correction-Field Verification

Drain Number: #244

Drain Length: 9841

Drain Name: Sutton Place-Sec 1 Arm

Change + / - : 40

Date: 04-19-2010


New Length: 9881

Verified By: Suzie Mills

Notes & Sketch: See attached Map

It was recently discovered that outlet pipe at the south end of the pond for Sutton Place Section 1 was missed in the mapping inventory done in 2003-2004. This run of 24" pipe between structures 155-154 will add 40 feet to the drain's overall length.

Suzanne L. Mills
GIS Specialist

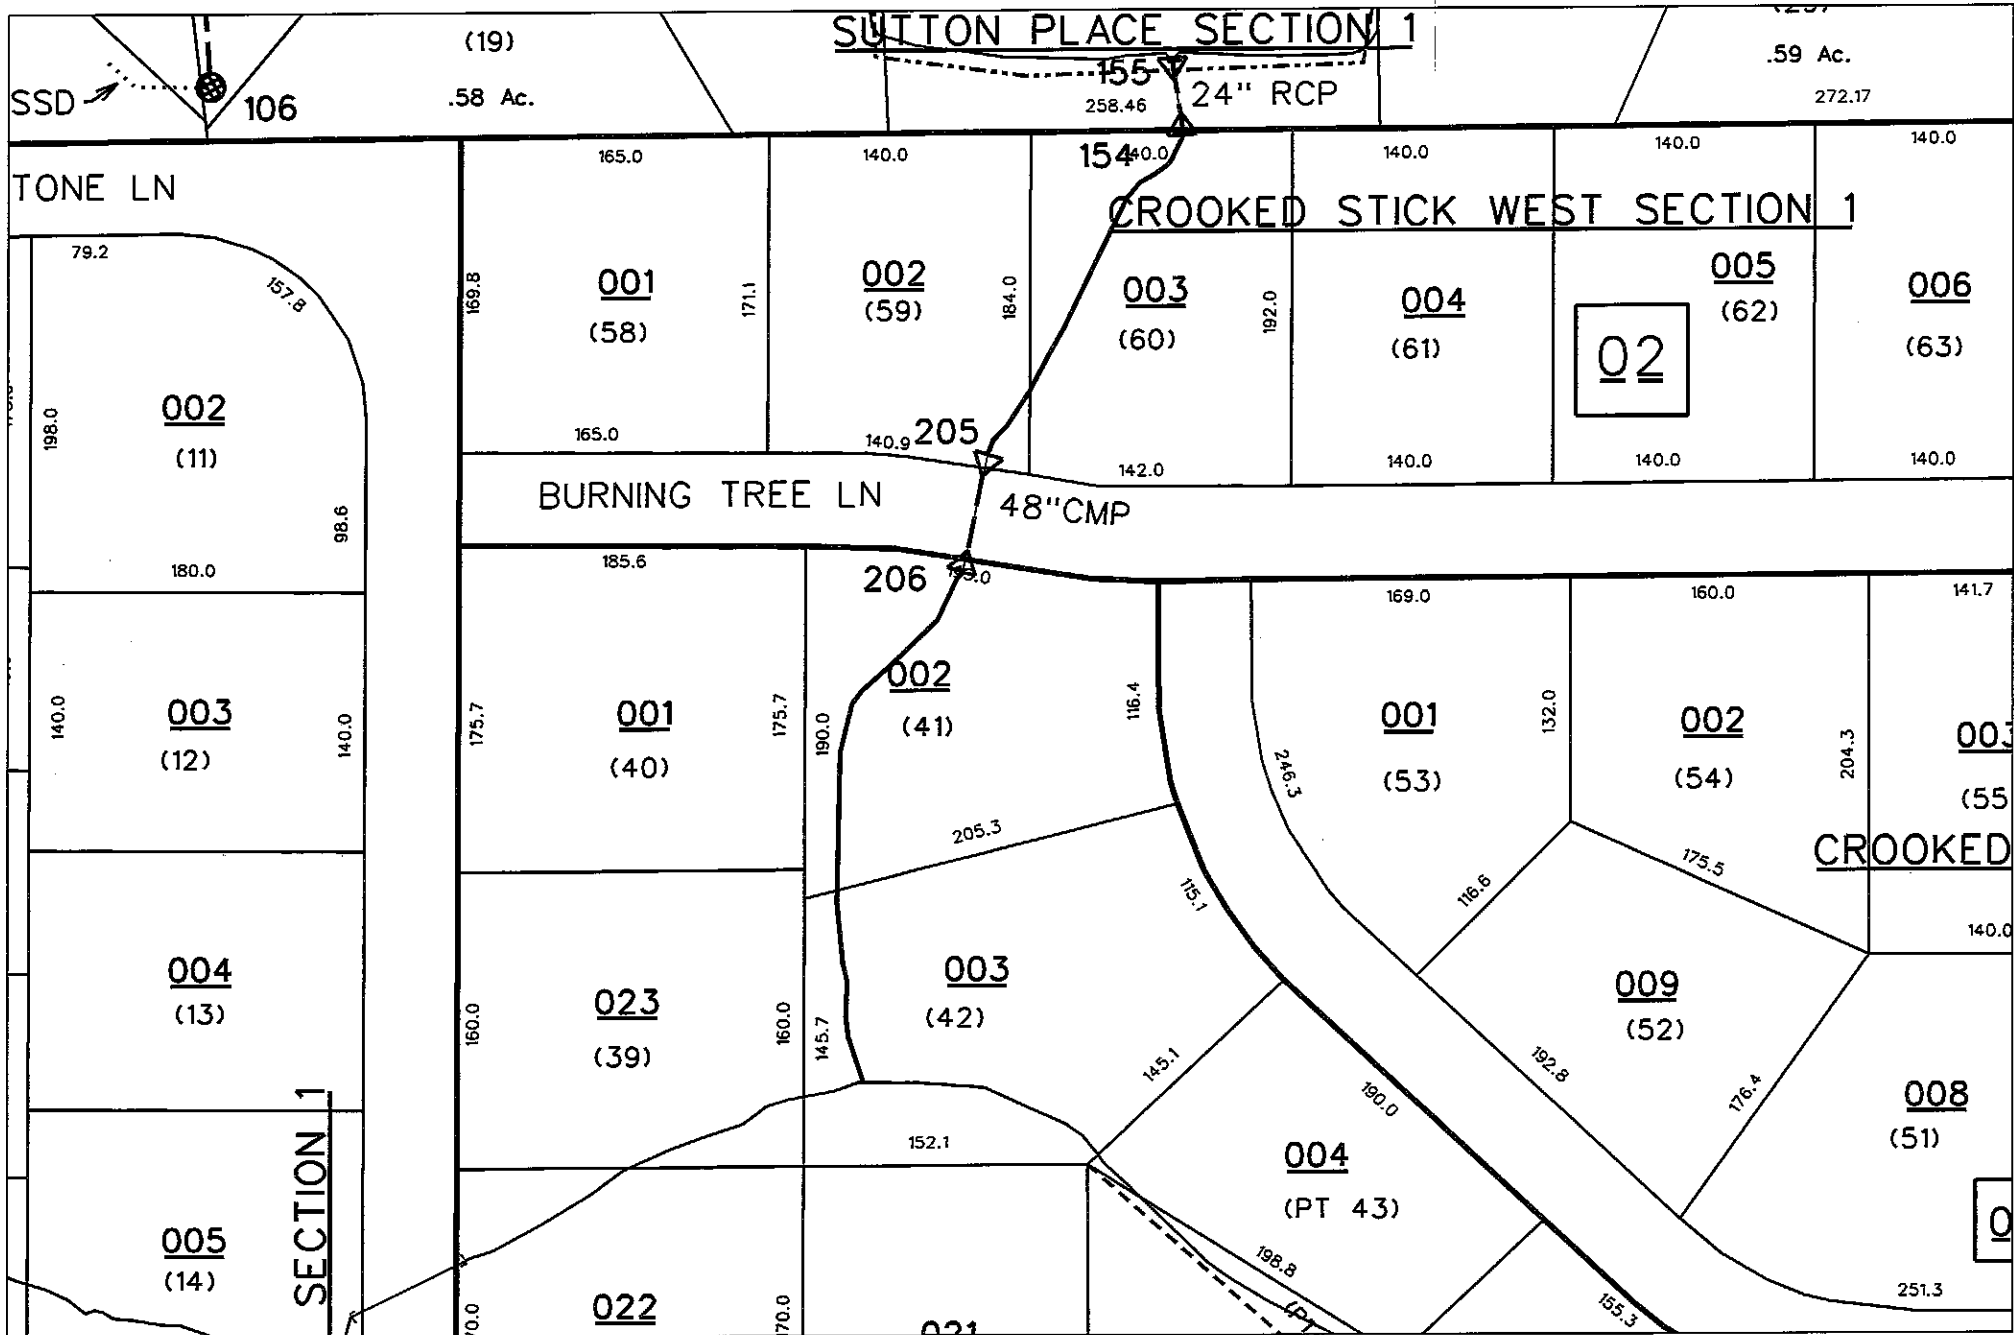

sub_rg_drn.dgn 4/12/2010 1:08:19 PM