

Kenton C. Ward, CFM
Surveyor of Hamilton County
Phone (317) 776-8495
Fax (317) 776-9628

Suite 188
One Hamilton County Square
Noblesville, Indiana 46060-2230

Map Correction-Field Verification

Drain Number: #315

Drain Length: n/a

Drain Name: JR Collins: Illinois St. Improv.

Change + / - : n/a


Date: 2006

New Length: 8

Verified By: SLM 12-05-2016

Notes & Sketch:

Road improvements at Illinois Street set Str. 201 and added 8' feet to the drain. It was tied into the existing Hamilton Crossing West Phase II arm.

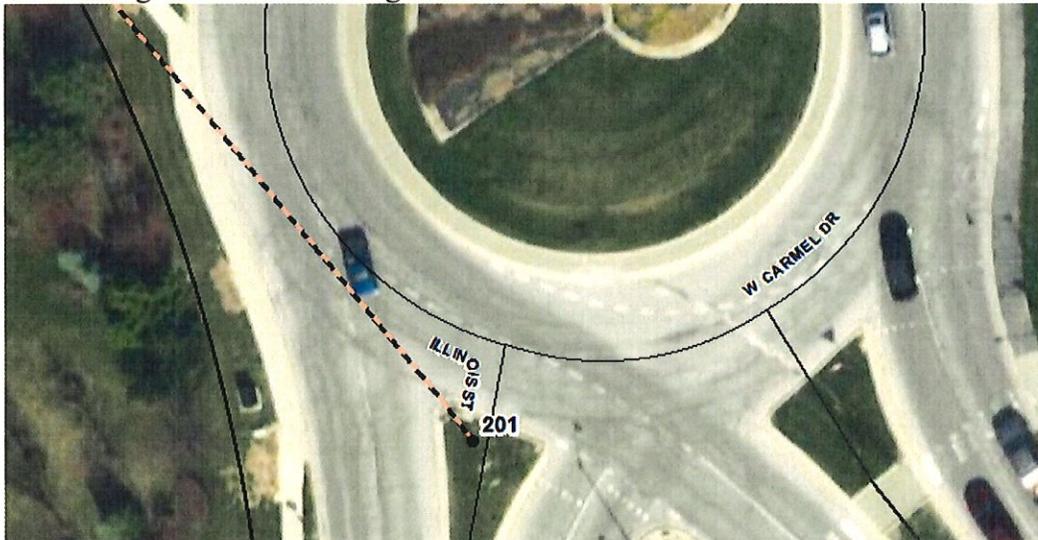

Suzanne L. Mills
Suzanne L. Mills
GIS Specialist