

*Kenton C. Ward, CEM*  
*Surveyor of Hamilton County*  
*Phone (317) 776-8495*  
*Fax (317) 776-9628*

*Suite 188*  
*One Hamilton County Square*  
*Noblesville, Indiana 46060-2230*

### ***Map Correction-Field Verification***

**Drain Number:** 315

**Drain Length:** 1965

**Drain Name:** Vernon Asher Drain

**Change + / - :** 285

**Date:** 02-02-2015

**New Length:** 2250


**Verified By:** SLM, GRH, SAB

---

**Notes & Sketch:** See attached map.

It was recently discovered that the Vernon Asher tile was not vacated from Station 39+60 to Station 42+45 (terminus). The 16" tile between these stations was installed in 1939. The tile was field located from the Manhole set on the tile with the Delta Faucet site to the east right of way line of US 31 as it existed in 1939. The tile had two visible blow holes on the tile just east of where the swale turns south.

Suzanne L. Mills  
GIS Specialist

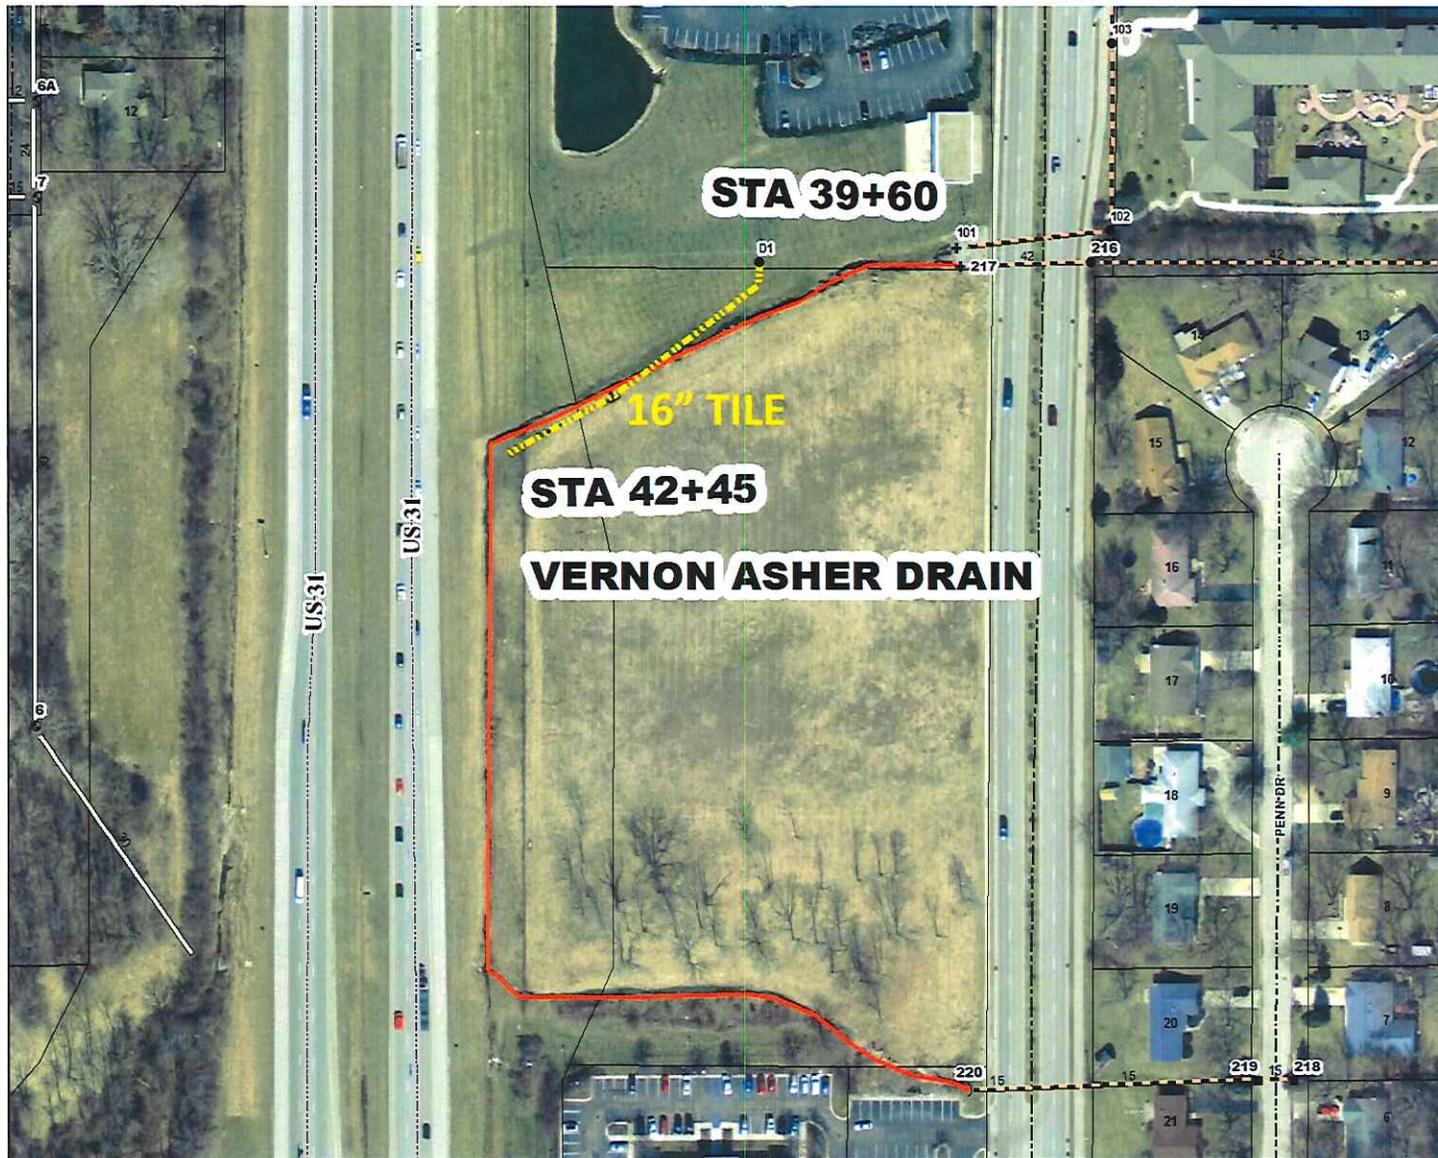

This map was compiled by the Hamilton County Surveyor's Office. Although strict accuracy standards have been employed in the compilation of this map, Hamilton County does not warrant or guarantee the accuracy of the information contained herein and disclaims any and all liability resulting from any error or omission in this map.

## VERNON ASHER DRAIN STA 39+60 TO 42+45 (TERMINUS)

Printing Date: 1/9/2015  
 Prepared By: Suzanne Mills, GISP  
 Hamilton County Surveyor's Office  
 One Hamilton County Square, Ste 18E  
 Noblesville, IN 46060  
 317-776-8495





2' TRUF. DITCH  
RIP-RAP REQ'D.

VIEW

FLOWLINE U.S. 31 DITCH  
FLOWLINE PROP. DITCH  
RIP-RAP REQ'D: 8" THICK  
VIEW

TAIL AT ENTRY  
31 DITCH


NOTE: NO CONSTRUCTION  
WITHIN STATE R/W  
WITHOUT PRIOR  
APPROVAL OF STATE  
HIGHWAY DEPT.

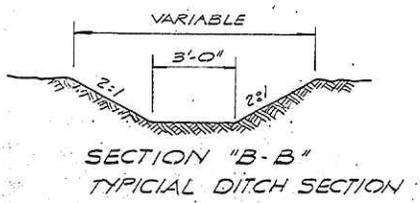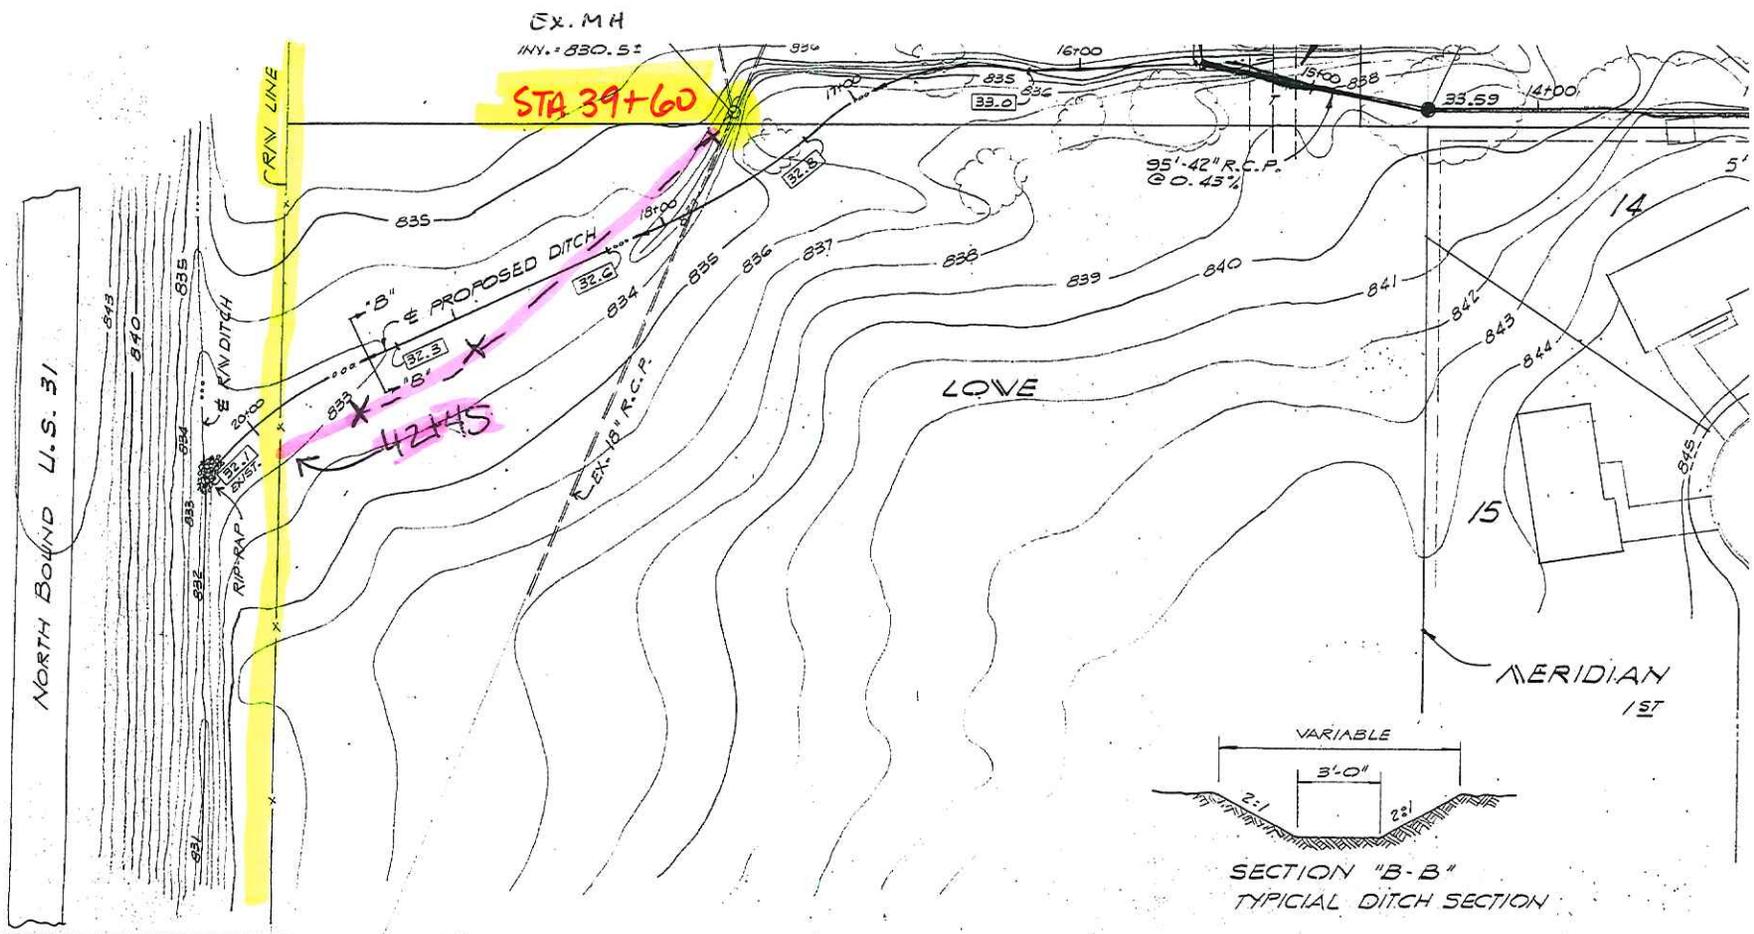

IT IS THE RESPONSIBILITY OF EACH  
PARTY TO VERIFY ALL EXISTING  
FIELD CONDITIONS PERTAINING  
TO THE USE OF THE WORK. IT SHALL  
BE THE CONTRACTOR'S RESPONSIBILITY  
TO NOTIFY THE ENGINEER  
OF ANY CHANGES, ERRORS OR  
OMISSIONS FOUND ON THESE PLANS OR  
FIELD BEFORE WORK IS STARTED.

NO. SECTION  
I. BELLE  
15416  
1/15/83

V. Asher Drain Ext.  
(Meridian Highlands)  
(Meridia Meadows) **Weine Engineers**  
JOB: 82-622  
1/3/83

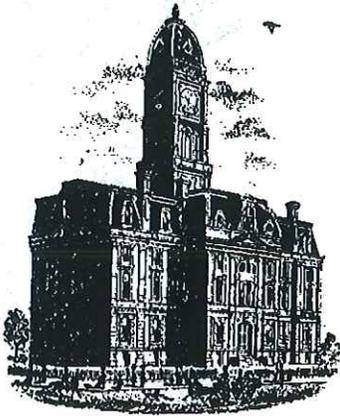

SURVEYOR'S OFFICE  
**Hamilton County**

Kenton C. Ward, Surveyor

776-9626

942 Maple Avenue

Noblesville, Indiana 46060

January 9, 1992

TO: Hamilton County Drainage Board

RE: Vernon W. Asher Drain

Attached is a petition to vacate a portion of the Vernon W. Asher Drain filed by MASCO Corporation of Indiana. The portion to be vacated is that portion across the MASCO (Aka Delta Faucet) Property.

The portion to be vacated is that portion between STA 32+65 and 39+60 as described in the original drain Viewers Report for a total of 695 feet of drain. This section was bypassed by the relocation of the drain done by Arbor Hospital. The tile drain as described in the original report will remain between STA 39+60, which is a manhole on or near Masco's South line, to the terminus of the tile in East U.S. #31 road side ditch. In so doing, Masco will be assured of an outlet.


Since the drain has been rerouted upstream, I do not foresee any

This copy printed from the Digital Archive of the Hamilton County Surveyor's Office; One Hamilton Co. Square, Ste. 188, Noblesville, In 46060

This copy printed from Digital Archive of the Hamilton County Surveyor's Office; One Hamilton Co. Square, Ste., Noblesville, In 46060

*Approved*

problem which could arise from this request. Therefore, I recommend the Board set a hearing for the request at its March meeting.

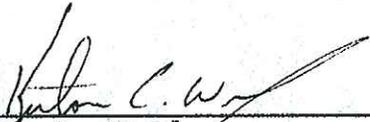

---

Kenton C. Ward  
Hamilton County Surveyor

KCW/no