

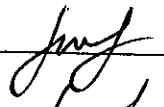
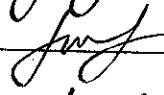



**Drain:** GEORGE PARKER **Drain #:** 31  
**Improvement/Arm:** \_\_\_\_\_  
**Operator:** J. LIVINGSTON **Date:** 5-19-04  
**Drain Classification:** Urban/Rural **Year Installed:** 1890

### GIS Drain Input Checklist

- Pull Source Documents for Scanning
- Digitize & Attribute Tile Drains
- Digitize & Attribute Storm Drains
- Digitize & Attribute SSD
- Digitize & Attribute Open Ditch
- Stamp Plans
- Sum drain lengths & Validate
- Enter Improvements into Posse
- Enter Drain Age into Posse
- Sum drain length for Watershed in Posse
- Check Database entries for errors

  
 \_\_\_\_\_  
 \_\_\_\_\_  
 \_\_\_\_\_  
 \_\_\_\_\_  
 \_\_\_\_\_  
  
 \_\_\_\_\_  
  
 \_\_\_\_\_  
  
 \_\_\_\_\_  
  
 \_\_\_\_\_

Gasb 34 Footages for Historical Cost  
Drain Length Log

Drain-Improvement: GEORGE PARKER

Drain Type:	Size:	Length	Length (DB Query)	Length Reconcile	If Applicable	
					Price:	Cost:
TILE	2x10"	700'	700'		3 <sup>00</sup> "/lf	4,200 <sup>00</sup>
	2x12"	1650'	1650'		4 <sup>00</sup> "/lf	13,200 <sup>00</sup>
	1x12" 1x15"	510'	510'		4 <sup>00</sup> "/lf 5 <sup>00</sup> "/lf	4,590 <sup>00</sup>

Sum: 2860' 2860' \$21,990<sup>00</sup>

Final Report: \_\_\_\_\_

Comments:

---

---

---

---

---

---

---

State of Indiana, *Hamilton* County, ss:

We, the undersigned, Commissioners of Drainage, swear that we have each personally examined each tract of land assessed for benefits and damages and the whole route of the proposed work, and that such drain is of sufficient capacity to carry, without overflowing, all the water which flows or should flow along such route; that no other lands than those described in this report will be either benefited or damaged by the construction of the proposed work, and that all the statements therein are true and correct, and that all assessments of benefits and injuries set forth therein are correct, just, fair and equitable to all parties concerned, as we verily believe.

*E. S. Stalker*  
*E. C. Cunningham*  
*J. M. Decker* } Commissioners.

Subscribed and sworn to by said Commissioners, this *2* day of *April*, 18*90*, before me.

*Jas W. Christian*  
Clerk Circuit Court.

Filed *April 2*, 18*90*  
*Jas W Christian*  
Clerk Circuit Court.

8174  
REPORT OF COMMISSIONERS.  
FAVORABLE.

## REPORT OF COMMISSIONERS.

To the Honorable Judge of the Hamilton Circuit Court:

The undersigned, Commissioners of Drainage, to whom was referred the petition of Frank Newby for the drainage of South west quarter of the South East quarter Section 14 Township 20 Range 5 East, and the North west quarter of the North East quarter, and the South west quarter of the North East quarter Section 20 Township 20 Range 5 East, all

in Hamilton County, respectfully report that they have inspected personally all the lands described in said petition, and all other lands liable to be affected by the construction of the proposed work, and are of the opinion that the proposed drainage will be practicable, conducive to the public health, and of public utility, and will benefit a public highway, and that the same can be constructed at an expense less than the aggregate benefits to lands affected, thereby, and after causing the necessary surveys and examinations to be made, are of the opinion that the method of drainage, should be as follows. To be tiled with two rows of 10 inch tile from Stake 6 to Stake 7, and two rows of 12 inch tile from Stake 7 to Stake 20 or 50 feet. Balance of ditch to be open 1 foot wide in bottom, side slopes  $\frac{1}{2}$  to 1 or 45° slopes, and dirt to be deposited not nearer than two feet from bed of bank. Tile portion to be cut in two separate and distinct channels about 12 feet apart, and one row of tile laid in each channel.

Continued on last page.

They estimate the cost of constructing the work at \$891<sup>50</sup> dollars. They further report that they have estimated the benefits and injury to the

several tracts of land which will be affected by the work, as follows:

OWNERS.	DESCRIPTION.	S.	T.	R.	Acres.	Injury: Acres Damaged	Benefit: Assessment.
George W. Sheets ✓	SW NW 14 20 5 40	14	20	5	40	30 A.	\$30.00
Frederick Goin ✓	SE NW 14 20 5 40	14	20	5	40	40 "	40.00
Philip Sheets ✓	NW SE 14 20 5 40	14	20	5	40	5 "	5.00
John Newby ✓	NW SW 14 20 5 40	14	20	5	40	5	5.00
Same ✓	NE SW 14 20 5 40	14	20	5	40	30	30.00
Same ✓	SW SW 14 20 5 40	14	20	5	40	10	10.00
Same ✓	SE SW 14 20 5 40	14	20	5	40	30	60.00
Frank Newby ✓	SW SW 14 20 5 40	14	20	5	40	40	240.00
Same ✓	NW NE 23 20 5 40	23	20	5	40	40	240.00
Same ✓	SW NE 23 20 5 40	23	20	5	40	20	105.00
Chalmer Jack ✓	NW NW 23 20 5 40	23	20	5	40	5	10.00
Same ✓	NE NW 23 20 5 40	23	20	5	40	25	50.00
J.W. Newby ✓	SW SW 13 20 5 40	13	20	5	40	5	5.00
Same ✓	SE SE 14 20 5 40	14	20	5	40	25	25.00
Same ✓	NE NE <sup>23</sup> 14 20 5 40	14	20	5	40	4	4.00
Isabell Carey ✓	NW NW 24 20 5 40	24	20	5	40	10.	10.00
Henry Parker ✓	SW NW 24 20 5 40	24	20	5	40	20.	20.00
Henry Parker ✓	NW SW 24 20 5 40	24	20	5	40	20	20.00
Geo Same ✓	SE NE 23 20 5 40	23	20	5	40	40	40.00
Elisha Holloway ✓	NE SW 24 20 5 40	24	20	5	40	5	10.00
James H. Kerr ✓	NE SE 23 20 5 40	23	20	5	40	15.	15.00
Marcus Webb ✓	NW SE 23 20 5 40	23	20	5	40	15.	15.00
White River Township Harrison Co	Public Highway ESW 23 20 5	23	20	5			25.00
Total Assessed Benefits							\$1050.00

# Newby Drain - Engineer's Report.

No. of Station.	Depth of Cut.	Width on Top.	Width in Bottom.	No. of Cubic Yards to be Removed.	Price per Cubic Yard.	Total Cost per Station.	
0.	3.5	16 in	12 in				Ditch to be
1.	4.2	"	"	36	12 1/2	\$20 10	tiled with two
2.	5.6	"	"	46	"	21 35	rows of 10 inch tile
3.	4.6	"	"	48	"	21 60	from state 0 to 7
4.	4.7	"	"	45	"	21 22	and from state 7
5.	4.1	"	"	41	"	20 73	to state 23 + 50 feet
6.	3.4	"	"	36	"	20 10	to be tiled with
7.	3.2	18"	14"	32	"	19 60	two rows of 12 in.
8.	4.3	"	"	42	"	27 45	tile.
9.	4.3	"	"	48	"	28 20	There is to be cut
10.	3.4	"	"	42	"	27 45	two separate and
11.	4.0	"	"	40	"	27 20	distinct channels
12.	3.6	"	"	42	"	27 45	for tile, and one
13.	3.9	"	"	42	"	27 45	row of tile to be
14.	5.5	"	"	52	"	28 70	laid in each
15.	6.7	"	"	68	"	30 70	channel.
16.	4.2	"	"	60	"	29 70	Channels to be
17.	2.3	"	"	46	"	27 95	one on either
18.	3.9	"	"	44	"	27 70	side of states
19.	3.8	"	"	42	"	27 45	and about 12 feet
20.	3.8	"	"	42	"	27 45	apart.
21.	4.5	"	"	46	"	27 95	The computation
22.	3.8	"	"	46	"	27 95	of cubic yards
23.	3.5	"	"	40	"	27 20	for the two channels
24.	3.4	7.8	17 foot.	28 } 13 }	12 1/2 13	18 80	is calculated and
25.	3.7	8.4	"	26	"	3 90	and given in
26.	3.7	8.4	"	26	"	3 90	the column for
27.	3.9	8.8	"	26	"	3 90	Cubic yards.
28.	3.5	8.0	"	25	"	3 75	
29.	4.0	9.0	"	24	"	3 60	
30.	4.7	10.4	"	22	"	3 30	
31.	4.6	10.2	"	23	"	3 45	

No. of Station.	Depth of Cut.	Width on Top.	Width in Bottom.	No. of Cubic Yards to be Removed.	Price per Cubic Yard.	Total Cost per Station.
32. cut.	4.3 2.1	9.6	1 Foot	24	15 <sup>d</sup>	\$ 3.60
33	4.9	10.8	"	24	"	3.60
34	5.0	11.0	"	24	"	3.60
35. cut	4.5 2.1	10.0	"	24	"	3.60
36.	7.2	15.4	"	28	"	4.20
37. cut	6.8 2.5	14.6	"	32	"	4.80
38.	6.4	13.8	"	34	"	5.10
39.	6.8	14.6	"	36	"	5.40
40. cut	7.2 2.8	15.4	"	39	"	5.85
41.	7.5	16.0	"	39	"	5.85
42.	7.3	15.6	"	39	"	5.85
43. cut.	6.8 2.8	14.6	"	39	"	5.85
44.	8.2	17.4	"	40	"	6.00
45. cut	7.2 2.9	15.4	"	42	"	6.30
46.	7.8	16.6	"	43	"	6.45
47.	6.6	14.2	"	45	"	6.75
48. cut.	7.8 3.1	16.6	"	47	"	7.05
49.	7.3	15.6	"	44	"	6.60
50.	7.8	16.6	"	41	"	6.15
51. cut	7.0 2.1	15.0	"	37.	"	5.55
52.	8.5	18.0	"	39.	"	5.85
53	7.5	16.0	"	40.	"	6.00
54. cut	7.5 2.9	16.0	"	42.	"	6.30
55.	7.4	15.8	"	40.	"	6.75
56.	6.5	14.0	"	48.	"	7.20
57. cut.	6.9 3.2	14.8	"	50.	"	7.50
58.	5.5	12.0	"	42	"	6.30
59.	5.2	11.2	"	32	"	4.80
60. cut.	5.2 2.0	11.2	"	22	"	3.30
61.	5.0	11.0	"	26	"	3.90
62.	3.5	8.0	"	30	"	4.50
63. cut	3.9	8.8	"	30	"	5.25

No. of Station.	Depth of Cut.	Width on Top.	Width in Bottom.	No. of Cubic Yards to be Removed.	Price per Cubic Yard.	Total Cost per Station.
64.	3.7	8.4	1.500	35	15 <sup>¢</sup>	5.25
65.	4.0	9.0	"	35	"	5.25
66.	4.0	9.0	"	42	"	6.30
67.	5.9	12.8	"	111	"	16.65
68.	4.5	10.0	"	119	"	17.85
69.	3.1	7.2	"	68	"	10.20
70.	2.7	6.4	"	42.	"	6.30
71.	2.1	5.2	"	30	"	4.50
72.	1.8	4.6	"	22	"	3.30
73.	1.2	4.4	"	14	"	2.10
73+30				5	"	.75
				<u>2926</u>		<u>\$891.50</u>

7845  
3571  
11000

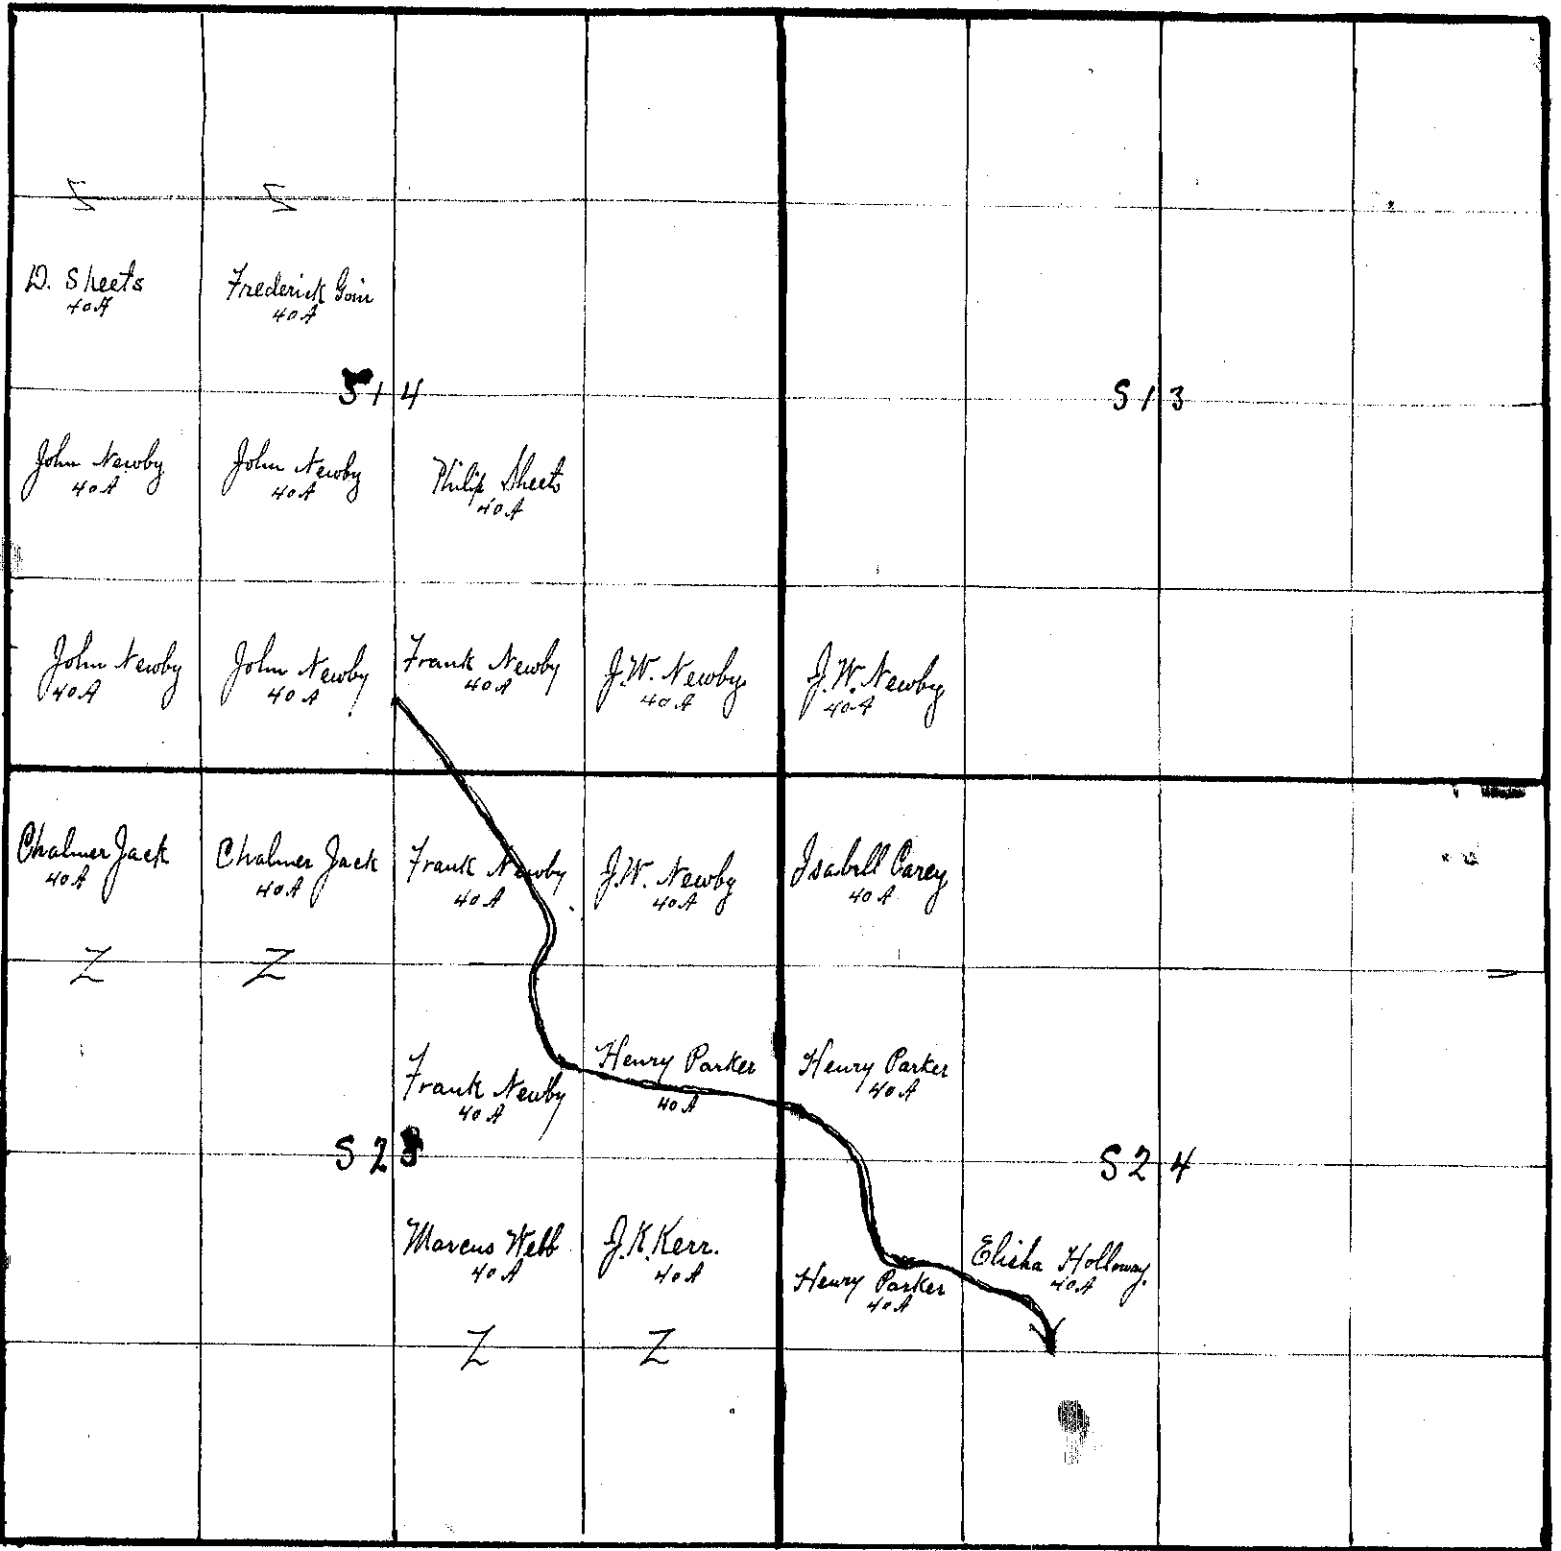
Excavating 1046 cu yds at 12 1/2<sup>¢</sup> = \$130.75  
 " 1880 " " 15 = 282.00  
 Cost 84 rd 10 in Tile on ground at \$1.25 = 105.00  
 " 198 " 12 " " " " " 1.20 = 236.40  
 " of 12x covering covering mouth of Tile 2.75  
 " Filling ditch. 14.60  
\$891.50

C. J. Cunningham  
 Engineer.

812.00  
 212.35  
 1587.00  
 200.00



Plat of Newby Ditch in Secs 13, 14, 23 & 24 T<sub>2</sub> R<sub>5</sub> E.



C. J. Cottingham  
Engineer.

By the construction of a ditch commencing about 30 rods north of the South West corner of the South East Quarter Section 14, Township 20 Range 5 East running thence S 45° E 1330 feet thence S 15° 30' W 490 feet, thence S 22° 30' E 530 feet, thence S 28° 30' E 450 feet thence S 52° E 290 feet, thence N 88° E 430 feet, thence N 81° E 425 feet thence N 67° E 60 feet, thence S 42° E 260 feet, thence S 81° 30' E 445 feet thence S 42° 30' E 455 feet, thence S 3° 30' W 460 feet, thence S 66° E 660 feet thence S 83° E 260 feet, thence S 72° E 240 feet, thence S 85° E 350 feet thence S 19° E 180 feet, and emptying into Bear Creek at a point about 30 rod east of the SW. corner of the NE 1/4 of the SW 1/4 Section 24. Twp. 20 R 5 East.

In the tile portion of said ditch the bottom is to be well surfaced, tile laid, and ditch left open until inspected, then covered. There is to be a box covering the ends of each row of tile at the mouth. To be made in a square box 6 feet long, and constructed of 2 inch plank and tile laid on inside of box.

There is to be a drop of six inches from bottom of tile ditch where it enters open ditch to the bottom of the open ditch.

0 to 7 w 100  
 7 to 23+50 23+50 w 100  
 23+50 to 50 w 115  
 50 to 60 w 200  
 60 to 73+30 w 30

All of which is respectfully submitted.

Eli Stalker

J. C. Cottingham

Wm. D. Decker

Commissioners.

# J. H. GENTRY

DEALER IN

## GROCERIES

GENTS' FURNISHING GOODS AND NOTIONS.

Arcadia, Ind. .... 190 .....

We all the parties interested in  
the Geo. Parker Ditch do hereby agree  
to change the grade from stake 61 to  
71. The change made is as follows.  
The fall to each 100 ft to be 25/100 ft to each  
100 ft. instead of 35/100 to each 100 ft.

Witness

Geo. Parker  
Henry Parker  
Levi Holmway  
M. C. Webb  
Fred P. Fain  
George B. Webb  
George A. Webb  
John Keenan  
James R. Keenan  
John Keenan

Witness

L. C. Kenby

To the Honorable Board of Commissioners of *Hamilton* County, Indiana:  
 We, the undersigned, appointed by this Court, at its *May Reg* Term, 1904, to view a drain described in the certified copy of a petition and order of Court for a *Drain*, by *Geo. Parker Et al* and others, handed us by the Auditor, would represent that according to said order we, on the day named therein, to wit: The *17<sup>th</sup>* day of *May*, 1904, in company with *H. Lindley*, a civil engineer, made an accurate survey of the line of said proposed *Drain*, from its source to its outlet. A plat of said *Drain* is filed herewith, including the survey by the engineer, marked "Exhibit *B*." We caused stakes to be set along said line, each one hundred feet, numbering down stream, as shown by plat. We also made a computation of the total number of cubic yards of earth to be removed from said drain, and estimated the total cost for the construction of the work at *\$1750.<sup>35</sup>/<sub>100</sub>* Dollars. We also apportioned and set apart to each parcel of land a share of said work in proportion to the benefits received, all of which will fully appear by a tabular statement in this report. We have also set out, by a statement below, the names of the owners of lands benefited, with a description of each tract of land, and the amount assessed against each tract. The depth of cut, the width at bottom, and width at top along said drain, is also shown in a tabular statement in this report. After a full and careful view and examination, we are of the opinion that the drain, as located by the survey, will be of *a public utility and a benefit to two or more public highways and that the cost of construction will be less than the benefits derived therefrom and the best method to secure said drainage, is by a drain as described on page 3 of this Report.*

The following statement shows who are benefited, the lands thereof and assessments thereon, location, length of each share, amount of assessments, amount of benefits, amount of dirt to be removed from each share, price thereof per cubic yard, and total cost of each share:

NAMES OF OWNERS.	DESCRIPTION OF LANDS.	Section.	Township.	Range.	Acres Assessed.	Acres Benefited.		Amount of Benefits.	Amount of Assessments.	From Station.	To Station.	Feet Long.	Cuts Cubic Yards to be Removed	Price per Cubic Yard.	Cost of Construction of Share.
						H/ths Assessed.	H/ths Benefited.								
<i>Geo D Sheets</i>	<i>H. SW</i>	<i>SW</i>	<i>14</i>	<i>20</i>	<i>5</i>	<i>30</i>	<i>30</i>	<i>4500</i>	<i>6250</i>				<i>4.21</i>	<i>✓</i>	
<i>"</i>	<i>W 1/2 N 1/2</i>	<i>SE</i>	<i>14</i>	<i>20</i>	<i>5</i>	<i>5</i>	<i>5</i>	<i>17.50</i>							
<i>Fredrick Goins</i>	<i>SE</i>	<i>SW</i>	<i>14</i>	<i>20</i>	<i>5</i>	<i>40</i>	<i>40</i>	<i>6000</i>	<i>6000</i>				<i>4.05</i>		
<i>John Kemby</i>	<i>H SW</i>	<i>SW</i>	<i>14</i>	<i>20</i>	<i>5</i>	<i>15</i>	<i>15</i>	<i>2250</i>	<i>4050</i>				<i>2.73</i>		
<i>"</i>	<i>H NW</i>	<i>SW</i>	<i>14</i>	<i>20</i>	<i>5</i>	<i>12</i>	<i>12</i>	<i>1800</i>							
<i>Chas O. Kemby</i>	<i>NE</i>	<i>SW</i>	<i>14</i>	<i>20</i>	<i>5</i>	<i>40</i>	<i>40</i>	<i>6000</i>	<i>20250</i>				<i>13.65</i>		
<i>"</i>	<i>H-SE</i>	<i>SW</i>	<i>14</i>	<i>20</i>	<i>5</i>	<i>35</i>	<i>35</i>	<i>14250</i>							
<i>John W. Kemby</i>	<i>SW</i>	<i>SE</i>	<i>14</i>	<i>20</i>	<i>5</i>	<i>40</i>	<i>40</i>	<i>180.00</i>	<i>57400</i>				<i>38.70</i>		
<i>"</i>	<i>H-SE</i>	<i>SE</i>	<i>14</i>	<i>20</i>	<i>5</i>	<i>25</i>	<i>25</i>	<i>8750</i>							
<i>"</i>	<i>H. SW</i>	<i>SW</i>	<i>13</i>	<i>20</i>	<i>5</i>	<i>5</i>	<i>5</i>	<i>750</i>							
<i>"</i>	<i>NE</i>	<i>NE</i>	<i>23</i>	<i>20</i>	<i>5</i>	<i>40</i>	<i>40</i>	<i>18000</i>							
<i>"</i>	<i>H-NW</i>	<i>NW</i>	<i>24</i>	<i>20</i>	<i>5</i>	<i>10</i>	<i>10</i>	<i>3500</i>							
<i>"</i>	<i>NW</i>	<i>NE</i>	<i>23</i>	<i>20</i>	<i>5</i>	<i>40</i>	<i>40</i>	<i>210.00</i>							
<i>"</i>	<i>H-SW</i>	<i>NE</i>	<i>23</i>	<i>20</i>	<i>5</i>	<i>20</i>	<i>20</i>	<i>9400</i>							
<i>Credit by work performed by Kemby</i>								<i>907</i>	<i>22000</i>						
<i>Geo Parker</i>	<i>SE</i>	<i>NE</i>	<i>23</i>	<i>20</i>	<i>5</i>	<i>40</i>	<i>40</i>	<i>27000</i>	<i>49125</i>				<i>33.12</i>		
<i>"</i>	<i>SW</i>	<i>NW</i>	<i>24</i>	<i>20</i>	<i>5</i>	<i>40</i>	<i>40</i>	<i>22125</i>							
<i>Henry Parker</i>	<i>H NW</i>	<i>SW</i>	<i>24</i>	<i>20</i>	<i>5</i>	<i>30</i>	<i>30</i>	<i>20750</i>	<i>20750</i>				<i>13.65</i>		
<i>Sarah Edwards</i>	<i>H-NW 1/2</i>	<i>NE NW</i>	<i>24</i>	<i>20</i>	<i>5</i>	<i>4</i>	<i>4</i>	<i>600</i>	<i>600</i>				<i>4</i>		
<i>Leri Halliway</i>	<i>H-SE</i>	<i>SW</i>	<i>24</i>	<i>20</i>	<i>5</i>	<i>5</i>	<i>5</i>	<i>1750</i>	<i>1750</i>				<i>41.18</i>		

TABULAR STATEMENT OF ASSESSMENTS, BENEFITS, ETC.

TABULAR STATEMENT OF STATIONS, WIDTH, DEPTH, LENGTH, ETC.

NAMES OF OWNERS.	DESCRIPTION OF LANDS.	Section.	Township.	Range.	Acres Assessed.	Ft. to be Assessed.	Acres Benefited.	Ft. to be Benefited.	Amount of Benefits.	Amount of Assessments.	From Station.	To Station.	Feet Long.	Cubic Yards to be Removed.	Price per Cubic Yard.	Cost of Construction of Share.
Jamies Karr	Pl-NE	NE	23	205	18	18	63.00	63.00	4.25							
Geo Webb Trf.	Pl-NE	NW	23	205	30	30	115.00	115.00	7.75							
Marcus O Webb	Pl-NW	SE	23	205	5	5	17.50	17.50	1.18							
Hamilton Co Public Highway	Ureania G.R. 14						45.00	45.00	3.03							
White River Township Public Highway	Pruefat N.S. 13						10.00	10.00	.69							

**Location** - By the construction of a ditch beginning about 30 rods North of the Southwest corner of the Southeast quarter of Section 14, Township 23 Range 5 East; running thence S 45° E 1330 ft; thence S 15° 30' W 490 ft; thence S. 22° 30' E 530 ft; thence S. 28° 30' E 450 ft; thence S 52° E 290 ft; thence N 88° E 435 ft; thence N 81° E 425 ft; thence S 67° E 60 ft; thence S 42° E 260 ft; thence S 81° 30' E 445 ft; thence S 42° 30' E 445 ft; S 72° E 240 ft; thence S. 83° E 350 ft; thence S 19° E 180 ft and emptying into Bear Creek at a point about 35 rods East of the S. W. corner of the N.E. 1/4 of the S. W. 1/4 of Section 24, Township 20 Range 5 East.

**Specifications** - Main ditch to consist of two rows of 10" tile from sta 0 to sta 7, and two rows of 12" tile from sta 7 to sta 23+50 and from sta 23+50 to sta 30 one row of 12" and one row of 15" tile. The above portion is already constructed and accepted as sufficient.

From sta 30 to sta 40+9.6 one row of 20" tile and from sta 40+9.6 to sta 41 one row of salt glazed sewer tile and an open ditch two feet wide in bottom from sta 41 to sta 43+80 or terminates with slopes of 1 to 1 or 45°

GENERAL SPECIFICATIONS AND SUGGESTIONS.

The length of the ditch as located is	7380 ft		
The fall of the established grade is	60	feet, from Station	0 to Station 7
"	30	"	" " 23+50
"	15	"	" " 50
"	25	"	" " 60
"	30	"	" " 71
"	25	"	" " 73+80
The total fall is	225	"	"

A drop in grade of 25/100 at sta 71.

**Requirements** - At sta 30 to be constructed a catch basin built from hard burnt brick, laid up in mortar, made from one part Portland cement to two parts good sharp sand, and to be covered with iron ring and open cover of the Ewald Over pattern. Dimensions of cover twenty inches, Dimensions of basin 4' x 3' x 9"

**Stone wall** - At Sta 71 to be constructed a stone retaining wall. Dimensions 12' x 5' x 2'. Said wall shall be built from field rock or niggerheads laid up in mortar made from one part Portland cement to three parts good sharp sand so constructed as to receive the tile at proper grade 18" above base of wall

All tile used in construction of said drain to be first class in every respect and shall be laid in ditch in a true line at proper grade with joints well matched and shall be left uncovered until inspected and accepted by the County Surveyor. After grade and tile have been accepted the trench of ditch over tile shall be filled with earth to a depth of at least 24 inches over top of tile. All material subject to inspection of County Surveyor

For the Re-viewers would further report that in our opinion it would be unpracticable to allot said drain for construction so we believe that the work can be better done and in less time to sell same to one contractor and we would recommend that the Auditor sell same in one contract as provided by law.

J. J. Driver  
H. A. McMullans  
W. E. Marz

Subscribed and sworn to before me, this 28 day of May 1904  
Isaac Powell Auditor Hamilton County.

148 3

No.

IN THE MATTER OF

Geo Parker

Drain

Approved June 10 1904  
and viewers ordered  
to make final

Report  
June 19 - 1904

Henry [unclear] P.P.

Report of Ditch Viewers.

COMMISSIONERS' COURT.

1000.

1230.

250

Filed \_\_\_\_\_, 1.

Auditor.

Wm. B. Burford, Printer, Indianapolis. 500-2-25-'99.

Recorded  
D.R.#1. Pg 48, 49, 50+51, J.A.M.