

SURVEYOR'S OFFICE
Hamilton County

Kenton C. Ward, CFM
Surveyor of Hamilton County
Phone (317) 776-8495
Fax (317) 776-9628

Suite 188
One Hamilton County Square
Noblesville, Indiana 46060-2230

Map Correction-Field Verification

Drain Number: #247

Drain Length: 12469.15

Drain Name: Bentley Oaks Sec. 1 Arm

Change +/-: -1820.59


Date: 3-10-2011

New Length: 10,648.56



Verified By: SLM, LMC, JLL

Notes & Sketch: The city of Carmel widened 136th St. from Springmill Rd to approximately 5000' East. The changes that occurred with this road project removed 1747 feet of 6" SSD within the existing Right of Way. Also removed were the 12" RCP between structures 119 to 109 and 120 to 106. Therefore, 73.59 feet of 12" RCP was removed. (Sheets 10, 11) (Schneider - proj No. 06-07)

Suzanne L. Mills
GIS Specialist

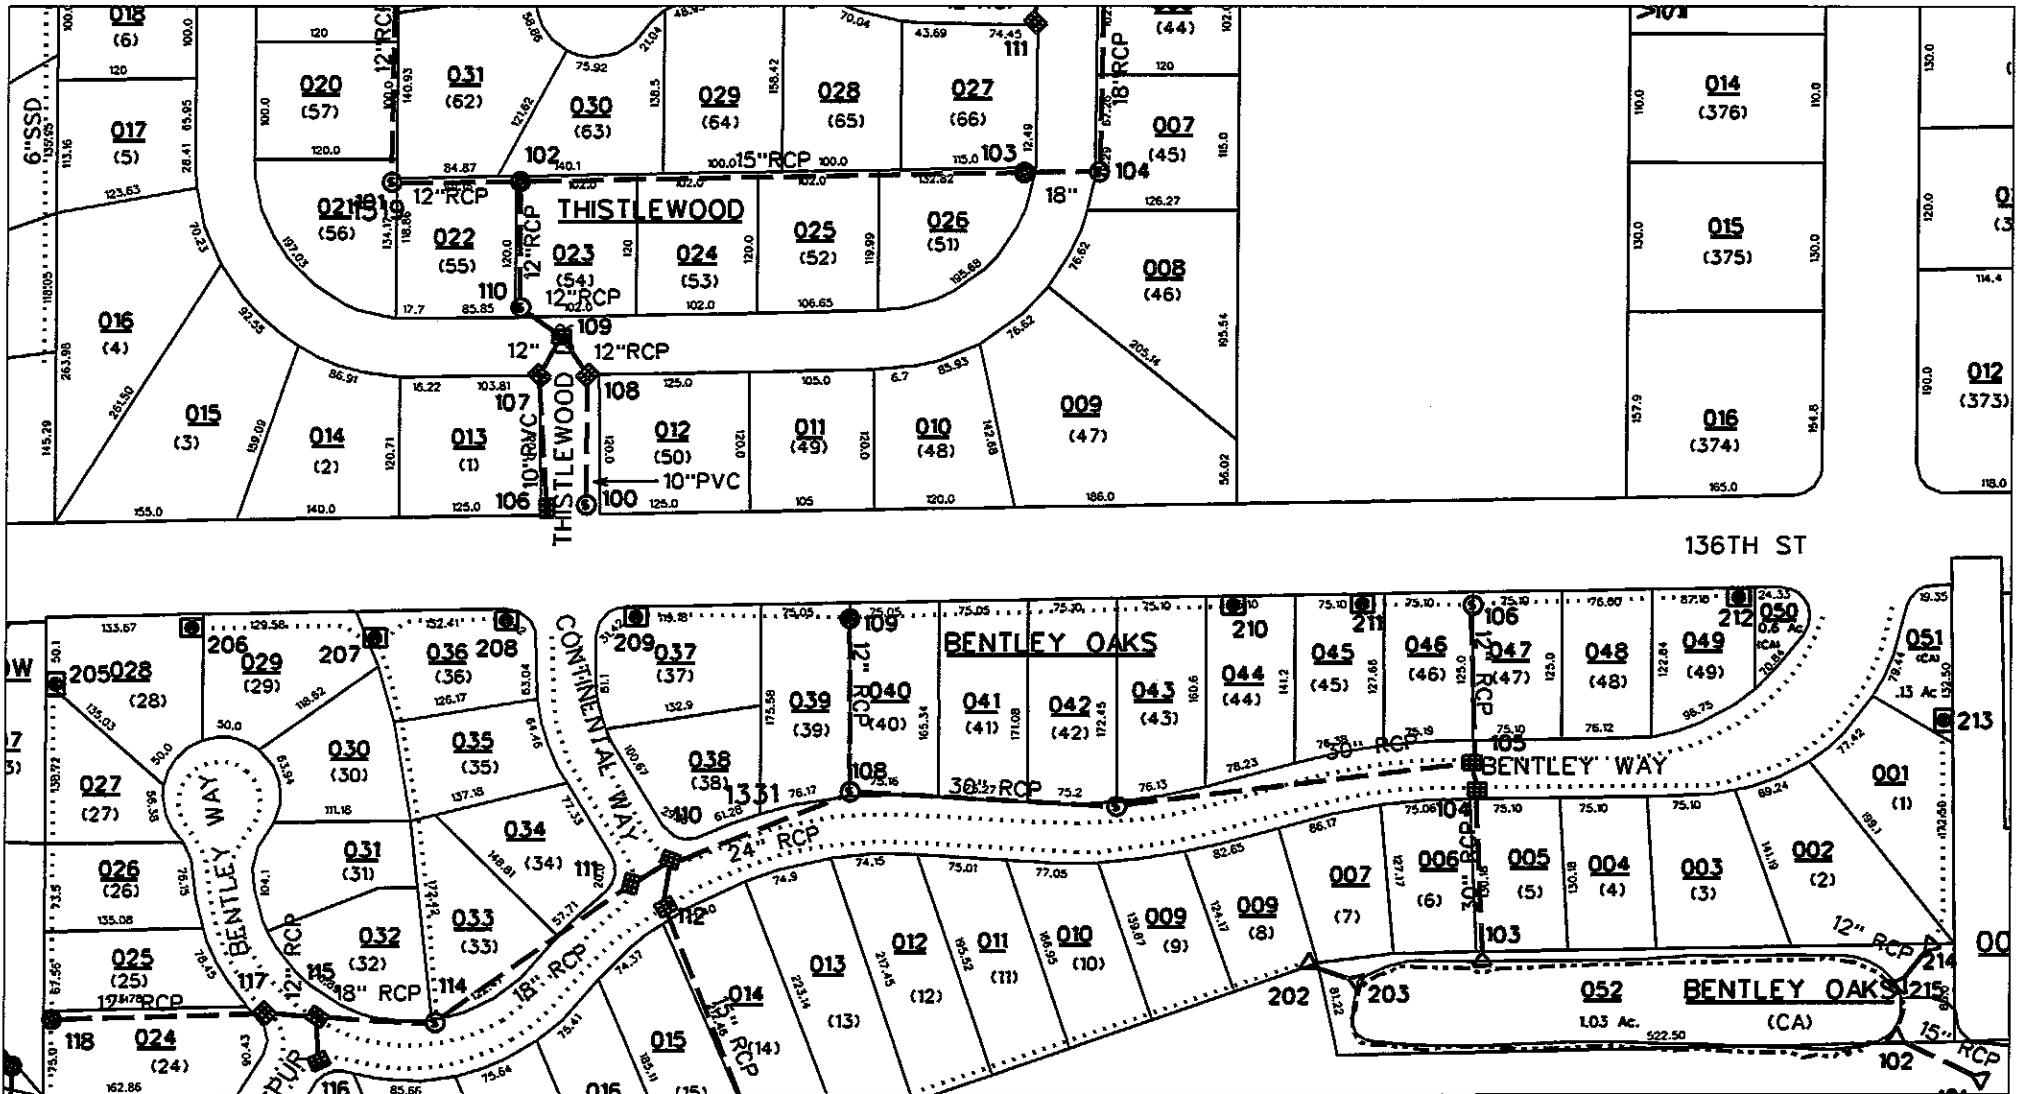

sub_rg_dm.dgn 3/16/2011 3:54:51 PM

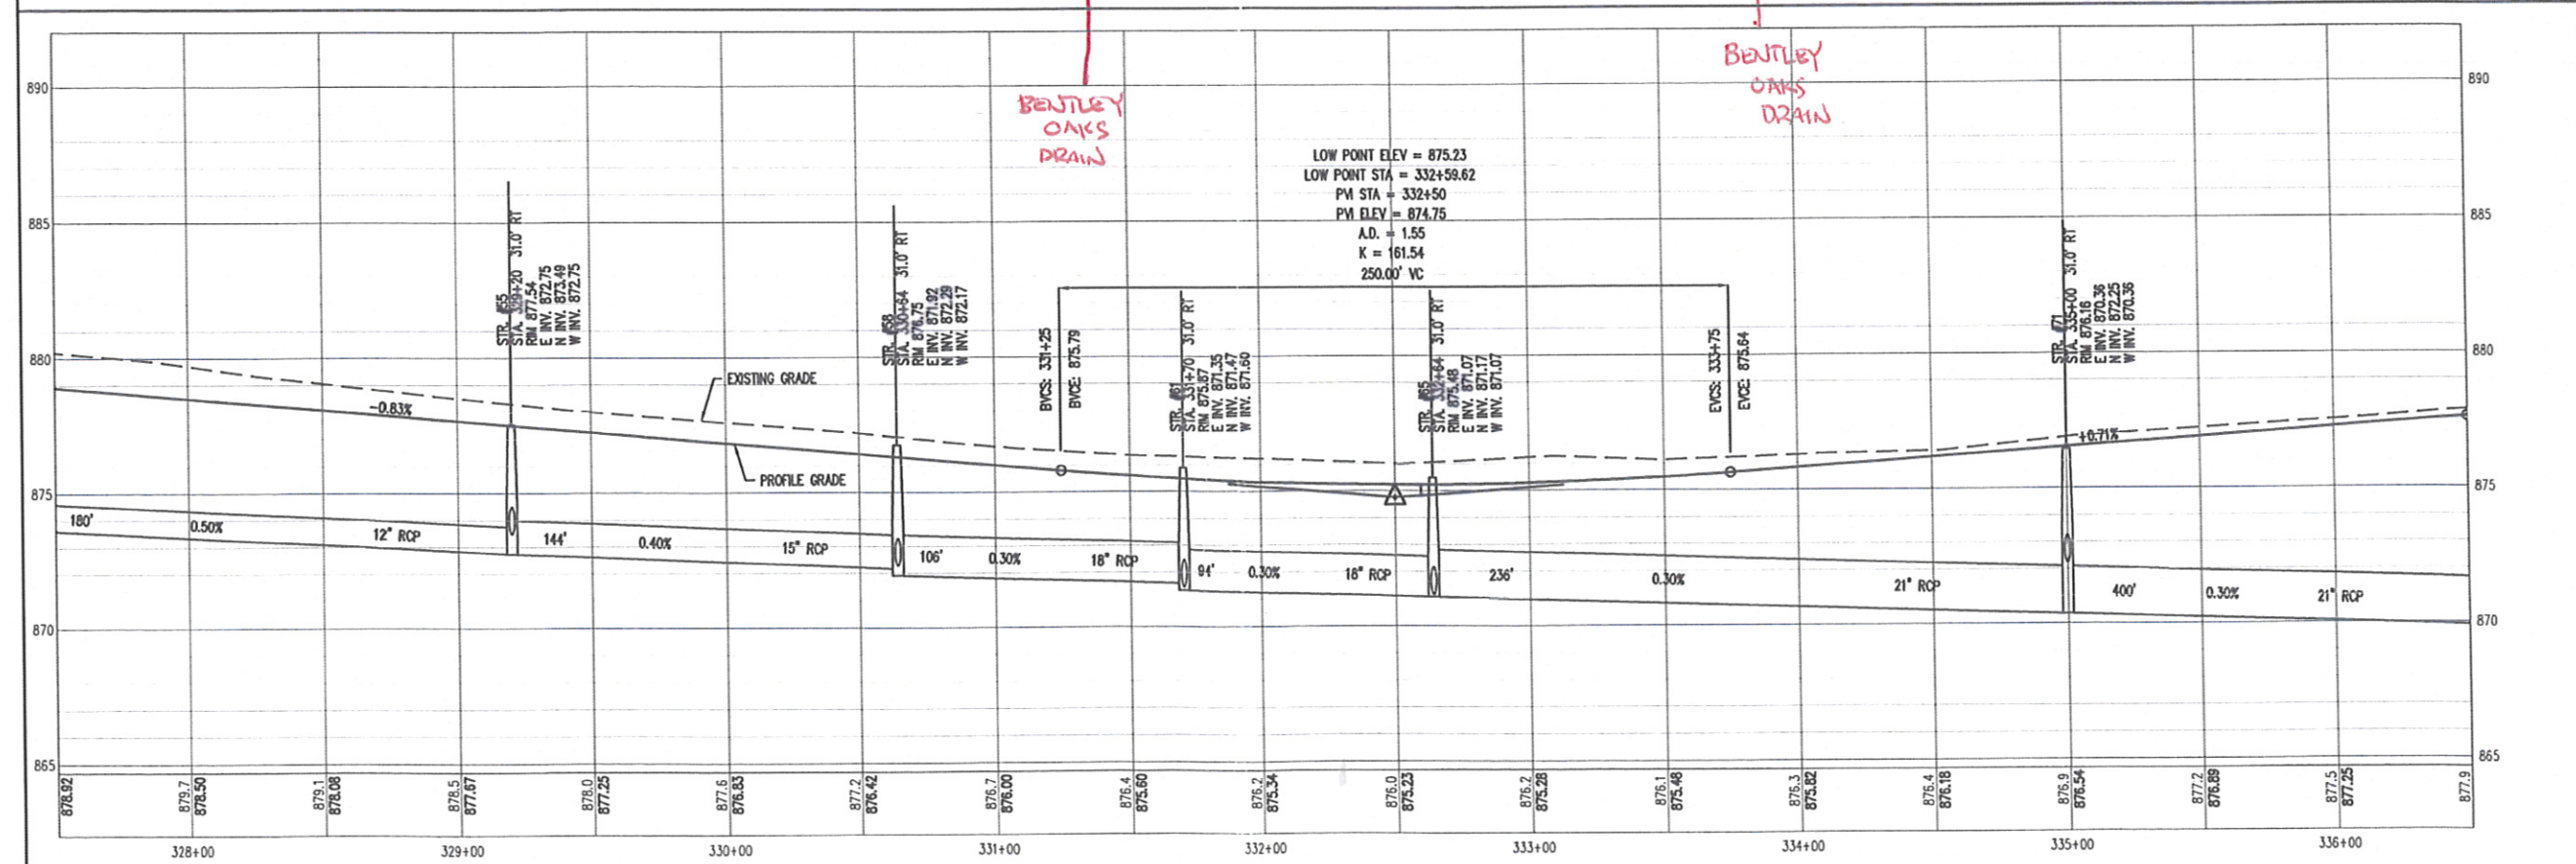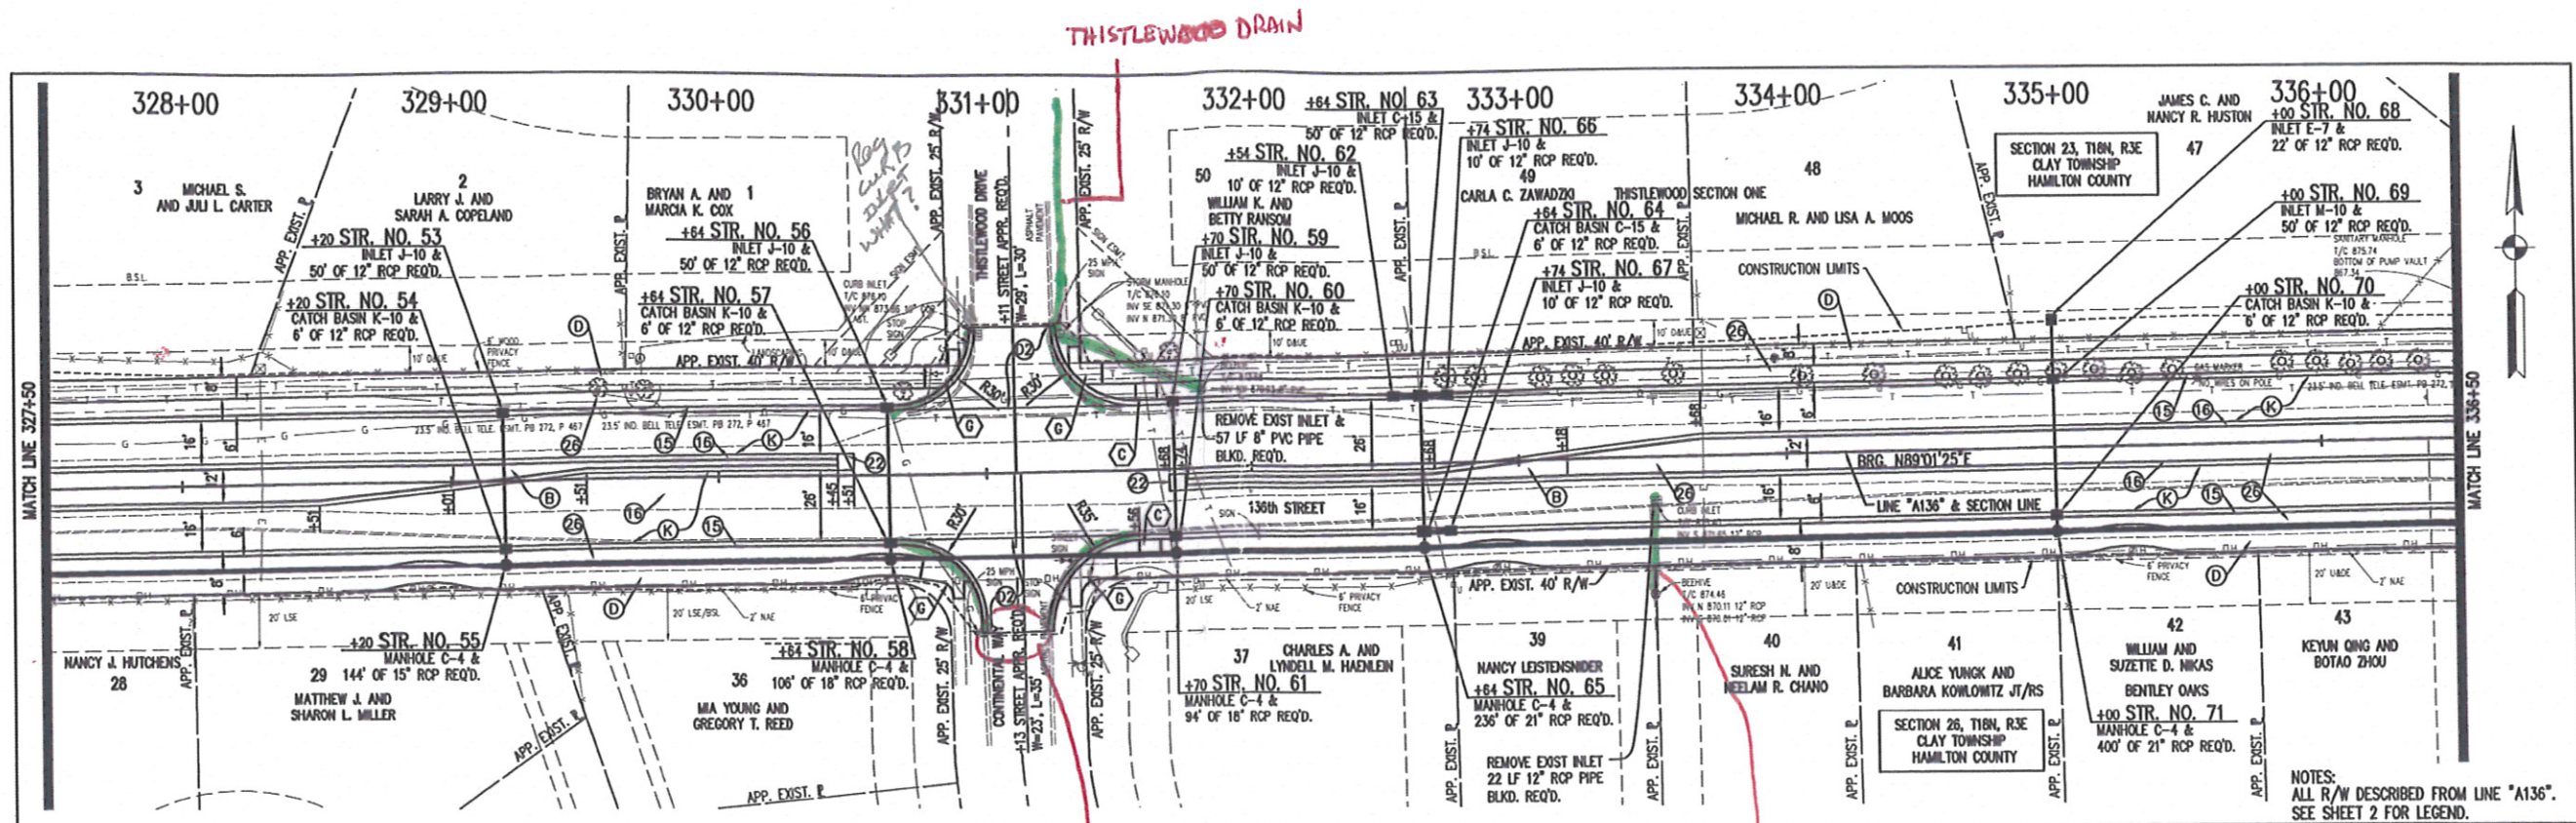

Historic Fort Harrison
8901 Otis Avenue
Indianapolis, Indiana
46216-1037
1-800-898-0332
317-828-7100


Formerly Schindler Engineering Corp. / Bohlen, Meyer, Gibson & Assoc.

RECOMMENDED FOR APPROVAL	Preliminary - Not For Construction
DESIGNED: SSB	DRAWN: SSB
CHECKED: ACD	CHECKED: ACD


CITY OF CARMEL


136th STREET
PLAN & PROFILE- LINE "A136"

HORIZONTAL SCALE 1"=30'	BRIDGE FILE
VERTICAL SCALE 1"=3'	DESIGNATION
SURVEY BOOK	SHEETS
CONTRACT	10 of 44
	PROJECT
	06-07

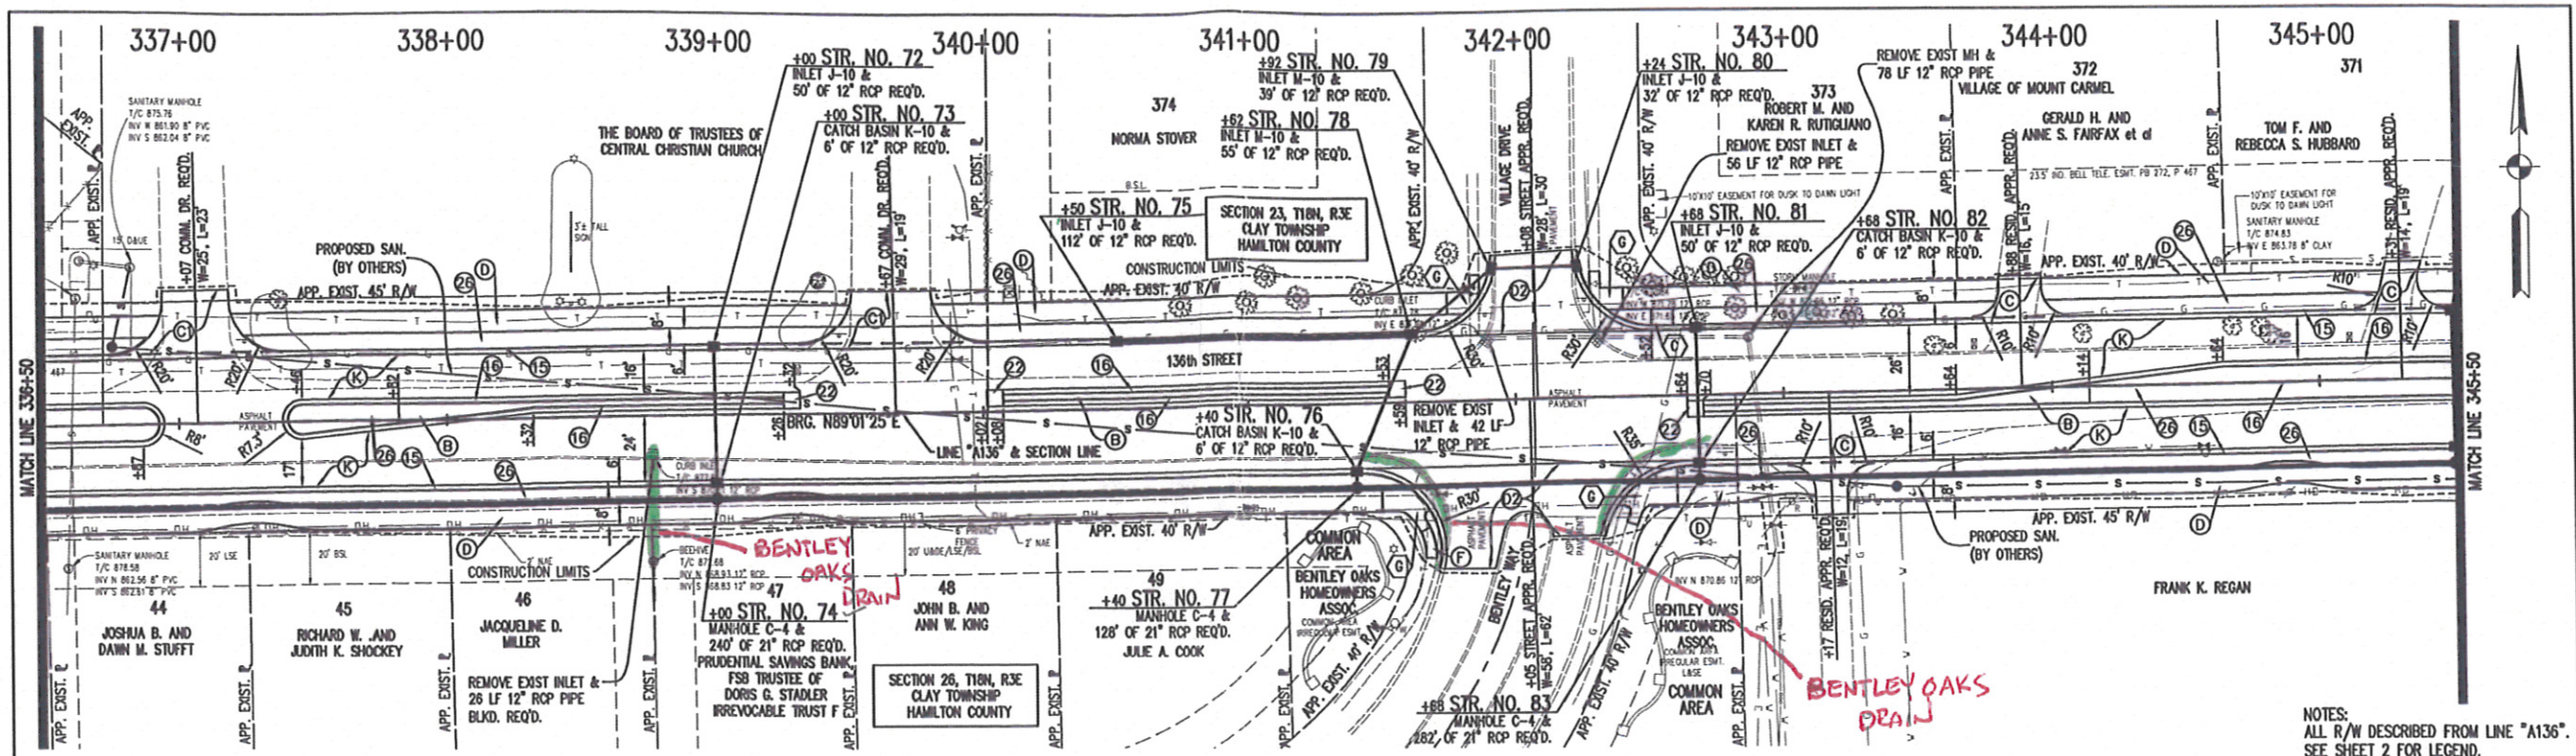

NOTES:
ALL R/W DESCRIBED FROM LINE "A136".
SEE SHEET 2 FOR LEGEND.

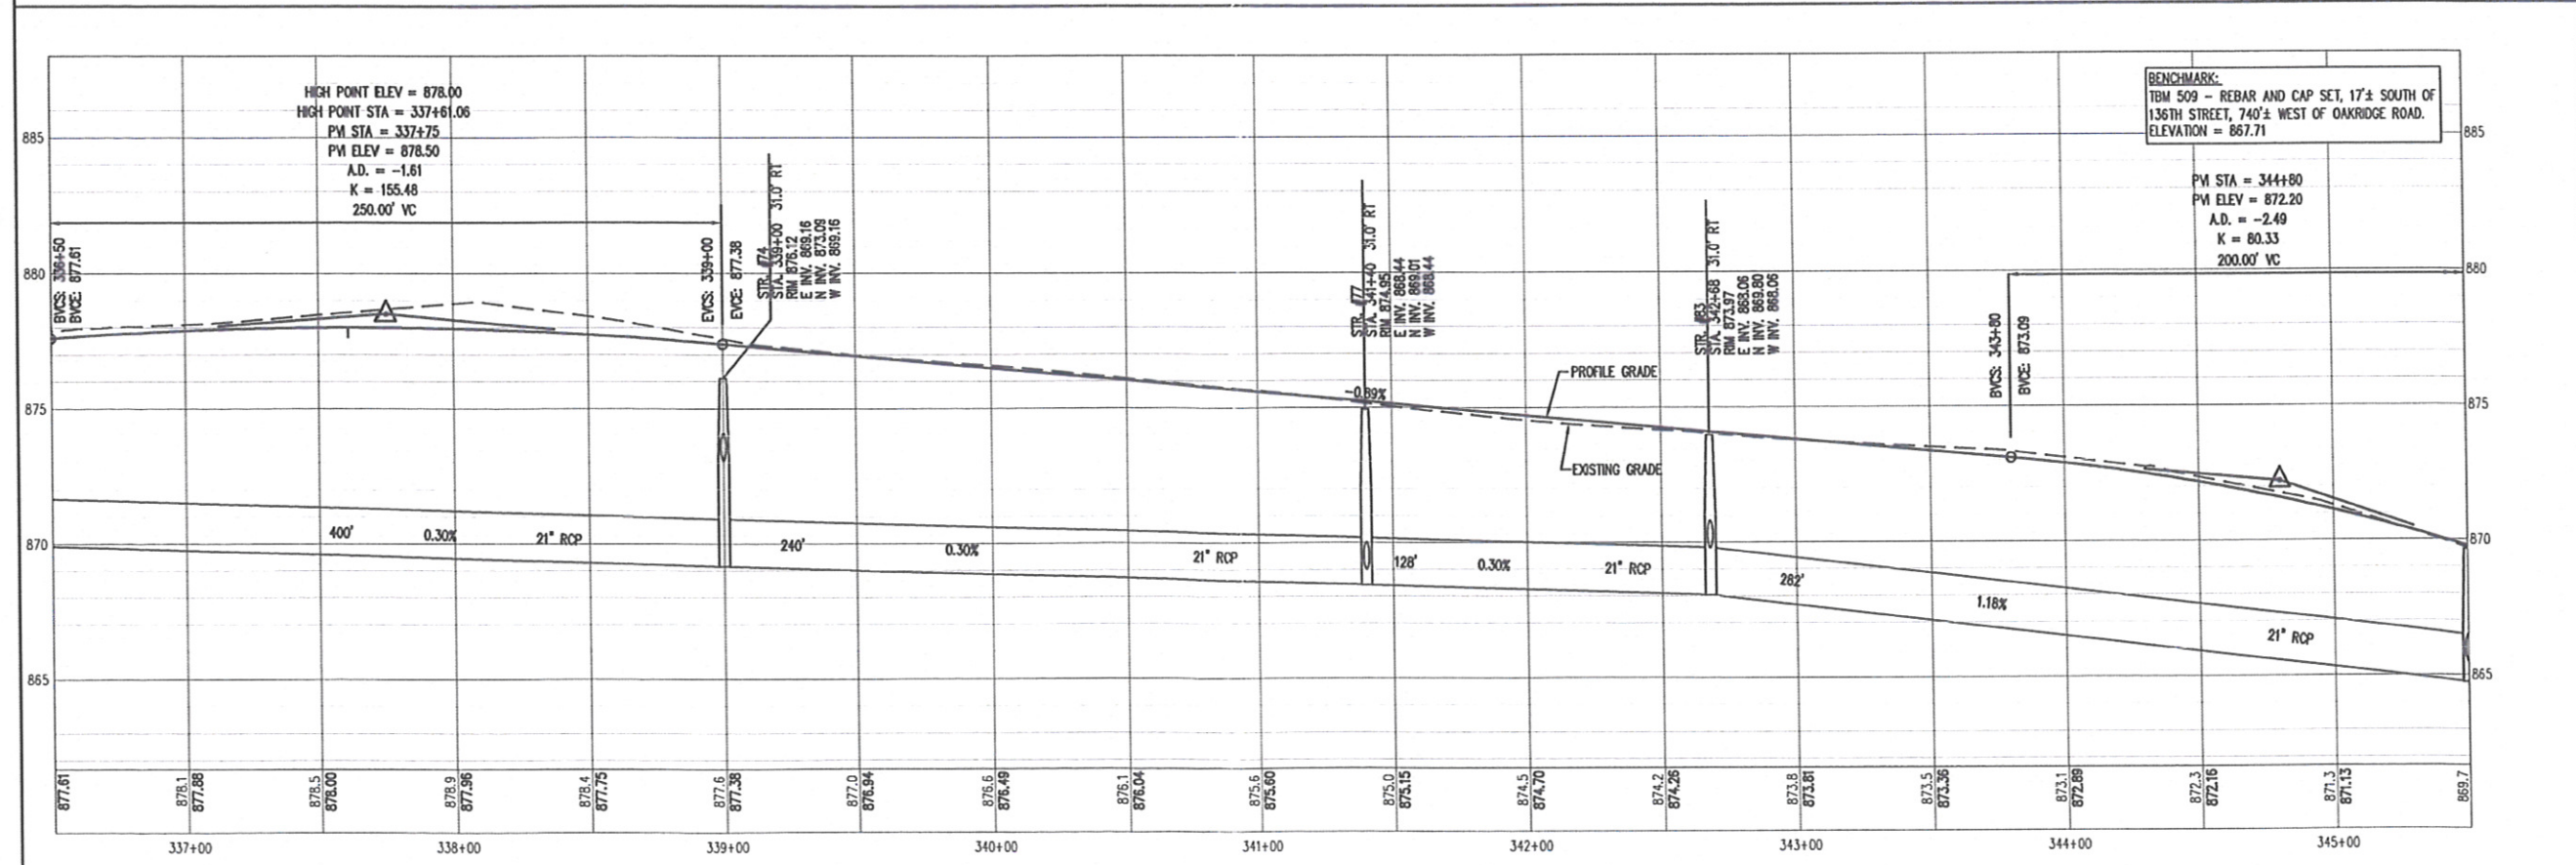

 <p>Historic Fort Harrison 8901 Otis Avenue Indianapolis, Indiana 46218-1037 1-800-898-0332 317-826-7100</p> <p>Formerly Schneider Engineering Corp. / Bohlen, Meyer, Gibson & Assoc.</p>	<p>RECOMMENDED FOR APPROVAL</p> <p>Preliminary - Not For Construction</p> <p>DESIGN ENGINEER DATE</p>	<p>CITY OF CARMEL</p> <p>136th STREET PLAN & PROFILE- LINE "A136"</p>	<p>HORIZONTAL SCALE 1"=30'</p> <p>VERTICAL SCALE 1"=3'</p>	<p>BRIDGE FILE</p> <p>DESIGNATION</p>
	<p>DESIGNED: SSB</p> <p>CHECKED: ACD</p>		<p>DRAWN: SSB</p> <p>CHECKED: ACD</p>	<p>SURVEY BOOK</p> <p>CONTRACT</p>