

Drain: OVERMAN - HARVEY Drain #: 32
Improvement/Arm: MURPHY DITCH
Operator: J. LIVINGSTON Date: 5-18-04
Drain Classification: Urban/Rural Year Installed: 1989

GIS Drain Input Checklist

- Pull Source Documents for Scanning JL
- Digitize & Attribute Tile Drains _____
- Digitize & Attribute Storm Drains JL
- Digitize & Attribute SSD _____
- Digitize & Attribute Open Ditch JL
- Stamp Plans JL
- Sum drain lengths & Validate JL
- Enter Improvements into Posse JL
- Enter Drain Age into Posse JL
- Sum drain length for Watershed in Posse JL
- Check Database entries for errors JL

Gasb 34 Footages for Historical Cost Drain Length Log

Drain-Improvement: OVERMAN - HARVEY - MURPHY DITCH

| Drain Type: | Size: | Length | Length (DB Query) | Length Reconcile | If Applicable | |
|-------------|---------|--------------|----------------------|---------------------|-----------------------|--------------------------------|
| | | | | | Price: | Cost: |
| RCP | 33" x 2 | 60' | 90' | 130' | 28. ⁵⁰ /lf | 5130. ⁰⁰ |
| OPEN DITCH | — | 1790' | 1790' | | 19. ⁵⁵ /lf | 34,994. ⁵⁰ |
| | | | | | | |
| | | | | | | |
| Sum: | | <u>1850'</u> | <u>1880'</u> | <u>130'</u> | | <u>\$ 40,124.⁵⁰</u> |

Final Report: 1850'

Comments:

ALL AVAILABLE AERIAL PHOTOGRAPHY SHOWS 90' OF 33" RCP UNDER 146TH ST. THE ADDITION WAS MADE PRIOR TO 1994.

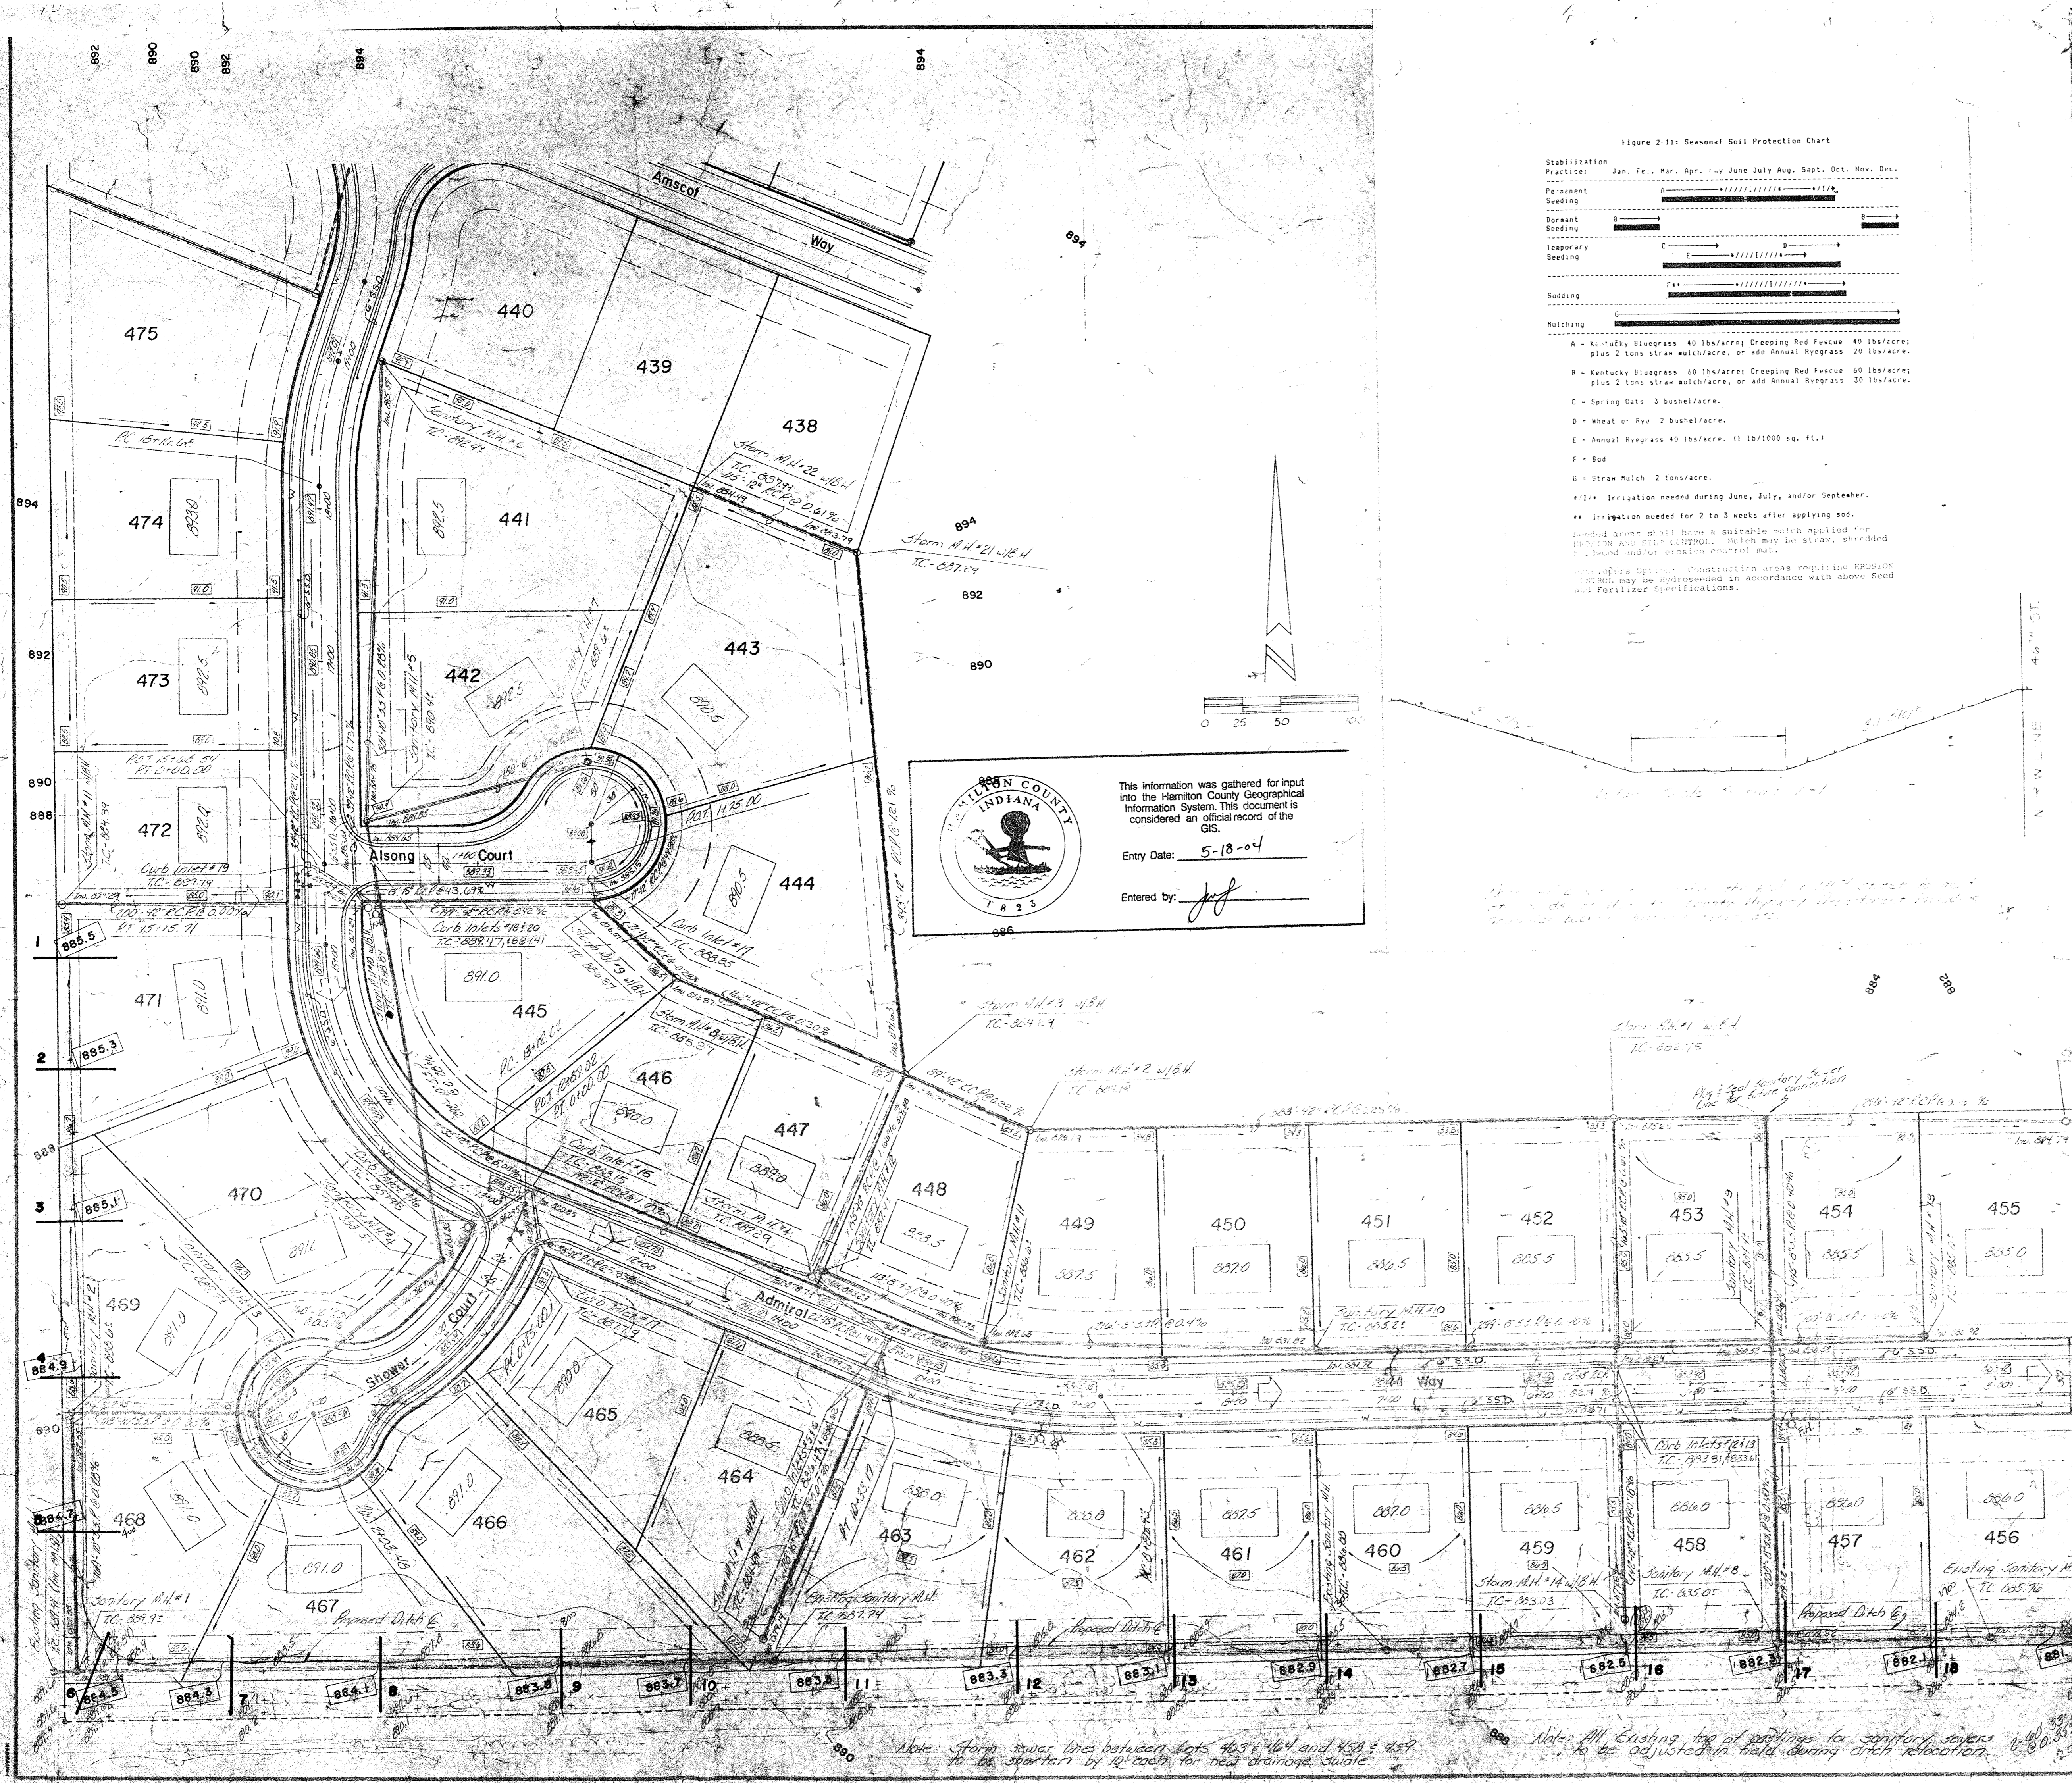


Figure 2-11: Seasonal Soil Protection Chart

| Practice | Jan. | Feb. | Mar. | Apr. | May | June | July | Aug. | Sept. | Oct. | Nov. | Dec. |
|-------------------|---|------|------|------|-----|------|------|------|-------|------|------|------|
| Stabilization | [Bar chart showing stabilization practices from Jan to Dec] | | | | | | | | | | | |
| Permeant | [Bar chart showing permeant practices from Jan to Dec] | | | | | | | | | | | |
| Seeding | [Bar chart showing seeding practices from Jan to Dec] | | | | | | | | | | | |
| Spraying | [Bar chart showing spraying practices from Jan to Dec] | | | | | | | | | | | |
| Temporary Seeding | [Bar chart showing temporary seeding practices from Jan to Dec] | | | | | | | | | | | |
| Sodding | [Bar chart showing sodding practices from Jan to Dec] | | | | | | | | | | | |

Mulching

- C = Spring Oats 3 bushels/acre.
- D = wheat or Rye 2 bushels/acre.
- E = Annual Ryegrass 40 lbs/acre, 11 15/1600 sq. ft.
- F = Sod
- G = Straw Mulch 2 tons/acre.

••• Irrigation needed during June, July, and/or September.

••• Irrigation needed for 2 to 3 weeks after applying sod.




This information was gathered for input into the Hamilton County Geographical Information System. This document is considered an official record of the GIS.

Entry Date: 5-18-04

Entered by: [Signature]

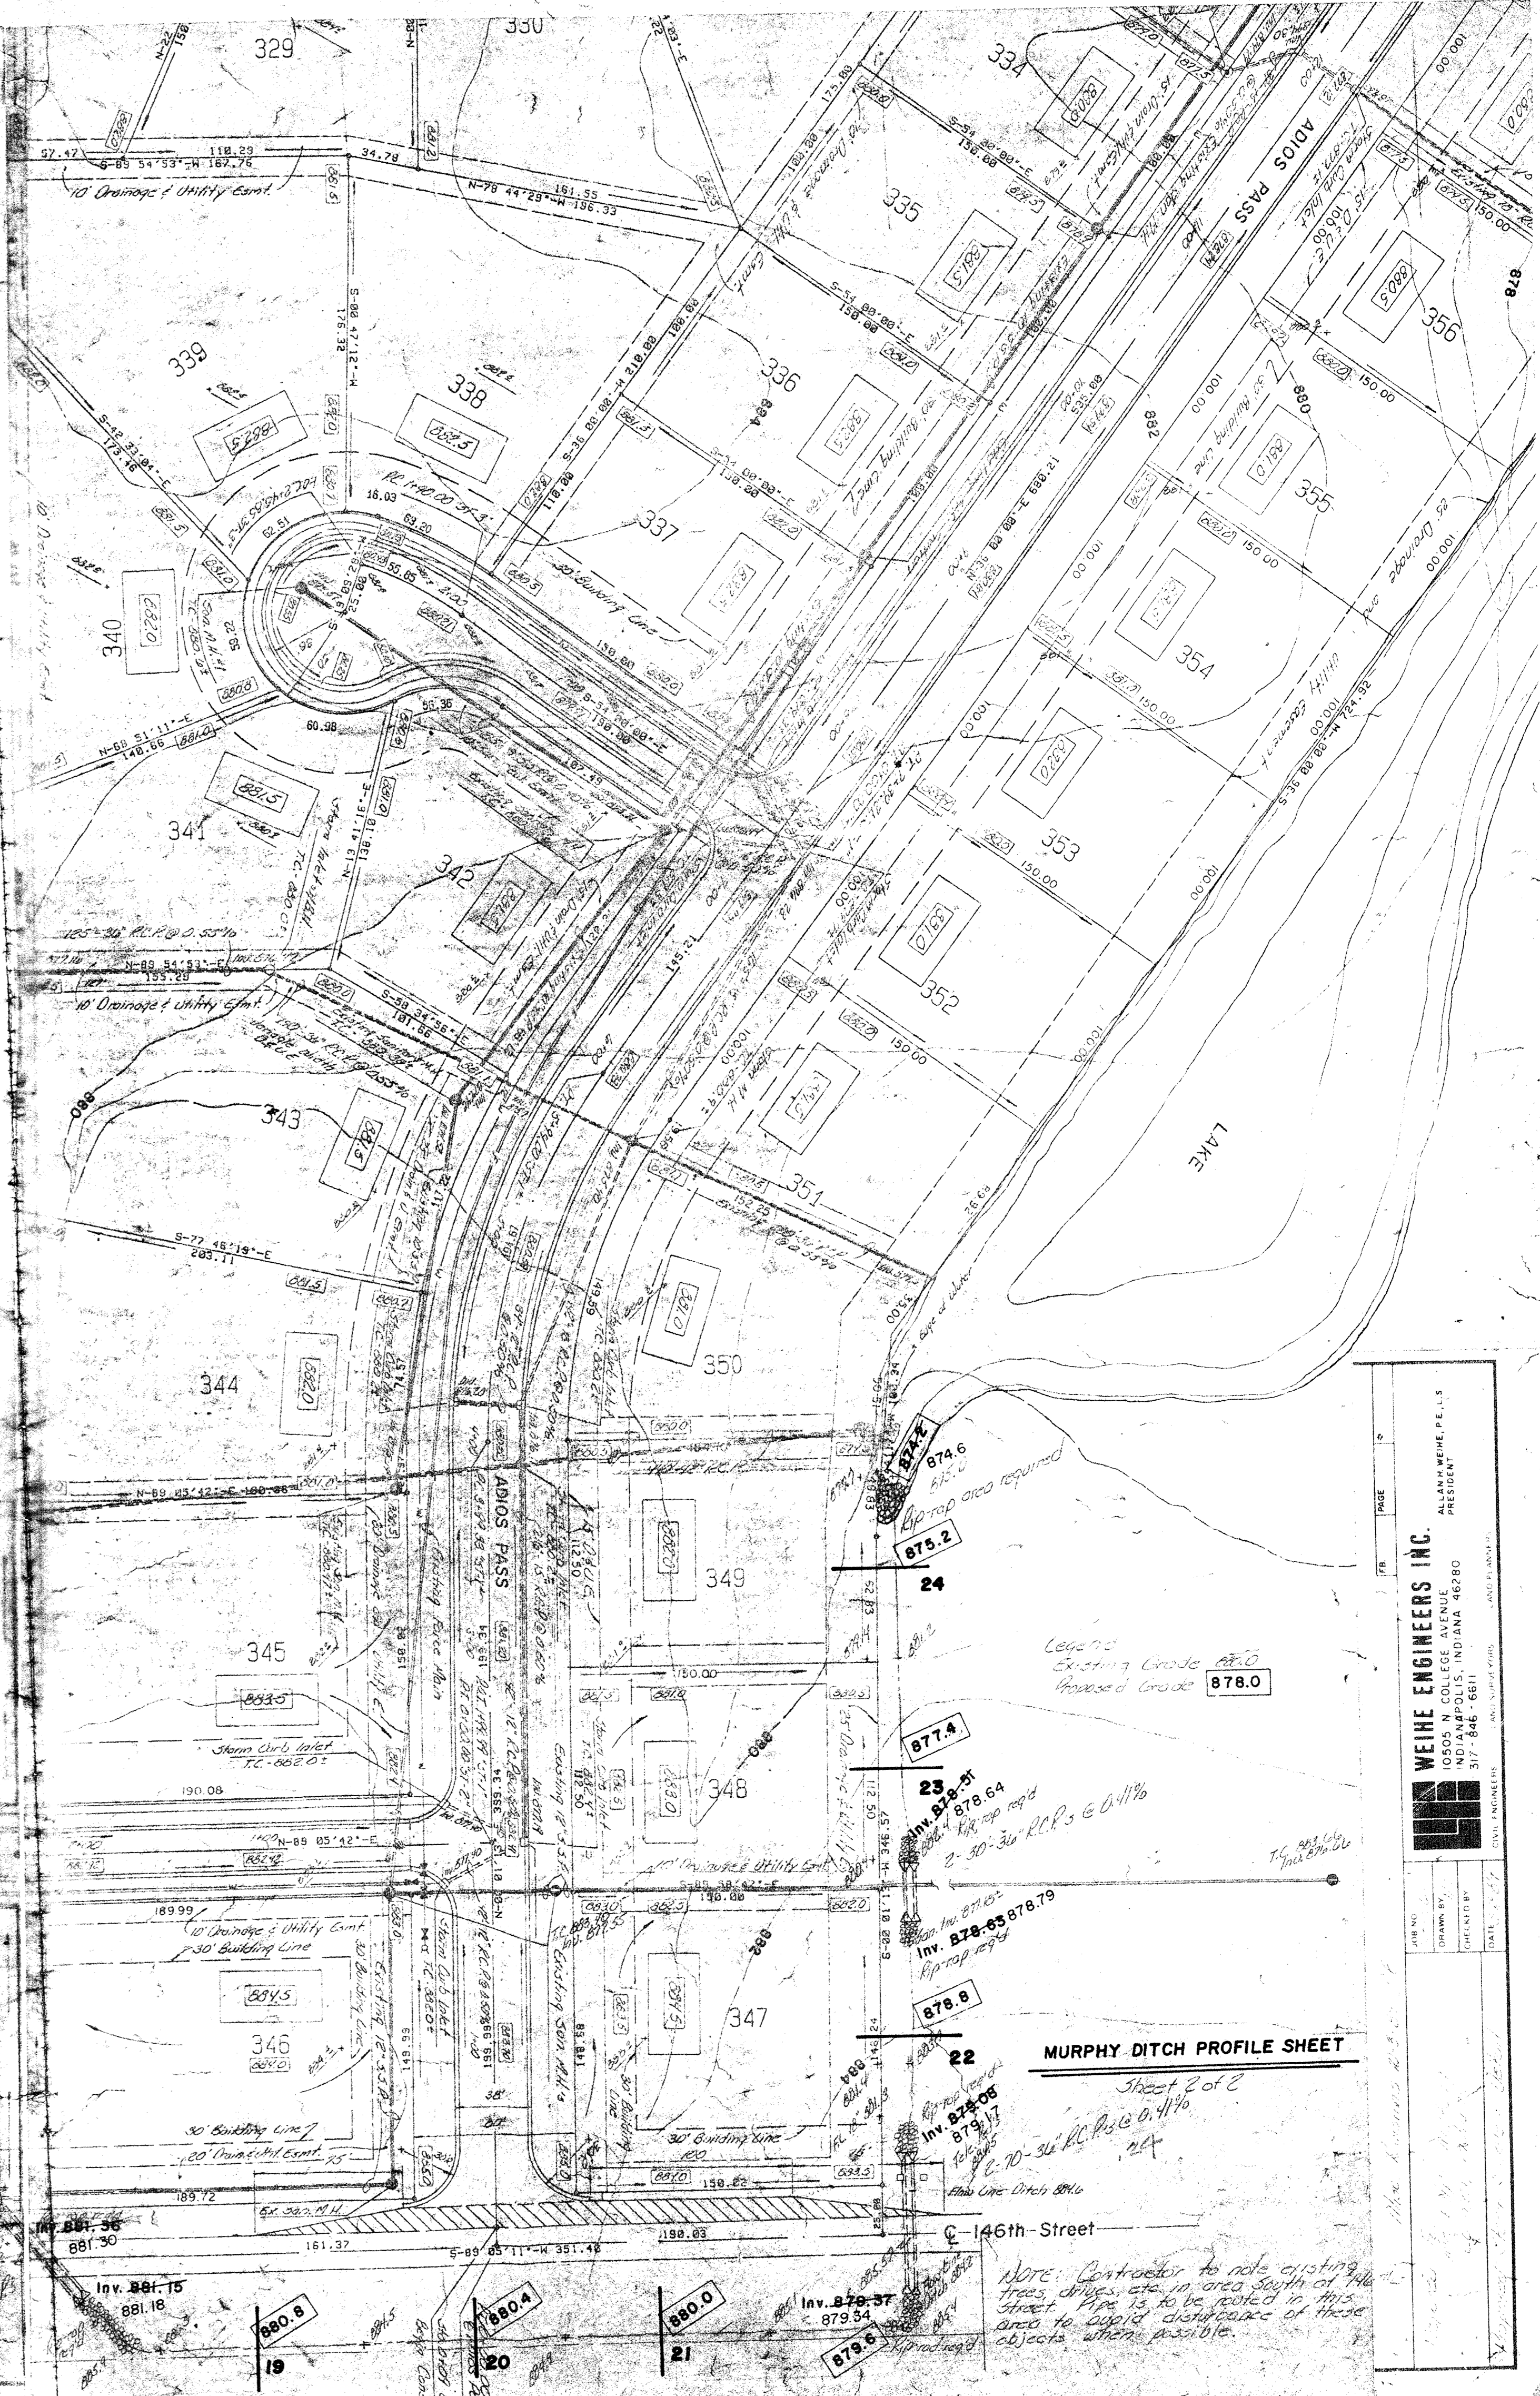

MURPHY DITCH PROFILE SHEET

Sheet 2 of 2

Inv. 878.64

Inv. 878.65

WEINE ENGINEERS, INC.


INDIANAPOLIS, INDIANA 46280

317-846-6511

