

Drain: DEERWALK ESTATES DRAIN Drain #: 236
Improvement/Arm: DEERWALK ESTATES - SECTION 1
Operator: JOH Date: 12-11-03
Drain Classification: Urban/Rural Year Installed: 1990

GIS Drain Input Checklist

- Pull Source Documents for Scanning JJA 12-11
- Digitize & Attribute Tile Drains N/A
- Digitize & Attribute Storm Drains JJA 12-11
- Digitize & Attribute SSD JJA 12-11
- Digitize & Attribute Open Ditch _____
- Stamp Plans JJA 12-11
- Sum drain lengths & Validate JJA 12-11
- Enter Improvements into Posse JJA 12-11
- Enter Drain Age into Posse Done ✓
- Sum drain length for Watershed in Posse Done ✓
- Check Database entries for errors JJA 12-11

Gasb 34 Footages for Historical Cost Drain Length Log


Drain-Improvement: DEERWALK ESTATES DRAIN - DEERWALK ESTATES - SECTION 2

Drain Type:	Size:	Length (SURVEYORS REPORT)	Length (DB Query)	Length Reconcile	If Applicable	
					Price:	Cost:
SSD	6"	540'	540'	∅		
RCP	12"	393'	393'	∅		
	15"	150'	150'	∅		
CMP	48"	85'	85'	∅		
	142"x91"	96'	96'	∅		
OPEN DITCH		2,310'	2,310'	∅		

Sum: 3,589' 3,589' ∅

Final Report: _____

Comments:

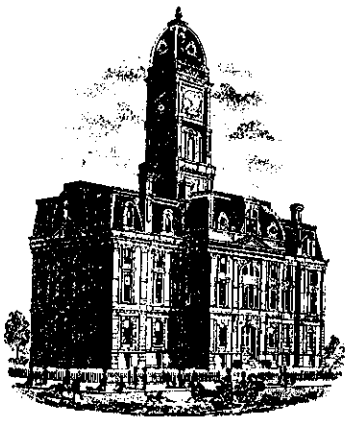

SURVEYOR'S OFFICE

Hamilton County

Kenton C. Ward, Surveyor

776-9626

942 Maple Avenue

Noblesville, Indiana 46060

TO: Hamilton County Drainage Board

RE: Deerwalk Estates Drain

Attached is a petition, non-enforcement request, plans, calculations, quantity summary and assessment roll for the Deerwalk Estates Drain.

I have reviewed the submittals and petition and have found each to be in proper form.

I have made a personal inspection of the land described in the petition. Upon doing so, I believe that the drain is practicable; will improve the public health; benefit a public highway and be of public utility; and that the costs, damages and expenses of the proposed drain will probably be less than the benefits accruing to the owners of land likely to be benefitted. The drain will consist of the following:

Open Ditch	2310 ft.	48" CMP	70 ft.
6" SSD	555 ft	142"x 91"	96 ft.
12" RCP	412 ft.		


The total length of the drain will be 3,441 feet.

The portions of the open ditch which is included in the above lengths are those located through Lots 19 and 20; between Lots 10, 11 and 9, 12 and that through and between Lots 5, 4, 3, 2 and 1.

I have reviewed the plans and believe the drain will benefit each lot equally. Therefore, I recommend each lot be assessed equally. I recommend a maintenance assessment of \$45.00 per lot or block, \$5.00 per acre for roadways. With this assessment the total annual assessment for the

drain/this section will be \$1025.00. Maintenance of Duck Creek is not included in the drain. Also, the ravine along the North side of Lots 12, 13 and 14 is not to be included as part of this drain.

I recommend a hearing be set for August 1990. Further, I recommend the Board approve the non-enforcement of the easement at that time if the drainage is approved.

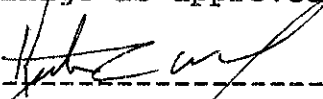

Kenton C. Ward
Hamilton County Surveyor

KCW/no

STATE OF INDIANA)
)
COUNTY OF HAMILTON)

TO: HAMILTON COUNTY DRAINAGE BOARD
% Hamilton County Surveyor, Courthouse, Noblesville, IN 46060

In the matter of Deer Walk Subdivision,
Section _____ Drain Petition.

Petitioner is the owner of all lots in the land affected by the proposed new regulated drain. The drainage will affect various lots in Deer Walk, a subdivision in Hamilton County, Indiana. The general route of such drainage shall be in existing easements and along public roads as shown in the plans on file in the Surveyor's Office.

Petitioner believes that the cost, damages and expenses of the proposed improvement will be less than the benefits which will result to the owners of the land likely to be benefited thereby. Petitioner believes the proposed improvements will:

- (a) improve public health
- (b) benefit a public street
- (c) be of public utility

Petitioner agrees to pay the cost of construction of the drainage system and requests periodic maintenance assessments by the Board thereafter.

The Petitioner also agrees to the following:

1. To provide the Drainage Board a Performance Bond for the portion of the drainage system which will be made a regulated drain. The bond will be in the amount of 100% of the Engineers estimate. The bond will be in effect until construction of 100% of the system is completed and so certified by the Engineer.
2. The Petitioner shall retain an Engineer throughout the construction phase. At completion of the project the Petitioner's Engineer shall certify that the drainage system which is to be maintained as a regulated drain has been constructed as per construction plans.

3. The Petitioner agrees to request in writing to the County Surveyor any changes from the approved plan and must receive written authorization from the County Surveyor prior to implementation of the change. All changes shall be documented and given to the Surveyor to be placed in the Drain File.
4. The Petitioner shall instruct his Engineer to provide a reproducible print on a 24" x 36" mylar of the final design of the Drainage System. This shall be submitted to the County Surveyor prior to the release of the Performance Bond.
5. The Petitioner shall comply with the Erosion Control Plan as as specified on the construction plans. Failure to comply with the Erosion Control Plan shall be determined by the Board as being an obstruction to the drainage system. The County Surveyor shall immediately install or repair the needed measures at Petitioners cost as per IC 36-9-27-46.

The Petitioner further requests that the Drain be classified as an Urban Drain.

Kevin W. Emmert
Signed

Kevin W. Emmert
Printed Name

Marie E. Freeman
Signed

MARIE E. FREEMAN
Printed Name

RECORDED OWNER(S) OF LAND INVOLVED

DATE MAR. 21, 1990

WESTCHESTER FIRE INSURANCE COMPANY
518 Stuyvesant Avenue
P.O. Box 615
Lyndhurst, N.J. 07071-9836

BOND NO. WF12514

\$ 59,000.00

KNOWN ALL MEN BY THESE PRESENTS: That we, the undersigned
Kevin Emmert Construction Co. as Principal, and Westchester Fire
Insurance Company, a corporation of the New York and authorized to do business in the State of
as Surety, are hereby held and firmly bound unto the Hamilton County Commissioners
as Oblige, in the penal sum of Fifty nine thousand and 00/100
(\$ 59,000.00) Dollars for the payment of which, well and truly to be made we hereby jointly
and severally bind ourselves, our heirs, executors, administrators, successors, and assigns.

WHEREAS, it is proposed to make certain
drainage work at Deerwalk Estates as per attached cost estimate.

WHEREAS, the Hamilton County Commissioners has approved said plan upon the
execution and delivery of this bond.

NOW, THEREFORE, the condition of this obligation is such that if the above bounden Principal shall
construct the improvements shown above, and complete said work to satisfaction of the Hamilton
County Commissioners and in accordance with the present standard specifications of the
Hamilton County Commissioners therefore, then this obligation shall be void,
otherwise the same remain in full force and effect; it being expressly understood and agreed that the
liability of the Surety for any and all claims hereunder shall in no event exceed the penal amount of this
obligation as herein stated.

Signed, sealed and dated this May 16, 1990

Kevin Emmert Construction Co.
Principal

Janet A. Sawyer
Witness

BY Kevin W. Emmert

Westchester Fire Insurance Company
Surety

Elizabeth Monahan
Witness

BY Mary L. Paduzzi
Mary L. Paduzzi, Attorney-in-Fact

WESTCHESTER FIRE INSURANCE COMPANY

NEW YORK, NEW YORK

STATEMENT AS OF DECEMBER 31, 1989

ASSETS		LIABILITIES AND SURPLUS	
Bonds	\$1,110,906,748	Losses and Adjustment Expenses	\$ 994,964,202
Stocks:		Taxes and Expenses	34,382,611
Preferred	\$ 4,041,554	Unearned Premiums	195,097,716
Common	<u>324,638,780</u> 328,680,334	Other Liabilities	91,735,334
Real Estate	8,043,993	Capital	\$ 2,500,000
Cash and Bank Deposits	1,350,081	Paid in and Contributed Surplus	130,160,715
Short Term Investments	82,356,307	Other Surplus	<u>233,242,370</u>
Other Invested Assets	3,474,114	Surplus to Policyholders	<u>365,903,085</u>
Premium Balances Receivable	112,854,499		
Equities and Deposits in Pools and Associations	3,834,848		
Other Assets	<u>30,582,024</u>		
Total Admitted Assets	<u>\$1,682,082,948</u>	Total Liabilities and Surplus	<u>\$1,682,082,948</u>

Bonds and Stocks are valued in accordance with the basis adopted by the National Association of Insurance Commissioners.

Securities carried at \$138,721,850 in the above statement are deposited as required by law.

STATE OF NEW JERSEY }
 COUNTY OF MORRIS } SS:

GEORGE J. RACHMIEL, Senior Vice President & Treasurer and MICHAEL A. SANDRI, Vice President of the Westchester Fire Insurance Company being duly sworn, each for himself deposes and says that they are the above described officers of the said Company and that on the 31st day of December, 1989 the Company was actually possessed of the assets set forth in the foregoing statement and that such assets were available for the payment of losses and claims and held for the protection of its policyholders and creditors, except as hereinbefore indicated, and that the foregoing statement is a correct exhibit of such assets and liabilities of the said Company on the 31st day of December, 1989 according to the best of their information, knowledge and belief, respectively.

George J. Rachmiel
 Senior Vice President & Treasurer

Michael A. Sandri
 Vice President



Sworn to and Subscribed before me this 6th day of April, 1990.

Cynthia Jo Stehli

CYNTHIA JO STEHLI
NOTARY PUBLIC OF NEW JERSEY
 My Commission Expires Dec. 13, 1993



**POWER OF ATTORNEY
WESTCHESTER FIRE INSURANCE COMPANY
PRINCIPAL OFFICE, NEW YORK, N.Y.**

KNOW ALL MEN BY THESE PRESENTS: That the WESTCHESTER FIRE INSURANCE COMPANY a Corporation duly organized and existing under the laws of the State of New York, and having its administrative offices in the Township of Morris, New Jersey, has made, constituted and appointed, and does by these presents make, constitute and appoint Robert A. Nicosia, Richard L. Quackenbush, Mary L. Paluzzi, Margaret A. Nicosia, Thomas Piccinnino, and Richard Ingram of Nutley, New Jersey, each

its true and lawful Agent(s) and Attorney(s)-in-Fact, with full power and authority hereby conferred in its name, place and stead, to execute, seal, acknowledge and deliver: Any and all bonds and undertakings---

and to bind the Corporation thereby as fully and to the same extent as if such bonds had been duly executed and acknowledged by the regularly elected officers of the Corporation at its offices in Morris Township, New Jersey in their own proper persons.

This Power of Attorney limits the act of those named therein to the bonds and undertakings specifically named therein, and they have no authority to bind the Company except in the manner and to the extent therein stated.

This Power of Attorney revokes all previous powers issued in behalf of the attorney(s)-in-fact named above.

IN WITNESS WHEREOF the Westchester Fire Insurance Company has caused these presents to be signed and attested by its appropriate officers and its corporate seal hereunto affixed this 27th day of June, 19 89.



Attest:

WESTCHESTER FIRE INSURANCE COMPANY

John K. Stewart
Assistant Secretary
John K. Stewart

Richard A. Annese
Vice President
Richard A. Annese

STATE OF NEW JERSEY)
COUNTY OF MORRIS) ss.:

On this 27th day of June, 19 89, before the subscriber, a duly qualified Notary Public of the State of New Jersey, came the above-mentioned Vice President and Assistant Secretary of the Westchester Fire Insurance Company, to me personally known to be the officers described by me, duly sworn, deposed and said, that they are the officers of said Company aforesaid, and that the seal affixed to the preceding instrument is the Corporate Seal of said Company, and the said Corporate Seal and their signatures as officers were duly affixed and subscribed to the said instrument by the authority and direction of the said Company.

IN TESTIMONY WHEREOF, I have hereunto set my hand and affixed my seal at the Township of Morris, the 27th day and year first above written.

DAWN M. BIAMONTE

NOTARY PUBLIC OF NEW JERSEY
OFFICE: One Hamilton Co. Square, Ste. 188, Norwood, N.J. 07060
MY COMMISSION EXPIRES JULY 25, 1993

Dawn M. Biamonte
Notary Public

This Power of Attorney is granted pursuant to Article IV of the By-Laws of the WESTCHESTER FIRE INSURANCE COMPANY as now in full force and effect.

ARTICLE IV Execution of Instruments. "The Chairman of the Board, Vice-Chairman of the Board, President, or any Vice-President, in conjunction with the Secretary, or any Secretary, if more than one shall be appointed by the Board, or an Assistant Secretary, shall have power on behalf of the Corporation:

(a) to execute, affix the corporate seal manually or by facsimile to, acknowledge, verify and deliver any contracts, obligations, instruments and documents whatsoever in connection with its business including, without limiting the foregoing, any bonds, guarantees, undertakings, recognizances, powers of attorney or revocations of any powers of attorney, stipulations, policies of insurance, deeds, leases, mortgages, releases, satisfactions and agency agreements;

(b) to appoint, in writing, one or more persons for any or all of the purposes mentioned in the preceding paragraph (a), including affixing the seal of the Corporation."

This Power of Attorney is signed and sealed under and by the authority of Article III, Section 9 of the By-Laws of the WESTCHESTER FIRE INSURANCE COMPANY, as now in full force and effect.

ARTICLE III Section 9 Facsimile Signatures. "The signature of any officer authorized by the Corporation to sign any bonds, guarantees, undertakings, recognizances, stipulations, powers of attorney or revocations of any powers of attorney and policies of insurance issued by the Corporation may be printed facsimile, lithographed, or otherwise produced . . . The Corporation may continue to use for the purposes herein stated the facsimile signature of any person or persons who shall have been such officer or officers of the Corporation, notwithstanding the fact that he may have ceased to be such at the time when such instruments shall be issued."

CERTIFICATE

State of New Jersey
County of Morris

I, the undersigned, Assistant Secretary of the WESTCHESTER FIRE INSURANCE COMPANY, DO HEREBY CERTIFY that the foregoing POWER OF ATTORNEY remains in full force and effect and has not been revoked and furthermore that the above quoted abstracts of Article IV and Article III, Section 9 of the By-Laws of the Corporation are now in full force and effect.

Signed and sealed at the Township of Morris, New Jersey dated _____ 16th _____

day of _____ May _____, 19⁹⁰ _____.

By Herbert H. Linder
Assistant Secretary
Herbert H. Linder



ASSOCIATED INSURANCE MANAGERS
 6308 Rucker Rd., Suite A
 P. O. Box 55570
 Indianapolis, Indiana 46205
 317-253-1402
 FAX 317-254-9834

- Box 940, Anderson 46015
317-644-3331
- Box 55570, Indianapolis 46205
317-253-1402
- Box 5582, Evansville 47716
812-479-5050

From: STEVE KUYKENDALL

DEERWALK

To: HAMILTON COUNTY SURVEYORS OFFICE
 942 MAPLE AVENUE
 NOBLESVILLE, IN. 46060

ATTN: JERRY LISTON

Subject: KEVIN EMMETT CONSTRUCTION

Date: 6-25-91

Dear Mr. Liston,

In our clients request, please find attached favorable Letter of Credit that we have in force as support for their subdivision Bonds at Deerwalk Estates.

Sincerely,
 Steve Kuykendall

Please Reply Below

Date:

Bond Agent for Kevin
 Emmett Construction

FILED

HAMILTON COUNTY DEPARTMENT OF PUBLIC WORKS



Irrevocable Letter of Credit No. 323
Expiration Date 5-11-92

Ameritrust National Bank
Central Indiana
110 North 9th Street
P O Box 40
Noblesville, IN 46060-9987
(317) 773-0980
FAX. (317) 773-5543

Universal Bonding Insurance Company
518 Stuyvesant Avenue
P.O. Box 615
Lyndhurst, N.J. 07071-9836

Beneficiaries:

By order of our client, Kevin W. and Denise Emmert, we hereby establish this Irrevocable Letter of Credit No. 323 in your favor for an amount up to but not exceeding the aggregate sum of Twenty-Eight Thousand Dollars and 00/100(\$28,000), effective immediately, and expiring at the offices of the bank on May 11, 1992 unless renewed as hereinafter provided.

Funds under this Letter of Credit are available to you against your sight draft(s), signed by your authorized corporate officer, drawn on us bearing the clause "Drawn under Credit No. 323".

This Letter of Credit will be automatically renewed for a one year period upon the expiration date set forth above and upon each anniversary of such date, unless at least sixty (60) days prior to such expiration date, or prior to any anniversary of such date, we notify both you and our client in writing by certified mail that we elect not to so renew this Letter of Credit.

Upon receipt by you of our notice of election not to renew this Letter of Credit, you may draw hereunder by your sight draft (s) drawn on us and bearing the clause "Drawn under Credit No. 323".

This Letter of Credit sets forth in full the terms of our undertaking and such undertaking shall not in any way be modified, amended or amplified by reference to any documents or instrument referred to herein or in which this Letter of Credit is referred to or to which this Letter of Credit relates and any such reference shall not be deemed to incorporate herein by reference any document or instrument.


All bank charges and commissions incurred in this transaction are for the applicant's account. Any funds drawn hereunder and unused at the time you are discharged as Surety on all bond(s) or undertaking(s) on behalf of our client will be repaid to us by you.

Letter of Credit No. 323
Ameritrust National Bank

We hereby agree with the drawers, endorsers, and bonafide holders of drafts drawn under and in compliance with the terms of this credit that such drafts will be duly honored upon presentation to the drawee.

Except as otherwise expressly stated herein, this credit is subject to the Uniform Customs and Practice for Commercial Documentary Credits (1983 Revision) I.C.C. Publication No. 400.

Sincerely,

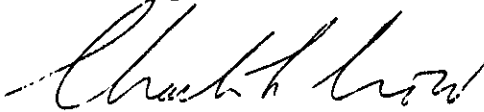

Ameritrust National Bank
Charles L. Crow
Vice-President

WESTCHESTER FIRE INSURANCE COMPANY
518 Stuyvesant Avenue
P.O. Box 615
Lyndhurst, N.J. 07071-9836

BOND NO. WF12514

\$ 59,000.00

KNOWN ALL MEN BY THESE PRESENTS: That we, the undersigned
Kevin Emmert Construction Co. as Principal, and Westchester Fire
Insurance Company, a corporation of the New York and authorized to do business in the State of
, as Surety, are hereby held and firmly bound unto the Hamilton County Commissioners
as Obligees, in the penal sum of Fifty nine thousand and 00/100
(\$ 59,000.00) Dollars for the payment of which, well and truly to be made we hereby jointly
and severally bind ourselves, our heirs, executors, administrators, successors, and assigns.

WHEREAS, it is proposed to make certain
drainage work at Deerwalk Estates as per attached cost estimate.

WHEREAS, the Hamilton County Commissioners has approved said plan upon the
execution and delivery of this bond.

NOW, THEREFORE, the condition of this obligation is such that if the above bounden Principal shall
construct the improvements shown above, and complete said work to satisfaction of the Hamilton
County Commissioners and in accordance with the present standard specifications of the
Hamilton County Commissioners therefore, then this obligation shall be void,
otherwise the same remain in full force and effect; it being expressly understood and agreed that the
liability of the Surety for any and all claims hereunder shall in no event exceed the penal amount of this
obligation as herein stated.

Signed, sealed and dated this May 16, 1990

Kevin Emmert Construction Co.

Principal

Janet A. Lawler
Witness

BY Kevin W. Emmert

Westchester Fire Insurance Company

Surety

Elizabeth Mena
Witness

BY Mary L. Paluzzi
Mary L. Paluzzi, Attorney-in-Fact



SURVEYOR'S OFFICE
Hamilton County

Kenton C. Ward, Surveyor

Phone (317) 776-8495

Fax (317) 776-9628

Suite 146

One Hamilton County Square

Noblesville, Indiana 46060-2230

To: Hamilton County Drainage Board

June 10, 1997

Re: Deerwalk Estates Drain - Sec. 1 arm

Attached are as-builts, certificate of completion & compliance, and other information for Deerwalk Estates. An inspection of the drainage facilities for this section has been made and the facilities were found to be complete and acceptable.

During construction, changes were made to the drain which will alter the plans submitted with my report for this drain dated June 13, 1990. The changes are as follows:

The 48" CMP was lengthened from 70' feet to 85' feet.

The corrected totals are as follows: 12" RCP - 393' feet, 15" RCP - 150' feet.


The length of the drain due to the changes described above is now **3,589 feet**.

The non-enforcement was approved by the Board at its meeting on August 20, 1990 and recorded under instrument #9022187.

The bond or letter of credit from Westchester Fire Insurance Co. & Ameritrust, number WF 12514 and 323, dated May 16, 1990 & June 1991, in the amount of \$59,000.00 for storm sewers and \$28,000.00 for the extension, has been recommended for release in a letter to the Commissioners dated may 11, 1992.

I recommend the Board approve the drains construction as complete and acceptable.

Sincerely,

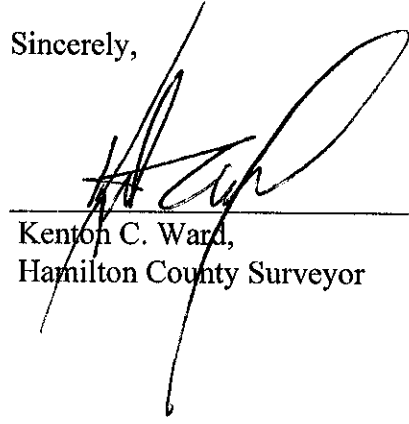

Kenton C. Ward,
Hamilton County Surveyor

KCW/slm

Asbuilt Structures

Project: Deerwalk Estates

Structure: T.C.: I.E.: Pipe: Length: Original Plans: Difference:

STR 5	795.91	792.49				
STR 4	795.94	792.43	12"	26'		
STR 4	795.94	792.43				
STR 3	795.53	792.19	12"	121'		
STR 3	795.53	792.09				
MES	—	791.89	12"	7'		
STR 2	797.05	793.64				
STR 1	797.33	792.97	12"	26'		
STR 1	797.33	792.90				
MES	—	783.16	12"	51'		
MES	—	803.98				
STR 7	803.99	800.28	12"	20'		
STR 7	803.99	800.17				
STR 6	803.81	799.65	12"	26'		
STR V	803.81	799.60				
MES	—	798.39	15"	150'		
STR B	798.29	786.15				
MES	—	773.06	12"	110'		

6" SSD Streets:

Total: _____

6" SSD Lots:

Total: _____

RCP Pipe Totals:

Other Drain:

Total Length of Drain: _____

Asbuilt Structures

Project: Deerwalk Estates

Structure: T.C.: I.E.: Pipe: Length: Original Plans: Difference:

LOT 19 & 20	—	783.84	142" x 91"	96'		
		783.16	CMP			
LOT 10 & 11	—	773.34				
		773.06	48" CMP	85'	From 70'	+15

6" SSD Streets:

6" SSD Lots:

Lot 18	80'
14-15	760'

Total: _____

555 or

Total: → 540

RCP Pipe Totals:

12"	393'
15"	150'

Other Drain:	
48" CMP	85'
142" x 91" CMP	96'
OPEN DITCH	2310'

Total Length of Drain: 3589'

GENERAL NOTES:

IT IS THE RESPONSIBILITY OF EACH CONTRACTOR TO VERIFY ALL EXISTING UTILITIES AND CONDITIONS PERTAINING TO HIS PHASE OF THE WORK. IT SHALL BE THE CONTRACTOR'S RESPONSIBILITY TO CONTACT THE OWNERS OF THE VARIOUS UTILITIES BEFORE WORK IS STARTED. THE CONTRACTOR SHALL NOTIFY IN WRITING THE OWNERS OF THE ENGINEER OF ANY CHANGES, ERRORS OR OMISSIONS FOUND ON THESE PLANS OR IN THE FIELD BEFORE WORK IS STARTED OR RESUMED.


STANDARD SPECIFICATIONS SHALL APPLY FOR ALL WORK AND MATERIAL. THE CONTRACTOR SHALL BE RESPONSIBLE FOR OBTAINING ALL STATE, CITY AND COUNTY PERMITS.

CONTRACTOR SHALL CHECK WITH THE ENGINEER PRIOR TO THE START OF CONSTRUCTION TO VERIFY DATE OF PLANS.

ALL CONTRACTORS SHALL VERIFY SUBSURFACE CONDITIONS PRIOR TO BIDDING.

UNDERGROUND TILES NOT VISIBLE ON THE SURFACE MAY EXIST. ANY TILES ENCOUNTERED DURING CONSTRUCTION SHALL BE MAINTAINED WITH POSITIVE DRAINAGE.

EASEMENT SHALL BE PROVIDED ALONG ALL UTILITY LINES.

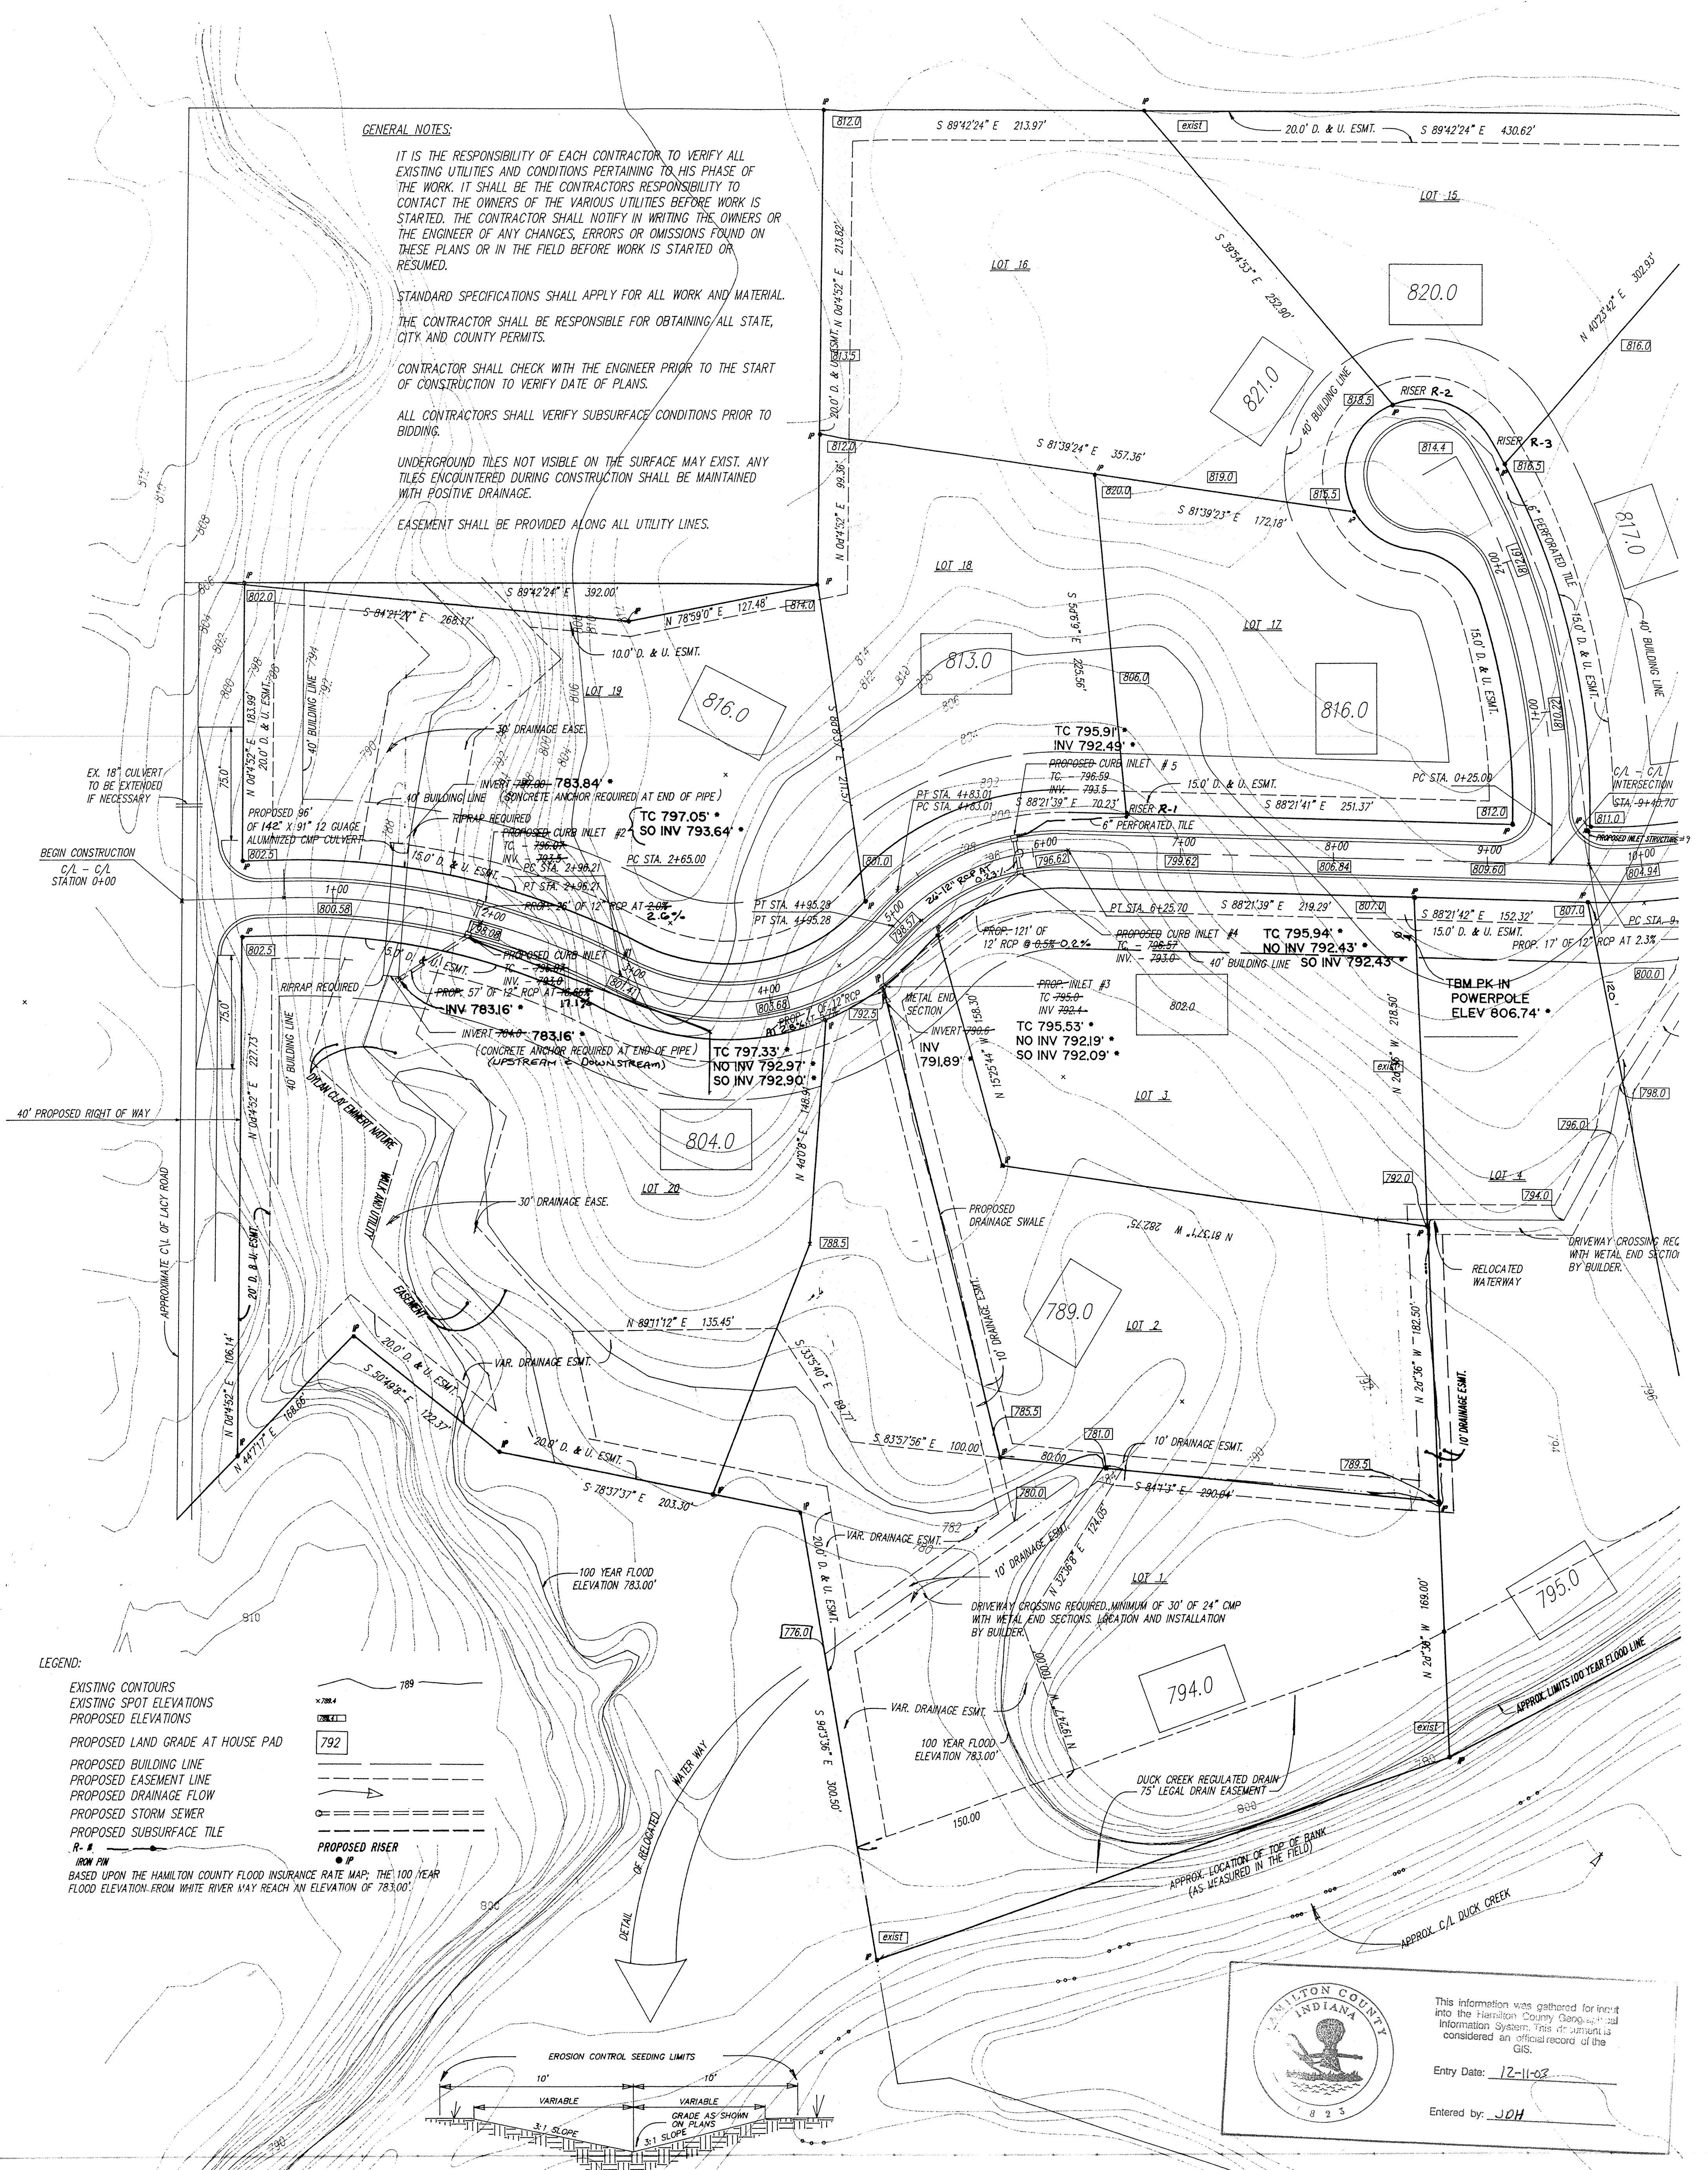

- LEGEND:
- EXISTING CONTOURS
 - EXISTING SPOT ELEVATIONS
 - PROPOSED ELEVATIONS
 - PROPOSED LAND GRADE AT HOUSE PAD
 - PROPOSED BUILDING LINE
 - PROPOSED EASEMENT LINE
 - PROPOSED DRAINAGE FLOW
 - PROPOSED STORM SEWER
 - PROPOSED SUBSURFACE TILE
 - IRON PIN
 - BASED UPON THE HAMILTON COUNTY FLOOD INSURANCE RATE MAP, THE 100 YEAR FLOOD ELEVATION FROM WHITE RIVER MAY REACH AN ELEVATION OF 783.00'

HAMILTON COUNTY INDIANA

This information was gathered for input into the Hamilton County Geographic Information System. This document is considered an official record of the GIS.



Entered by: JQH

RECORD DRAWINGS OF STORM SEWERS

DATED 29 APRIL 1991

Allan H. Weihe
ALLAN H. WEIHE REG. IND. PE #8827

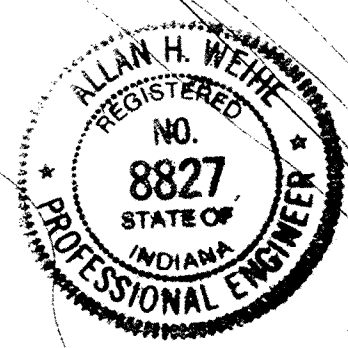

SECTION 34, T-20E R-5E
WHITE RIVER TOWNSHIP

PREPARED FOR:
DEERWALK
KEVIN EMMERT
NOBLESVILLE, INDIANA 46060

REVISIONS	DATE	BY	JOB NO.
			89-1480
			DRAWN BY
			0'B
			CHECKED BY
			A.H.W.
			DATE

WEIHE ENGINEERS INC.

10505 NORTH COLLEGE AVENUE
INDIANAPOLIS, INDIANA 46280
(317) 846-6611

CIVIL ENGINEERS LAND SURVEYORS LAND PLANNERS

ALLAN H. WEIHE, P.E., L.S.
PRESIDENT

GENERAL NOTES:

IT IS THE RESPONSIBILITY OF EACH CONTRACTOR TO VERIFY ALL EXISTING UTILITIES AND CONDITIONS PERTAINING TO HIS PHASE OF THE WORK. IT SHALL BE THE CONTRACTOR'S RESPONSIBILITY TO CONTACT THE OWNERS OF THE VARIOUS UTILITIES BEFORE WORK IS STARTED. THE CONTRACTOR SHALL NOTIFY IN WRITING THE OWNERS OR THE ENGINEER OF ANY CHANGES, ERRORS OR OMISSIONS FOUND ON THESE PLANS OR IN THE FIELD BEFORE WORK IS STARTED OR RESUMED.

STANDARD SPECIFICATIONS SHALL APPLY FOR ALL WORK AND MATERIAL. THE CONTRACTOR SHALL BE RESPONSIBLE FOR OBTAINING ALL STATE, CITY AND COUNTY PERMITS.

CONTRACTOR SHALL CHECK WITH THE ENGINEER PRIOR TO THE START OF CONSTRUCTION TO VERIFY DATE OF PLANS.

ALL CONTRACTORS SHALL VERIFY SUBSURFACE CONDITIONS PRIOR TO BIDDING.


UNDERGROUND TILES NOT VISIBLE ON THE SURFACE MAY EXIST. ANY TILES ENCOUNTERED DURING CONSTRUCTION SHALL BE MAINTAINED WITH POSITIVE DRAINAGE.


EASEMENT SHALL BE PROVIDED ALONG ALL UTILITY LINES.

LEGEND:

- EXISTING CONTOURS
- EXISTING SPOT ELEVATIONS
- PROPOSED ELEVATIONS
- PROPOSED LAND GRADE AT HOUSE PAD
- PROPOSED BUILDING LINE
- PROPOSED EASEMENT LINE
- PROPOSED DRAINAGE FLOW
- PROPOSED STORM SEWER
- PROPOSED SUBSURFACE TILE
- IRON PIN

BASED UPON THE HAMILTON COUNTY FLOOD INSURANCE RATE MAP, THE 100 YEAR FLOOD ELEVATION FROM WHITE RIVER MAY REACH AN ELEVATION OF 783.00'

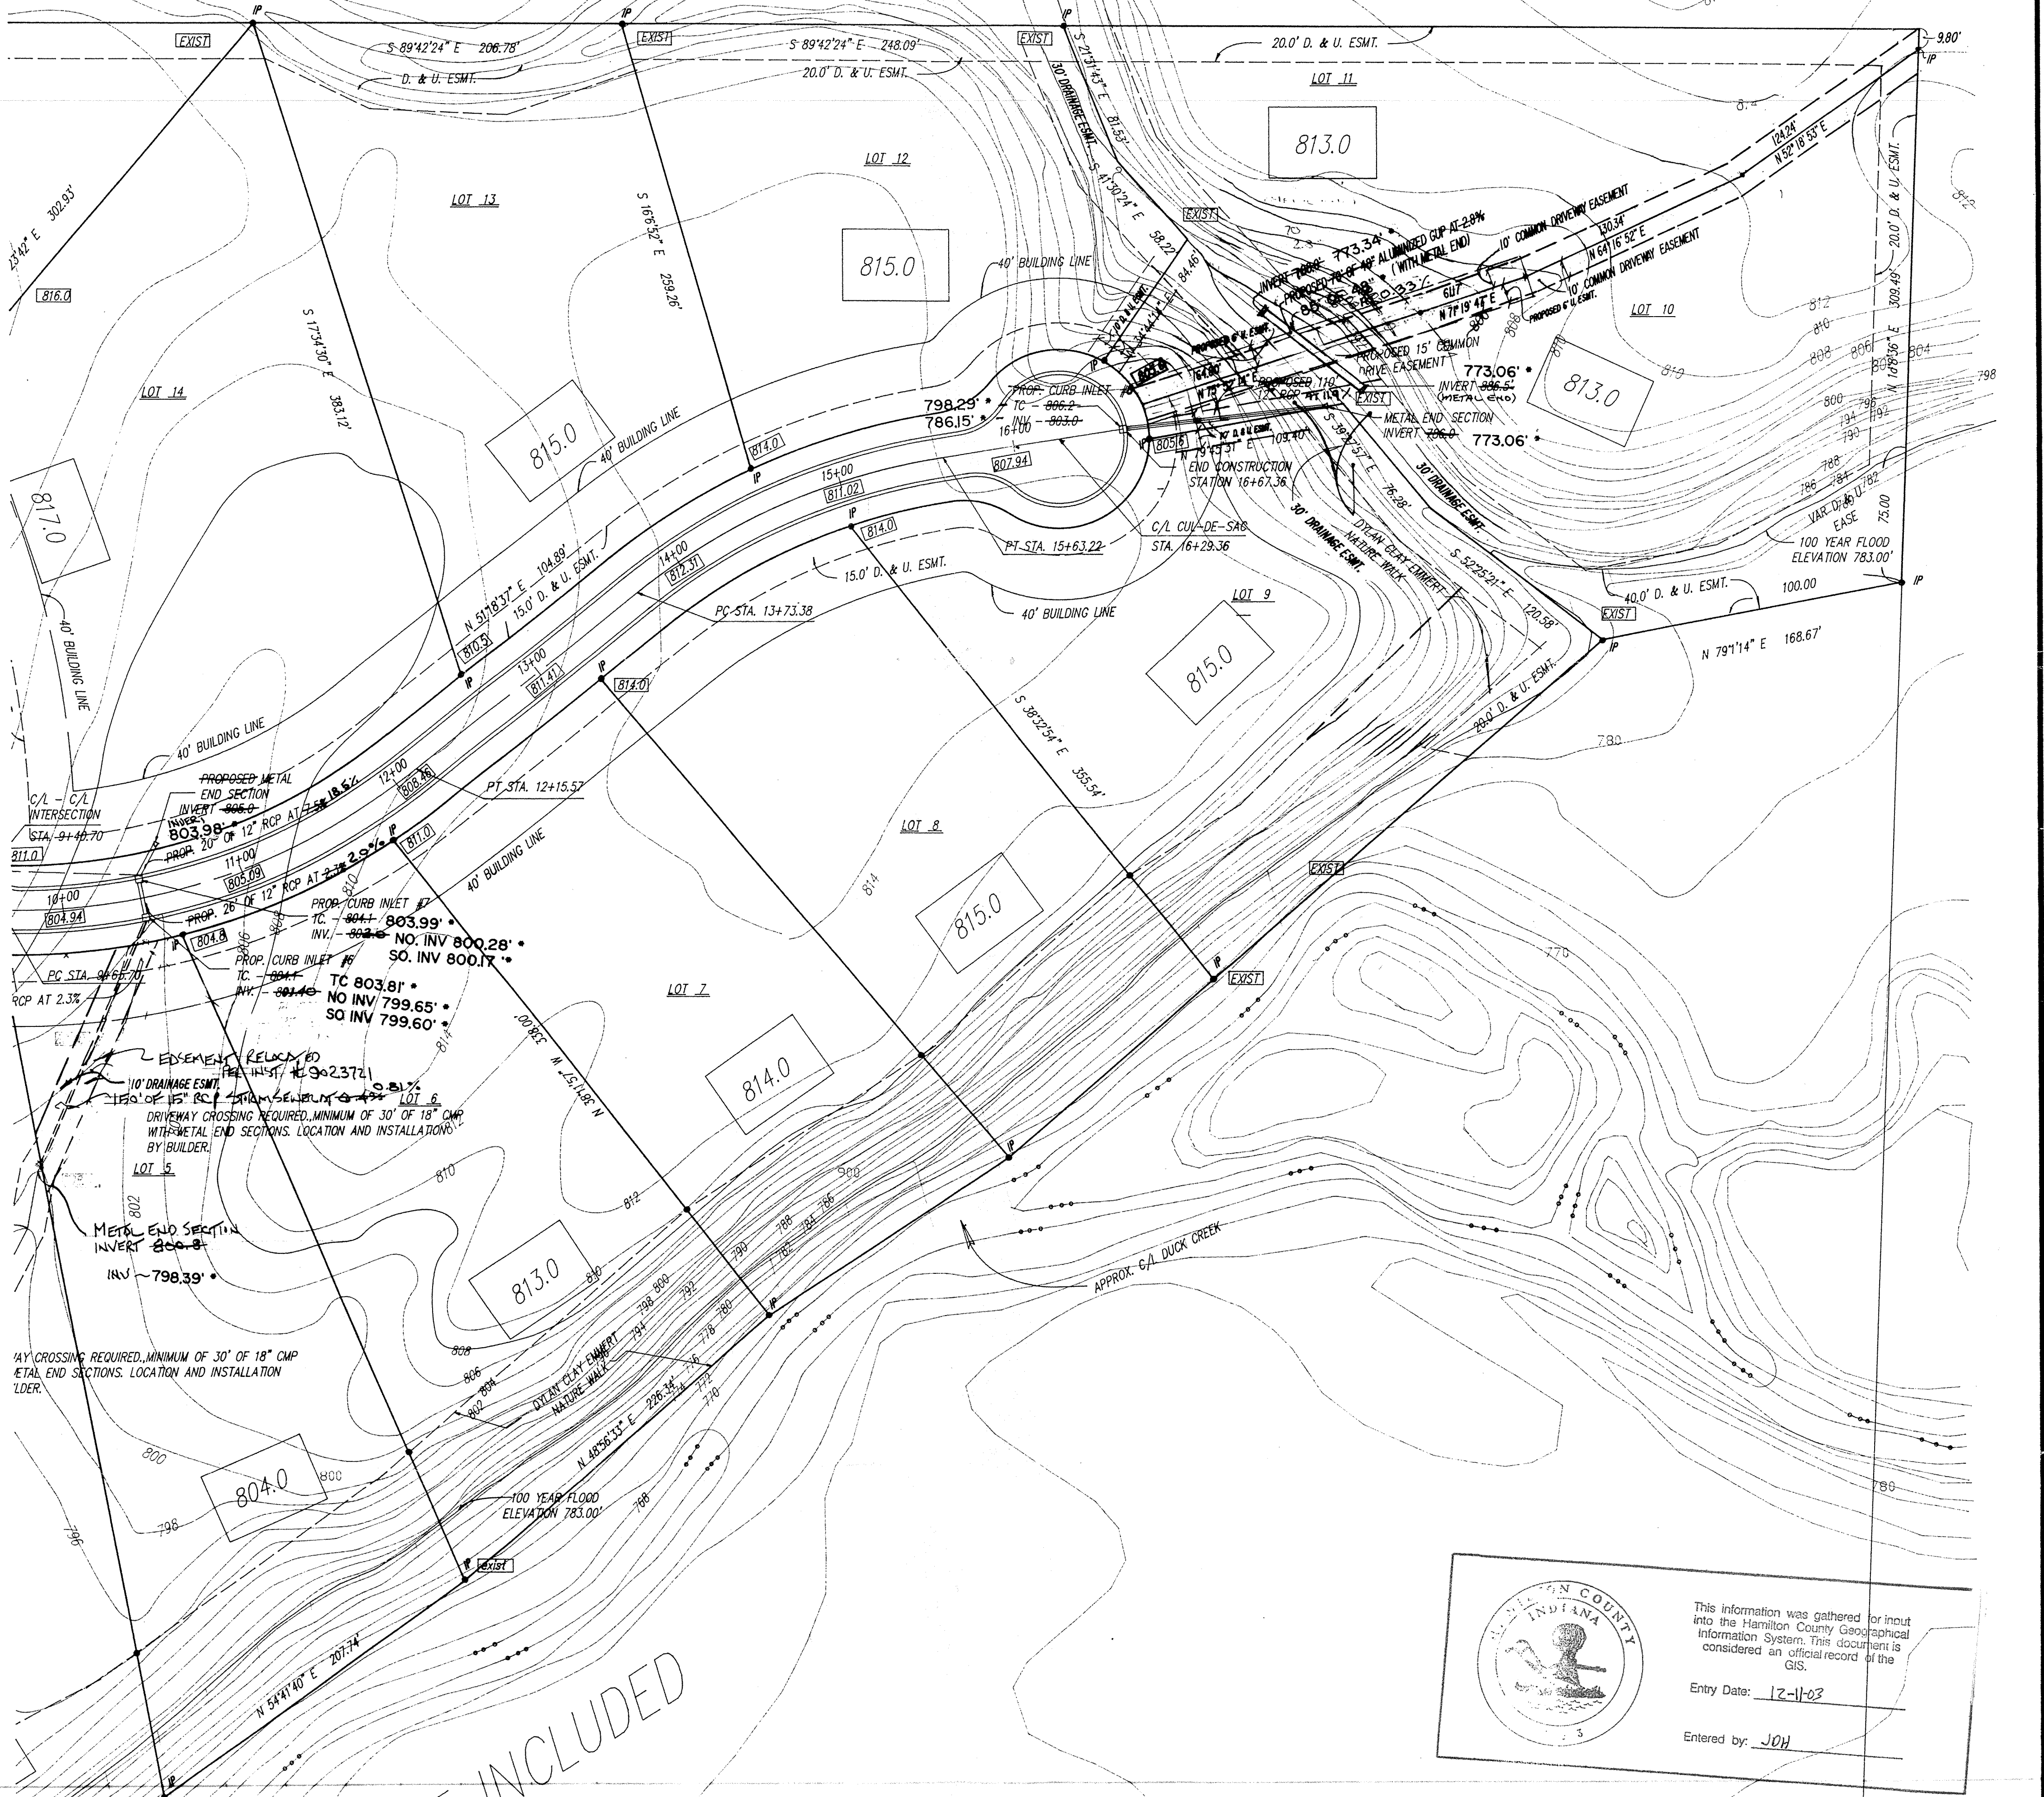


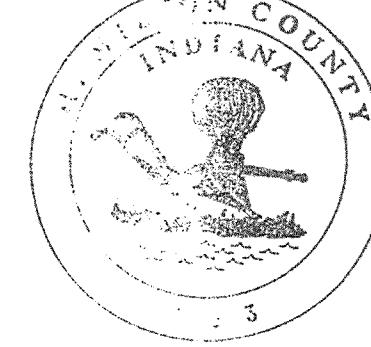
 This information was gathered or input into the Hamilton County Geographical Information System. This document is considered an official record of the GIS.
 Entry Date: 12-11-03
 Entered by: JOH

RECORD DRAWINGS OF STORM SEWERS

DATED 29 APRIL 1991

ALLAN H. WEIHE REG. IND. PE #8827

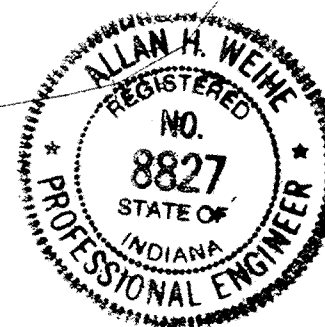


SECTION 34, T-20E, R-5E
WHITE RIVER TOWNSHIP

5

PREPARED FOR:
DEERWALK
KEVIN EMMERT
NOBLESVILLE, INDIANA 46060
 DEVELOPMENT PLAN SCALE: 1" = 50'

REVISIONS	DATE	BY	JOB NO.
Rev. System	11/10	[Signature]	89.1480
			DRAWN BY O'B
			CHECKED BY A.H.V.
			DATE

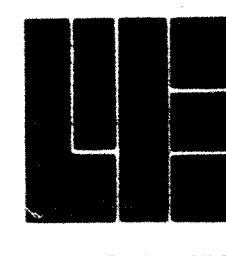

WEIHE ENGINEERS INC.
 10505 NORTH COLLEGE AVENUE
 INDIANAPOLIS, INDIANA 46280
 (317) 846-6611

ALLAN H. WEIHE, P.E., L.S. PRESIDENT

CIVIL ENGINEERS LAND SURVEYORS LAND PLANNERS