


Drain: MILL CREEK DRAIN **Drain #:** 206
Improvement/Arm: MILL CREEK - SECTION 8
Operator: JPH **Date:** 2-12-04
Drain Classification: Urban/Rural **Year Installed:** 1985

GIS Drain Input Checklist

- Pull Source Documents for Scanning JPH 2-12
- Digitize & Attribute Tile Drains N/A
- Digitize & Attribute Storm Drains JPH 2-12
- Digitize & Attribute SSD JPH 2-12
- Digitize & Attribute Open Ditch JPH 2-12
- Stamp Plans JPH 2-12
- Sum drain lengths & Validate JPH 2-12
- Enter Improvements into Posse JPH 2-12
- Enter Drain Age into Posse JPH 3-1
- Sum drain length for Watershed in Posse JPH 3-1
- Check Database entries for errors JPH 2-12

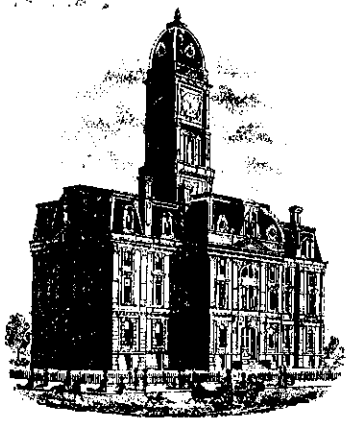

SURVEYOR'S OFFICE Hamilton County

Kenton C. Ward, Surveyor

776-9626

Noblesville, Ind. 46060 April 8, 1985

TO: Hamilton County Drainage Board

RE: Mill Creek Section 8

Attached is a petition, plans and assessment roll for Mill Creek, Section 8. I have reviewed the petition and submittals and found them to be in proper form.

I have personally reviewed the plans and inspected the site and believe the proposed drain to be practicable, will improve public health, benefit a public highway, be of public utility and that the costs, damages and expenses of the proposed drain will probably be less than the benefits accruing to the owners of land likely to be benefited.

Attached is an assesement roll for these sections of the drain. I have considered the benefits to each tract in compling the assesement roll. In doing so I believe that each tract has equal benefit on the drain. With a \$25.00 per lot assessment and \$2.00 per acre on the roads, the total yeraly assesment will be \$334.80.

FILED
APR 12 1985

The drain will consist of the following items.


Open ditch (including part of Sly Run)	2555.49 ft
24" RCP	435 ft
12" RCP	35 ft
15" RCP	177 ft
6" SSD	1127.48 ft

HAMILTON COUNTY ENGINEER
Mary Ellen Oldham

The total footage of the drain will be 4329.97 feet.

Also attached is a non enforcement request. This request should be approved at the hearing

A hearing for this drain should be set for 9:00am on June 10, 1985.

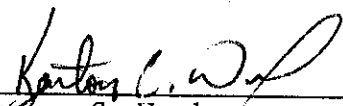

Kenton C. Ward
Hamilton County Surveyor

KCW/no

GUARD CASUALTY & SURETY INSURANCE COMPANY
Indianapolis, Indiana

SUBDIVISION BOND

SP 8427

KNOW ALL MEN BY THESE PRESENTS: That We, the undersigned,
CHARLES L. CROW & DAVID S. DAVIS, R.R. #6, Box 451, Noblesville, Indiana, 46060,
as Principal, and GUARD CASUALTY & SURETY INSURANCE COMPANY, as Surety, are held and firmly
bound unto Hamilton County, Board of County Commissioners,
in the penal sum of TEN THOUSAND, and no/100-----
DOLLARS (\$ 10,000.00), for the payment of which well and truly to be made, we bind ourselves, our heirs,
executors, administrators and assigns.

SEALED AND DATED THIS 3rd DAY OF April, 19 85.

THE CONDITIONS OF THE ABOVE OBLIGATION ARE SUCH THAT:

WHEREAS, Drainage in Mill Creek Subdivision, Section #8

have not been improved as required by the regulations of said _____
Obligee

NOW, THEREFORE, if said Principal
shall construct said Drainage

according to specifications and regulations of the Obligee
and comply with all the provisions of the ordinances, rules and regulations of said Obligee,
in relation to the mode, manner or form in which said work shall be done, and shall pay and save Obligee,
against loss or damage which may arise by reason of delay in completion of said work, by reason of the man-
ner in which said work is done or the quality of the materials furnished being in violation of the requirements
of any law of the State of Indiana, or any ordinance of the Obligee
controlling such work, then this obligation to be void; otherwise to be and remain in full force and effect.

CHARLES L. CROW & DAVID S. DAVIS

By: Matthew David D. Davis

GUARD CASUALTY & SURETY INSURANCE COMPANY

By: J.R. Morford
J.R. Morford, Attorney-in-fact

GCSI FORM No. 172

GUARD CASUALTY AND SURETY INSURANCE COMPANY

1317 N. Pennsylvania Indianapolis, Indiana 46244

SP N^o 8427

KNOW ALL MEN BY THESE PRESENTS, GUARD CASUALTY AND SURETY INSURANCE COMPANY a corporation duly organized under the laws of the State of Indiana, and having its general office in the city of Indianapolis, State of Indiana, has made, constituted and appointed, and does by these presents, make, constitute and appoint.

J.R. Morford of Indianapolis, Indiana

its true and lawful Attorney-in Fact with full power and authority hereby conferred to sign and deliver in its behalf as Surety, any and all kinds of Surety Bonds, except as limited hereon, and to bind GUARD CASUALTY AND SURETY INSURANCE COMPANY thereby as fully and to the same extent as if such instruments were signed by the duly authorized officers of GUARD CASUALTY AND SURETY INSURANCE COMPANY and all the acts of said Attorney-in-Fact, pursuant to the authority hereby given, are hereby ratified and confirmed, provided that the liability of the Company as surety on any such bond executed under this authority shall not exceed

\$100,000.00

THIS POWER VOID IF ALTERED OR ERASED OR IF POWER NUMBER IS NOT IN BLUE INK.

(This power does not authorize the execution of bonds for loan, financial or bank guarantees.)

The acknowledgement and execution of any such document by said Attorney-in-Fact shall be as binding upon the Company as if such bond had been executed and acknowledged by the regularly elected officers of the Company.

The signature of the President or a Vice President and the seal of the Company may be affixed by facsimile on any power of attorney granted, and the signature of the Assistant Secretary and the seal of the Company may be affixed by facsimile to any certificate of any such power and any such power or certificate bearing such facsimile signature and seal shall be valid and binding on the Company. Any such power so executed and sealed and certified by certificate so executed and sealed shall, with respect to any bond or undertaking to which it is attached, continue to be valid and binding on the Company.

GUARD CASUALTY AND SURETY INSURANCE COMPANY further certifies that the following is a true and exact copy of a resolution of the Board of Directors of GUARD CASUALTY AND SURETY INSURANCE COMPANY, duly adopted and now in force, to wit: All bonds of the corporation shall be executed in the corporate name of the Company by the President, any Vice President, or by such other officers as the Board of Directors may authorize. The President, any Vice President, or any Assistant Secretary may appoint Attorneys-in-Fact or agents who shall have authority to issue bonds in the name of the Company.

All authority hereby conferred shall expire and terminate, without notice, unless used before midnight of April 1, 1986, but until such time shall be irrevocable and in full force and effect.

IN WITNESS WHEREOF, the said GUARD CASUALTY AND SURETY INSURANCE COMPANY has caused these presents to be executed by its officer, with its corporate seal affixed, this date of April 3, 1985

GUARD CASUALTY AND SURETY INSURANCE COMPANY



By Leon E. Ellis
SS: _____ President

STATE OF INDIANA
COUNTY OF MARION

On this April 3, 1985, before me, a Notary Public, personally appeared Leon E. Ellis who being by me duly sworn, acknowledged that he signed the above Power-of-Attorney as an officer of the said GUARD CASUALTY AND SURETY INSURANCE COMPANY and acknowledged said instrument to be the voluntary act and deed of the corporation.

My commission expires: May 28, 1985



Sandra J. Pflum
Notary Public

CERTIFICATE OF COMPLETION AND COMPLIANCE

To: Hamilton County Surveyor

Re: Mill Creek, SEG. 8

I, hereby certify that:

- 1.) I am a Registered Land Surveyor in the State of Indiana;
- 2.) I am familiar with the plans and specifications for the above referenced subdivision.
3. The attached as-built drawing, to the best of my belief, is a true and correct representation of the installation, including, (a) storm sewers, (b) inlet/manholes, (e) culverts

Signature:

Allan H. Weihe

Date:

11/7/86

Typed or Printed Name: Allan H. Weihe

Business Address: 10505 N. College Ave.
Indianapolis, Indiana 46280

Telephone: (317)846-6611



INDIANA REGISTRATION NUMBER - 10398

FILED

DEC 3 1986

HAMILTON COUNTY DRAINAGE BOARD



SURVEYOR'S OFFICE
Hamilton County

Kenton C. Ward, Surveyor

776-9626

Noblesville, Ind. 46060 — December 10, — 1986


TO: Hamilton County Drainage Board

RE: Mill Creek, Section 8 Drain

I have inspected the drainage facilities for the Mill Creek Drain, Section 8 and have found them to be complete and acceptable. The project engineer has submitted the certificate of completion and compliance and a as built reproducible mylar of the drainage plan.


A change was made during construction on the open ditch on Lots 58 and 59. The swale was relocated so as to conform more naturally with existing topography. In doing so, seventy-five (75') feet was added to the drain. The final length is 4404.97 feet.


At this time I also recommend the Board approve the non-enforcement request for this plat, along with the drainage facilities as constructed.

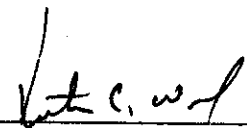

Kenton C. Ward
Hamilton County Surveyor


KCW/no

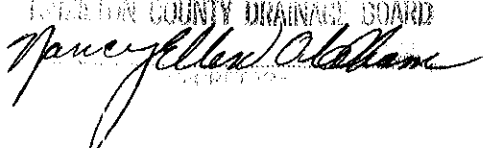FILED
JAN 12 1987
HAMILTON COUNTY DRAINAGE BOARD

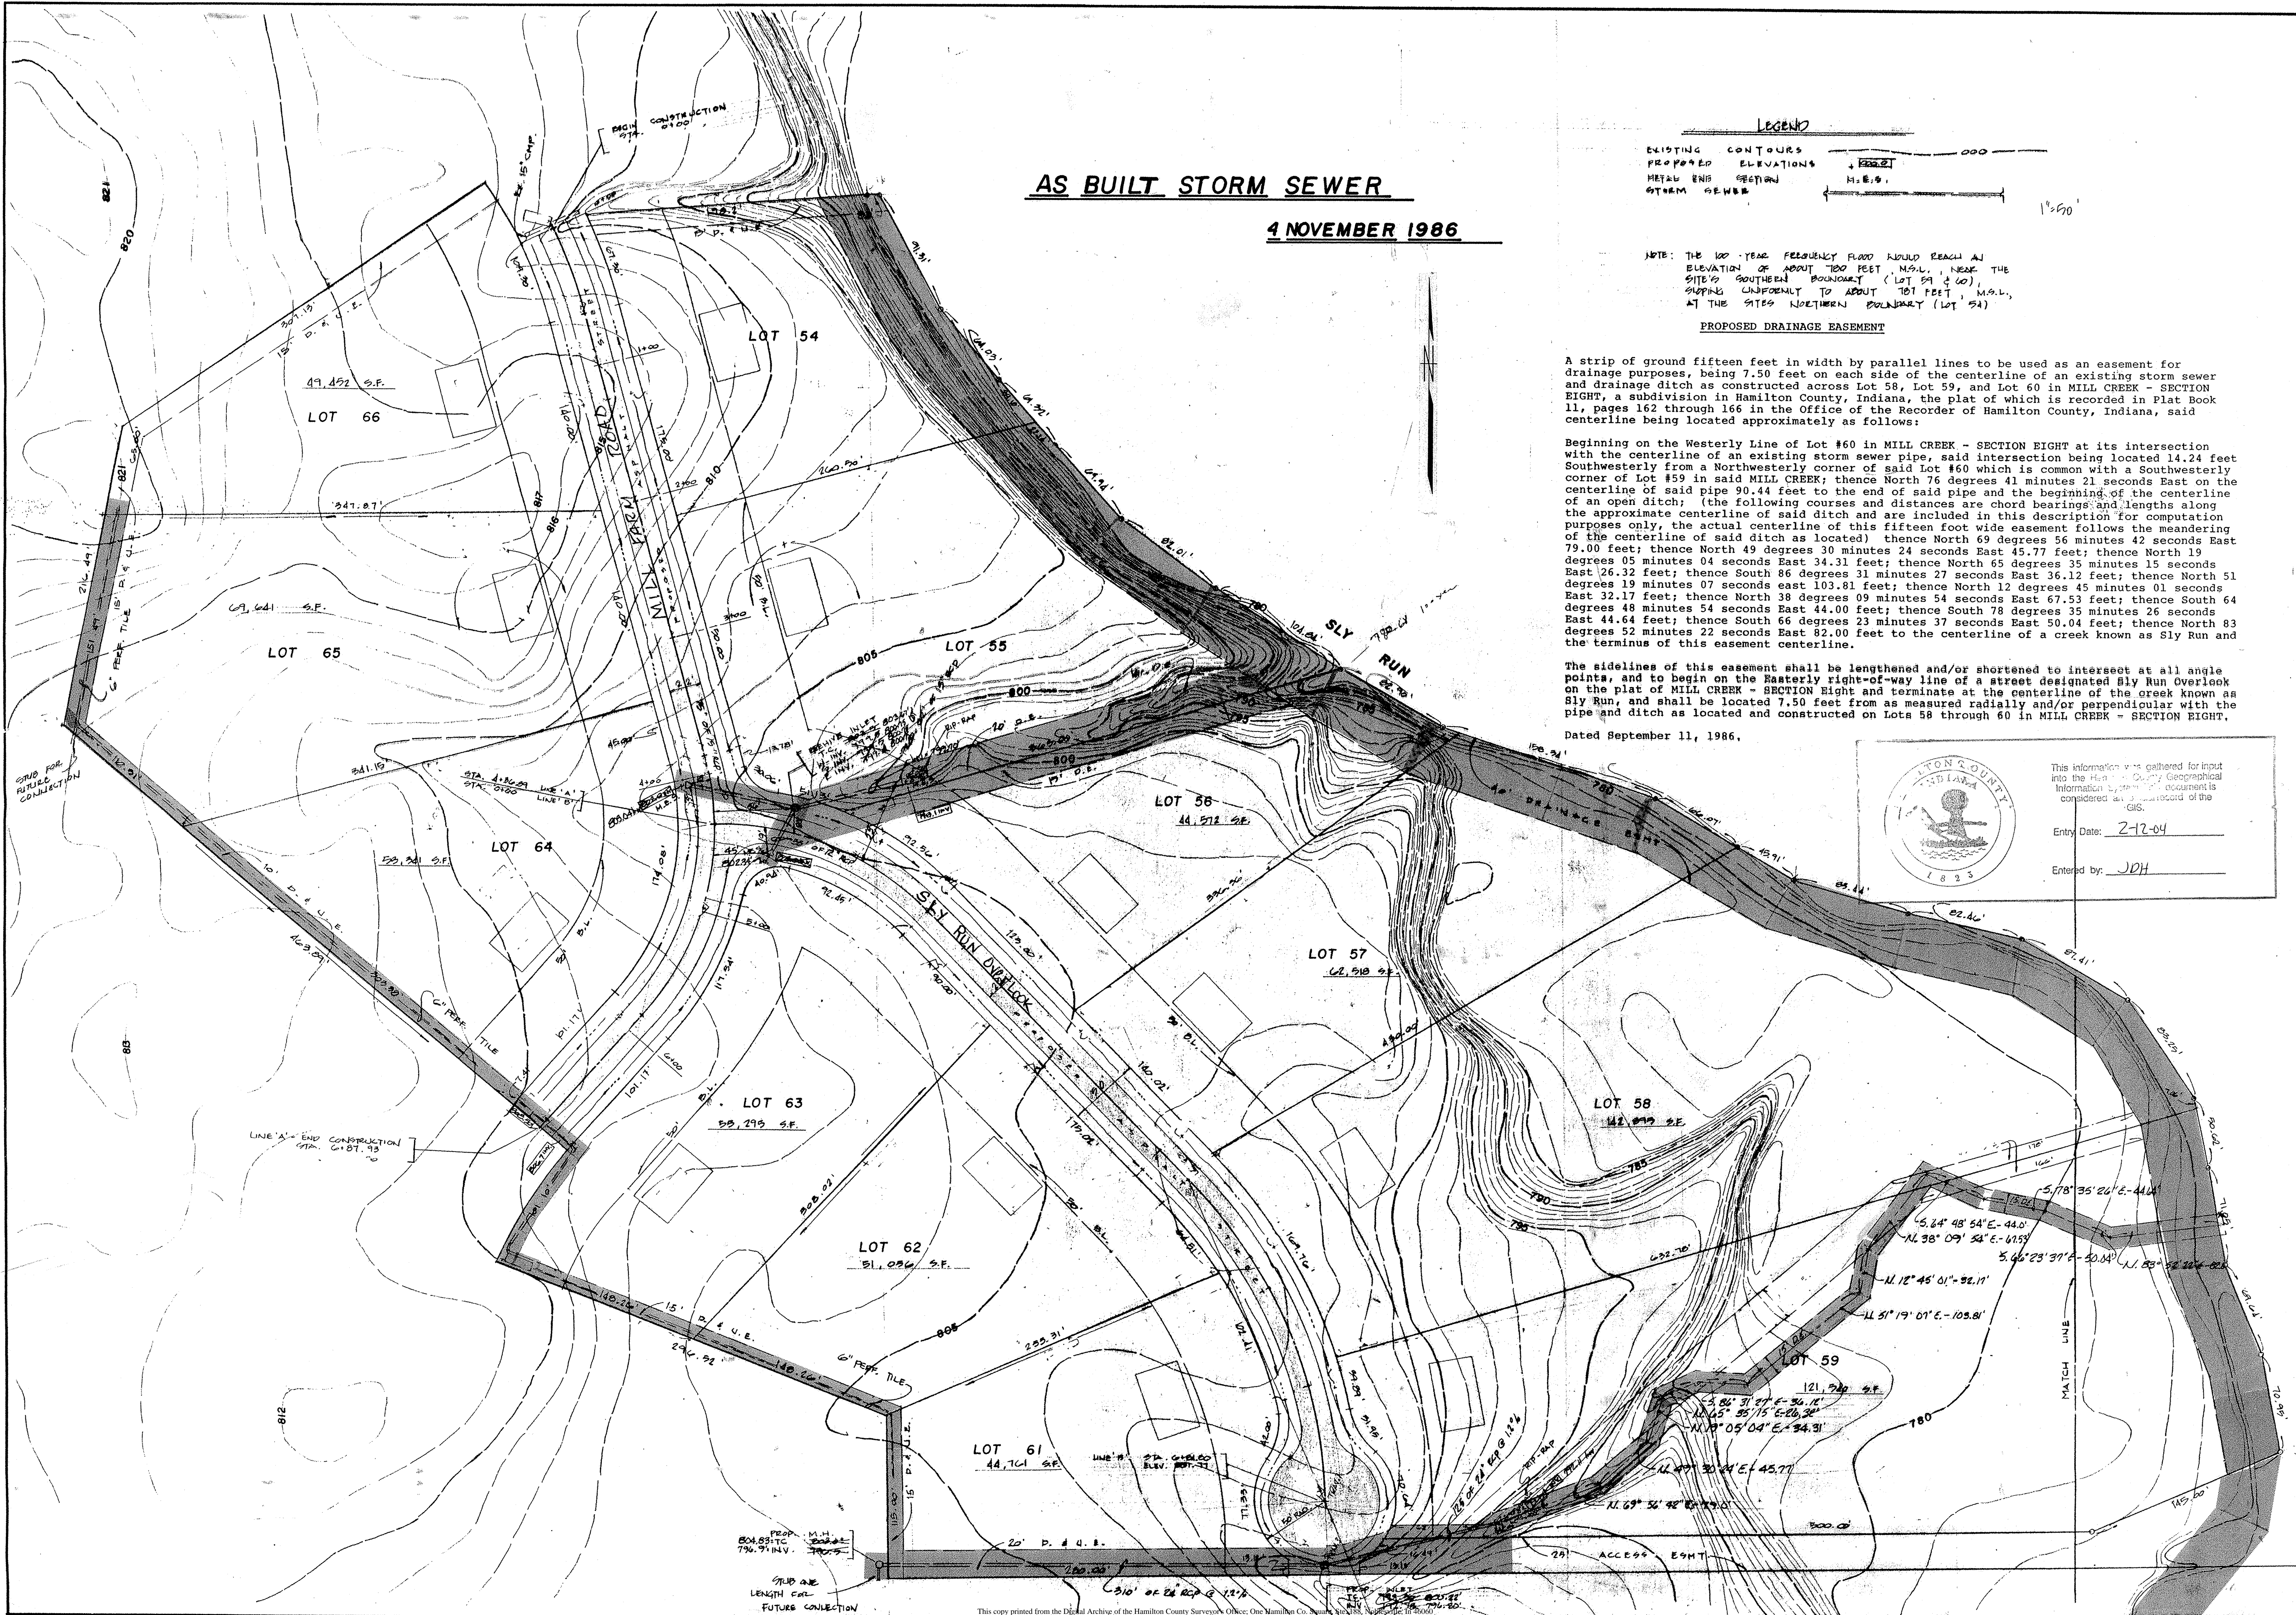


ALLAN H. WEIHE, P.E., L.S.
 PRESIDENT

WEIHE ENGINEERS INC.
 10505 NORTH COLLEGE AVENUE
 INDIANAPOLIS, INDIANA 46280
 (317) 846-6611

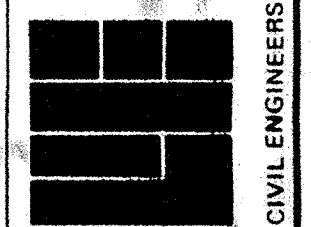

DATE: 11/14/86
 DRAWN BY: SDH
 CHECKED BY: JPH

REVISIONS: None
 DATE: 2-12-84
 ENTERED BY: JPH



CIVIL ENGINEERS
 LAND SURVEYORS
 LAND PLANNERS
 MILL CREEK SUBDIVISION SEC. 8
 DEVELOPMENT PLAN
 SHEET NO. 2
 OF