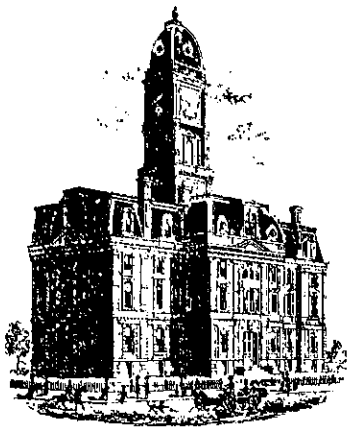

SURVEYOR'S OFFICE

# Hamilton County

Kenton C. Ward, CFM
Surveyor of Hamilton County
Phone (317) 776-8495
Fax (317) 776-9628

Suite 188
One Hamilton County Square
Noblesville, Indiana 46060-2230

## *Map Correction-Field Verification*

**Drain Number:** #312 **Drain Length:** N/A

**Drain Name:** VOWC - Village of West Clay Sec. 6003 & Commercial **Change +/-:** N/A

**Date:** 1-18-2011 **New Length:** N/A

**Verified By:** GRH & JLL

---

**Notes & Sketch:**

A structure was placed on the 36" RCP Running between existing structures 740 & 726. This structure (601) was placed with the Stratford Assisted Living Building. (See plans By Schneider Engineering dated 10.31.2005 with project No. 1238.044) Per the inspector, Str. 601 has a sump.

Suzanne L. Mills
GIS Specialist

This copy is from the Digital Archive of the Hamilton County Surveyor's Office; Noblesville, In 46060

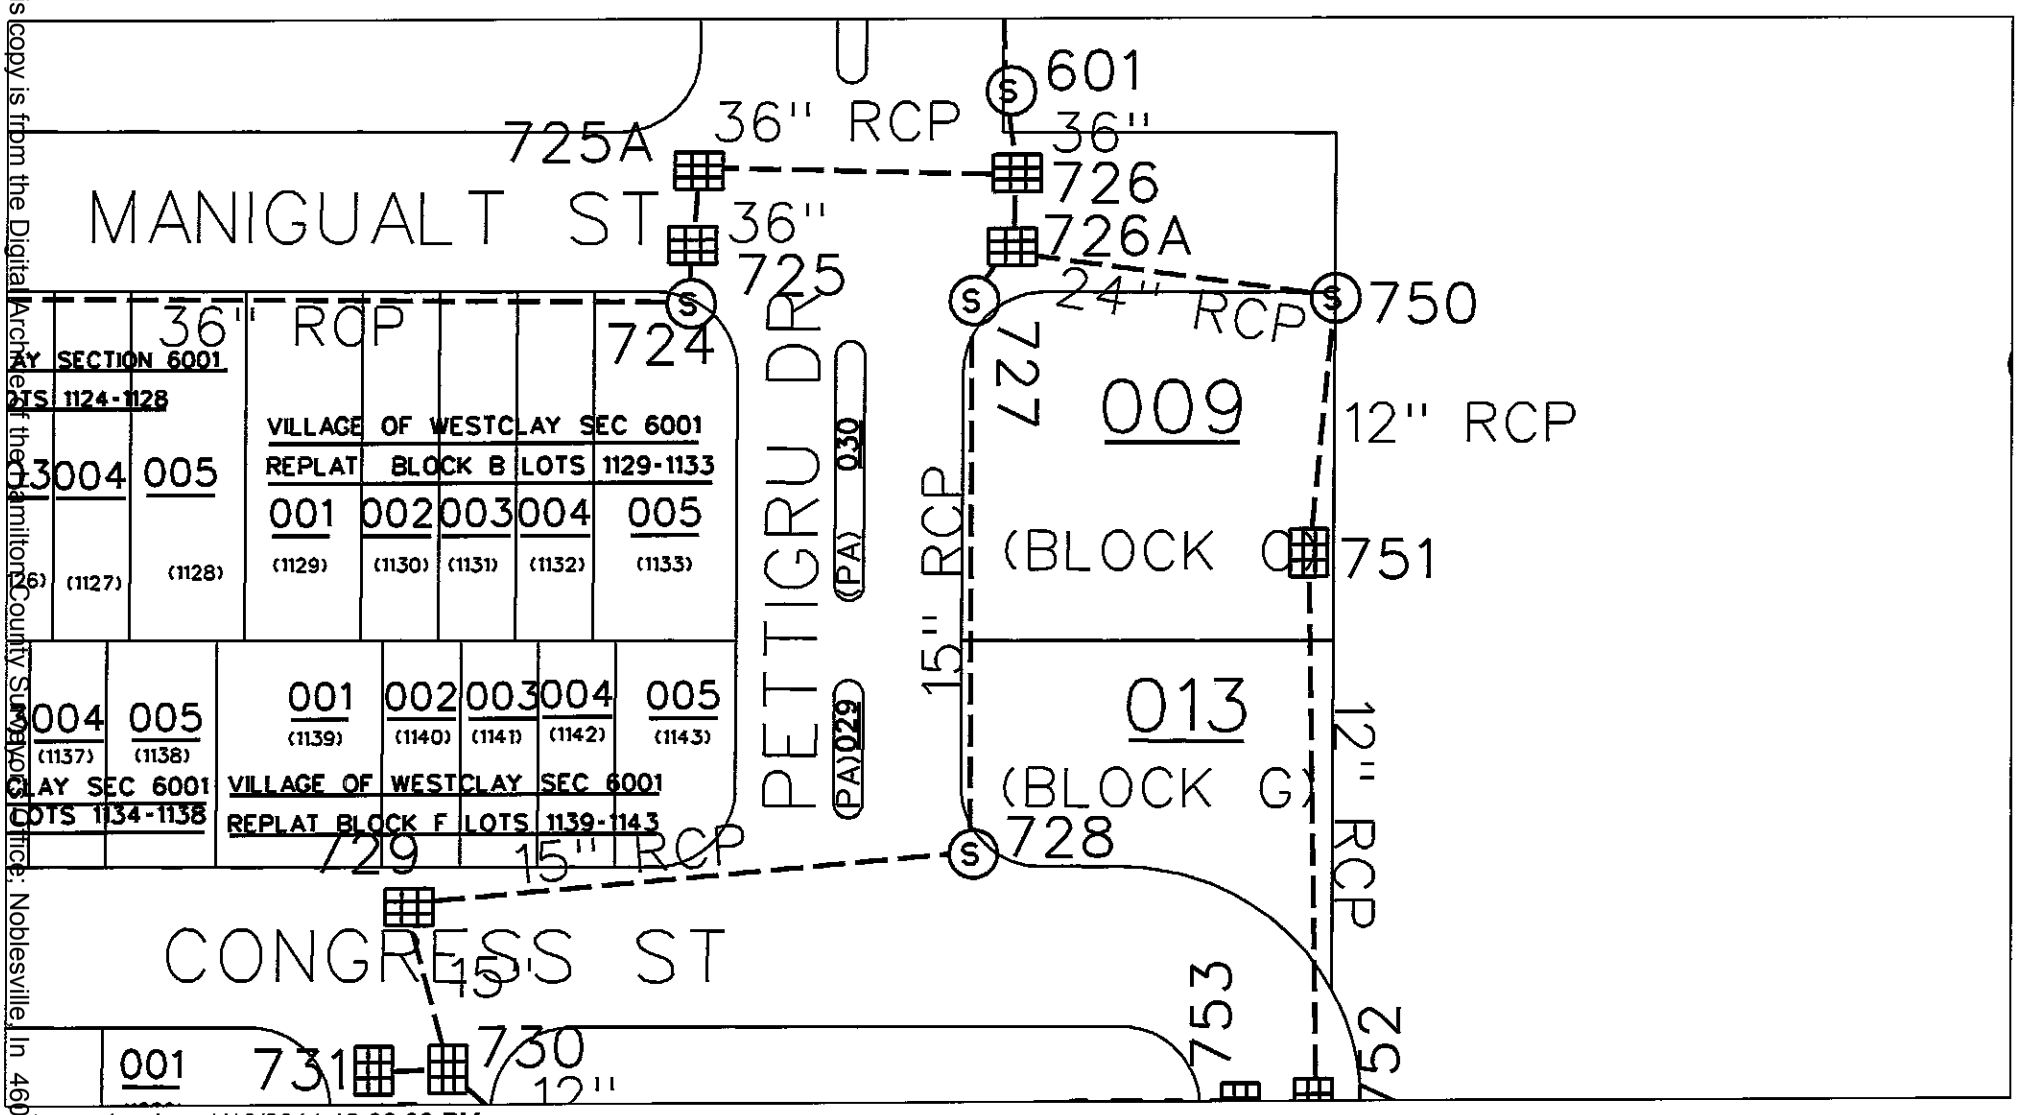


This copy is from the Digital Archive of the Hamilton County Surveyor's Office; Noblesville, In 46060