

Drain: SPRINGMILL POND DRAIN **Drain #:** 240
Improvement/Arm: SPRINGMILL POND-SECTION 3
Operator: JDH **Date:** 7-12-04
Drain Classification: Urban/Rural **Year Installed:** 1991

GIS Drain Input Checklist

- Pull Source Documents for Scanning JDH
- Digitize & Attribute Tile Drains NA
- Digitize & Attribute Storm Drains JDH
- Digitize & Attribute SSD JDH
- Digitize & Attribute Open Ditch JDH
- Stamp Plans JDH
- Sum drain lengths & Validate JDH
- Enter Improvements into Posse JDH
- Enter Drain Age into Posse _____
- Sum drain length for Watershed in Posse _____
- Check Database entries for errors JDH



SURVEYOR'S OFFICE

Hamilton County

Kenton C. Ward, Surveyor

776-9626

942 Maple Avenue

Noblesville, Indiana 46060

August 12, 1991

TO: Hamilton County Drainage Board

RE: Springmill Ponds Drain-Section 3

Attached is a petition, non-enforcement request, plans, calculations, quantity summary and assessment roll for the Springmill Ponds Drain-Section 3.

I have reviewed the submittals and petition and have found each to be in proper form.

I have made a personal inspection of the land described in the petition. Upon doing so, I believe that the drain is practicable; will improve the public health; benefit a public highway and be of public utility; and that the costs, damages and expenses of the proposed drain will probably be less than the benefits accruing to the owners of land likely to be benefitted. The drain will consist of the following:

6"	SSD	9220ft	18"	RCP	411ft
8"	CMP	20ft	21"	RCP	54ft
12"	RCP	502ft	24"	RCP	898ft
15"	RCP	43ft	27"	RCP	426ft

Dual 36" RCP 150ft Open Swale 1650ft

The total length of the drain will be 13,374 feet.

The open swale noted in the above lengths is that swale along the South side of 146th Street and running North to the pond in Village Farms. This swale runs along the North side of Lots 204 and 205 of Village of Mount Carmel, Section 8 and the East side of Lots 347, 348, 349 and 350 of Village Farms, Section 5. The dual 36" RCP is that which crosses under 146th Street at the North East corner of Lot 204, Village of Mount Carmel, Section 8.


The SSD shown above includes the 6" SSD under curbs and the SSD in the rear of the following lots: 83 to 90; 91 to 94; 96,97,98,99, 101,102,123,129,121,122,77 to 81 and 119 Only the main subsurface drain will be maintained. The laterals off the main line are private drains and will not be maintained as part of the regulated drain.

Lots 82 thru 91 may also be assessed for reconstruction or construction of the Springmill Crossing, or the Village of Mount Carmel Drains. However, for maintenance purpose, these lots are proposed to be assessed to the Springmill Ponds Drain only. All lots at some time in the future may also be assessed for reconstruction or maintenance of the Overman-Harvey Drain.

I have reviewed the plans and believe the drain will benefit each lot equally. Therefore, I recommended each lot be assessed equally. I recommend a maintenance assessment of \$25.00 per lot, \$5.00 per acre for roadways. With this assessment the total

annual assessment for the drain/this section will be \$ ^{1182⁰⁰} ~~4482.86~~

I recommend a hearing be set for October 1991. At that time I recommend the non-enforcement request be approved by the Board.

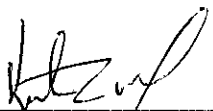

Kenton C. Ward
Hamilton County Surveyor

KCW/no
cc: file

UNION STATE BANK

21 Jefferson Square • P. O. Box ~~298~~ 1710 • Carmel, Indiana 46032

TELEPHONE
AREA CODE 317
846-7381

IRREVOCABLE
LETTER OF CREDIT NO. **1102**

DATE August 5, ~~XXXX~~ 1991

BENEFICIARY

Hamilton County Commissioners
and City of Carmel
Hamilton County Courthouse
Noblesville, Indiana 46060

FOR ACCOUNT OF

Dart Development, Inc.
1841 Ludlow Avenue
Indianapolis, Indiana 46201

Storm Sewers - Springmill Ponds
Section III

GENTLEMEN:

WE HEREBY ESTABLISH OUR CREDIT IN YOUR FAVOR, FOR THE ACCOUNT INDICATED ABOVE, FOR A SUM OR SUMS NOT EXCEEDING AN AGGREGATE AMOUNT OF Forty Six Thousand Two Hundred and no/100 Dollars (\$46,200.00)

FUNDS ARE AVAILABLE BY YOUR DRAFT(S) AT Carmel, Indiana DRAWN ON UNION STATE BANK
UNION STATE BANK, P. O. Box 1710, Carmel, Indiana 46032

Drafts are to be accompanied by:

Original Letter of Credit


Beneficiary's signed certificate stating that the applicant has failed to construct the necessary storm sewers at the applicant's Springmill Ponds, Section III Subdivision.

ALL DRAFTS DRAWN UNDER THIS LETTER OF CREDIT ARE TO BE ENDORSED HEREON AND SHALL BEAR THE CLAUSE "DRAWN UNDER UNION STATE BANK LETTER OF CREDIT No. (AS INDICATED ABOVE)," and must be drawn and presented on or before August 5, 1992

WE HEREBY AGREE WITH YOU THAT ALL DRAFTS DRAWN UNDER AND IN COMPLIANCE WITH THE TERMS OF THIS LETTER OF CREDIT WILL BE DULY HONORED UPON PROPER PRESENTATION.

Except as otherwise expressly stated herein this Credit is subject to the Uniform Customs and Practice for Documentary Credits (1983 Revision), International Chamber of Commerce, Publication ~~290~~ 400.

VERY TRULY YOURS,

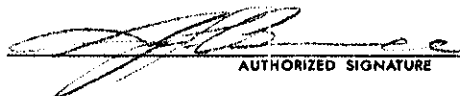
AUTHORIZED SIGNATURE

George F. Burrell, President

TITLE

Walter H. O.

UNION STATE BANK

21 Jefferson Square • P. O. Box 1710 • Carmel, Indiana 46032

TELEPHONE
AREA CODE 317
846-7381

IRREVOCABLE
LETTER OF CREDIT NO. **1103**

DATE August 5, 1991

BENEFICIARY

Hamilton County Commissioners
and city of Carmel
Hamilton County Courthouse
Noblesville, Indiana 46060

FOR ACCOUNT OF

Dart Development, Inc.
1841 Ludlow Avenue
Indianapolis, Indiana 46201

Sub-surface Drains - Springmill Ponds
Section III

GENTLEMEN:

WE HEREBY ESTABLISH OUR CREDIT IN YOUR FAVOR, FOR THE ACCOUNT INDICATED ABOVE, FOR A SUM OR SUMS NOT EXCEEDING AN AGGREGATE AMOUNT OF **Eighteen Thousand Five Hundred Fifty and no/100 Dollars (\$18,550.00)**

FUNDS ARE AVAILABLE BY YOUR DRAFT(S) AT Carmel, Indiana
UNION STATE BANK, P. O. Box 1710, Carmel, Indiana 46032

DRAWN ON UNION STATE BANK

Drafts are to be accompanied by:

Original Letter of Credit


Beneficiary's signed certificate stating that the applicant has failed to construct the necessary sub-surface drains at the applicant's Springmill Ponds, Section III Subdivision.

ALL DRAFTS DRAWN UNDER THIS LETTER OF CREDIT ARE TO BE ENDORSED HEREON AND SHALL BEAR THE CLAUSE "DRAWN UNDER UNION STATE BANK LETTER OF CREDIT No. (AS INDICATED ABOVE)," and must be drawn and presented on or before **August 5, 1992**

WE HEREBY AGREE WITH YOU THAT ALL DRAFTS DRAWN UNDER AND IN COMPLIANCE WITH THE TERMS OF THIS LETTER OF CREDIT WILL BE DULY HONORED UPON PROPER PRESENTATION.

Except as otherwise expressly stated herein this Credit is subject to the Uniform Customs and Practice for Documentary Credits (1977 Revision), International Chamber of Commerce, Publication **250**, 400.

VERY TRULY YOURS,

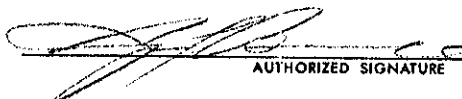
AUTHORIZED SIGNATURE

George F. Burrell, President

TITLE

CERTIFICATE OF COMPLETION AND COMPLIANCE

TO: HAMILTON COUNTY SURVEYOR

RE: Springmill Ponds Section III

I hereby certify that:

- 1.) I am a Registered Land Surveyor in the State of Indiana,
- 2.) I am familiar with the plans and specifications for the above referenced subdivision,
- 3.) I have personally observed and supervised the completion of the Drainage Facilities for the above referenced subdivision, and
- 4.) To the best of my knowledge, information and belief, the Drainage Facilities within the subdivision has been installed and completed in conformity with all plans and specifications.

Signature: Stephen E. Bourquein Date: June 10, 1992

Type or Printed Name: Stephen E. Bourquein

Business Address: MSE Corporation

501 Congressional Blvd., Suite 110, Carmel, IN 46032

Telephone: (317) 843 5080



INDIANA REGISTRATION NUMBER

S0441



SURVEYOR'S OFFICE
Hamilton County

Kenton C. Ward, Surveyor

Phone (317) 776-8495

Fax (317) 776-9628

Suite 146

One Hamilton County Square

Noblesville, Indiana 46060-2230

October 17, 1996

TO: Hamilton County Drainage Board

RE: Springmill Ponds Drain-Springmill Ponds Section 3

Attached are As-Builts, Certificate of Completion and Compliance, and other information for Springmill Pond Drain-Springmill Ponds Section 3. An inspection of the drainage facilities for this section has been made and the facilities were found to be complete and acceptable.

During construction, changes were made to the drain which will alter the plans submitted with my report for this drain dated August 12, 1991. The changes are as follows:

STR 154-156 was missed on the original report. This structure consists of 12" RCP at a length of 42 feet.* STR 134-135 consists of 24" RCP, which was shortened from 169 feet to 168 feet.* Structure ~~159~~¹⁶² to ~~166~~¹⁶⁷ consist of 24" RCP which was shortened from 51 feet to 57 feet of 24" RCP. Structure 167 to 166 consist of 24" RCP which was shortened from 184 feet to 181 feet.* Structure 145 to 146 consists of 24" RCP which was shortened from 139 feet to 137 feet.* Structure 141 to 142 which consists of 27" RCP, which was shortened from 82 feet to 62 feet.*

NOTE: The open ditch on the North side of 146th Street that runs through Village Farms Section 7 is a part of the Overman-Harvey Drain-see report dated October 15, 1993.

The length of the drain due to the changes described above is now 13,395 feet.


13,396'

The non-enforcement request was approved by the Board at its meeting on October 21, 1991.

The bonds or letters of credit from Union State Bank, numbers 1102 and 1103, dated August 5, 1991, in the of amounts of


\$46,200.00 and \$18,550.00 have been released.

I recommend the drains construction as complete and acceptable.

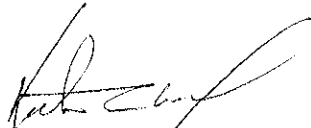

Kenton C. Ward *SLW*
Hamilton County Surveyor
KCW/no

Village Farms Sec. 7

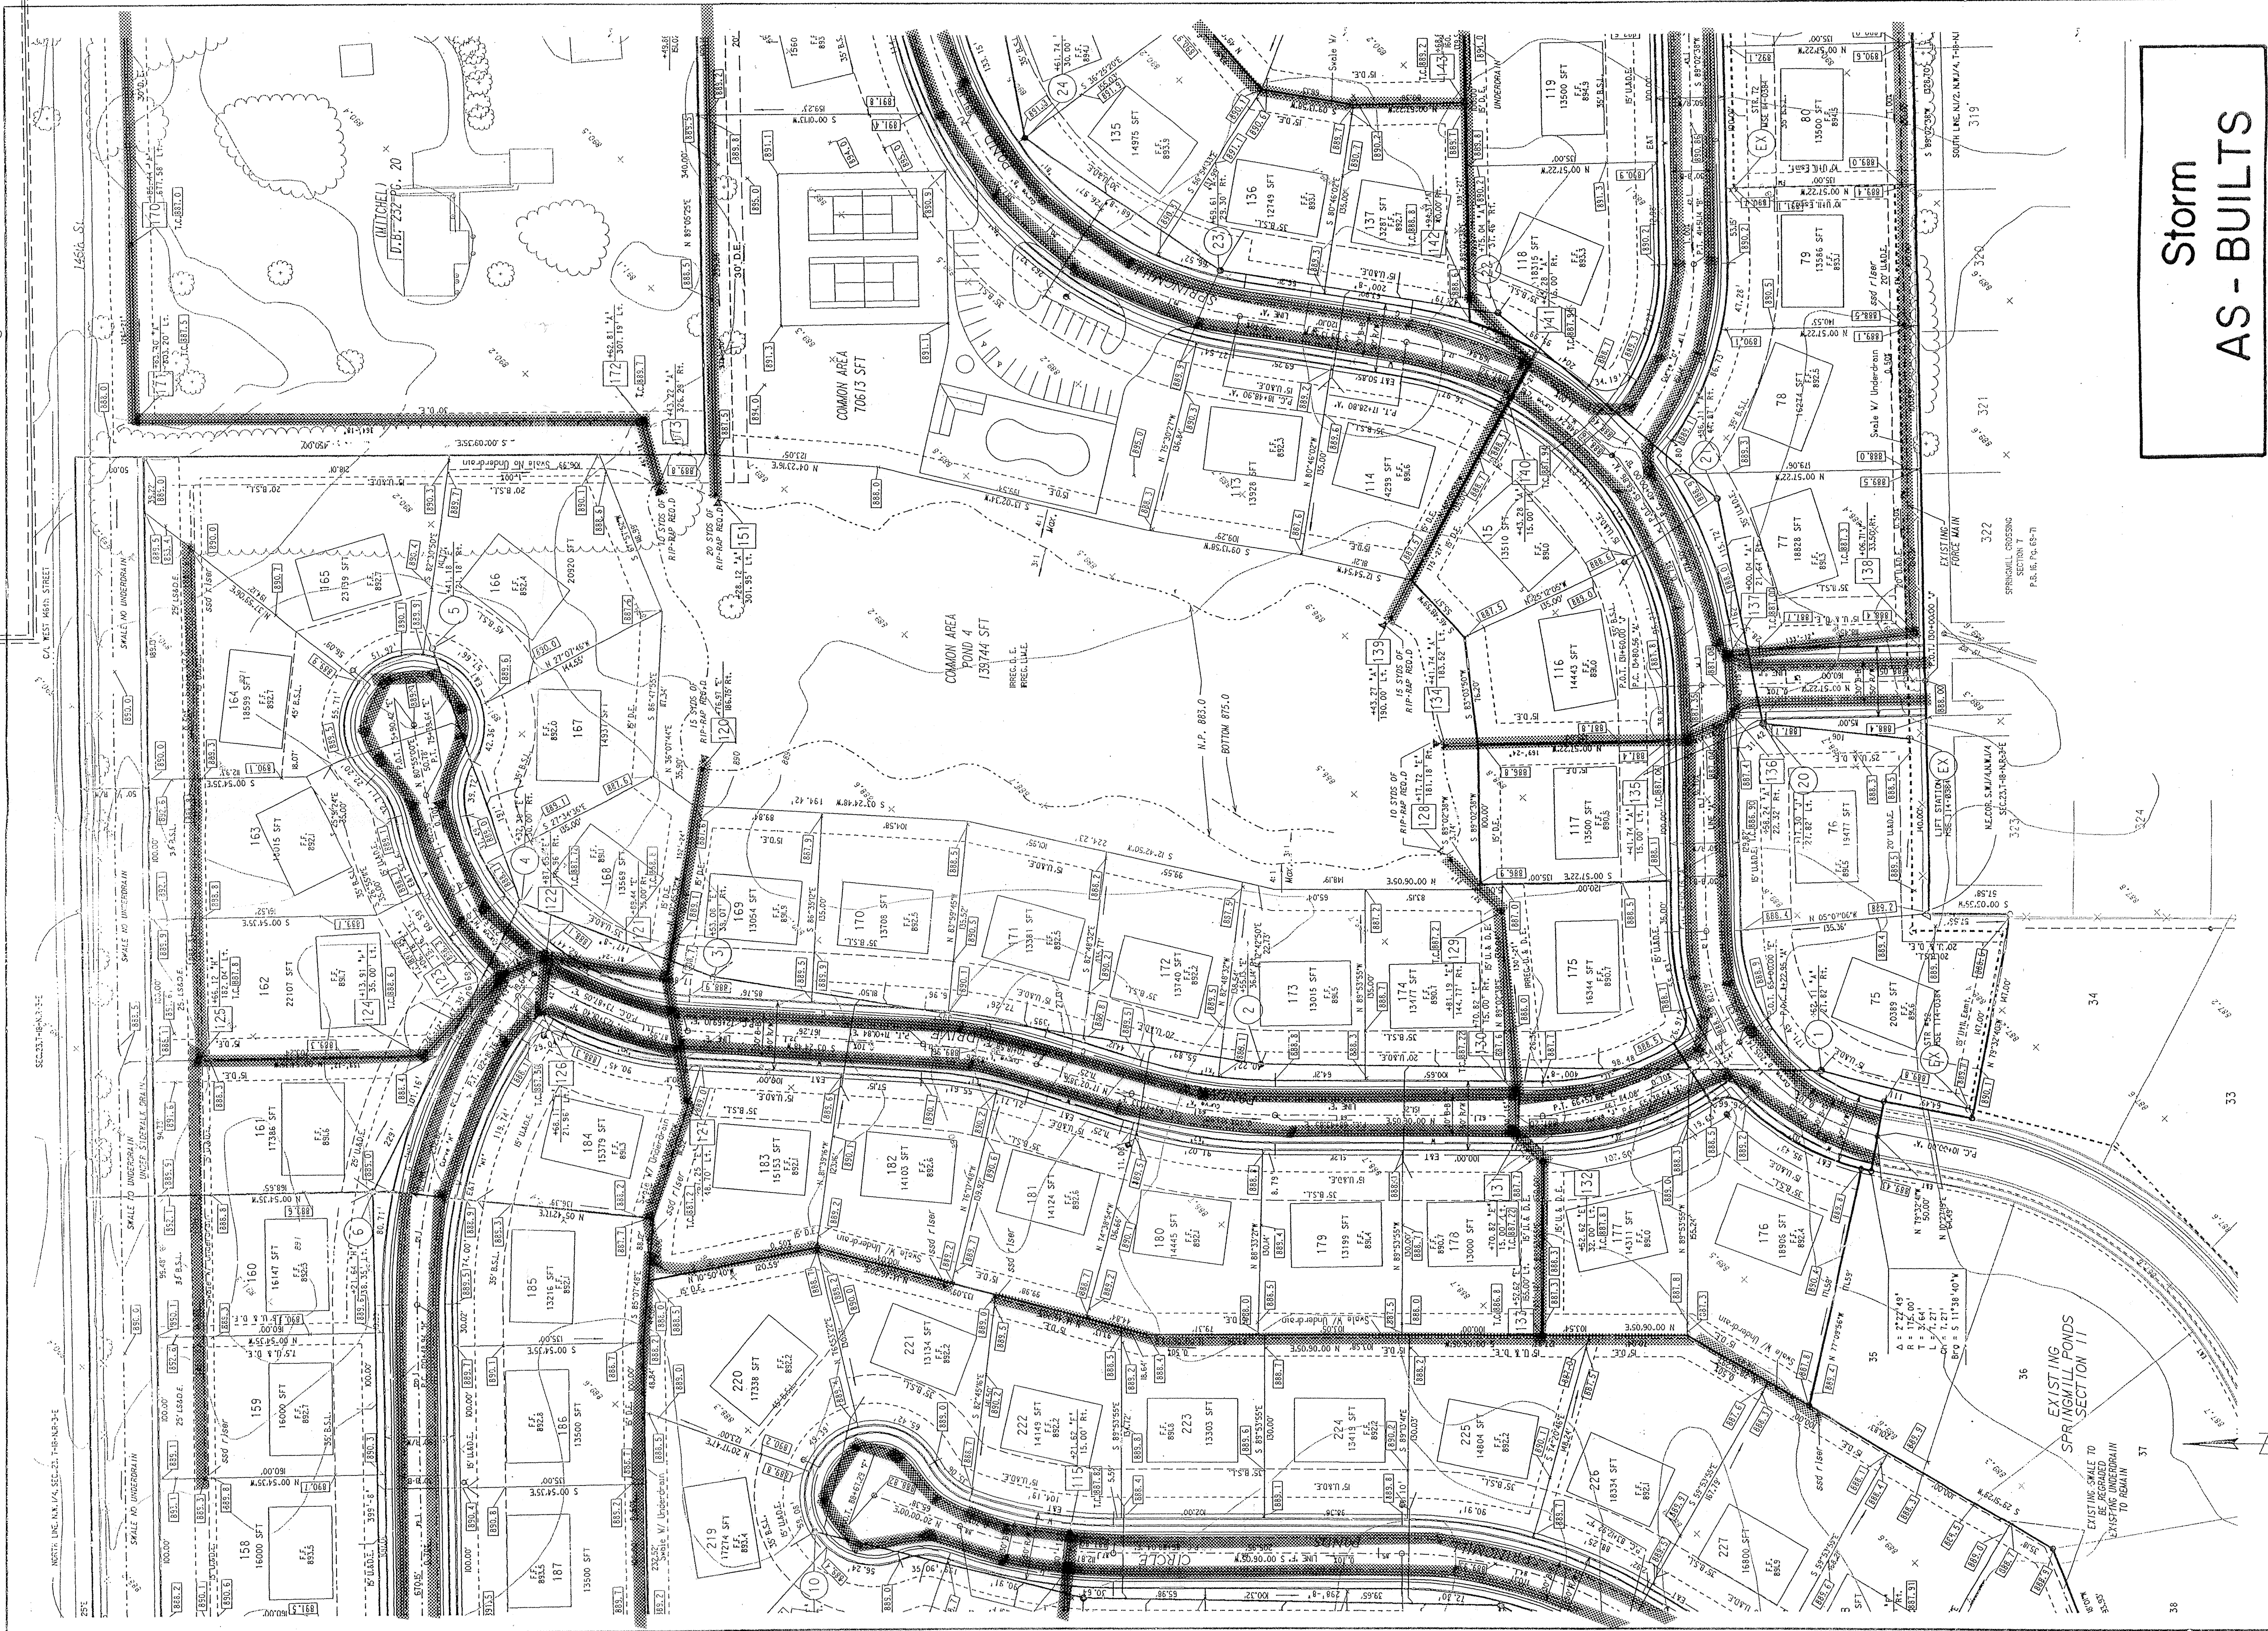

Storm AS - BUILTS

11th SITE DEVELOPMENT PLAN
SPRINGMILL PONDS
 SECTIONS III - IV

Scale: 1" = 50'

DATE: 4/9/02

SHEET No. 2 of 10

DESIGNED BY: B.L.H.
 CHECKED BY: M.A.L.
 APPROVED BY: D.M.N.

DATE: JUNE 7, 1991

REVISED AND DUBS:
 7-19-91 Add Existing Lots 159, 160, 225, 226
 7-19-91 Rev. Existing Lots 161 & 162
 7-19-91 Rev. Pond Signs
 7-19-91 Add H.P. Area, Paved Area
 7-25-91 Rev. L&E to S.D.E.
 8-19-91 Rev. Lateral Location for POC Area

13325


This copy printed from the Digital Archive of the Hamilton County Surveyor's Office, One Hamilton Co. Square, Ste. 188, Noblesville, IN 46060

Village Farms Sec. M

SECTIONAL PLATS SECTIONS III - IV










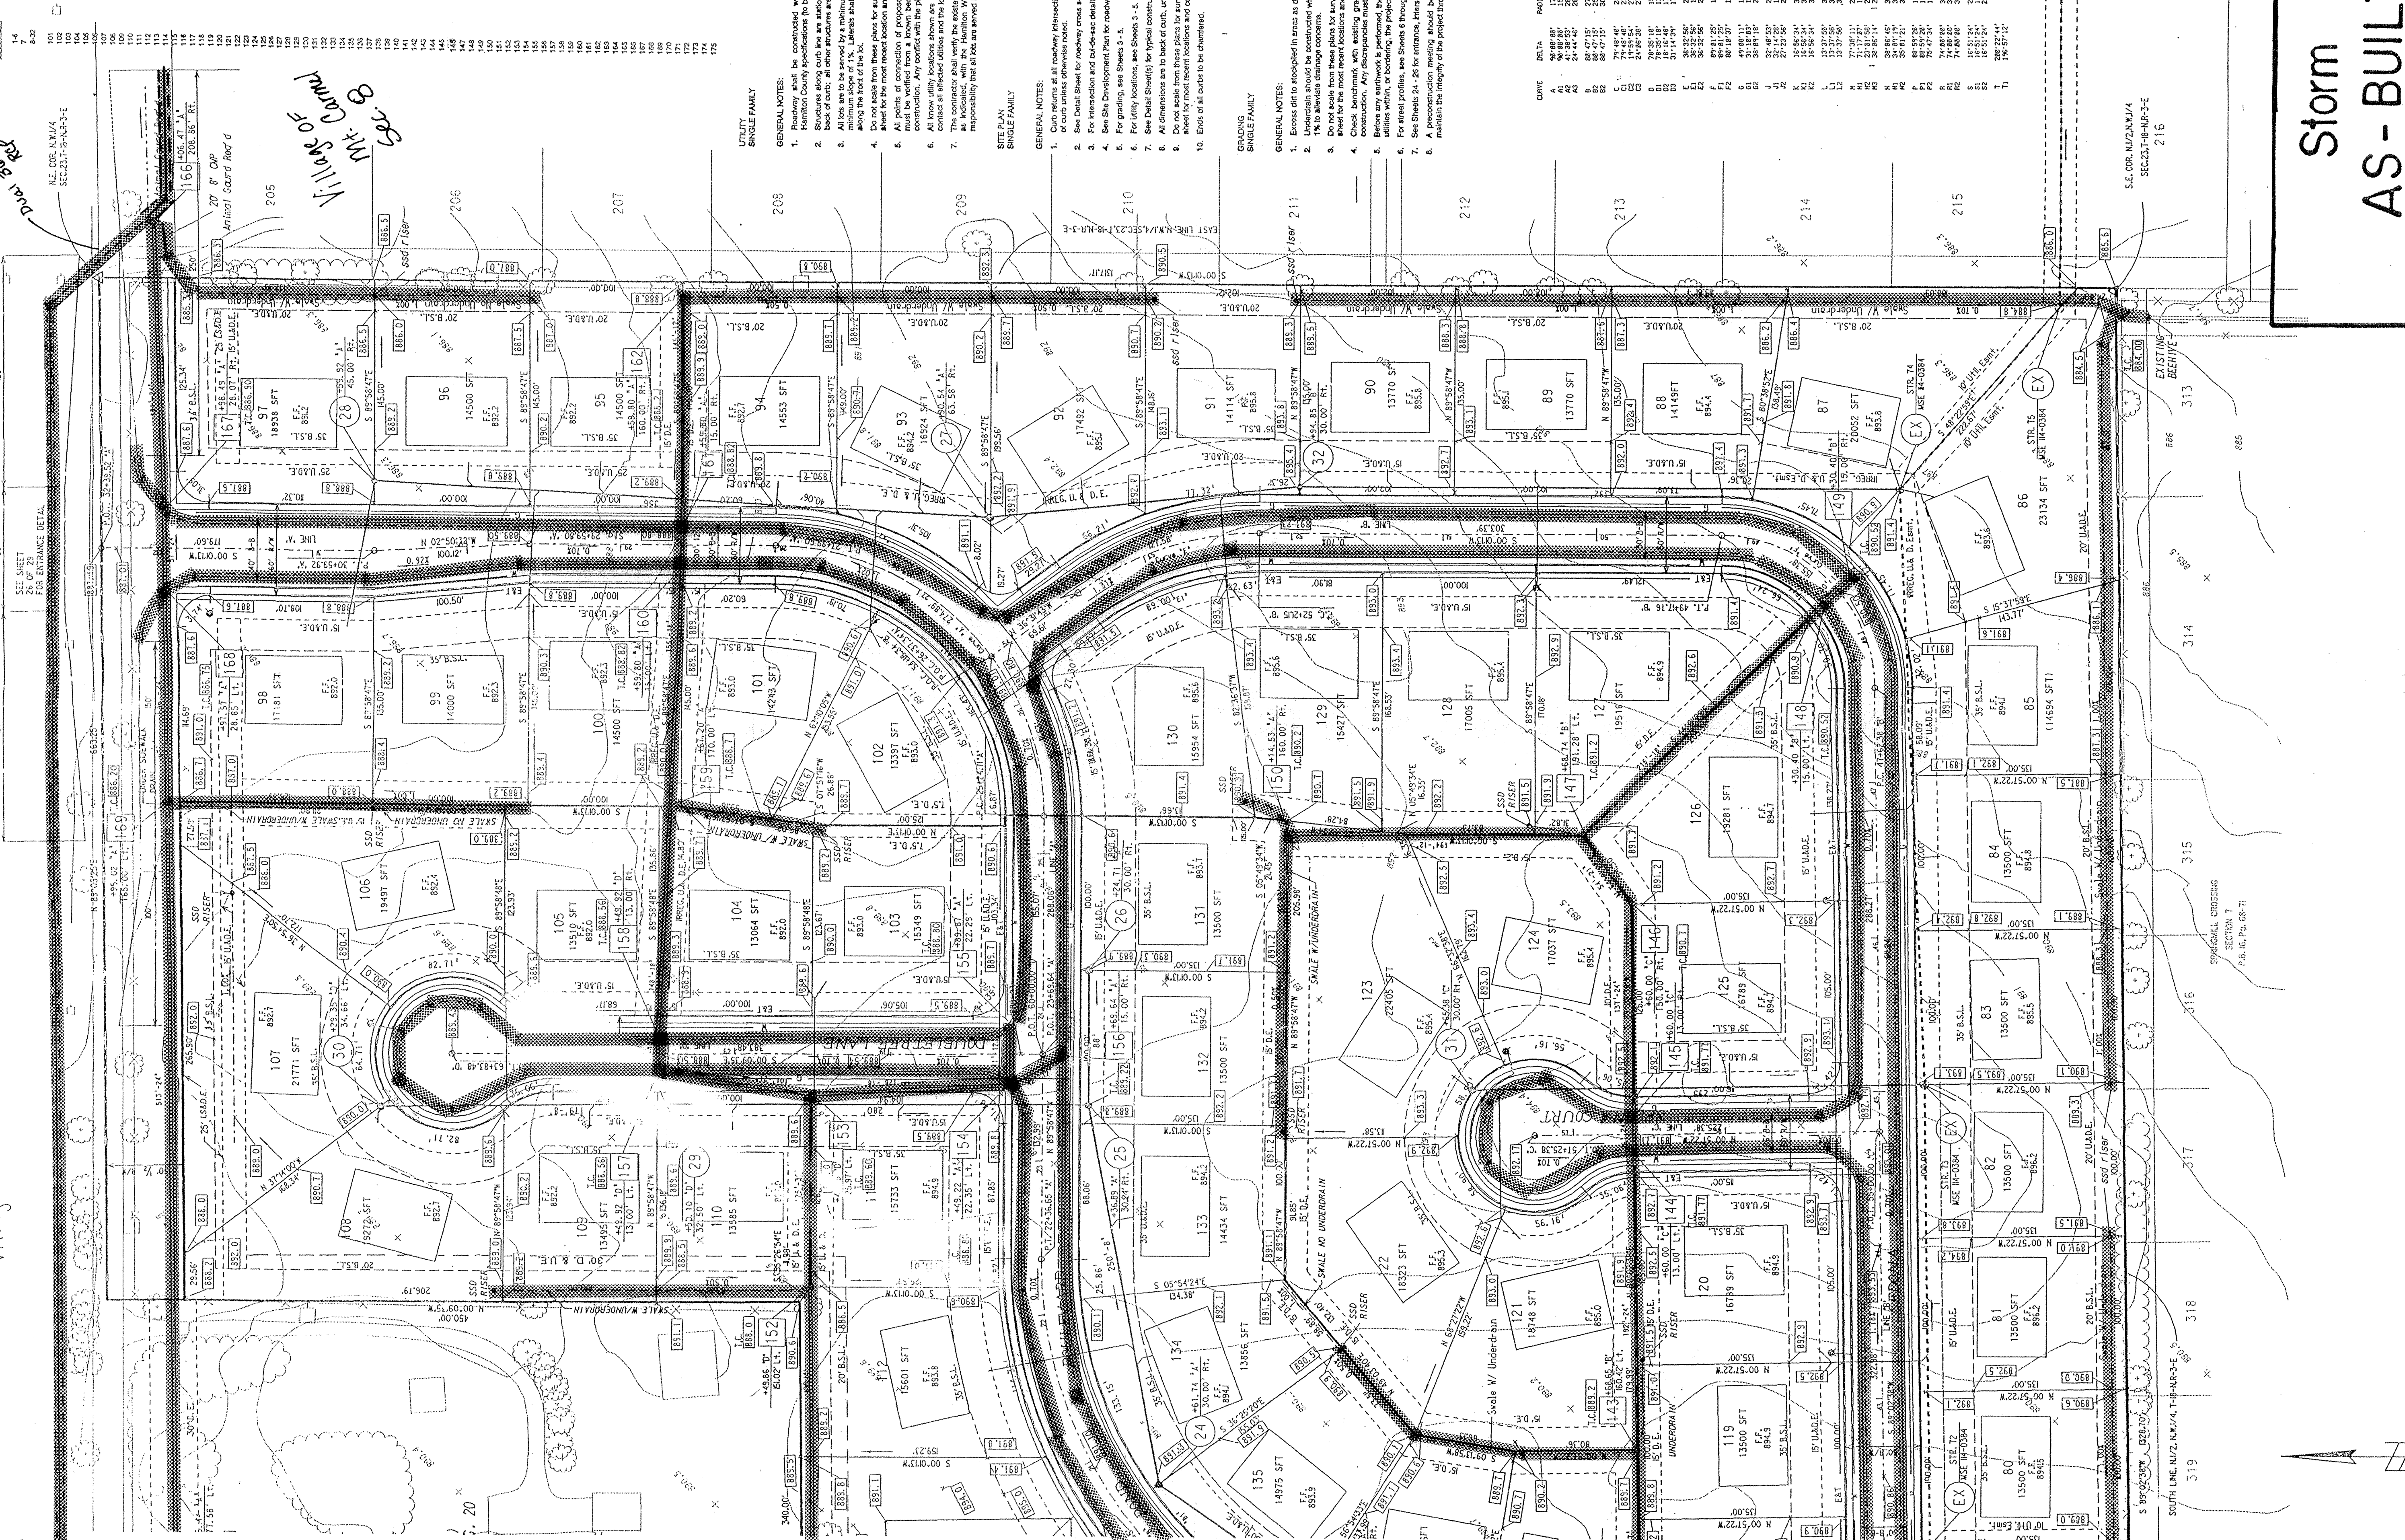

Storm AS-BUILTS

THE SITE DEVELOPMENT PLAN
SPRINGMILL PONDS
SECTIONS III - IV

Scale: 1" = 50'
 Job No: 114-0491
 Sheet No: 3 of 10
 Date: JUNE 7, 1991
 PRF: 4950FP
 DGN: 4950FP

Revisions and Notes:

- 7-15-91 Rev. Scale Grades Lots 100-110
- 7-15-91 Add DE Lots 102-103
- 7-17-91 Add Annual Guard Str 116 & 20 of 116
- 7-19-91 Add Easement Lots 126 & 131
- 7-19-91 Rev. Area and Detail Lots 126 & 131
- 7-25-91 Rev. LSE to AS & DE

Designed by: B.F.H.
Drawn by: M.A.L.
Checked by: [Blank]
Approved by: D.M.M.

Professional Seal: 13325
 M. NEUMANN
 REGISTERED PROFESSIONAL ENGINEER
 STATE OF INDIANA

Company: MSE Engineering
 MSE Corporation
 501 Congressional Boulevard
 Suite 110
 Carmel, IN 46032
 317-843-5080
 317-843-5089 FAX