


Drain: WILSON - HAGLE **Drain #:** 175
Improvement/Arm: TOWN OF ARCADIA RECONSTRUCTION
Operator: J. L. WINKELSTEADT **Date:** 7-8-04
Drain Classification: Urban/Rural **Year Installed:** 1999

GIS Drain Input Checklist

- Pull Source Documents for Scanning
- Digitize & Attribute Tile Drains
- Digitize & Attribute Storm Drains
- Digitize & Attribute SSD
- Digitize & Attribute Open Ditch
- Stamp Plans
- Sum drain lengths & Validate
- Enter Improvements into Posse
- Enter Drain Age into Posse
- Sum drain length for Watershed in Posse
- Check Database entries for errors

J. L. Winkelsteadt
J. L. Winkelsteadt
J. L. Winkelsteadt
J. L. Winkelsteadt
J. L. Winkelsteadt
J. L. Winkelsteadt
J. L. Winkelsteadt
J. L. Winkelsteadt
J. L. Winkelsteadt
J. L. Winkelsteadt
J. L. Winkelsteadt

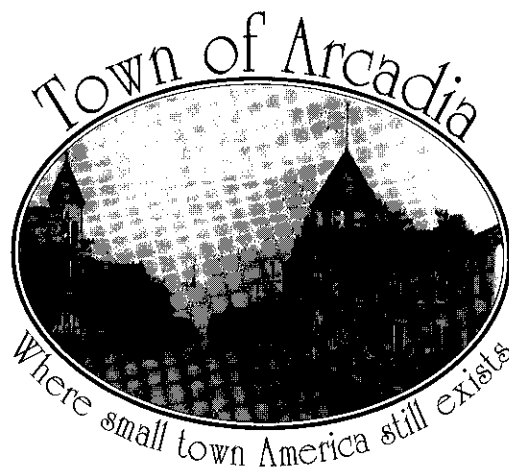

March 5, 1999

Hamilton County Surveyor's Office
Mr. Kenton Ward
One Hamilton County Square, Ste. 146
Noblesville, Indiana 46060

Dear Mr. Ward:

The Town of Arcadia will be replacing the south section of the Wilson-Nagle Drain. The work will be done by Ward Construction of Arcadia. The Town of Arcadia will be paying for the labor and material as agreed in the contract signed by the Arcadia Town Council and the Hamilton County Drainage Board on the 15th day of June, 1983.

The work will start at a point south of East Main Street and continue south in the existing Wilson-Nagle Drain location ending on West Main Street. The contractor will notify the Town of all connections and laterals to the drain. This information will be forwarded to your office by the Town of Arcadia. The contractor will be replacing the tile using the same size that is existing at this time.

If you have any questions, please feel free to call me at 317-984-3512.


Sincerely,

John Phiifer
Supervisor



A
N
1" = 100'
WILSON
NAGLE
DRAIN

wilson 9-19-03.dgn 8/30/2004 7:48:17 AM

 This information was gathered for input into the Hamilton County Geographical Information System. This document is considered an official record of the GIS.

Entry Date: 9-8-04

Entered by: [Signature]