

Drain: KERCHEVAL-REGAN **Drain #:** 167
Improvement/Arm: Joint REGAN
Operator: J. LIVINGSTON **Date:** 2-12-04
Drain Classification: Urban/Rural **Year Installed:** 1899

GIS Drain Input Checklist

- Pull Source Documents for Scanning JL
- Digitize & Attribute Tile Drains JL
- Digitize & Attribute Storm Drains _____
- Digitize & Attribute SSD _____
- Digitize & Attribute Open Ditch _____
- Stamp Plans _____
- Sum drain lengths & Validate JL
- Enter Improvements into Posse _____
- Enter Drain Age into Posse JL
- Sum drain length for Watershed in Posse JL
- Check Database entries for errors JL

Gasb 34 Footages for Historical Cost
Drain Length Log

Drain-Improvement: KERCHEVAL - REGAN - Jettal REGAN

Drain Type:	Size:	Length	Length (DB Query)	Length Reconcile	If Applicable	
					Price:	Cost:
TILE	15"	2490'	2490'		5. ⁰⁰ /lf	12,450. ⁰⁰

Sum: 2490' 2490' 12,450.⁰⁰

Final Report: 2490'

Comments:


Commissioner's Record
 Book 11
 pg. 354

Sarah C Coz	3 ^W out @ WNW @ E	34	20	3	5	5	20	20	0+3	1	97	32	1764
Josiah Harvey	7 ^W out @ S ^W NW @ E	34	20	3	7	7	28	28	6+46	7+74	128	37	2469
John Reugin PA	@ E	34	20	3	17	17	68	68	17+18	20+66	348	94	5996

John Reagan Drain
 Jul 7 1899

Beginning at a point 295 feet north and 12 feet east of the Northeast corner of the South half of the South west quarter of section thirty four (34) Township twenty (20) range (3) three east and run thence from Stake 0 to Stake 4 N 59° E. Thence from Stake 4 to Stake 5+40 N 56° east, Thence from Stake 5+40 to Stake 13 East from Stake 13 to 15 @ 30° E Thence from Stake 15 to Stake 16 @ 50° E Thence from Stake 16 to Stake 17+50 @ 69° E Thence from Stake 17+50 to Stake 24+90, East end terminating 18 feet north of Stake 119 on an open drain known as the Elifah Jay Ditch Said ditch to consist of 1 row of 15 inch tiles from Stake 0 to 24+90 or terminus Tile used to be first class in every respect and must be laid in the ditch in a true line and at the proper grade and must be left uncovered until inspected

John Reagan Ditch

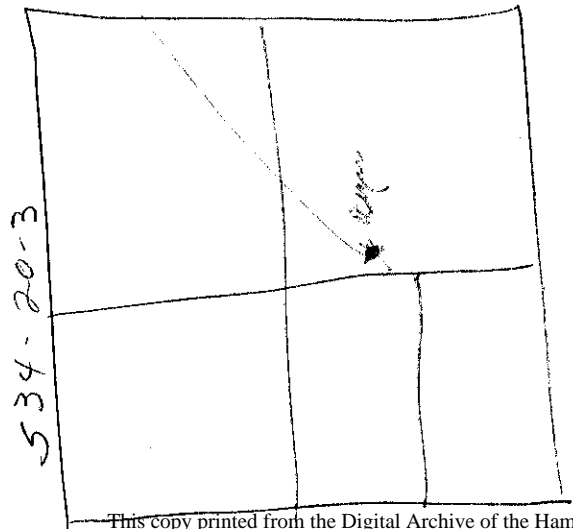

Reagan ditch point 295 ft north of 12 ft ditch
 to NE cor SW 1/4
 See 30-20-3
 Reagan ditch