
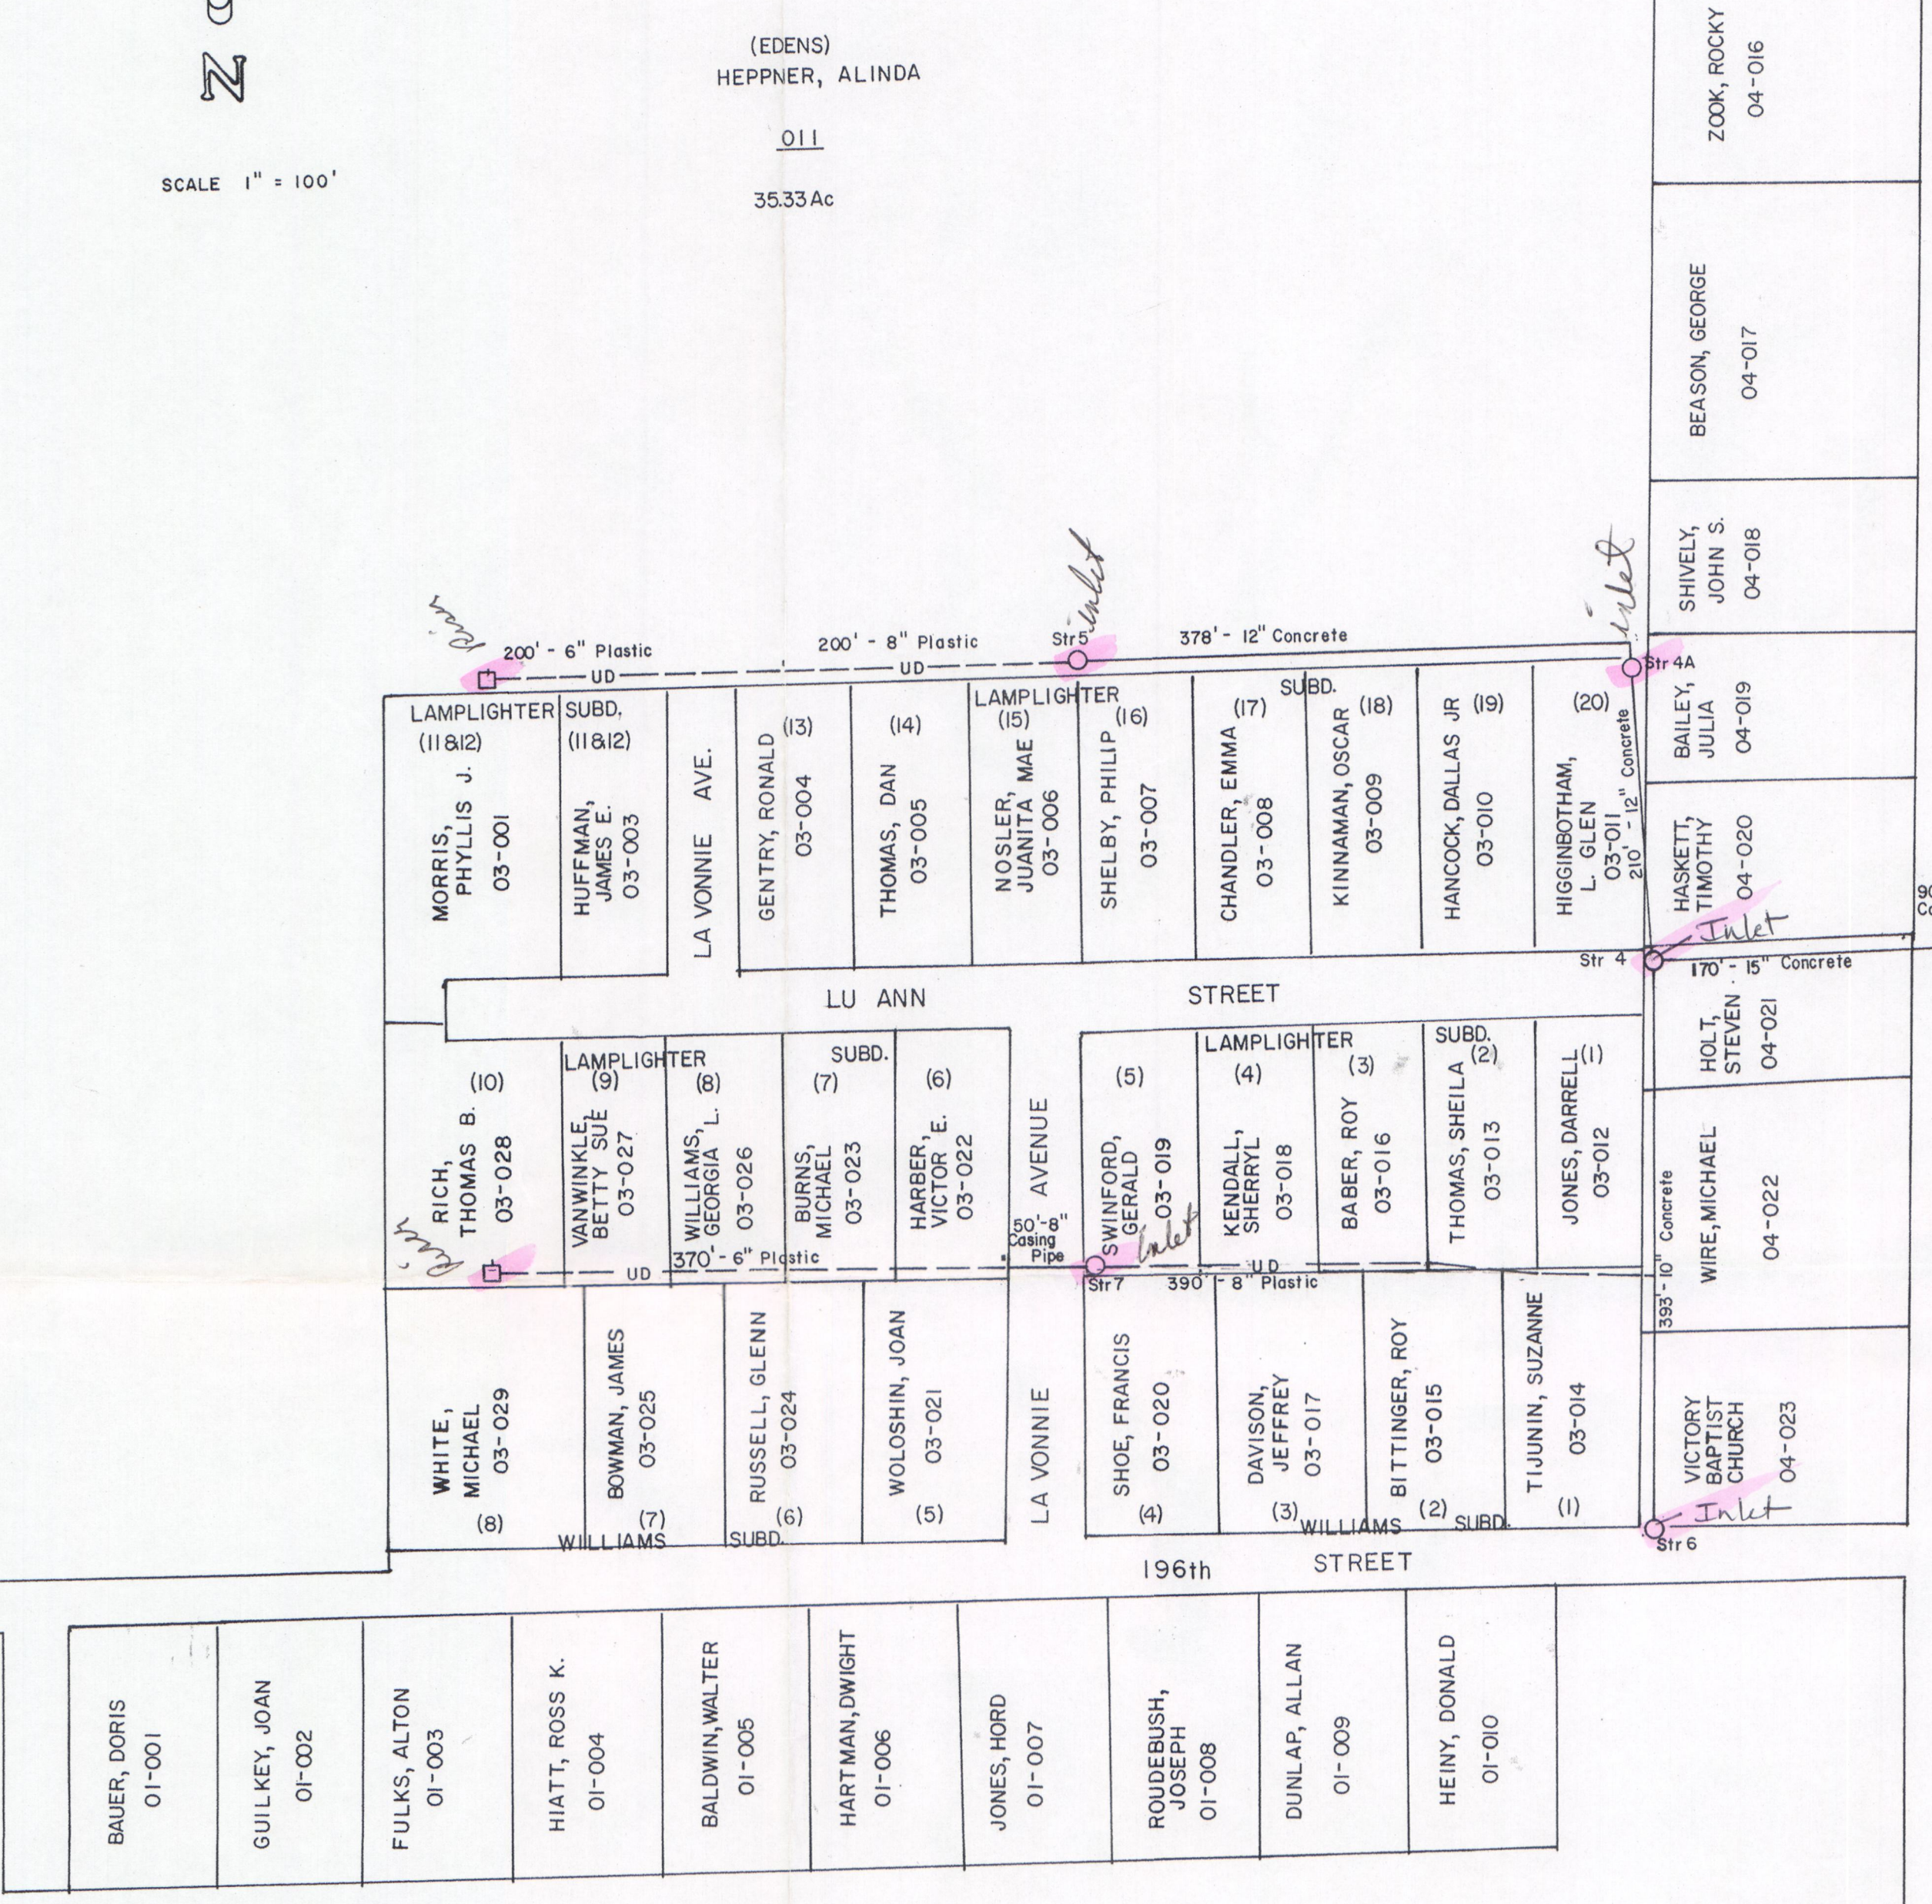


957' - c/k of co. line to the N.E.
1859' - c/k of co. line to the N.E.

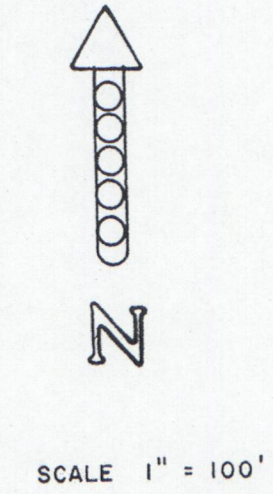

EASEMENTS
25' off S. line of 06-24-00-00-011 HEPPNER
15' off N. line of Lots 11 through 20
15' off W. line of 06-24-04-04-019
15' off W.S. line of 06-24-04-04-020
15' off W.S. line of 06-24-04-04-021
15' off W. line of 06-24-04-04-022 & 023
15' off E. line Lot 20 & 1 Lamplighter; Lot 1 Williams
15' off S. line Lots 1 through 10 Lamplighter
15' off N. line Lots 1 through 8 Williams
75' off W. line 07-19-00-00-027 McMAHON
75' off W. line 07-30-00-00-001 McMAHON
C. off N. line of 07-30-00-00-003 MacINNIS
90' off S. line of 07-30-00-00-001 McMAHON

LEGEND
ROAD
PROPERTY LINE
OPEN DRAIN
TILE DRAIN
NATURAL DRAIN
PRIVATE DRAIN
CATCH BASIN
HEADWALL
BREATHER
STRUCTURE
RISER
M.E.S.
UNDER DRAIN

PREPARED BY:
Janet Hansen & Jerry Liston
April 6, 1994

APPROVED BY:
[Signature]
Hamilton Co. Surveyor

SCALE - 1" = 100'

LAMPLIGHTER DRAIN
NOBLESVILLE TOWNSHIP

06-24-00
S24 T19-R4

07-19-00
S19 T19 R5

MILLER, JO LYNN (SOWERS) 02-004	VANZANT, DEWEY 02-002	MYERS, JIMMY 02-001										
Str 6												
VICTORY BAPTIST CHURCH 04-023	WIRE, MICHAEL 04-022	HOLT, STEVEN 04-021	Str 4									
4												
210' - 15" Concrete												
Str 4												
210' - 15" Concrete												
Str 4												
2												

06-25-00
S25 T19 R4

07-30-00
S30 T19 R5

