



SURVEYOR'S OFFICE

Hamilton County

Kenton C. Ward, CEM
Surveyor of Hamilton County
Phone (317) 776-8495
Fax (317) 776-9628

Suite 188
One Hamilton County Square
Noblesville, Indiana 46060-2230

Date: August 6, 2007

To: Hamilton County Drainage Board

Re: Mud Creek / Sand Creek Drain – James D. McCarty Arm

Attached is a 52.5 petition and plans for the proposed relocation of the Mud Creek / Sand Creek Drain – James D. McCarty Arm.

The relocation is being proposed by Olio 238 Partners, LLC, et al. This work is being done as part of the Olio 238 Offsite Utility Extension project per plans by Schneider Corp., Job No. 5761.002, revision date 8/2/2007, and by Stoeppelwerth & Assoc., Job No. 44903, revision date 8/2/2007; and as part of the Fishers Shoppes project per plans by Schneider Corp., Job No. 5761.003 dated 4/30/2007.

The proposal is to relocate the drain across the following tracts:

<u>Parcel</u>	<u>Owner</u>
13-11-23-00-00-017.000	Fishers Shoppes LLC,
13-11-24-00-00-028.000	Northeast Medical Center, Inc.,
13-11-24-00-00-029.000	Northeast Medical Center, Inc.,
13-11-24-00-00-023.000	Northeast Medical Center, Inc.,
13-11-24-00-00-024.000	Olio 238 Partners LLC,
13-11-24-00-00-025.000	Olio 238 Partners LLC,
13-11-25-00-00-001.000	Interstate Holdings LLC,
13-11-25-00-00-001.001	Olio 238 Partners LLC,
13-11-25-00-00-002.002	Pulte Homes of Indiana LLC,
State Road 238 right-of-way	State of IN Dept. of Transportation
136 th Street right-of-way	Town of Fishers
Olio Road right-of-way	Town of Fishers.

Per the plans, the drain will be reconstructed and relocated from the northwest corner of Olio Road and SR 238, then, routed generally in a southeasterly direction and discharge into Mud Creek. This project will reconstruct portions of both the main drain and Arm 1. The portion of the main drain from Sta. 16+60 to Sta. 26+42 located on parcels 13-11-25-00-00-021.000 and 13-11-25-00-00-021.002 owned by Community Hospitals of Indiana, Inc., will remain as regulated drain until reconstructed in the future. Also, the portion of Arm 1 from Sta. 0 to Sta. 7+00, which is located on parcels 13-11-24-00-00-024.000 and 13-11-24-00-00-025.000 owned by Olio 238 Partners, LLC, will remain as regulated drain until reconstructed in the future.

The new drain shall be those portions of storm sewer and open ditch as shown on the above plans sets. Those portions are as follows:

Fishers Shoppes (Sheet C602); Str. 600 to Str. 800; Olio 238 (Sheets C600 to C602); Str. 600 to Str. 609, 608, 607, 606, 605, 604, 603, 611, 602, 610, 601, 565, 564, 563, 561. Also, from Str.567. The 470 feet of open ditch shown on Sheet C602 from Str. 561 to Mud Creek.

This line will consist of the following:

15" RCP	54 ft.	24" RCP	150 ft.	42" RCP	1,611 ft.
18" RCP	143 ft.	30" RCP	718 ft.	Open Ditch	470 ft.
21" RCP	280 ft.	36" RCP	638 ft.		

The total length of the new drain shall be 3614 feet. A total of 2840 feet of the original 1915 drain between Sta. 1+39 and 16+60 of the main drain, and between Sta. 7+00 and Sta. 15+20 of Arm 1 shall be vacated. This proposal will add 773 feet to the drain's total length.

The cost of the relocation is to be paid by Bremner Duke Healthcare Real Estate. The developer has provided the Bond as follows:

Name of Bonding Co.: Western Surety Company
 Bond #: 929428001
 Bond Date: 6/15/2007
 Bond Amount: \$460,741.00

The easement for the new drain will be as follows per the attached plans:

Str. 600 to 604, 50' total with 25' per half;
 Str. 604 to 603, 50' total with 15' on north side of pipe and 35' on south side of pipe;
 Str. 603 to 601, 50' total with 25' per half;
 Str. 610 to 602, 50' total with 25' per half;
 Str. 601 to 561, 50' total with 30' on east side of pipe and 20' on west side of pipe. It should be noted that the east 15' will overlap with the HSE Utilites easement and will be utilized temporarily as additional space for equipment, excavated dirt and materials necessary for the repair and maintenance of the James D. McCarty Drain with reciprocal access granted to HSE Utilities.


From Str. 561 to Mud Creek the easement will be the statutory easement contained within the Pulte parcel until said parcel is developed in the future.

Non-enforcement requests for the above easements will be approved separately.

I recommend that this drain be classified as an urban drain. This drain may be assessed to the Mud Creek Drain in the future.

This project will be heard under the procedures as set out in IC 36-9-27-52.5. This project was determined to qualify as a 52.5 per authorization of the Board on July 23, 2007, as recommended by the County Attorney, per letter dated July 20, 2007. Therefore, a hearing is not required for the petition. I recommend approval by the Board.

Sincerely,

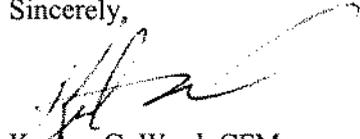A handwritten signature in black ink, appearing to read 'Kenton C. Ward', with a long, sweeping flourish extending to the right.

Kenton C. Ward, CFM
Hamilton County Surveyor

KCW/stc

HAMILTON COUNTY DRAINAGE BOARD
NOBLESVILLE, INDIANA

IN RE: James D. McCarty Drain Relocation)
Hamilton County, Indiana)

PETITION FOR RELOCATION AND RECONSTRUCTION

Olio 238 Partners, LLC (hereinafter "Petitioner"),

hereby petitions the Hamilton County Drainage Board for authority to relocate and improve a section of the James D. McCarty Drain, and in support of said petition advises the Board that:

1. Petitioner owns real estate through which a portion of the James D. McCarty Drain runs.
2. Petitioner plans to develop its real estate with roads, buildings, utilities, storm drains, sanitary sewers and other structures.
3. Petitioner's proposed development of its real estate will require relocation and reconstruction of a portion of the James D. McCarty Drain, as specifically shown on engineering plans and specifications filed with the Hamilton County Surveyor.
4. The work necessary for the proposed relocation and reconstruction will be undertaken at the sole expense of the Petitioner and such work will result in substantial improvement to the James D. McCarty Drain, without cost to other property owners on the watershed of the James D. McCarty Drain.

WHEREFORE, Petitioner requests that an Order issued from the Hamilton County Drainage Board authorizing relocation and reconstruction of the James D. McCarty Drain, in conformance with applicable law and plans and specifications on file with the Hamilton County Surveyor.

Olio 238 Partners, LLC


Signed

Harry F. McNaught, Jr.
Printed
President

Attached Sheet - James D. McCarty Legal Drain

Fishers Shoppes, LLC

By

Robert B. Warstler

Printed

Robert B. Warstler

Title

Member

Town of Fishers, Indiana

By

GARY A. HUFF

Printed

GARY A. HUFF

Title

TOWN MANAGER

Northeast Medical Center, Inc.

By

Glenn E. Hoge

Printed

Glenn E. Hoge

Title

Authorized Agent of BD Northeast Medical Center, LLC, an authorized agent of Northeast Medical Center, Inc.

Olio 238 Partners, LLC

By

Harry F. McNaught, Jr.

Printed

Harry F. McNaught, Jr.

Title

President

Interstate Holdings, LLC

By

SEAN P. McKinnies

Printed

SEAN P. McKinnies

Title

Manager - Const Services

Pulte Homes of Indiana, LLC

By

MATTHEW D. LOHMEYER

Printed

MATTHEW D. LOHMEYER

Title

DIRECTOR OF LAND DEVELOPMENT

Indiana Department of Transportation

By

JACK E. KIMMERLING, JR.

Printed


JACK E. KIMMERLING, JR.

Title

INDOT

Deerfield Diet Permits Manager

17-31-07

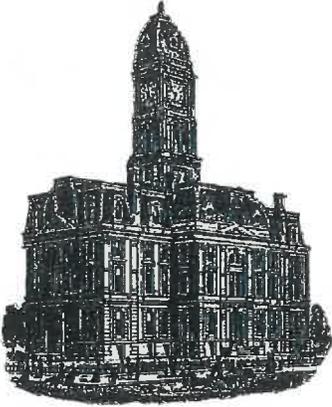

Kenton C. Ward, CFM
Surveyor of Hamilton County
Phone (317) 776-8495
Fax (317) 776-9628

Suite 188
One Hamilton County Square
Noblesville, Indiana 46060-2230

Map Correction-Field Verification

Drain Number: 347

Drain Length: 3387

Drain Name: James D. McCarty 2007 Relocation **Change +/- :** +151

Date: 8-25-2016

New Length: 3538

Verified By: SLM, JLL

Notes & Sketch: See attached plan sheet.

600-609 ✓ slm
Pipe between Structures ~~608-609~~ was never included in the final report. Plans mentioned in Surveyor's reported, dated August 6, 2007, were never found. Therefore, the drainage inspector recently did a field verification of this pipe section under Olio Rd. It was determined that the pipe under Olio Road is 151 feet of 21" RCP.

Suzanne L. Mills
GIS Specialist



SURVEYOR'S OFFICE

Hamilton County

Kenton C. Ward, CFM
 Surveyor of Hamilton County
 Phone (317) 776-8495
 Fax (317) 776-9628

Suite 188
 One Hamilton County Square
 Noblesville, Indiana 46060-2230

To: Hamilton County Drainage Board

March 5, 2009

Re: Mud Creek – Sand Creek: James D. McCarty Relocation

Attached are as-builts, certificate of completion & compliance, and other information for James D. McCarty Relocation. An inspection of the drainage facilities for this section has been made and the facilities were found to be complete and acceptable.

During construction, changes were made to the drain, which will alter the plans submitted with my report for this drain-dated August 6, 2007. The report was approved by the Board at the hearing held August 13, 2007. (See Drainage Board Minutes Book 10, Pages 361-363)

The changes are as follows:

Structure:	Length:	Size:	Material:	Up Invert:	Dn Invert	Grade:	Changes:
609-608	264	21	RCP	831.01	829.88	0.43	-16
608-607	290	30	RCP	829.88	828.97	0.31	11
607-606	115	30	RCP	828.97	828.72	0.21	1
606-605	159	30	RCP	828.72	827.09	1.03	-2
605-604	153	30	RCP	827.09	826.47	0.41	1
604-603	230	30	RCP	826.47	825.84	0.27	-4
603-611	53	30	RCP	825.84	825.68	0.3	6
611-602	122	36	RCP	825.68	825.34	0.21	-2
602-601	157	36	RCP	825.34	824.84	0.32	-7
610-602	59	15	RCP	836	835.38	1.01	6
567-565	151	24	RCP	832.67	829.65	2	1
601-565	30	42	RCP	824.84	824.77	0.25	2
565-564	342	42	RCP	824.77	823.9	0.25	9
564-563	400	42	RCP	823.9	822.91	0.25	
563-561	392	42	RCP	822.91	821.67	0.32	-8

RCP Pipe Totals:

15	59
21	264

Other Drain

Open Ditch	470
Total:	470

24	151
30	1000
36	279
42	1164
<u>2917</u>	

The length of the drain due to the changes described above is now **3387 feet**. The original tile was removed from Sta. 1+27 to Sta. 14+60 on the main ditch and from Sta. 7+00 to Sta. 15+20 on Arm 1. Therefore, 2033 feet of tile was removed with this project.

The individual non-enforcements will be filed as the properties in this are developed.

The following sureties were guaranteed by Western Surety Company and released by the Board on its March 23, 2009 meeting.

Bond-LC No: 929428001
Insured For: Storm Sewers
Amount: \$460,741.00
Issue Date: June 15, 2007


I recommend the Board approve the drain's construction as complete and acceptable.

Sincerely,



Kenton C. Ward, CFM
Hamilton County Surveyor

KCW/slm

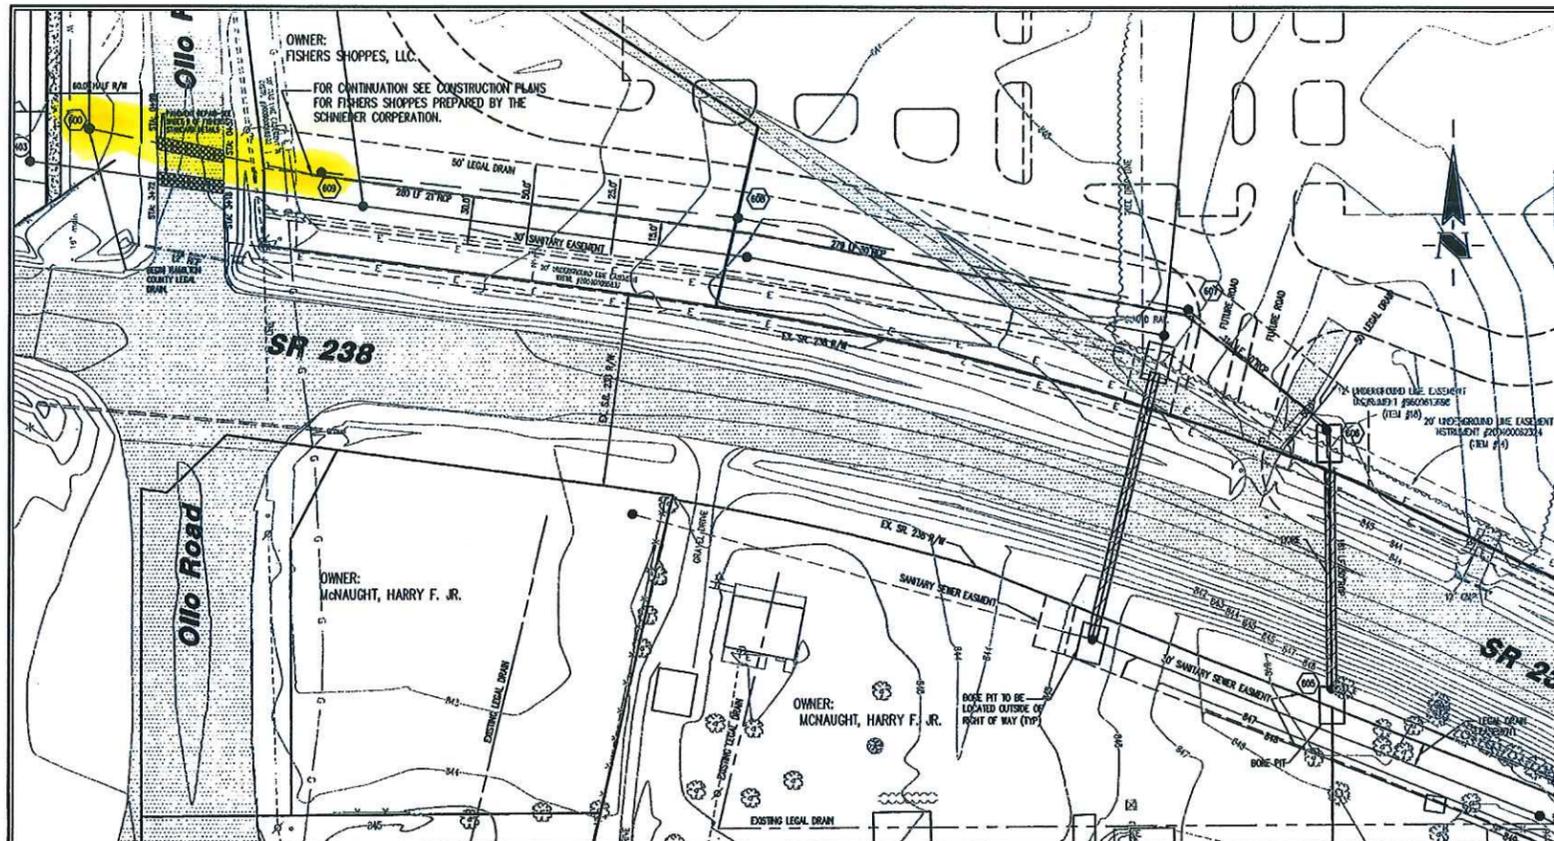

STORM SEWER PLAN


SCALE: 1"=50'

BENCHMARK
 BM - HSE DISK STAMPED "HSE13", IN CONCRETE AT THE ANGLE BREAK IN THE RIGHT-OF-WAY FENCE IN THE SOUTHWEST QUADRANT OF EXIST RAMP FROM I-69 NORTH TO STATE ROAD 238, 1 FOOT FROM CORNER OF RIGHT-OF-WAY FENCE AND 100 FEET TO THE EDGE OF PAVEMENT.
 ELEVATION = 840.88 (NAVD 1988)
 TBM 1 - PK NAIL IN POWER POLE #064-350 ± 31.6 FEET EAST OF THE CENTERLINE OF OLLO ROAD AND ±259.6 FEET NORTH OF THE CENTERLINE OF STATE ROAD 238.
 ELEVATION = 844.19 (NAVD 1988)
 TBM 2 - PK NAIL IN POWER POLE #062-351 ± 690 FEET EAST OF THE CENTERLINE OF OLLO ROAD, SOUTH SIDE OF 136TH STREET.
 ELEVATION = 848.09 (NAVD 1988)

HOLEY MOLEY SAYS "DON'T DIG BLIND"
"IT'S THE LAW"
 CALL 2 WORKING DAYS BEFORE YOU DIG
1-800-382-5544
 CALL TOLL FREE
 PER INDIANA STATE LAW IS-49-1981, IT IS AGAINST THE LAW TO EXCAVATE WITHOUT NOTIFYING THE UNDERGROUND LOCATION SERVICE TWO (2) WORKING DAYS BEFORE COMMENCING WORK.


- GENERAL NOTES**
- TEMPORARY TRAFFIC CONTROL DURING CONSTRUCTION TO CONFORM TO APPLICABLE LOCAL AND STATE STANDARDS.
 - ALL CONSTRUCTION ACTIVITY ON THIS SITE TO BE PERFORMED IN COMPLIANCE WITH APPLICABLE O.S.H.A. STANDARDS FOR WORKER SAFETY.
 - IT SHALL BE THE CONTRACTORS RESPONSIBILITY TO FIELD VERIFY ALL UTILITY LOCATIONS BEFORE CONSTRUCTION BEGINS.
 - CONTRACTORS SHALL MINIMIZE DAMAGE TO EXISTING TREES.
 - ALL FIELD TIES INTERCEPTED TO BE PERPETUATED INTO STORM SEWER. THE SUBCONTRACTOR SHALL NOTIFY IN WRITING THE OWNER AND ENGINEER IF ANY CIRCUMSTANCES WHERE THIS CANNOT BE ACCOMPLISHED.
 - CONSTRUCTION PER HAMILTON COUNTY SURVEYOR'S OFFICE STANDARD DETAIL DRAWINGS.

- REVISIONS**
- DAG - 4/20/07 - MISC. SHEET CLEANUP.
 - DAG - 6/01/07 - REVISED PER HSE REVIEW COMMENTS.
 - DAG - 7/02/07 - REVISED PER HSE REVIEW COMMENTS.
 - DAG - 7/20/07 - REVISED EXISTING LEGAL DRAIN INFORMATION.
 - DAG - 8/02/07 - REVISED EASEMENTS AND ADDED MANHOLE.
 - GAD - 8/13/07 - ADDED BORE PIT LOCATIONS.
 - GAD - 9/11/07 - ADDED STR. 412 PER HSE COMMENTS TO CRIFE.
 - R/S - 9/14/07 - REVISED STORM PLAN AND PROFILE.
 - DAG - 9/19/07 - REVISED PER 9/17/07 SAMCO COMMENT LETTER.
 - R/S - 10/15/07 - REVISED SANITARY STRUCTURE 407 AND ADD SITE.

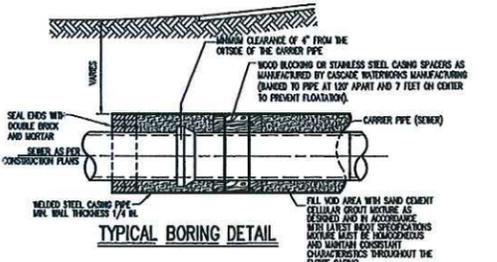



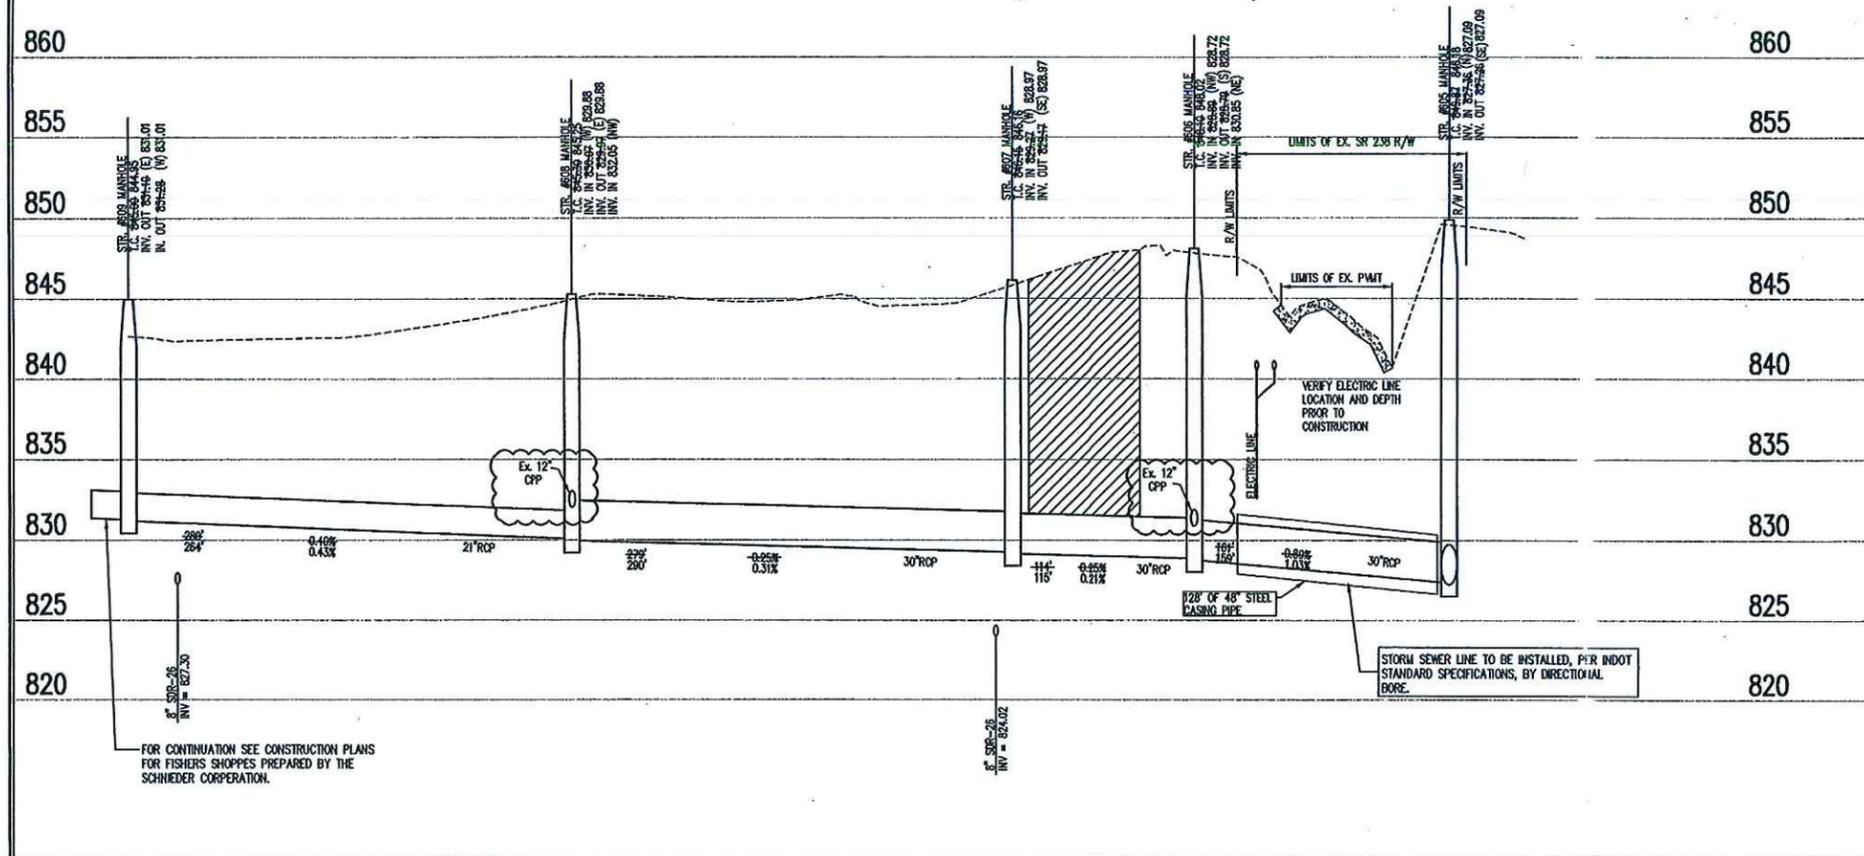

STORM SEWER PROFILE

SCALE: HORZ.: 1"=50'
 VERT.: 1"=5'

CERTIFICATION FOR "RECORD DRAWING"

CERTIFIED BY: *D. Place*

THE SCHNEIDER CORPORATION
 HISTORIC FORT HARRISON
 8901 OTIS AVENUE
 INDIANAPOLIS, INDIANA 46216
 (317) 828-7100 FAX (317) 828-7300

DATE: 05/29/08

This information was gathered for input into the Hamilton County Geographic Information System (GIS). This document is considered an official record of the GIS.

Entry Date: 3-5-09
 Entered By: SLN

LEGEND

	Existing Grade
	New Grade
	Greater Backfill



THE SCHNEIDER CORPORATION
 Historic Fort Harrison
 8901 Otis Avenue
 Indianapolis, IN 46216-1037
 Telephone: 317.828.7100
 Fax: 317.828.7300
 www.schneidercorp.com

Architecture
 Civil Engineering
 Environmental Engineering
 Geotechnical Services
 GIS * LIS
 Home Builder Services
 Interior Design
 Land Surveying
 Landscape Architecture
 Transportation Engineering

OLLO 238
 OFFSITE UTILITY EXTENSION
 FISHERS, INDIANA
 OLLO 238 PARTNERS, LLC
 INDIANAPOLIS, IN

DATE: 04/16/07	PROJECT NO.: 5761.002
DRAWN BY: DAG/RJS	CHECKED BY: GJD
SHEET TITLE: STORM SEWER PLAN AND PROFILE	
DRAWING FILES:	
SURVEYOR'S OFFICE

Hamilton County

Kenton C. Ward, CFM
 Surveyor of Hamilton County
 Phone (317) 776-8495
 Fax (317) 776-9628

Suite 188
 One Hamilton County Square
 Noblesville, Indiana 46060-2230

To: Hamilton County Drainage Board

March 5, 2009

Re: Mud Creek – Sand Creek: James D. McCarty Relocation

Attached are as-builts, certificate of completion & compliance, and other information for James D. McCarty Relocation. An inspection of the drainage facilities for this section has been made and the facilities were found to be complete and acceptable.

During construction, changes were made to the drain, which will alter the plans submitted with my report for this drain-dated August 6, 2007. The report was approved by the Board at the hearing held August 13, 2007. (See Drainage Board Minutes Book 10, Pages 361-363)

The changes are as follows:

Structure:	Length:	Size:	Material:	Up Invert:	Dn Invert	Grade:	Changes:
609-608	264	21	RCP	831.01	829.88	0.43	-16
608-607	290	30	RCP	829.88	828.97	0.31	11
607-606	115	30	RCP	828.97	828.72	0.21	1
606-605	159	30	RCP	828.72	827.09	1.03	-2
605-604	153	30	RCP	827.09	826.47	0.41	1
604-603	230	30	RCP	826.47	825.84	0.27	-4
603-611	53	30	RCP	825.84	825.68	0.3	6
611-602	122	36	RCP	825.68	825.34	0.21	-2
602-601	157	36	RCP	825.34	824.84	0.32	-7
610-602	59	15	RCP	836	835.38	1.01	5
567-565	151	24	RCP	832.67	829.65	2	1
601-565	30	42	RCP	824.84	824.77	0.25	2
565-564	342	42	RCP	824.77	823.9	0.25	9
564-563	400	42	RCP	823.9	822.91	0.25	
563-561	392	42	RCP	822.91	821.67	0.32	-8

RCP Pipe Totals:

15	59
21	264

Other Drain

Open Ditch	470
Total:	470

24	151
30	1000
36	279
42	1164
<u>2917</u>	

The length of the drain due to the changes described above is now **3387 feet**. The original tile was removed from Sta. 1+27 to Sta. 14+60 on the main ditch and from Sta. 7+00 to Sta. 15+20 on Arm 1. Therefore, 2033 feet of tile was removed with this project.

The individual non-enforcements will be filed as the properties in this are developed.

The following sureties were guaranteed by Western Surety Company and released by the Board on its March 23, 2009 meeting.

Bond-LC No: 929428001

Insured For: Storm Sewers

Amount: \$460,741.00

Issue Date: June 15, 2007

I recommend the Board approve the drain's construction as complete and acceptable.

Sincerely,



Kenton C. Ward, CFM
Hamilton County Surveyor

KCW/slm

